

ADDENDUM NUMBER 1:
Issued: September 17, 2013
Bid #06-14
Water Treatment Plant Deconstruction and Demolition

This Addendum forms part of the original document marked: Water Treatment Plant Deconstruction and Demolition Bid # 06-14

The following questions have been asked and answered:

Regarding the Base Project at Madbury:

Q: Do the footings and foundations need to be totally removed?

Answer: No. The footings and the floor of the foundation need to be broken so that groundwater will pass through. The foundation walls need to be demolished to no less than two (2) feet below grade. Clean rubblized concrete or brick may be used to fill the foundation hole to the appropriate level.

Q: Can you use the crushed concrete generated on site for backfill purposes?

Answer: Yes. See above.

Q: Is there a specific concrete size we need to use when backfilling?

Answer: 2-5 inch pieces

Q: How far out beyond the site do the pipelines extend? Are we required to get rid of the pipes beyond the site location?

Answer: You do not have to remove any piping beyond the footprint of the building.

Q: Will barricades be required?

Answer: No, but you have to control access to the site such that passers-by can pass safely. The worksite and stand-off must be clearly marked.

Q: Can we have extended work hours?

Answer: Yes, but only as an exception, and you must request permission for extended hours from the DPW 24-hours in advance.

Q: What permits will firms be required to acquire?

Answer: Any permit necessary other than the building permit for demolition from the town of Madbury, which the DPW will acquire.

Regarding the Add Alternate Project at Pease:

Q: Can the carbon be disposed of in the land fill?

Answer: Yes

Q: If the carbon weighs more than 50-Thousand pounds how is it paid for? Is the weight based on dry weight?

Answer: If there is more (or different) material present within the tanks than anticipated, the added cost for removal of the material will be treated as a change order.

Q: Can we use the back garage door to remove material?

Answer: No. The building addition with the garage door must not be impacted during this project as operations will be on-going there.

Additionally, part of this addendum includes the following attachments:

- List of attendees from the pre-bid meeting
- Asbestos inspection
- Carbon lab data sheet
- Plan sets of Madbury

Please acknowledge this addendum within your proposal, failure to do so may subject a bidder to disqualification.

End of Addendum #1

Filter Building Demolition Project Pre-Bid Meeting - 9/10/13

Sign-In Sheet

NAME	FIRM	PHONE	EMAIL
Kristen Leighton	Shipyard Waste Solutions	207-400-0992	Kristen@shipyardwastesolutions.com
Travis Saucier	T. Buck Construction	207-783-6223 207-783-3970	travis@TBUCKCON.NET
Phil Trachice	One Source Environmental, LLC	(603) 425-9649	Phil@ONESOURCEONE.COM
Heath Todd	Apex Construction	(603) 330-3600	heath@apex-constructioninc.com
MARK FILLION	BROWN INDUSTRIAL GROUP	207-698-5598	MARK@BROWNINDUSTRIALGROUP.COM
Bryson Stockdale	Air Quality Experts	(603) 894-6465	bstockdale@AQEMH.COM
Don Leano	AGI	603 498 1886	dls@abingtongroup.com
Sean Bent	AGI	603 498 0073	smb@abingtongroup.com
DANA KILROY	NCM	857-266-3238	DKILROY@NCMgroup.com

Filter Building Demolition Project Pre-Bid Meeting – 9/10/13

Sign-In Sheet

NAME	FIRM	PHONE	EMAIL
Rick Wickson	Wickson Construction/ Kinsman Corp.	603-778-3100 cell# 978-423-4521	rwickson@wicksonconstruction.com
Bryan Wickson	Wickson Const. Kinsman Corp	603-778-3100 603-548-2037	BTwickson@gmail.com
Mike DiHard	FRANCESCO Demolition	781-585-0210 781-934-9193	francesco25@verizon.net
Donna Olszak	All-Ways Wrecking	603 744 5090	allways@metrocast.net
Bob MORSON	JAYMORE Enterprises	603-635-2183	JAYMORE ENT @ comcast.net
Austin Connors	McCConnell Env	781 848 8071	mcc.connors@verizon.net
Malcolm BRADSHAW	M. BRADSHAW CO INC	603-679-3888	CRUSHMOORE@gmail.com
Jason LaBranchi	Green Environmental	603-242-3342	jlaBranchi@greenenvironmental.com
Larry Riv	Renard Trucking	207-384-5111	
Steve Fye	Shipyard Waste	207-439-5574	sfeye@shipyardwaste Solutions.com

Accolade Environmental Contracting, Corp.
PO Box 1256, Plaistow, NH. 03865
Telephone (603) 608-6545 aeccorp@hotmail.com

October 3, 2011

Mr. Peter Rice
Portsmouth Water & Sewer Department
680 Peverly Hill Road
Portsmouth, NH 03081

RE: Asbestos testing @ 61 Freshet Road, Madbury, NH

Dear Mr. Rice,

As a representative of Accolade Environmental, NH asbestos inspector license # AI000322, we have collected samples of building materials suspect of containing asbestos materials at the above referenced property. Samples were collected September 26, 2011 and overnight delivered to Asbestos Identification Laboratory (License # AA 000208) 165U New Boston Road, Woburn, MA. 01801. Scope of work was limited to the facilities building scheduled for demolition. Although aggressive sampling was performed no inspection can guarantee to uncover all suspect materials. If additional materials are discovered during demolition, (ie) behind walls, or under sub-flooring please contact me for further testing. The following results were obtained using the EPA/600/R-93-116 method of analyzes for the Determination of Asbestos in Bulk Building Materials or Products.

Asbestos material was detected in the following samples

#5 Cement wall board panels	20% chrysotile asbestos
#14 Cement exhaust pipe base-roof	10% chrysotile asbestos
	10% Crocidolite asbestos
#21 Exterior red paint on metal panel	20% chrysotile asbestos
Transite panels on laboratory hood	assumed acm

Materials with 1% or greater asbestos content must be handled in accordance with State, Federal and Local regulations pertaining to asbestos materials.
Please contact me if you require further information.

Sincerely,


Frank Kasabian, Vice-President, AEC, Corp.

See page 2 for quantities and estimated cost

Observed were approximately

73 light fixtures with mercury containing bulbs and ballast's which must be collect and properly disposed of.


8 AC units and 1-water cooler with CFC's (Freon) which requires collection and legal disposal. .

Cost estimates based on industrial standard pricing

Transite wall panels (double sided) 2,000 sf @ \$4.00 sf	\$8,000.
Exterior metal panels with asbestos paint 1,200 sf @ \$3.00 sf	\$3,600.
Transite exhaust pipe	\$1,000.
Transite laboratory hood 1 \$ \$1,200.	\$1,000.
NH DES Notification fee 1 @ \$300.	\$300.
Independent consultant for post abatement air testing	\$600.
Lamps/ballast's 73 @ \$15. Per fixture	\$1,095.
CFC collect and recycle 9 units @ \$50. Each	\$450.

Total pre demolition abatement cost \$16,045.

Excludes tank cleaning and motorized equipment with oils if applicable.

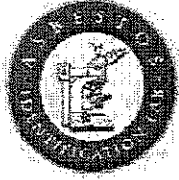


Asbestos Identification Laboratory
 165U New Boston St., Ste 271
 Woburn, MA 01801
 Bulk Asbestos Analysis by Polarized Light Microscopy
 EPA Method: 600/R-93/116

NVLAP
 Lab Code: 200919-01

Results Table

Sample ID	Lab ID	Material	Sample Location	Analytical Results
1	23950	Brown 12 inch floor tile	Second floor office	No Asbestos Detected
2	23951	Cove base mastic	Second floor office	No Asbestos Detected
3	23952	Joint compound/wallboard	Second floor office	No Asbestos Detected
4	23953	2 x 4 ceiling tile	Second floor office	No Asbestos Detected
5	23954	Cement wall board	Second floor top of stairs	Chrysotile=20%
6	23955	Cement board wall panel	Second floor partition wall	Chrysotile=20%
7	23956	Gray patterned floor tile	Second floor office left side	No Asbestos Detected
8	23957	Mud fitting insulation	L. room on fiberglass insulation pipe	No Asbestos Detected
9	23958	Roof tar	Upper roof	No Asbestos Detected
10	23959	Roof cement perimeter flashing	Upper roof	No Asbestos Detected
11	23960	Roof cement penetrations	Upper roof	No Asbestos Detected
12	23961	Roof tar	Lower roof	No Asbestos Detected
13	23962	Roof cement	Perimeter flashing lower roof	No Asbestos Detected
14	23963	Exhaust pipe	First through roof	Chrysotile=10% Crocidolite=10%
15	23964	12 inch beige VCT first-floor	First-floor	No Asbestos Detected
16	23965	Joint compound and wallboard composite	First floor office	No Asbestos Detected
17	23966	Window caulk	Frame to brick	No Asbestos Detected
18	23967	Exterior window glaze	Window glass	No Asbestos Detected
19	23968	Exterior window glaze	Window glass	No Asbestos Detected
20	23969	Exterior metal siding	Red exterior	No Asbestos Detected
21	23970	Paint red	Associated with #20	Chrysotile=20%

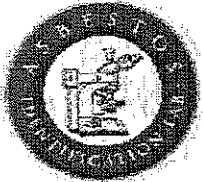

Asbestos Identification Laboratory
165U New Boston St., Ste 271
Woburn, MA. 01801
Bulk Asbestos Analysis by Polarized Light Microscopy
EPA Method: 600/R-93/116

NVLAP
Lab Code: 200919-01

October 3, 2011

Accolade Environmental
P.O. Box 1256
Plaistow, NH 03865

Batch 1695


Dear Frank Kasabian:

The following correspondence contains two communications:

1. Results of Asbestos project: **60 Freshet Rd., Madbury, NH**
2. Billing Invoice.

The information and analysis contained in this report have been generated using the EPA /600/R-93/116 Method for the Determination of Asbestos in Bulk Building Materials. Materials or products that contain more than 1% of any kind or combination of asbestos are considered an asbestos containing building material as determined by the EPA. This Polarized Light Microscope (PLM) technique may be performed either by visual estimation or point counting. Point counting provides a determination of the area percentage of asbestos in a sample. If the asbestos is estimated to be less than 10% by visual estimation of friable material, the determination may be repeated using the point counting technique. The results of the point counting supersede visual PLM results. Results in this report only relate to the items tested. This report may not be used by the customer to claim product endorsement by NVLAP or any other U.S. Government Agency.

- NVLAP Lab Code: 200919-0
- Massachusetts Certification License: AA000208
- State of Connecticut, Department of Public Health Approved Environmental Laboratory Registration# PH-0142
- State of Maine, Department of Environmental Protection Asbestos Analytical Laboratory License Number LB-0078(Bulk) LA-0087(Air)
- State of Rhode Island and Providence Plantations Department of Health Certification: AAL-121

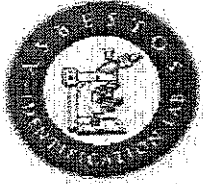

Asbestos Identification Laboratory
165 U New Boston St., Ste 271
Woburn, MA 01801
Bulk Asbestos Analysis by Polarized Light Microscopy
EPA Method: 600/R-93/116

NVLABSM
Lab Code: 200919-04

Results for Client Project: 60 Freshet Rd., Madbury, NH, Batch# 1695

Work Received: 9/29/2011

Date Sampled: 9/28/2011

Results Sent: 10/3/2011 1:15:56 PM

Field ID: 1 Material: Brown 12 inch floor tile Color: Tan Location: Second floor office Sample# 23950 NON=100
None Detected

Field ID: 2 Material: Cove base mastic Color: Yellow Location: Second floor office Sample# 23951 NON=100 None
Detected

Field ID: 3 Material: Joint compound/wallboard Color: Multi Location: Second floor office Sample# 23952 CEL=020
NON=080 None Detected

Field ID: 4 Material: 2 x 4 ceiling tile Color: Gray Location: Second floor office Sample# 23953 MNW=040 CEL=040
NON=020 None Detected

Field ID: 5 Material: Cement wall board Color: Gray Location: Second floor top of stairs Sample# 23954 NON=080
ASBESTOS DETECTED CHR=020

Field ID: 6 Material: Cement board wall panel Color: Gray Location: Second floor partition wall Sample# 23955
NON=080 ASBESTOS DETECTED CHR=020

Field ID: 7 Material: Gray patterned floor tile Color: Multi Location: Second floor office left side Sample# 23956
NON=100 None Detected

Field ID: 8 Material: Mud fitting insulation Color: Gray Location: L. room on fiberglass insulation pipe Sample#
23957 MNW=040 NON=060 None Detected

Field ID: 9 Material: Roof tar Color: Black Location: Upper roof Sample# 23958 CEL=025 NON=075 None Detected

Field ID: 10 Material: Roof cement perimeter flashing Color: Black Location: Upper roof Sample# 23959 NON=100
None Detected

Field ID: 11 Material: Roof cement penetrations Color: Black Location: Upper roof Sample# 23960 NON=100 None
Detected

Field ID: 12 Material: Roof tar Color: Black Location: Lower roof Sample# 23961 CEL=030 NON=070 None
Detected

Field ID: 13 Material: Roof cement Color: Black Location: Perimeter flashing lower roof Sample# 23962 CEL=020
NON=080 None Detected

Field ID: 14 Material: Exhaust pipe Color: Gray Location: First through roof Sample# 23963 NON=080 ASBESTOS
DETECTED CHR=010 CRO=010

Field ID: 15 Material: 12 inch beige VCT first-floor Color: Multi Location: First-floor Sample# 23964 NON=100 None Detected

Field ID: 16 Material: Joint compound and wallboard composite Color: Multi Location: First floor office Sample# 23965 CEL=020 NON=080 None Detected

Field ID: 17 Material: Window caulk Color: Black Location: Frame to brick Sample# 23966 NON=100 None Detected

Field ID: 18 Material: Exterior window glaze Color: Gray Location: Window glass Sample# 23967 NON=100 None Detected

Field ID: 19 Material: Exterior window glaze Color: Gray Location: Window glass Sample# 23968 NON=100 None Detected

Field ID: 20 Material: Exterior metal siding Color: Gray Location: Red exterior Sample# 23969 NON=100 None Detected

Field ID: 21 Material: Paint red Color: Red Location: Associated with #20 Sample# 23970 NON=080 ASBESTOS DETECTED CHR=020

****End of Report****

Legend (All sample results represent percentages: EX: 001=1%) TR(Trace)=<1%
Asbestos Minerals: Chrysotile=CHR, Amosite=AMO, Crocidolite=CRO, Actinolite=ACT, Tremolite=TRE, Anthophyllite=ANT
Fibrous Materials: Fiberglass=FBG, Mineral Wool=MNW, Cellulose=CEL, Hair=HAR, Synthetic=SYN, Other=OTH, Non-Fibrous=NON

Accolade

P O Box 1256
Plaistow, NH 03865

Invoice

Date	Invoice #
10/3/2011	2076

Bill To
Portsmouth Water & Sewer Dept. 680 Peverly Hill Road Portsmouth, NH 03801

JOB NUMBER/PO #

Description	Amount
61 Freshet Road, Madbury, NH. Collect samples of building materials suspect to contain asbestos. Provide analytical from an accredited laboratory. Price includes written report.	950.00
Thank you for your business.	Total 950.00

Phone #	Fax #
603-608-6545	603-642-6179

Accolade Environmental Contracting, Corp.
PO Box 1256, Plaistow, NH. 03865
Telephone (603) 608-6545 aeccorp@hotmail.com

PROPOSAL

<i>Proposal submitted to:</i>	<i>Project Name / Location:</i>
Mr. Peter Rice	61 Freshette Road
Portsmouth Water & Sewer Department	Madbury, MA
680 Peverly Hill Road	October 3, 2011
Portsmouth, NH 03081	
Telephone (603) 766 1416 <i>phrice@cityofportsmouth.com</i>	

Accolade is pleased to offer this proposal for the above referenced property.

Proper removal and disposal of all asbestos materials as identified in provided asbestos report. Price includes NH DES Notification and cost of independent consultant for post abatement testing services.

Asbestos \$10,900.

Collection of lamps/ballst's \$800.

Collection of CFC's \$400.


Total cost of this proposal \$12,100.

All work to be performed in compliance with all Local, State and Federal regulations
We propose to furnish equipment, material and labor to complete in accordance w/ the
above specifications, for the sum of as specified above. Proposal valid for 30 days
Payment to be made as follows: Net 5

Interest charge of 2% per month will be charged on all outstanding balances.
All materials guaranteed to be as specified. All work to be completed in a workmanlike manner
according to standard practices. Any alternations or deviations from above specifications
involving extra cost will be executed only upon written orders and will become an extra charge
over and above the estimate. All agreements contingent upon strikes, accidents or delays
beyond our control. Owner to carry fire, tornado and other necessary insurance. Owner agrees
to pay all costs associated with collection. Our work force fully covered by Workers
Compensation Insurance.

AEC, Corp.

Authorized Signature: _____

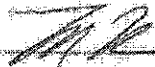

CUSTOMER SIGNATURE: _____

This signature authorizes work as specified. Payment as outlined above.

Request for Taxpayer Identification Number and Certification

Give form to the requester. Do NOT send to the IRS.

Name (if a joint account or you changed your name, see Specific Instructions on page 2)
ACCOLADE ENVIRONMENTAL CONTRACTING, COOP

Business name, if different from above. (See Specific Instructions on page 2)

Check appropriate box: Individual/Sole proprietor Corporation Partnership Other

Address (number, street, and apt. or suite no.)
PO Box 1256

City, state, and ZIP code
PLAISTOW NH 03865

Requester's name and address (optional)

Part I Taxpayer Identification Number (TIN)

Enter your TIN in the appropriate box. For individuals, this is your social security number (SSN). However, if you are a resident alien OR a sole proprietor, see the instructions on page 2. For other entities, it is your employer identification number (EIN). If you do not have a number, see **How To Get a TIN** on page 2.

Note: If the account is in more than one name, see the chart on page 2 for guidelines on whose number to enter.

Social security number
| | + | + | + | + |

OR

Employer identification number
2238940619

List account number(s) here (optional)


Part III For Payees Exempt From Backup Withholding (See the instructions on page 2.)

Part III Certification

Under penalties of perjury, I certify that:

- The number shown on this form is my correct taxpayer identification number (or I am waiting for a number to be issued to me), and
- I am not subject to backup withholding because: (a) I am exempt from backup withholding, or (b) I have not been notified by the Internal Revenue Service (IRS) that I am subject to backup withholding as a result of a failure to report all interest or dividends, or (c) the IRS has notified me that I am no longer subject to backup withholding.

Certification Instructions.—You must cross out item 2 above if you have been notified by the IRS that you are currently subject to backup withholding because you have failed to report all interest and dividends on your tax return. For real estate transactions, item 2 does not apply. For mortgage interest paid, acquisition or abandonment of secured property, cancellation of debt, contributions to an individual retirement arrangement (IRA), and generally, payments other than interest and dividends, you are not required to sign the Certification, but you must provide your correct TIN. (See the instructions on page 2.)

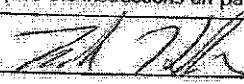Sign Here: Signature  Date **3/3/2006**

Purpose of Form.—A person who is required to file an information return with the IRS must get your correct taxpayer identification number (TIN) to report, for example, income paid to you, real estate transactions, mortgage interest you paid, acquisition or abandonment of secured property, cancellation of debt, or contributions you made to an IRA.

Use Form W-9 to give your correct TIN to the person requesting it (the requester) and, when applicable, to:

- Certify the TIN you are giving is correct (or you are waiting for a number to be issued).
- Certify you are not subject to backup withholding, or
- Claim exemption from backup withholding if you are an exempt payee.

Note: If a requester gives you a form other than a W-9 to request your TIN, you must use the requester's form if it is substantially similar to this Form W-9.

What Is Backup Withholding?—Persons making certain payments to you must withhold and pay to the IRS 31% of such payments under certain conditions. This is called "backup withholding." Payments that may be subject to backup withholding

include interest, dividends, broker and barter exchange transactions, rents, royalties, nonemployee pay, and certain payments from fishing boat operators. Real estate transactions are not subject to backup withholding.

If you give the requester your correct TIN, make the proper certifications, and report all your taxable interest and dividends on your tax return, payments you receive will not be subject to backup withholding. Payments you receive will be subject to backup withholding if:

- You do not furnish your TIN to the requester, or
- The IRS tells the requester that you furnished an incorrect TIN, or
- The IRS tells you that you are subject to backup withholding because you did not report all your interest and dividends on your tax return (for reportable interest and dividends only), or
- You do not certify to the requester that you are not subject to backup withholding under 3 above (for reportable interest and dividend accounts opened after 1983 only), or

5. You do not certify your TIN when required. See the Part III instructions on page 2 for details.

Certain payees and payments are exempt from backup withholding. See the Part II instructions and the separate **Instructions for the Requester of Form W-9.**

Penalties

Failure To Furnish TIN.—If you fail to furnish your correct TIN to a requester, you are subject to a penalty of \$50 for each such failure unless your failure is due to reasonable cause and not to willful neglect.

Civil Penalty for False Information With Respect to Withholding.—If you make a false statement with no reasonable basis that results in no backup withholding, you are subject to a \$500 penalty.

Criminal Penalty for Falsifying Information.—Willfully falsifying certifications or affirmations may subject you to criminal penalties including fines and/or imprisonment.

Misuse of TINs.—If the requester discloses or uses TINs in violation of Federal law, the requester may be subject to civil and criminal penalties.



Cyn Environmental Services Analytical Laboratory

Customer: City of Portsmouth Job Number: DOV23075
 Location: Portsmouth, NH Waste Code: MA99
 Lab Number: 09012716 Sample Date: 7/19/2013
 Sample ID: 23075 Receipt Date: 7/22/2013
 Sampled By: ES Analysis Date: 7/23/2013
 Sample Matrix: Non Hazardous Solid Report Date: 7/24/2013

HAZ-SCAN SOLID

Method	Analyte	Result	RL	AL	Units
Inorganics					
Closed Cup	Flashpoint	>140	140	>100 / >140	°F
Electrode	pH	6.8	N/A	>2 / <12.5	pH
Spot Test	Cyanides	ND	.5	Compatible	mg/Kg or mg/L
Spot Test	Sulfides	ND	5	Compatible	mg/Kg or mg/L
Organics					
GC/ECD	Polychlorinated Biphenyls	ND	2	<50	mg/Kg
HdSp/PID/FID/HECD	1,1,1-Trichloroethane	ND	0.5	N/A	mg/Kg
HdSp/PID/FID/HECD	1,1,2-Trichloroethane	ND	0.5	N/A	mg/Kg
HdSp/PID/FID/HECD	1,1-Dichloroethene	ND	0.5	<14	mg/Kg
HdSp/PID/FID/HECD	1,2-Dichloroethane	ND	0.5	<10	mg/Kg
HdSp/PID/FID/HECD	1,2-Dichlorobenzene	ND	0.5	<150	mg/Kg
HdSp/PID/FID/HECD	1,4-Dichlorobenzene	ND	0.5	<150	mg/Kg
HdSp/PID/FID/HECD	Acetone	ND	5.0	N/A	mg/Kg
HdSp/PID/FID/HECD	Benzene	ND	0.5	<10	mg/Kg
HdSp/PID/FID/HECD	Carbon Tetrachloride	ND	0.5	<10	mg/Kg
HdSp/PID/FID/HECD	Chlorobenzene	ND	0.5	<2000	mg/Kg
HdSp/PID/FID/HECD	Chloroform	ND	0.5	<120	mg/Kg
HdSp/PID/FID/HECD	Ethylbenzene	ND	0.5	N/A	mg/Kg
HdSp/PID/FID/HECD	Freon 113	ND	0.5	N/A	mg/Kg
HdSp/PID/FID/HECD	Methylene Chloride	ND	0.5	N/A	mg/Kg
HdSp/PID/FID/HECD	Methyl Ethyl Ketone	ND	5.0	<4000	mg/Kg
HdSp/PID/FID/HECD	Methyl isobutyl Ketone	ND	5.0	N/A	mg/Kg
HdSp/PID/FID/HECD	Tetrachloroethylene	ND	0.5	<14	mg/Kg
HdSp/PID/FID/HECD	Toluene	ND	0.5	N/A	mg/Kg
HdSp/PID/FID/HECD	Trichloroethylene	ND	0.5	<10	mg/Kg
HdSp/PID/FID/HECD	Trichlorofluoromethane	ND	0.5	N/A	mg/Kg
HdSp/PID/FID/HECD	Vinyl Chloride	ND	0.5	<4	mg/Kg
HdSp/PID/FID/HECD	Xylene (total)	ND	0.5	N/A	mg/Kg
HdSp/PID/FID/HECD	Methanol	ND	1.0	N/A	% w/w
Metals					
X-ray Fluorescence	Total Lead	ND	2.0	<100	mg/Kg
X-ray Fluorescence	Total Chromium	7.3	1.0	<100	mg/Kg
X-ray Fluorescence	Total Arsenic	3.0	1.0	<100	mg/Kg
X-ray Fluorescence	Total Cadmium	ND	1.0	<20	mg/Kg
X-ray Fluorescence	Total Mercury	ND	1.0	<4.0	mg/Kg
X-ray Fluorescence	Total Barium	64	9.0	<2000	mg/Kg
X-ray Fluorescence	Total Selenium	1.6	1.0	<20	mg/Kg
X-ray Fluorescence	Total Silver	ND	1.0	<100	mg/Kg
X-ray Fluorescence	TCLP Lead	N/A	0.5	5.0	mg/L
X-ray Fluorescence	TCLP Chromium	N/A	0.5	5.0	mg/L
X-ray Fluorescence	TCLP Arsenic	N/A	0.5	5.0	mg/L
X-ray Fluorescence	TCLP Cadmium	N/A	0.5	1.0	mg/L
X-ray Fluorescence	TCLP Mercury	N/A	0.2	0.2	mg/L
X-ray Fluorescence	TCLP Barium	N/A	10	100.0	mg/L
X-ray Fluorescence	TCLP Selenium	N/A	0.5	1.0	mg/L
X-ray Fluorescence	TCLP Silver	N/A	0.5	5.0	mg/L

* TCLP takes precedence
 AL = Facility Acceptance Limit
 N/A = Not Applicable
 ND = Not Detected ABOVE Reporting Limit
 RL = Laboratory Reporting Limit

Notes: None.


Submitted By: 

07/24/13


Approved By: 

07/24/13

P.O. Box 0119 · 1771 WASHINGTON STREET · STOUGHTON, MA 02072-0119 · TELEPHONE 781.341.5108 · FAX 781.344.3318
 TOLL FREE 1.800.899.1038


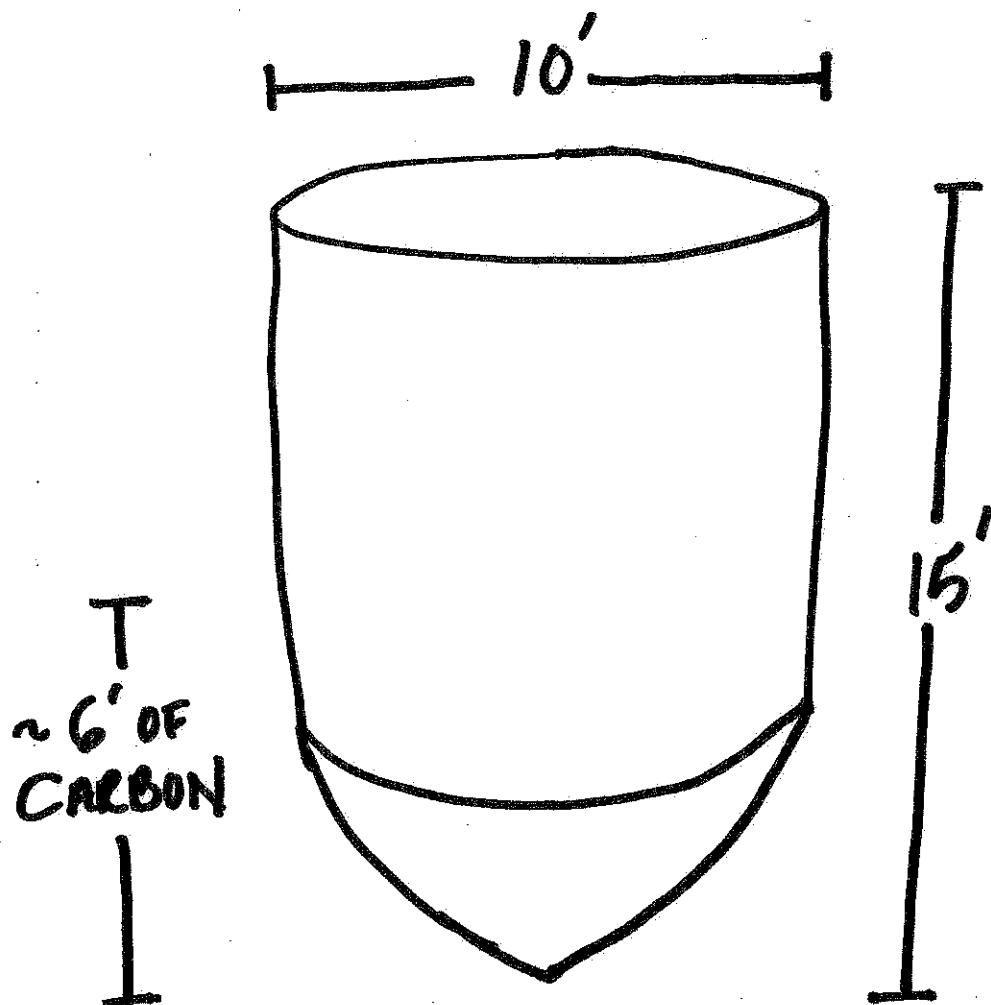


6 GRANULAR ACTIVATED CARBON TANK
TANK MATERIAL: 516 GRADE 70 CARBON STEEL
VOLUME: APPROXIMATELY 9,125 GALLONS
PER TANK
ESTIMATED VOLUME OF CARBON: 8,350 lbs.
PER TANK

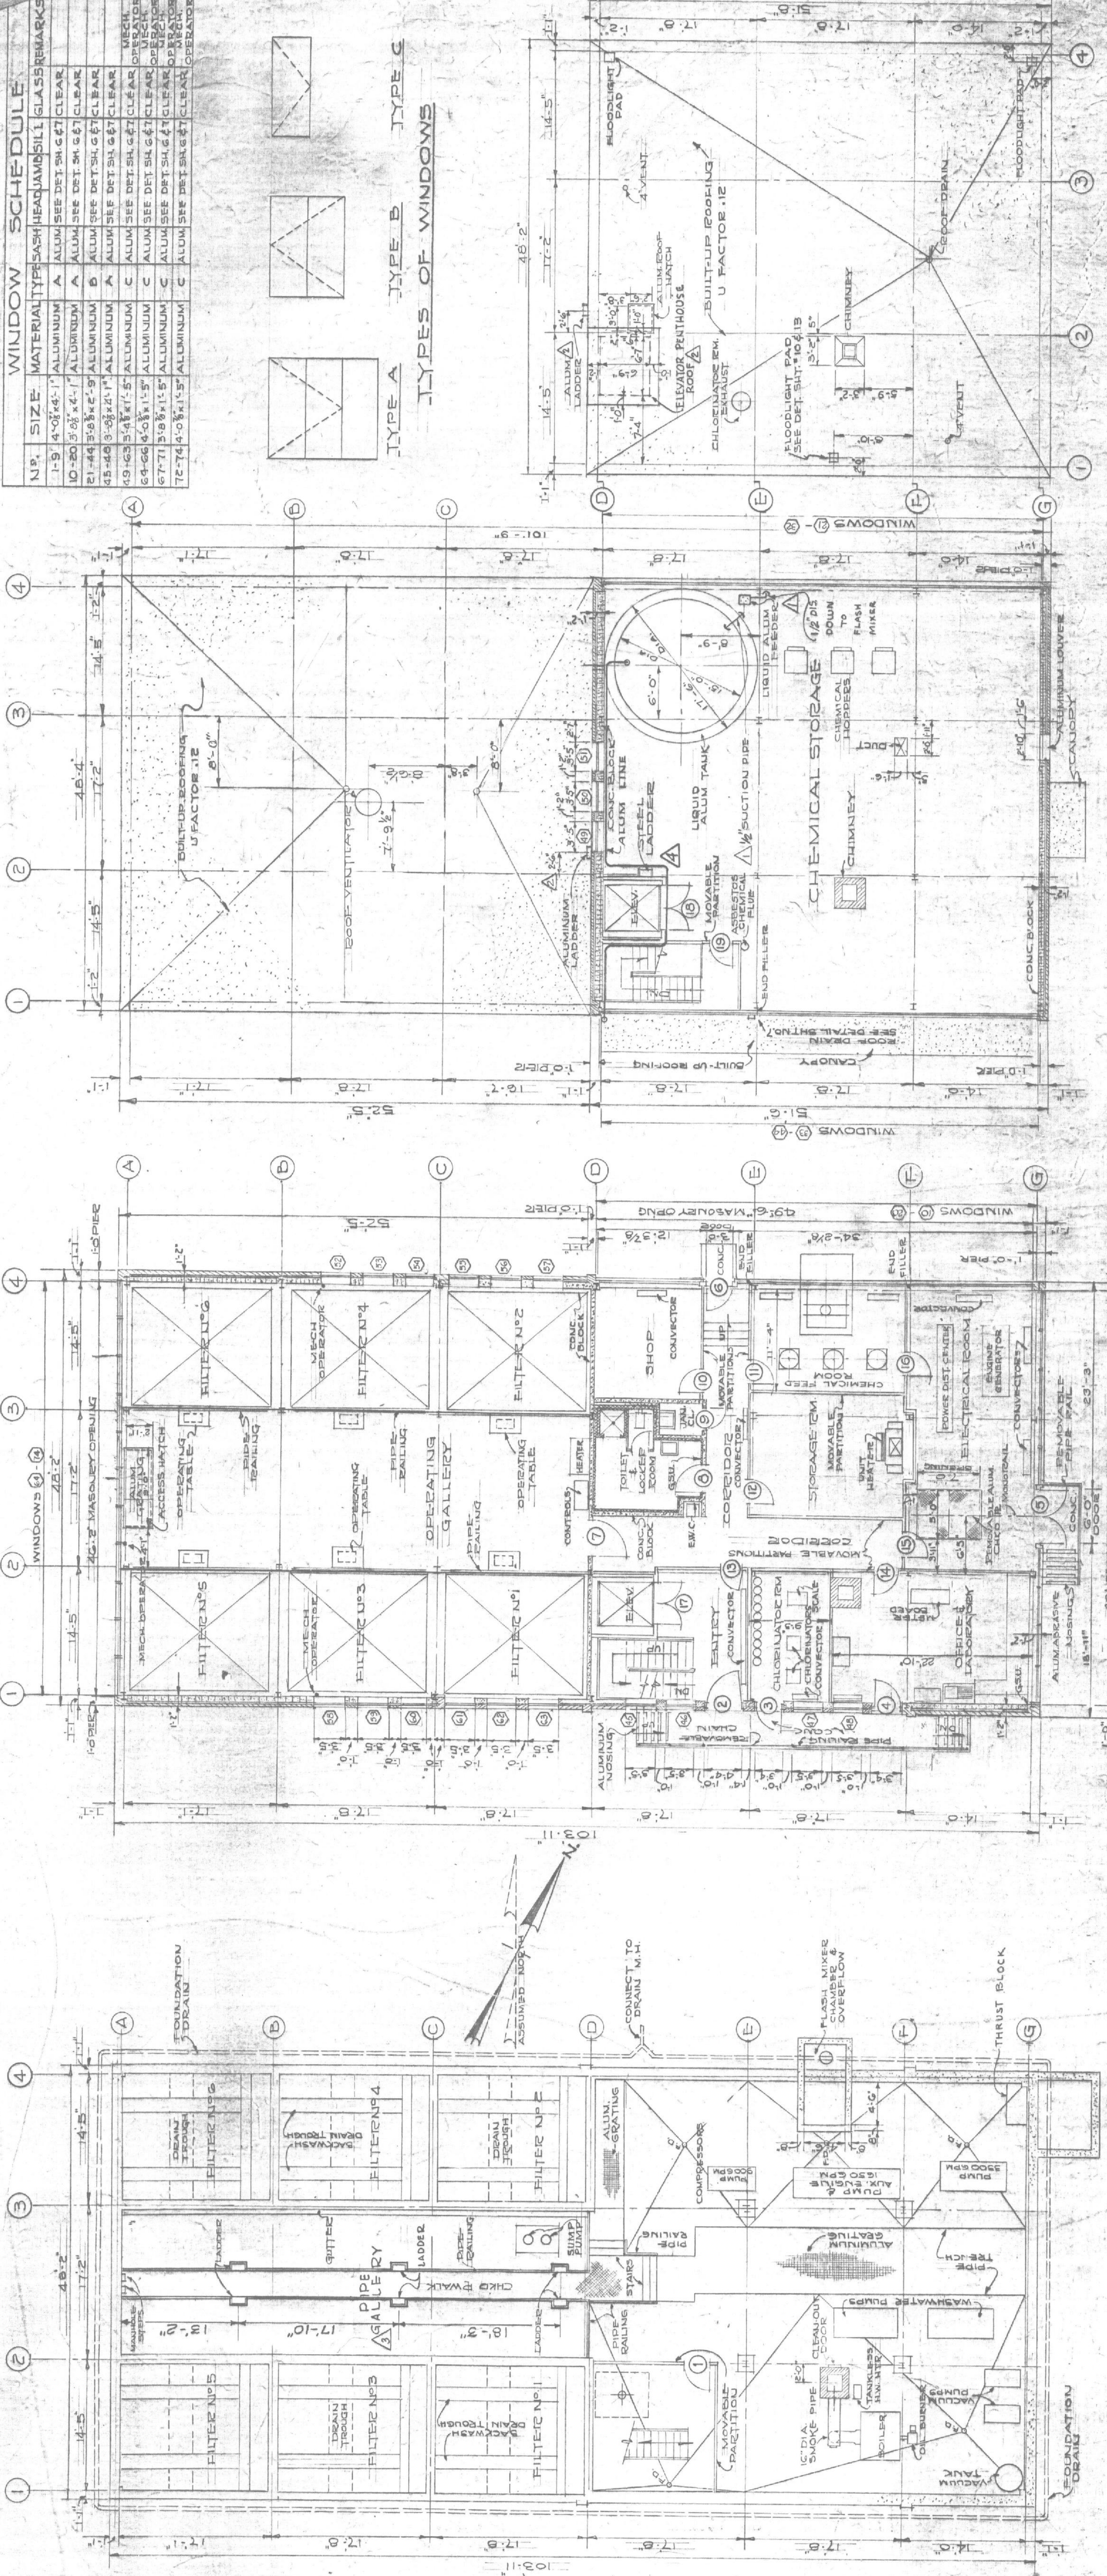

WINDOW SCHEDULE

NO.	SIZE	MATERIAL	TYPESASH	HEAD	SILL	GLASS	REMARKS
1-9	4'-0" x 4'-1"	ALUMINUM	A	ALUM	SEE DET. 54	6-8	CLEAR
10-20	3'-0" x 4'-1"	ALUMINUM	B	ALUM	SEE DET. 54	6-8	CLEAR
21-44	3'-0" x 4'-1"	ALUMINUM	C	ALUM	SEE DET. 54	6-8	CLEAR
45-48	3'-0" x 4'-1"	ALUMINUM	D	ALUM	SEE DET. 54	6-8	CLEAR
49-53	3'-0" x 4'-1"	ALUMINUM	E	ALUM	SEE DET. 54	6-8	CLEAR
54-56	4'-0" x 1'-5"	ALUMINUM	F	ALUM	SEE DET. 54	6-8	CLEAR
57-71	3'-0" x 1'-5"	ALUMINUM	G	ALUM	SEE DET. 54	6-8	CLEAR
72-74	4'-0" x 1'-5"	ALUMINUM	H	ALUM	SEE DET. 54	6-8	CLEAR

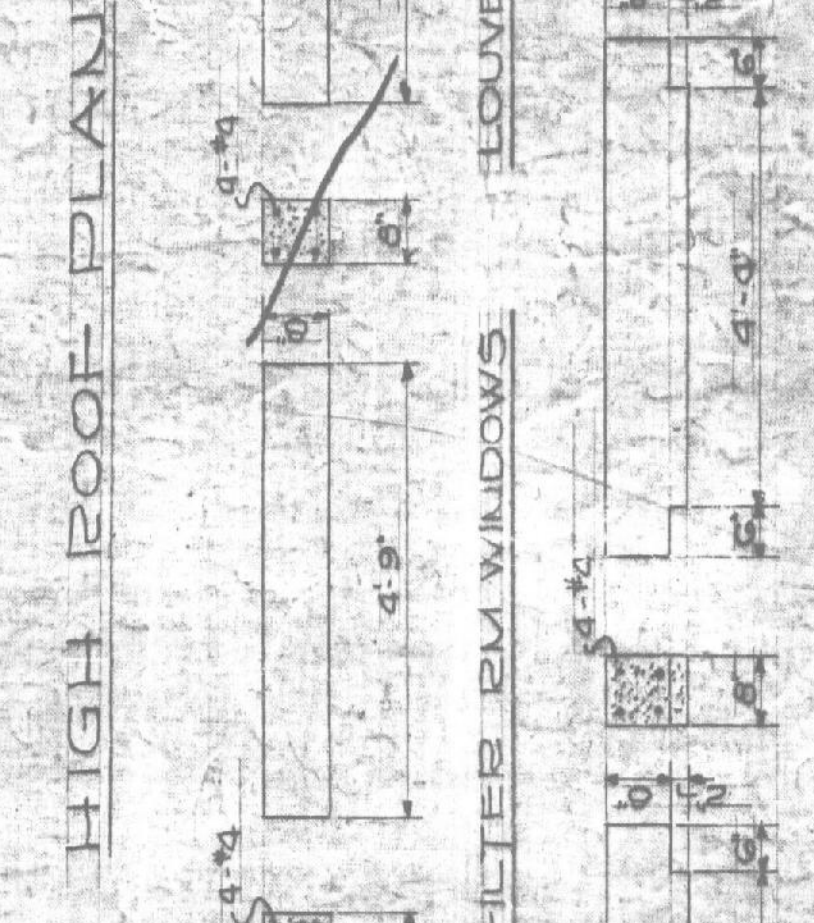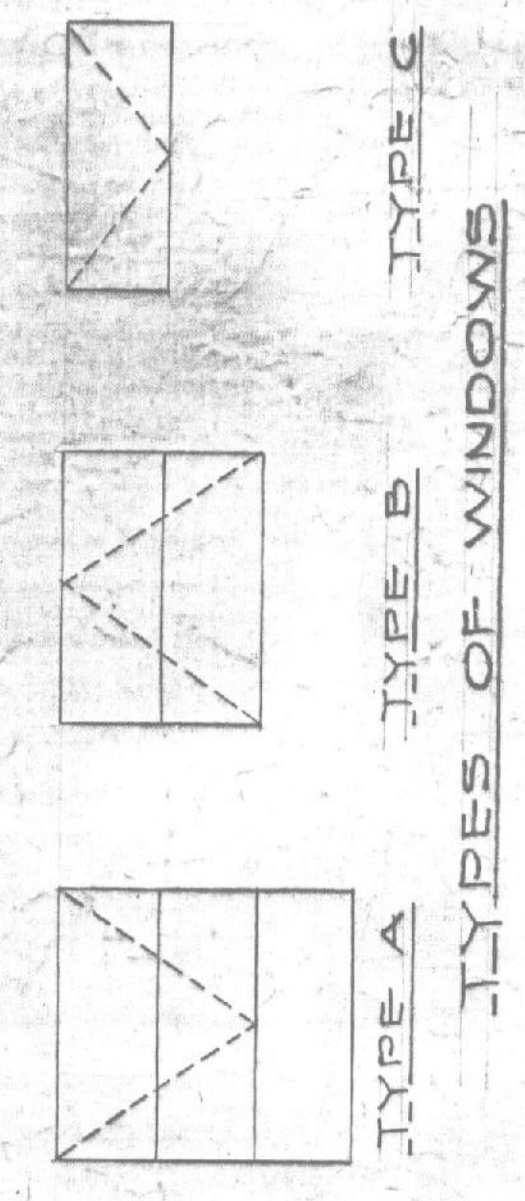

SECOND FLOOR PLAN

FIRST FLOOR PLAN

BASEMENT PLAN

NORTH ELEVATION

EAST ELEVATION

SOUTH ELEVATION

WEST ELEVATION

REVISIONS

NO.	DATE	DESCRIPTION
1	10-11-51	ALUM LINE RELOCATED (FC)
2	1-14-52	LADDERS RELOCATED (C.C)
3	1-14-52	HIGH ROOF PLAN & ELEVATIONS REVISIONS (SEE ELEVATIONS)
4	4-14-52	FILTER BUILDING LINES RELOCATED (A.D.D. 14-52)

Record Drawing
 Contract No. DA-19-016-ENG-6199

EXTERIOR PRECAST CONCRETE UNIT

DOOR N.E. 3

DOOR N.E. 2

DOOR N.E. 1

DOOR N.E. 4

DOOR N.E. 5




DOOR N.E. 6

WHITMAN & HOWARD, INC.
 89 BROAD ST., BOSTON, MASS.
 CORPUS OF ENGINEERS (U.S. ARMY)
 OFFICE OF THE DIVISION ENGINEER
 NEW ENGLAND DIVISION
 WALTHAM, MASS.

PEASE AIR FORCE BASE
 PORTSMOUTH, NEW HAMPSHIRE
SURFACE WATER SUPPLY
 FILTER BUILDING



DESIGNED BY: [Signature]
 CHECKED BY: [Signature]
 SUBMITTED BY: [Signature]
 APPROVED BY: [Signature]

SCALE: AS SHOWN
 DATE: JUNE, 1952
 DRAWING NUMBER: AN 71-05-31
 SHEET: []

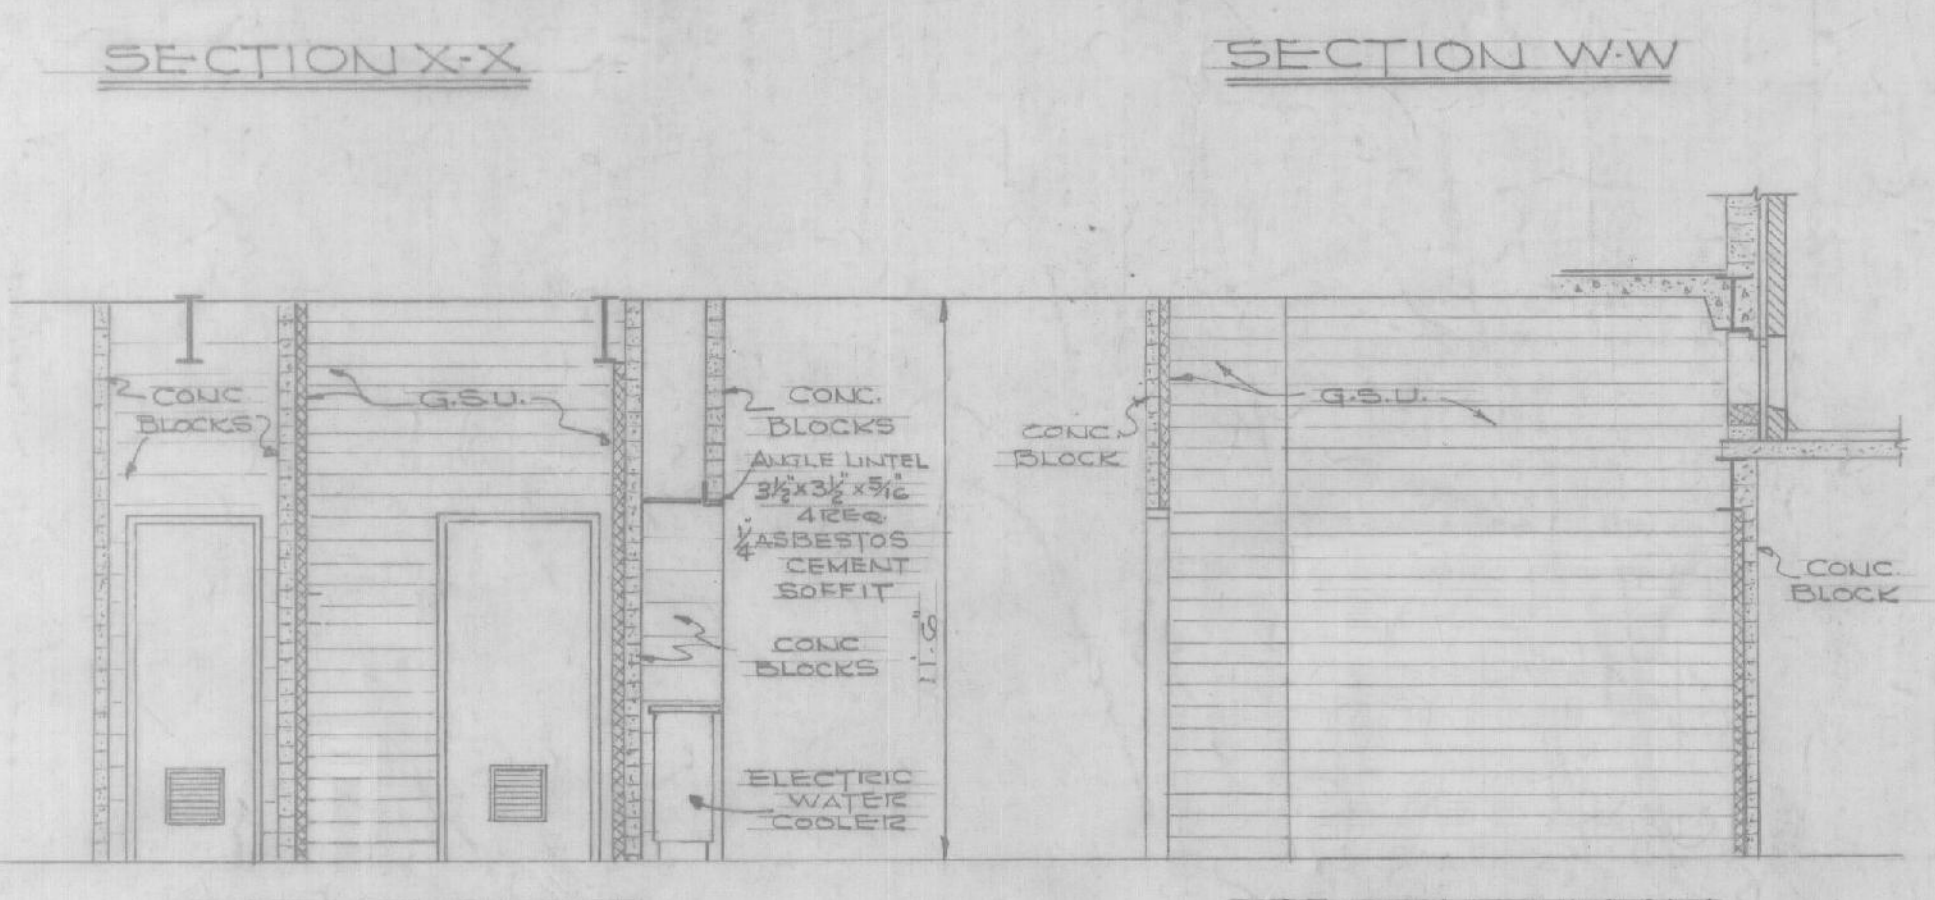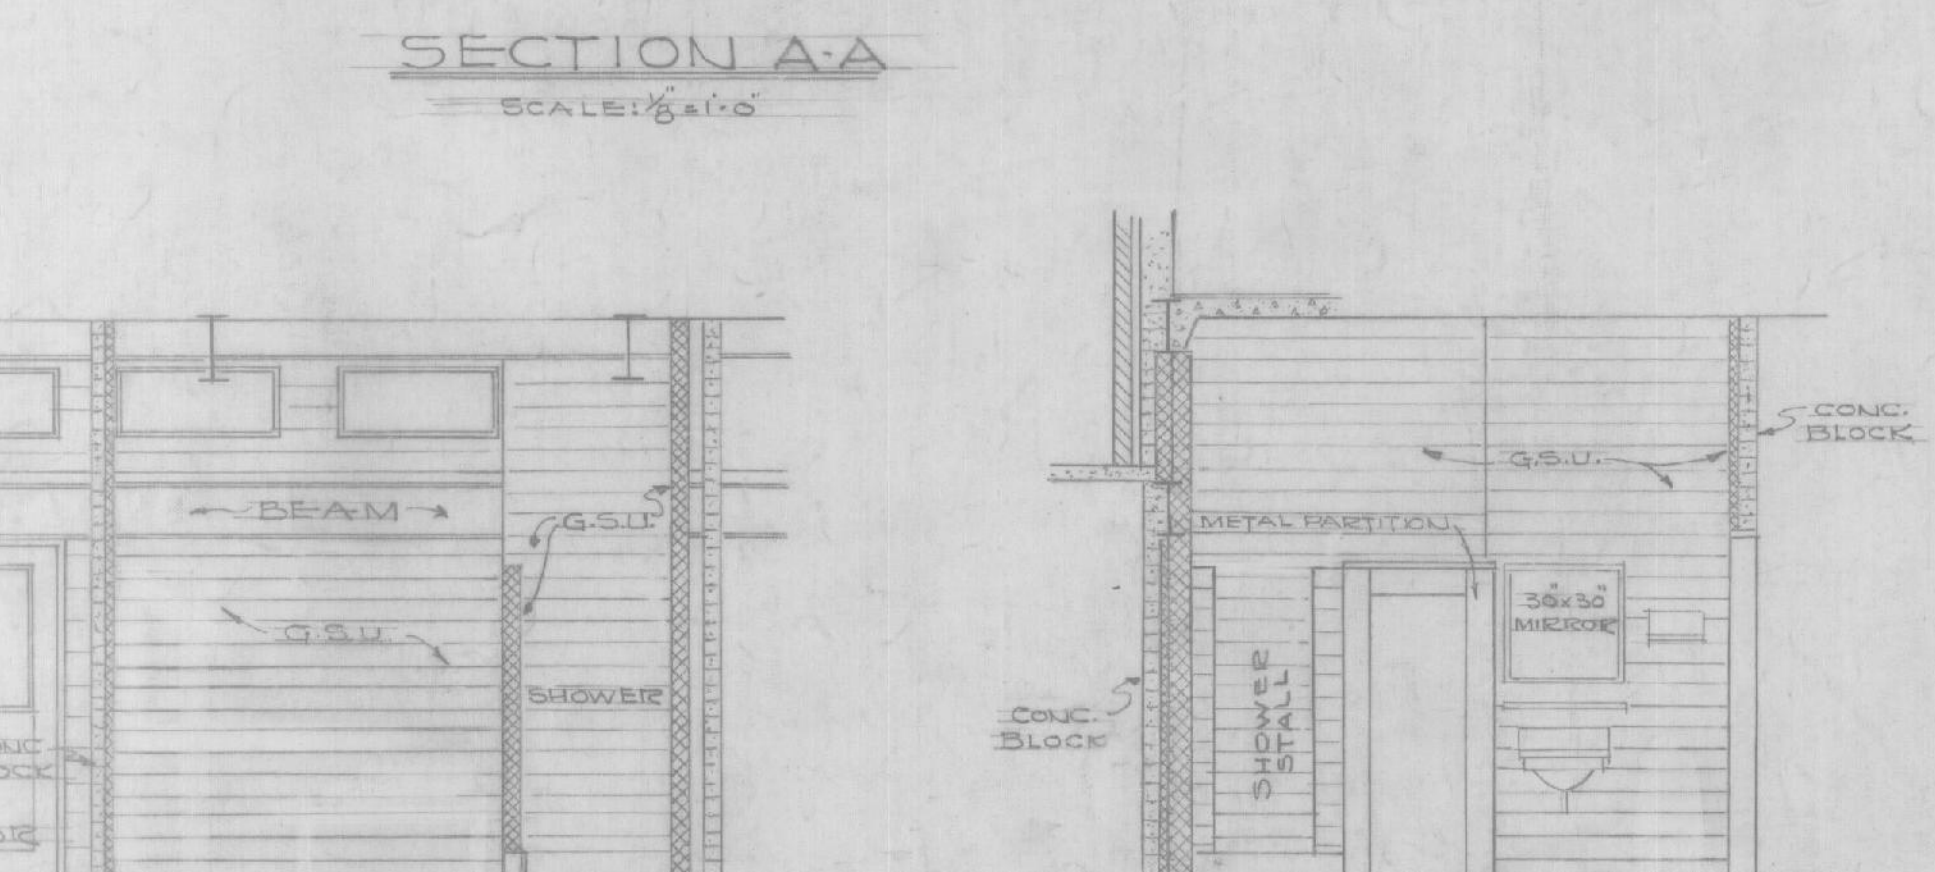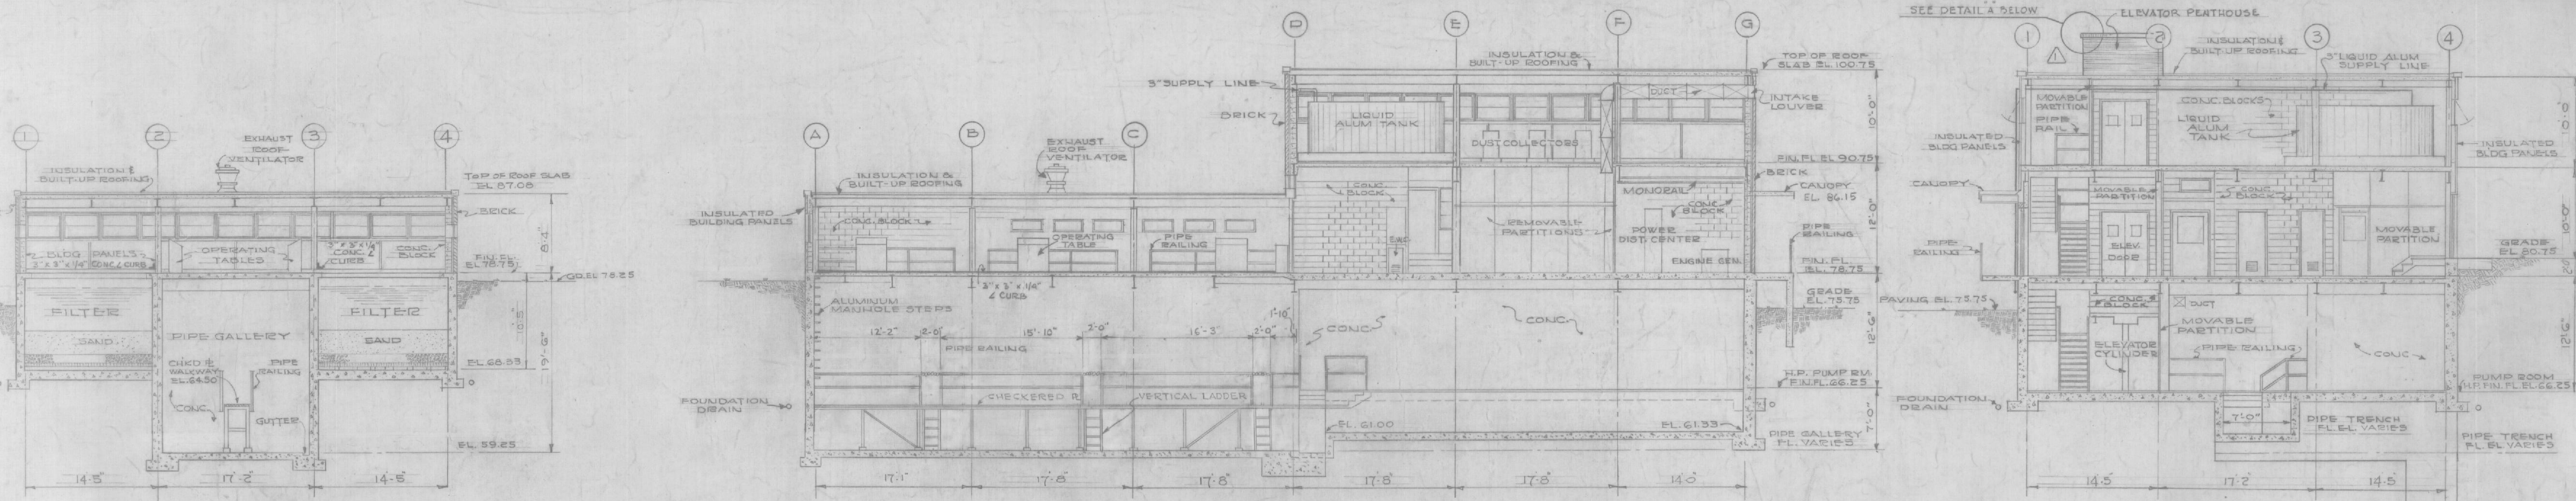

DOOR SCHEDULE									
NO.	SIZE	MATERIAL	TYPE	FRAME	HEAD	JAMB	SILL	GLASS	REMARKS
1	2'-11" x 6'-10" x 1 3/4"	ASBESTOS CEM.	B	WOOD	FOR MOVABLE PARTITION	CLEAR	CLEAR	SEE DETAIL SHT. 5	
2	4'-0" x 7'-0" x 1 3/4"	ALUMINUM	A	ALUM.	SEE DETAILS SHT. 7	NONE	NONE		
3	3'-0" x 7'-0" x 1 3/4"	ALUMINUM	A	ALUM.	SEE DETAILS SHT. 7	NONE	NONE		
4	2'-3" x 7'-0" x 1 3/4"	ALUMINUM	A	ALUM.	SEE DETAILS SHT. 7	NONE	NONE		
5	4'-0" x 6'-8" x 1 3/4"	HOLLOW METAL	D	STEEL	H-3	J-3	S-2	CLEAR	
6	3'-0" x 7'-0" x 1 3/4"	HOLLOW METAL	C	STEEL	H-1	J-1	S-1	NONE	CONC. LINTEL L-1
7	2'-6" x 7'-0" x 1 3/4"	HOLLOW METAL	C	STEEL	H-2	J-2	S-2	NONE	CONC. LINTEL L-2
8	2'-11" x 6'-10" x 1 3/4"	ASBESTOS CEM.	B	WOOD	FOR MOVABLE PARTITION	CLEAR	CLEAR	SEE DETAIL SHT. 5	
9	2'-11" x 6'-10" x 1 3/4"	ASBESTOS CEM.	B	WOOD	FOR MOVABLE PARTITION	CLEAR	CLEAR	SEE DETAIL SHT. 5	
10	2'-11" x 6'-10" x 1 3/4"	ASBESTOS CEM.	B	WOOD	FOR MOVABLE PARTITION	CLEAR	CLEAR	SEE DETAIL SHT. 5	
11	2'-11" x 6'-10" x 1 3/4"	ASBESTOS CEM.	B	WOOD	FOR MOVABLE PARTITION	CLEAR	CLEAR	SEE DETAIL SHT. 5	
12	2'-11" x 6'-10" x 1 3/4"	ASBESTOS CEM.	B	WOOD	FOR MOVABLE PARTITION	CLEAR	CLEAR	SEE DETAIL SHT. 5	
13	2'-11" x 6'-10" x 1 3/4"	ASBESTOS CEM.	B	WOOD	FOR MOVABLE PARTITION	CLEAR	CLEAR	SEE DETAIL SHT. 5	
14	2'-11" x 6'-10" x 1 3/4"	ASBESTOS CEM.	B	WOOD	FOR MOVABLE PARTITION	CLEAR	4" C.I. THRESHOLD		
15	2'-11" x 6'-10" x 1 3/4"	ASBESTOS CEM.	B	WOOD	FOR MOVABLE PARTITION	CLEAR	CLEAR	SEE DETAIL SHT. 5	
16	2'-11" x 6'-10" x 1 3/4"	ASBESTOS CEM.	B	WOOD	FOR MOVABLE PARTITION	CLEAR	CLEAR	SEE DETAIL SHT. 5	
17	2'-2" x 7'-0" x 1 3/4"	HOLLOW METAL	E	STEEL	SEE DETAIL SHT.	WIRE	CONC. LINTEL L-3		
18	2'-2" x 7'-0" x 1 3/4"	HOLLOW METAL	E	STEEL	SEE DETAIL SHT.	WIRE	CONC. LINTEL L-3		
19	2'-11" x 6'-10" x 1 3/4"	ASBESTOS CEM.	B	WOOD	FOR MOVABLE PARTITION	CLEAR	CLEAR	SEE DETAIL SHT. 5	










INTERIOR FINISH SCHEDULE							
AREA	FLOOR FIN.	FLOOR FILL	BASE	WALLS	DADO	CEILING	REMARKS
PIPE GALLERY	NONE	5" MAX.	NONE	NONE			
PUMP ROOM	CONC. FL. FIN.	5" MAX.	NONE	RUBBED CONC.		EXPOSED	
BOYNT STAIRWELL	CONC. FL. FIN.	5" MAX.	NONE	MOVABLE PART.		EXPOSED	
ENTRY	CONC. FL. FIN.	2 1/2" FOR CONDUIT	NONE	CONC. BLOCK		EXPOSED	
CORRIDOR	CONC. FL. FIN.	2 1/2" FOR CONDUIT	NONE	CONC. BLOCK		EXPOSED	
CHLORINATOR RM.	CONC. FL. FIN.	2 1/2" FOR CONDUIT	NONE	CONC. BLOCK		EXPOSED	
OFFICE & LAB	VINYL PLASTIC TILE	2 1/2" FOR CONDUIT	GOVE G.S.U.	MOVABLE PART.		EXPOSED	
ELECTRICAL RM.	CONC. FL. FIN.	2 1/2" FOR CONDUIT	CONC. FIN.	CONC. BLOCK		EXPOSED	
CHEM. FEED RM.	CONC. FL. FIN.	2 1/2" FOR CONDUIT	NONE	MOVABLE PART.		EXPOSED	
STORAGE RM.	CONC. FL. FIN.	2 1/2" FOR CONDUIT	NONE	MOVABLE PART.		EXPOSED	
TOILET & LOCKER RM.	QUARRY TILE	2 1/2" FOR CONDUIT	GOVE G.S.U.	G.S.U.		EXPOSED	QUARRY TILE SHOWER RECEPTOR
SHOP	CONC. FL. FIN.	2 1/2" FOR CONDUIT	NONE	CONC. BLOCK		EXPOSED	
JANITOR'S CLOSET	CONC. FL. FIN.	2 1/2" FOR CONDUIT	NONE	CONC. BLOCK		EXPOSED	
OPERATING GALLERY	CONC. FL. FIN.	NONE	CONC. FIN.	CONC. BLOCK		EXPOSED	
2ND FL. STAIRWELL	CONC. FL. FIN.	NONE	CONC. FIN.	CONC. BLOCK		EXPOSED	
CHEM. STORAGE	CONC. FL. FIN.	NONE	CONC. FIN.	CONC. BLOCK		EXPOSED	

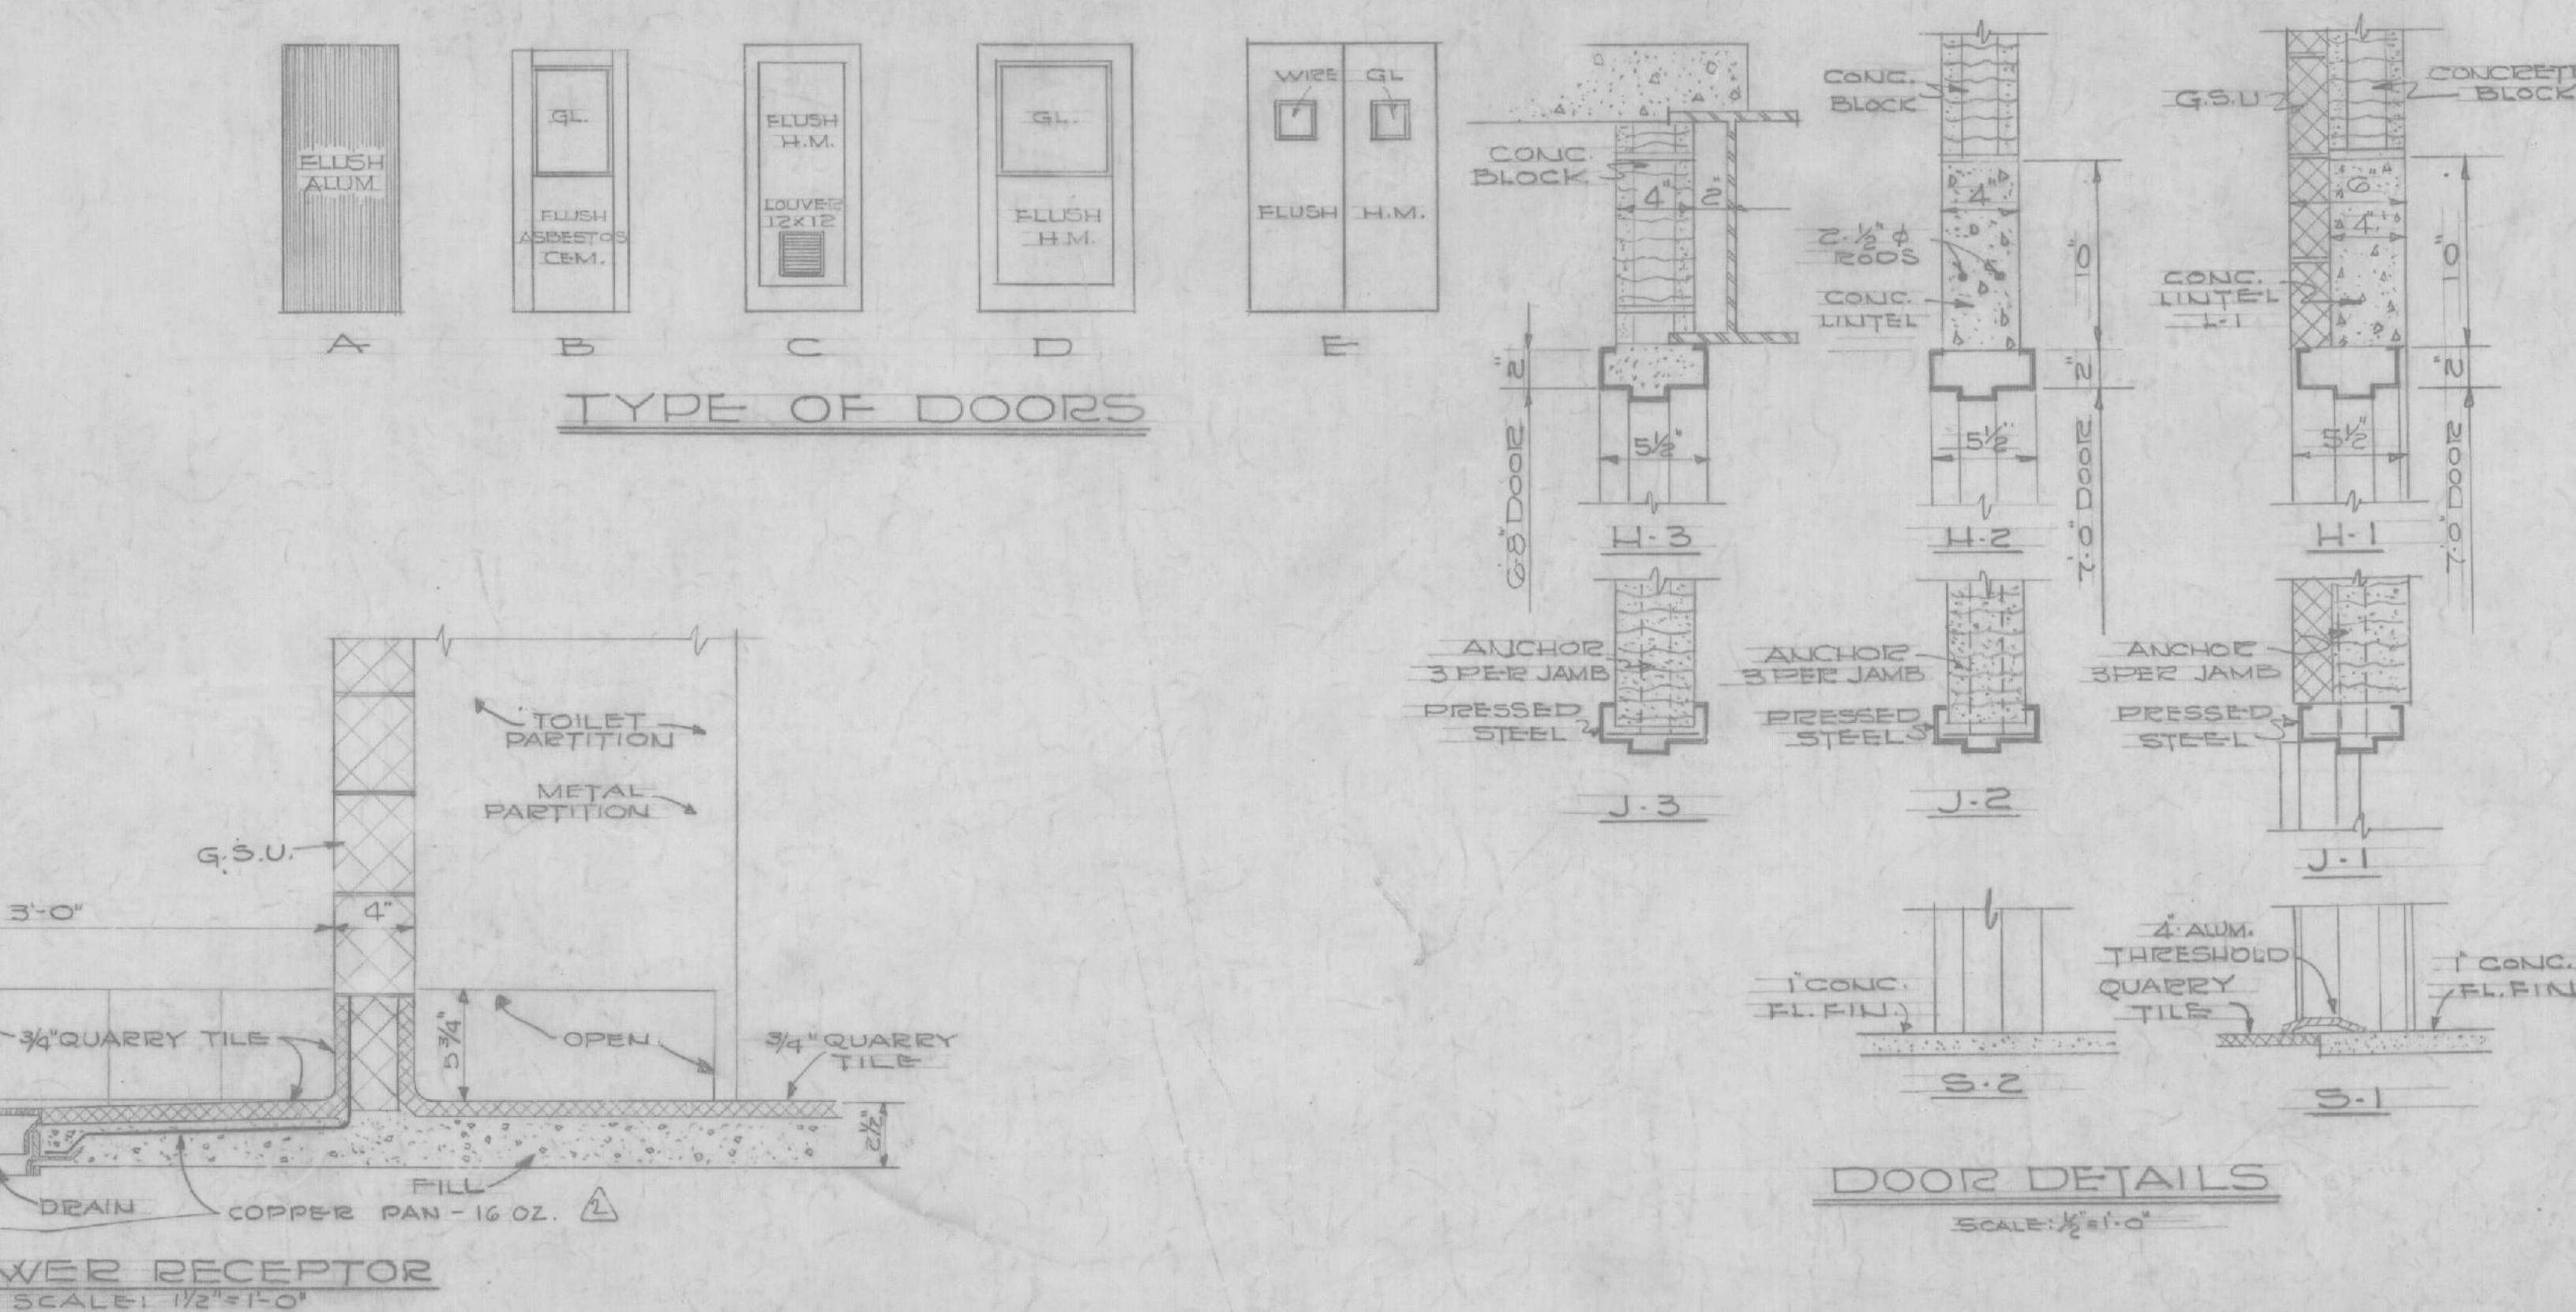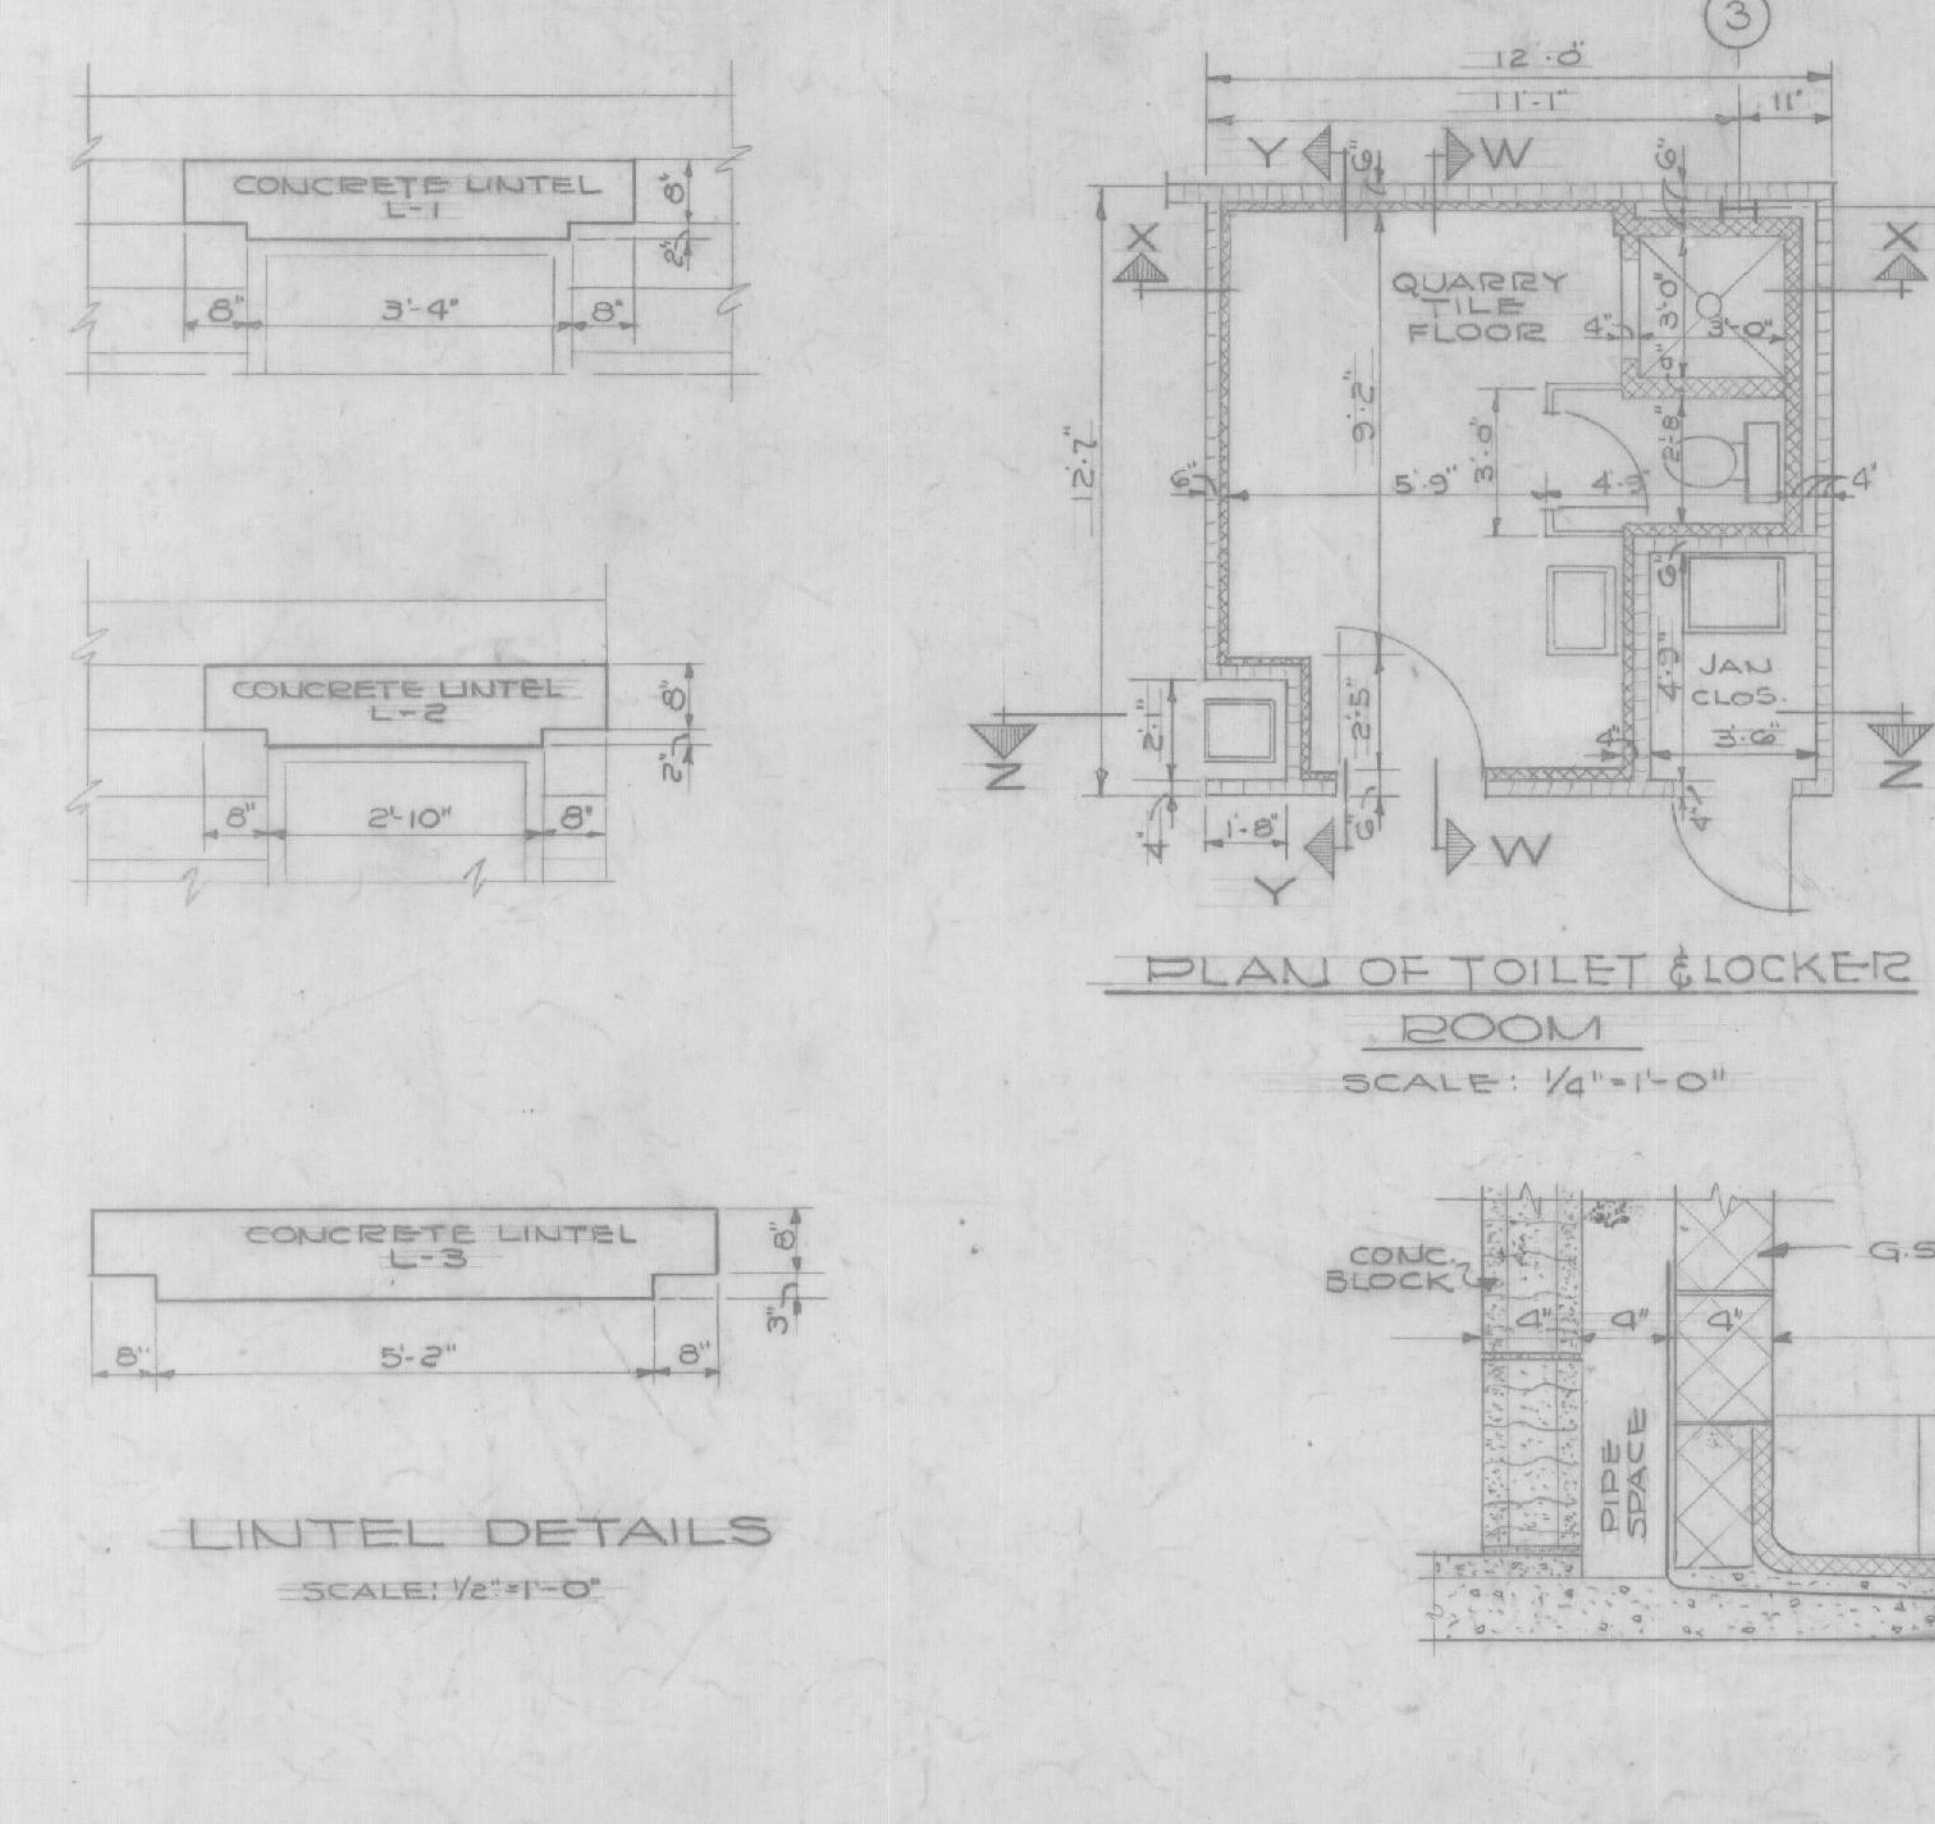

NOTE: PROVIDE JOINT REINFORCEMENT IN BLOCK WALLS AT ALL OPENINGS. FIRST JOINT OVER LINTEL. FIRST TWO JOINTS UNDER ALL SILLS. REINFORCEMENT SHALL TERMINATE 2'-0" BEYOND JAMBS.

Record Drawing
 Contract No. DA-19-016-ENG-6199


10-4-61	Final Field Corrections.		
3-30-60	Shower receptor revised (F.C.)	4/30	4/30
12-14-59	Section C-C revised; detail A added.	4/30	4/30
REVISION DATE	DESCRIPTION	BY	BY
WHITMAN & HOWARD, INC. ENGINEERS 89 BROAD ST. BOSTON, MASS.		CORPS OF ENGINEERS, U. S. ARMY OFFICE OF THE DIVISION ENGINEER NEW ENGLAND DIVISION WALTHAM, MASS.	
DRAWN BY: BEP.	PEASE AIR FORCE BASE PORTSMOUTH, NEW HAMPSHIRE SURFACE WATER SUPPLY FILTER BUILDING ARCHITECTURAL SECTIONS, DETAILS & SCHEDULES		
TRACED BY:	DATE: JUNE 1959		
CHECKED BY: C.G.M.	SCALE AS NOTED		
APPROVED: [Signature]	DRAWING NUMBER: AW71-05-31		
APPROVED: [Signature]	SHEET 5		

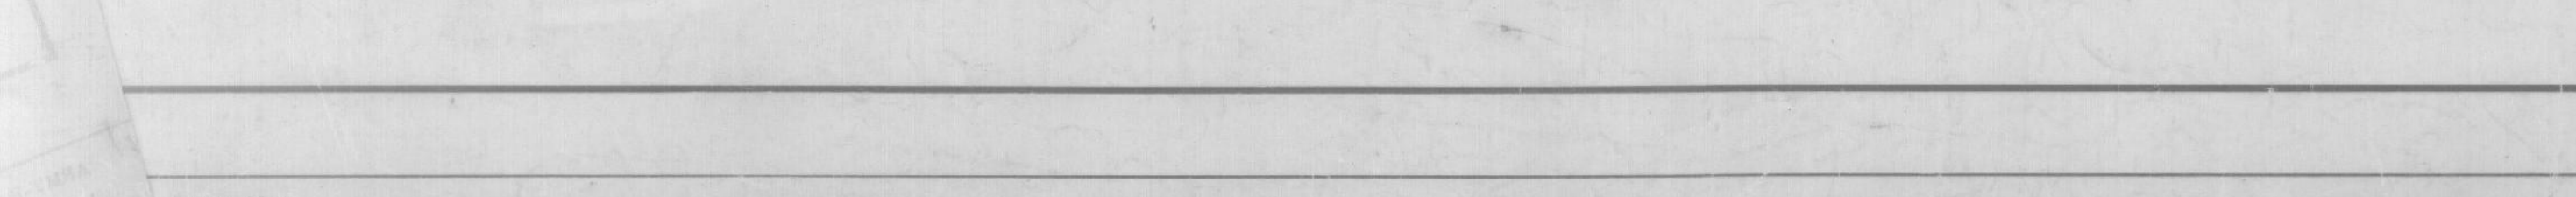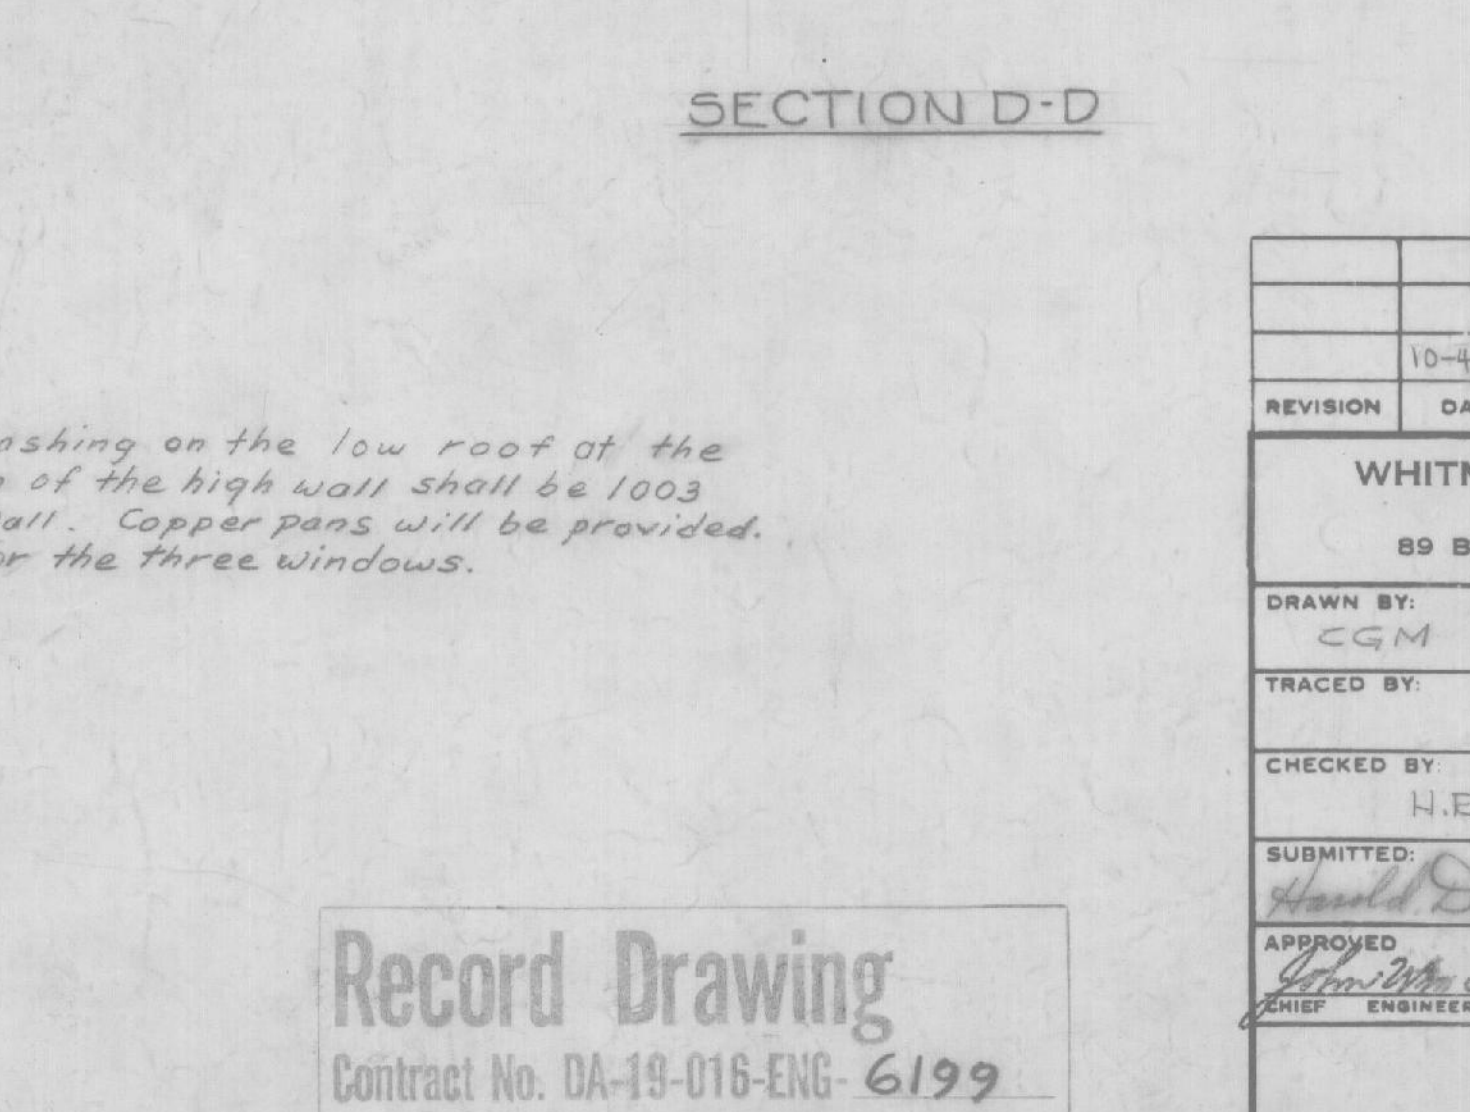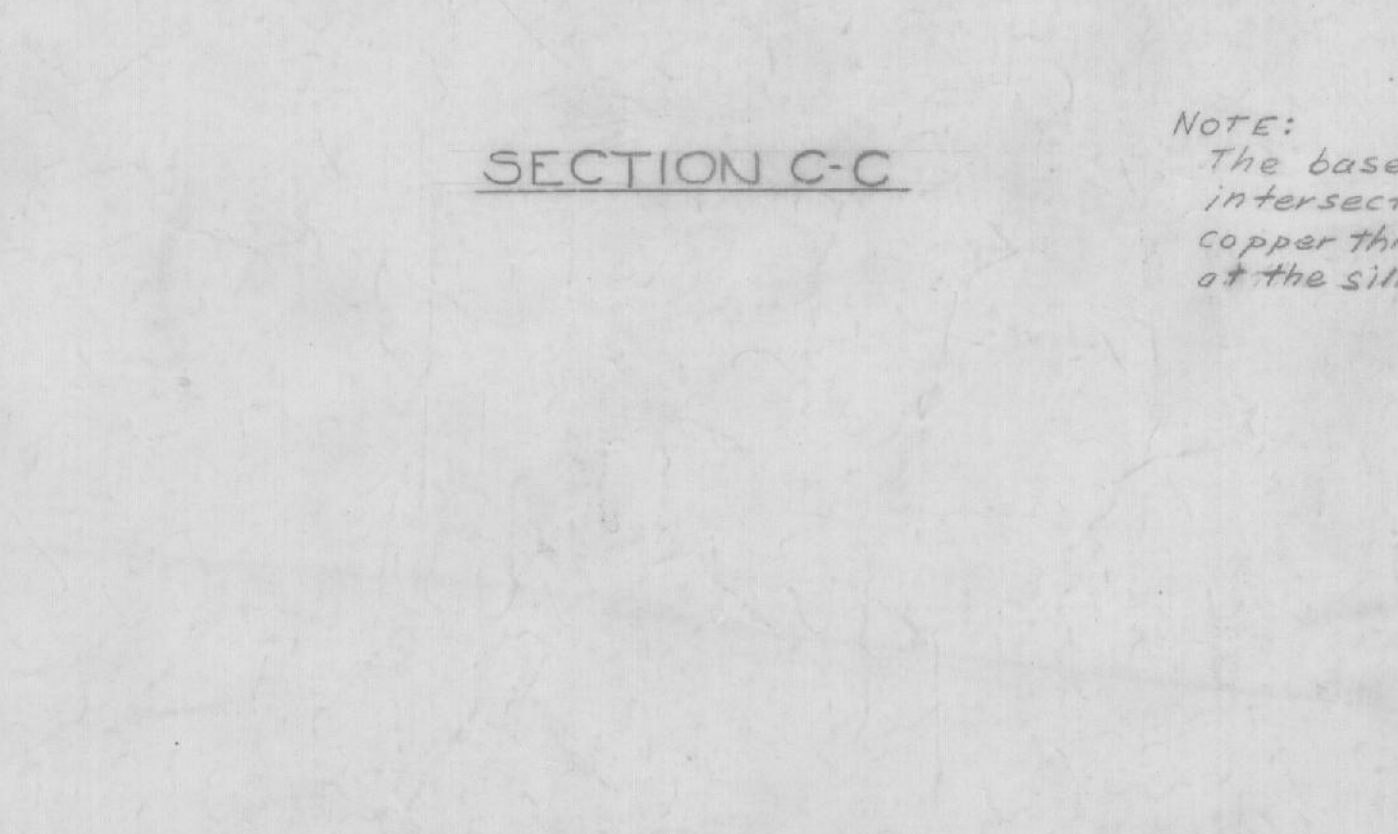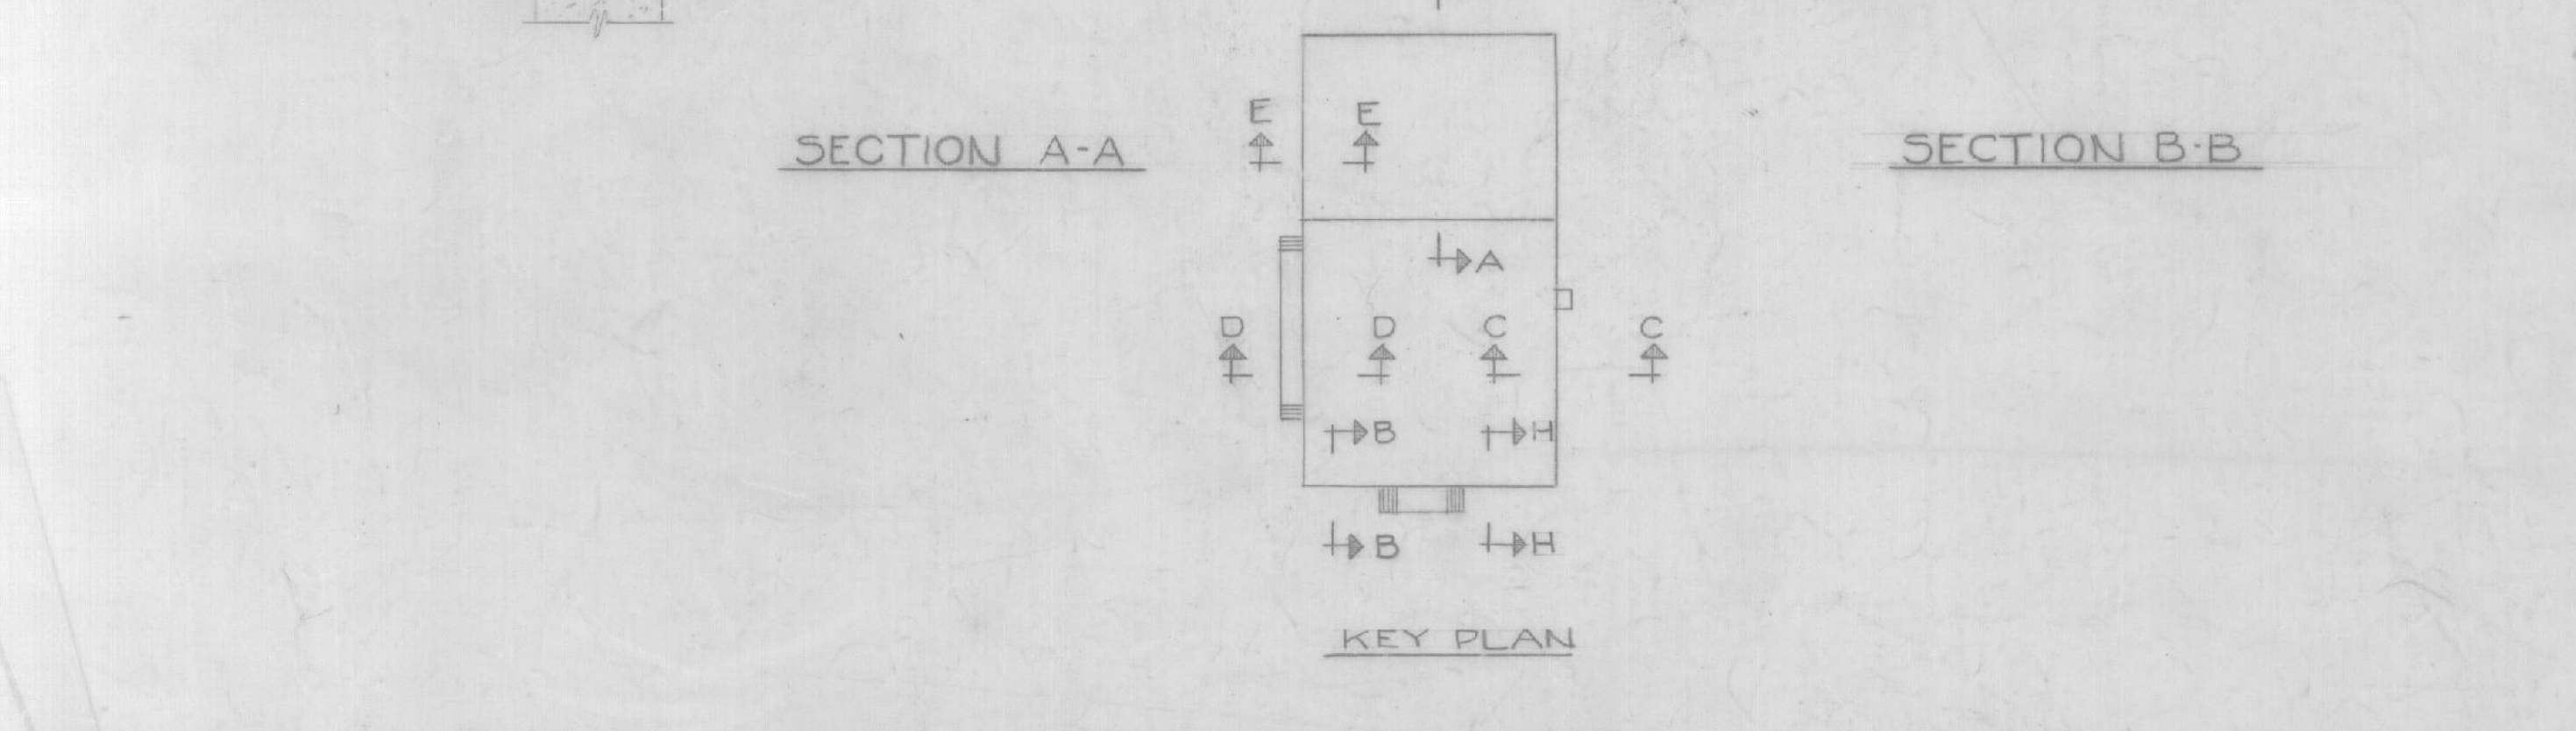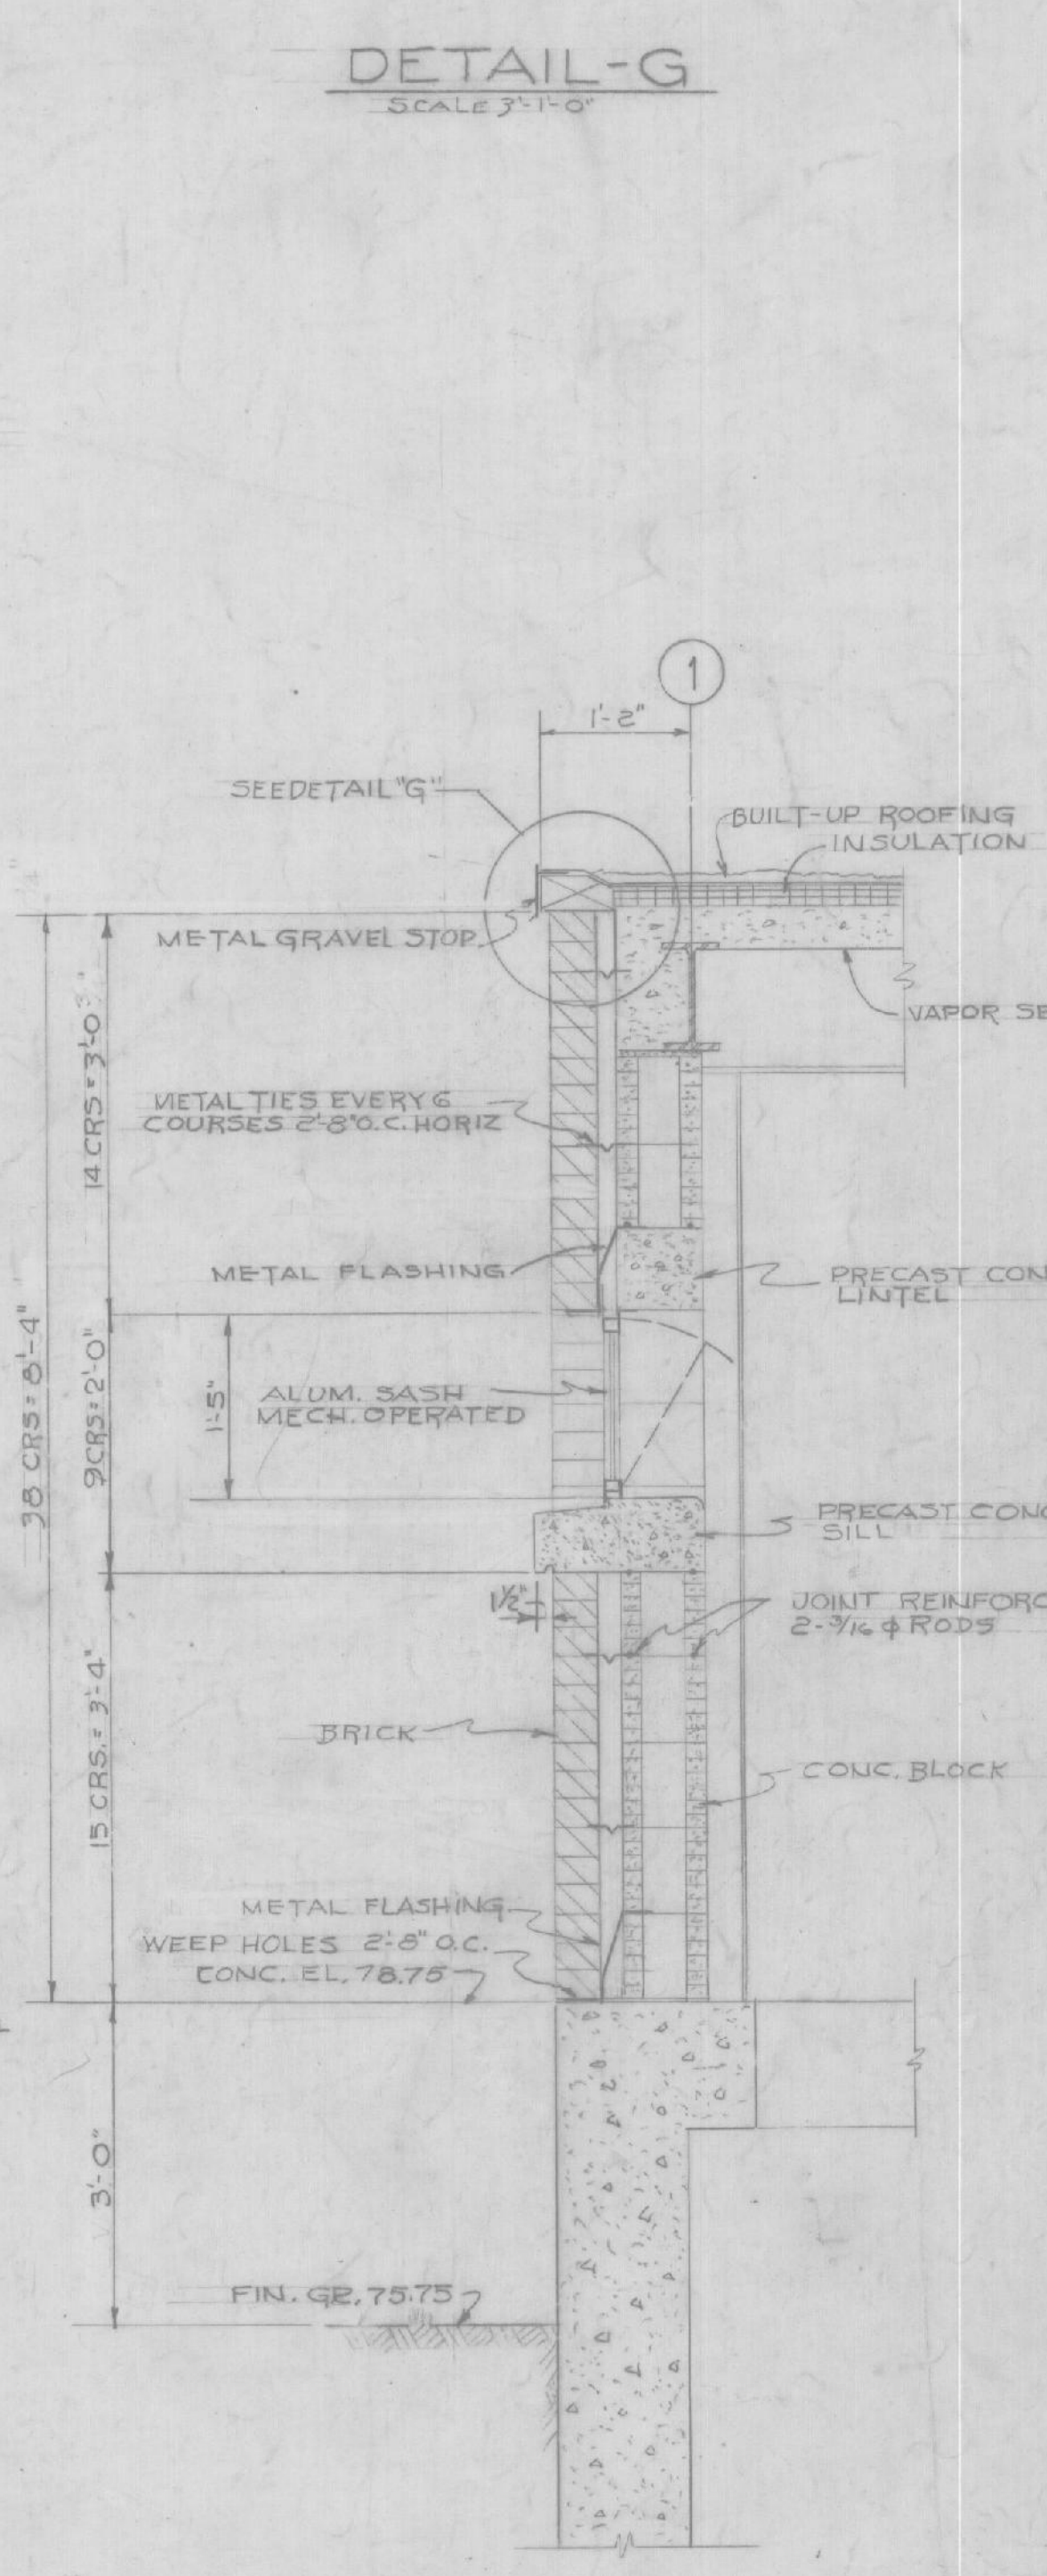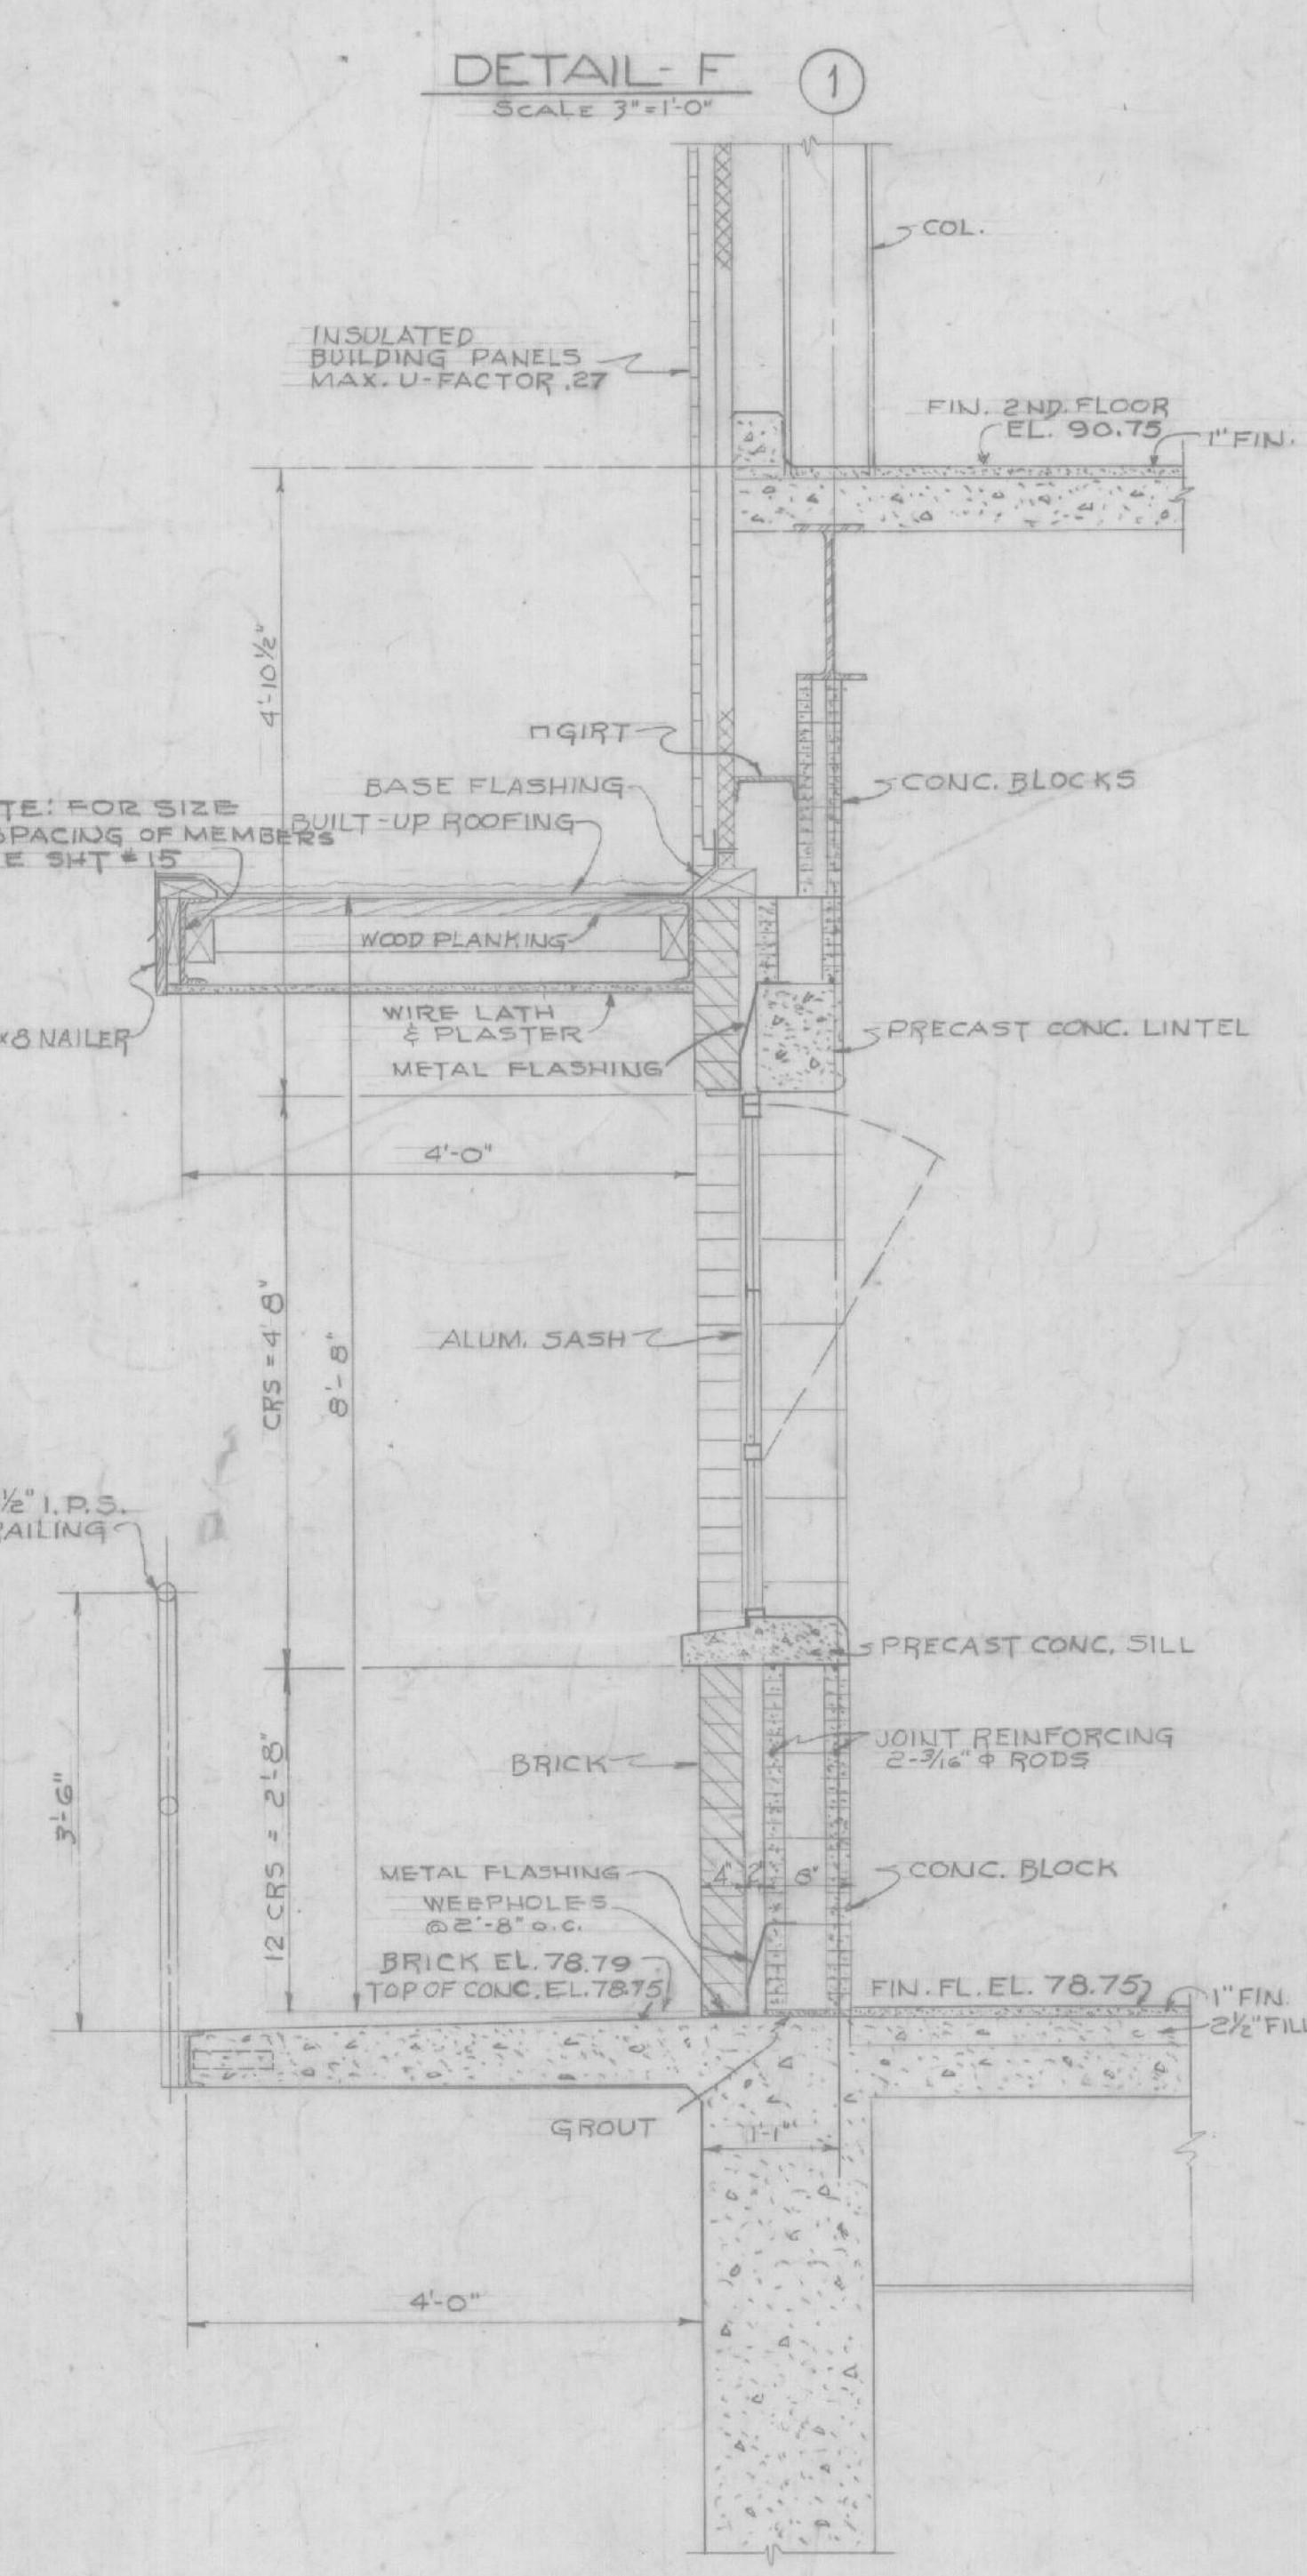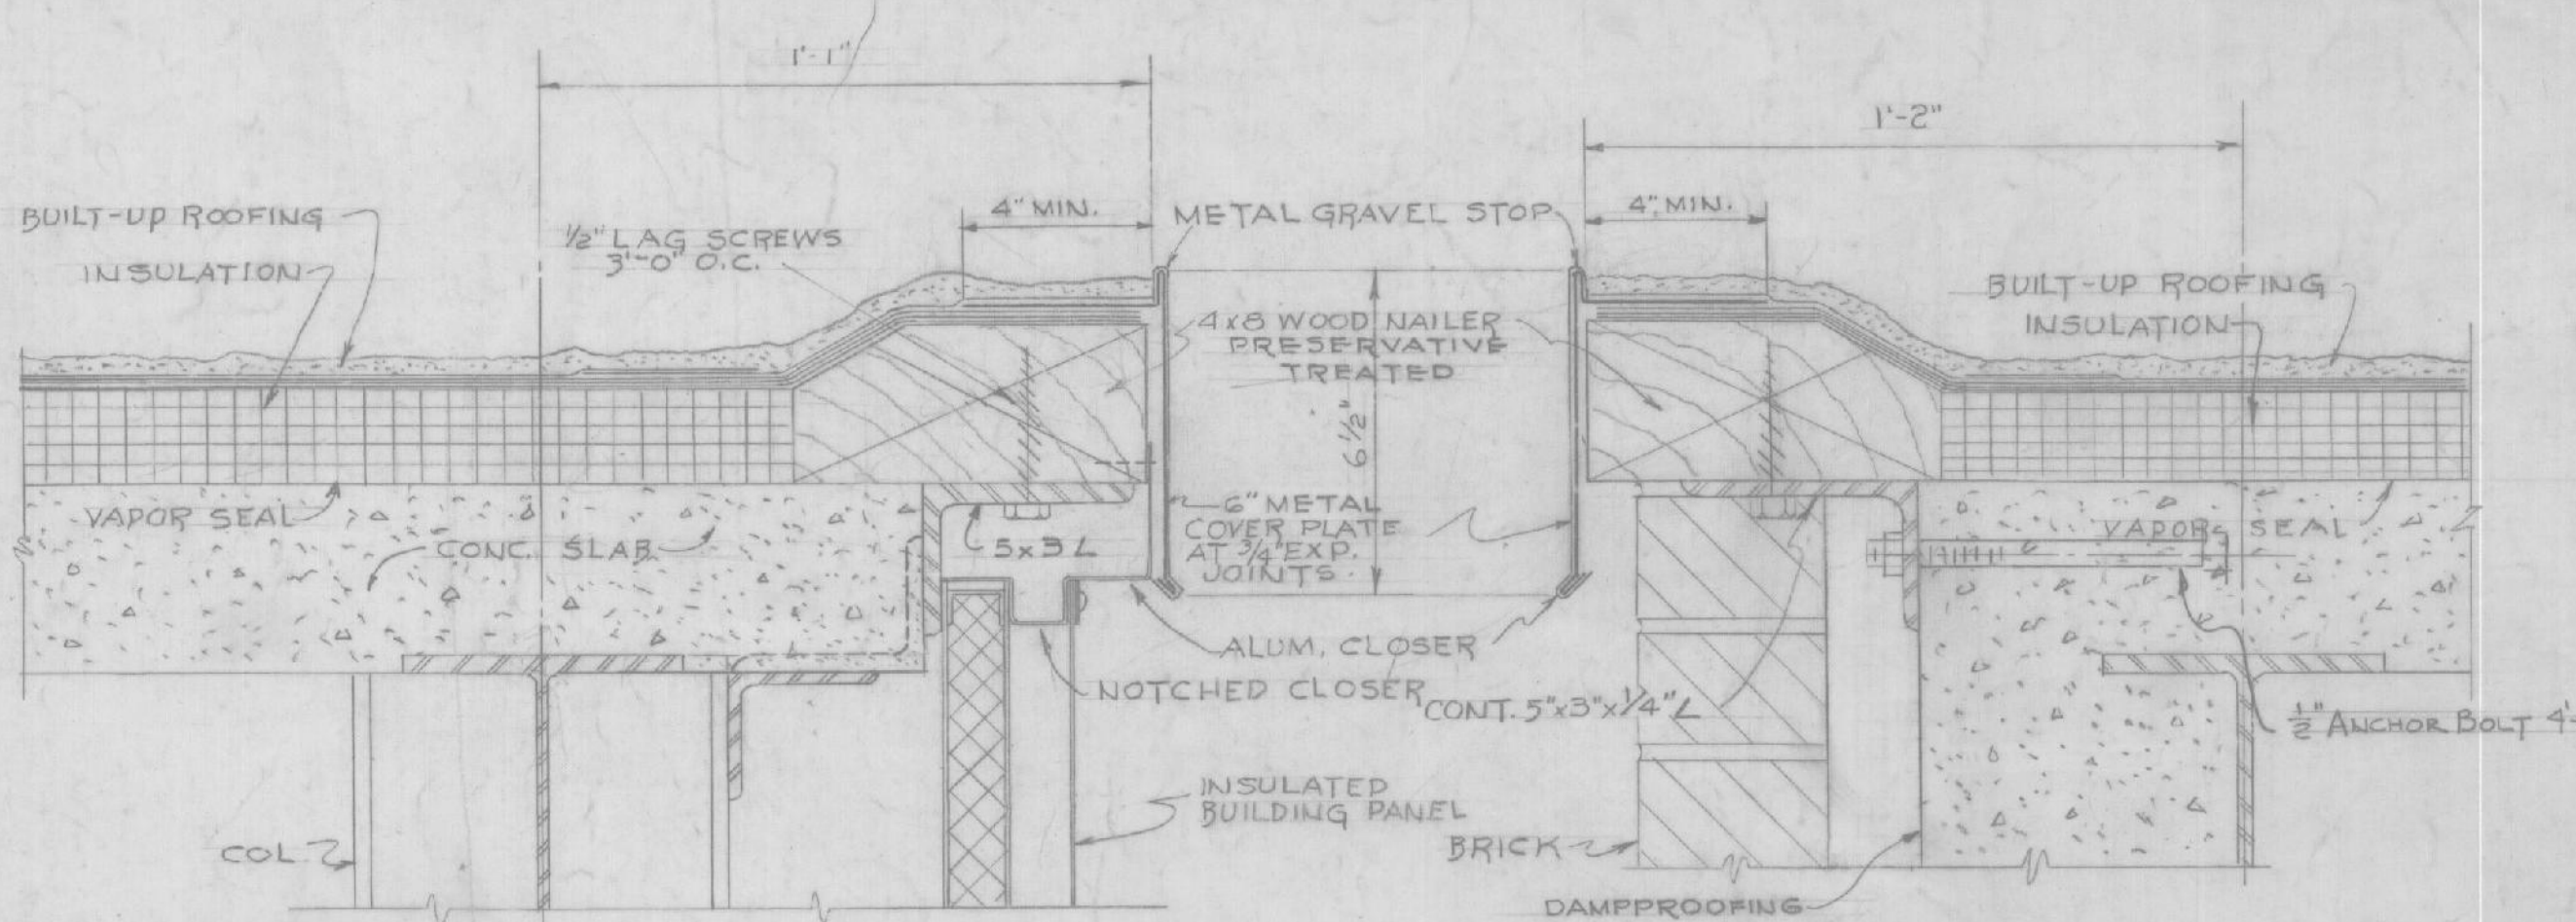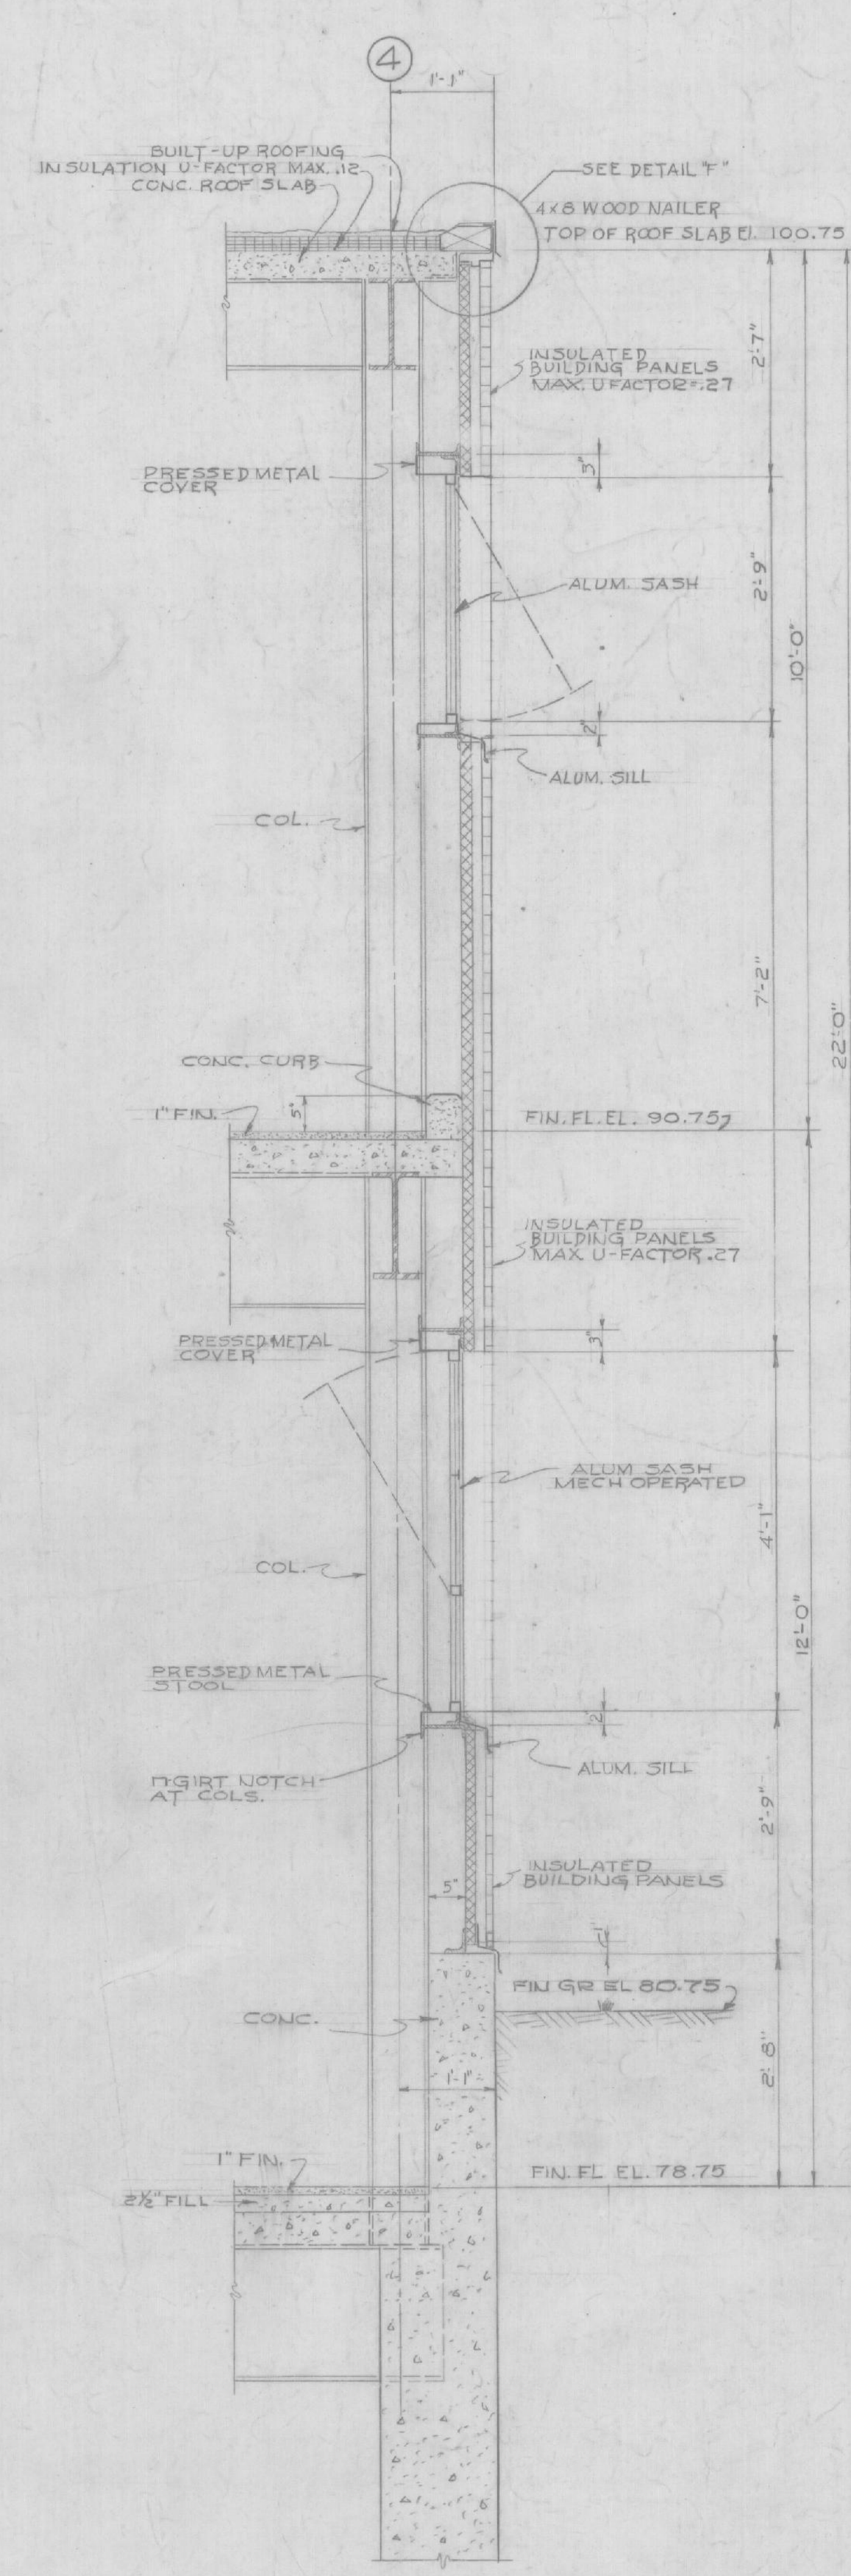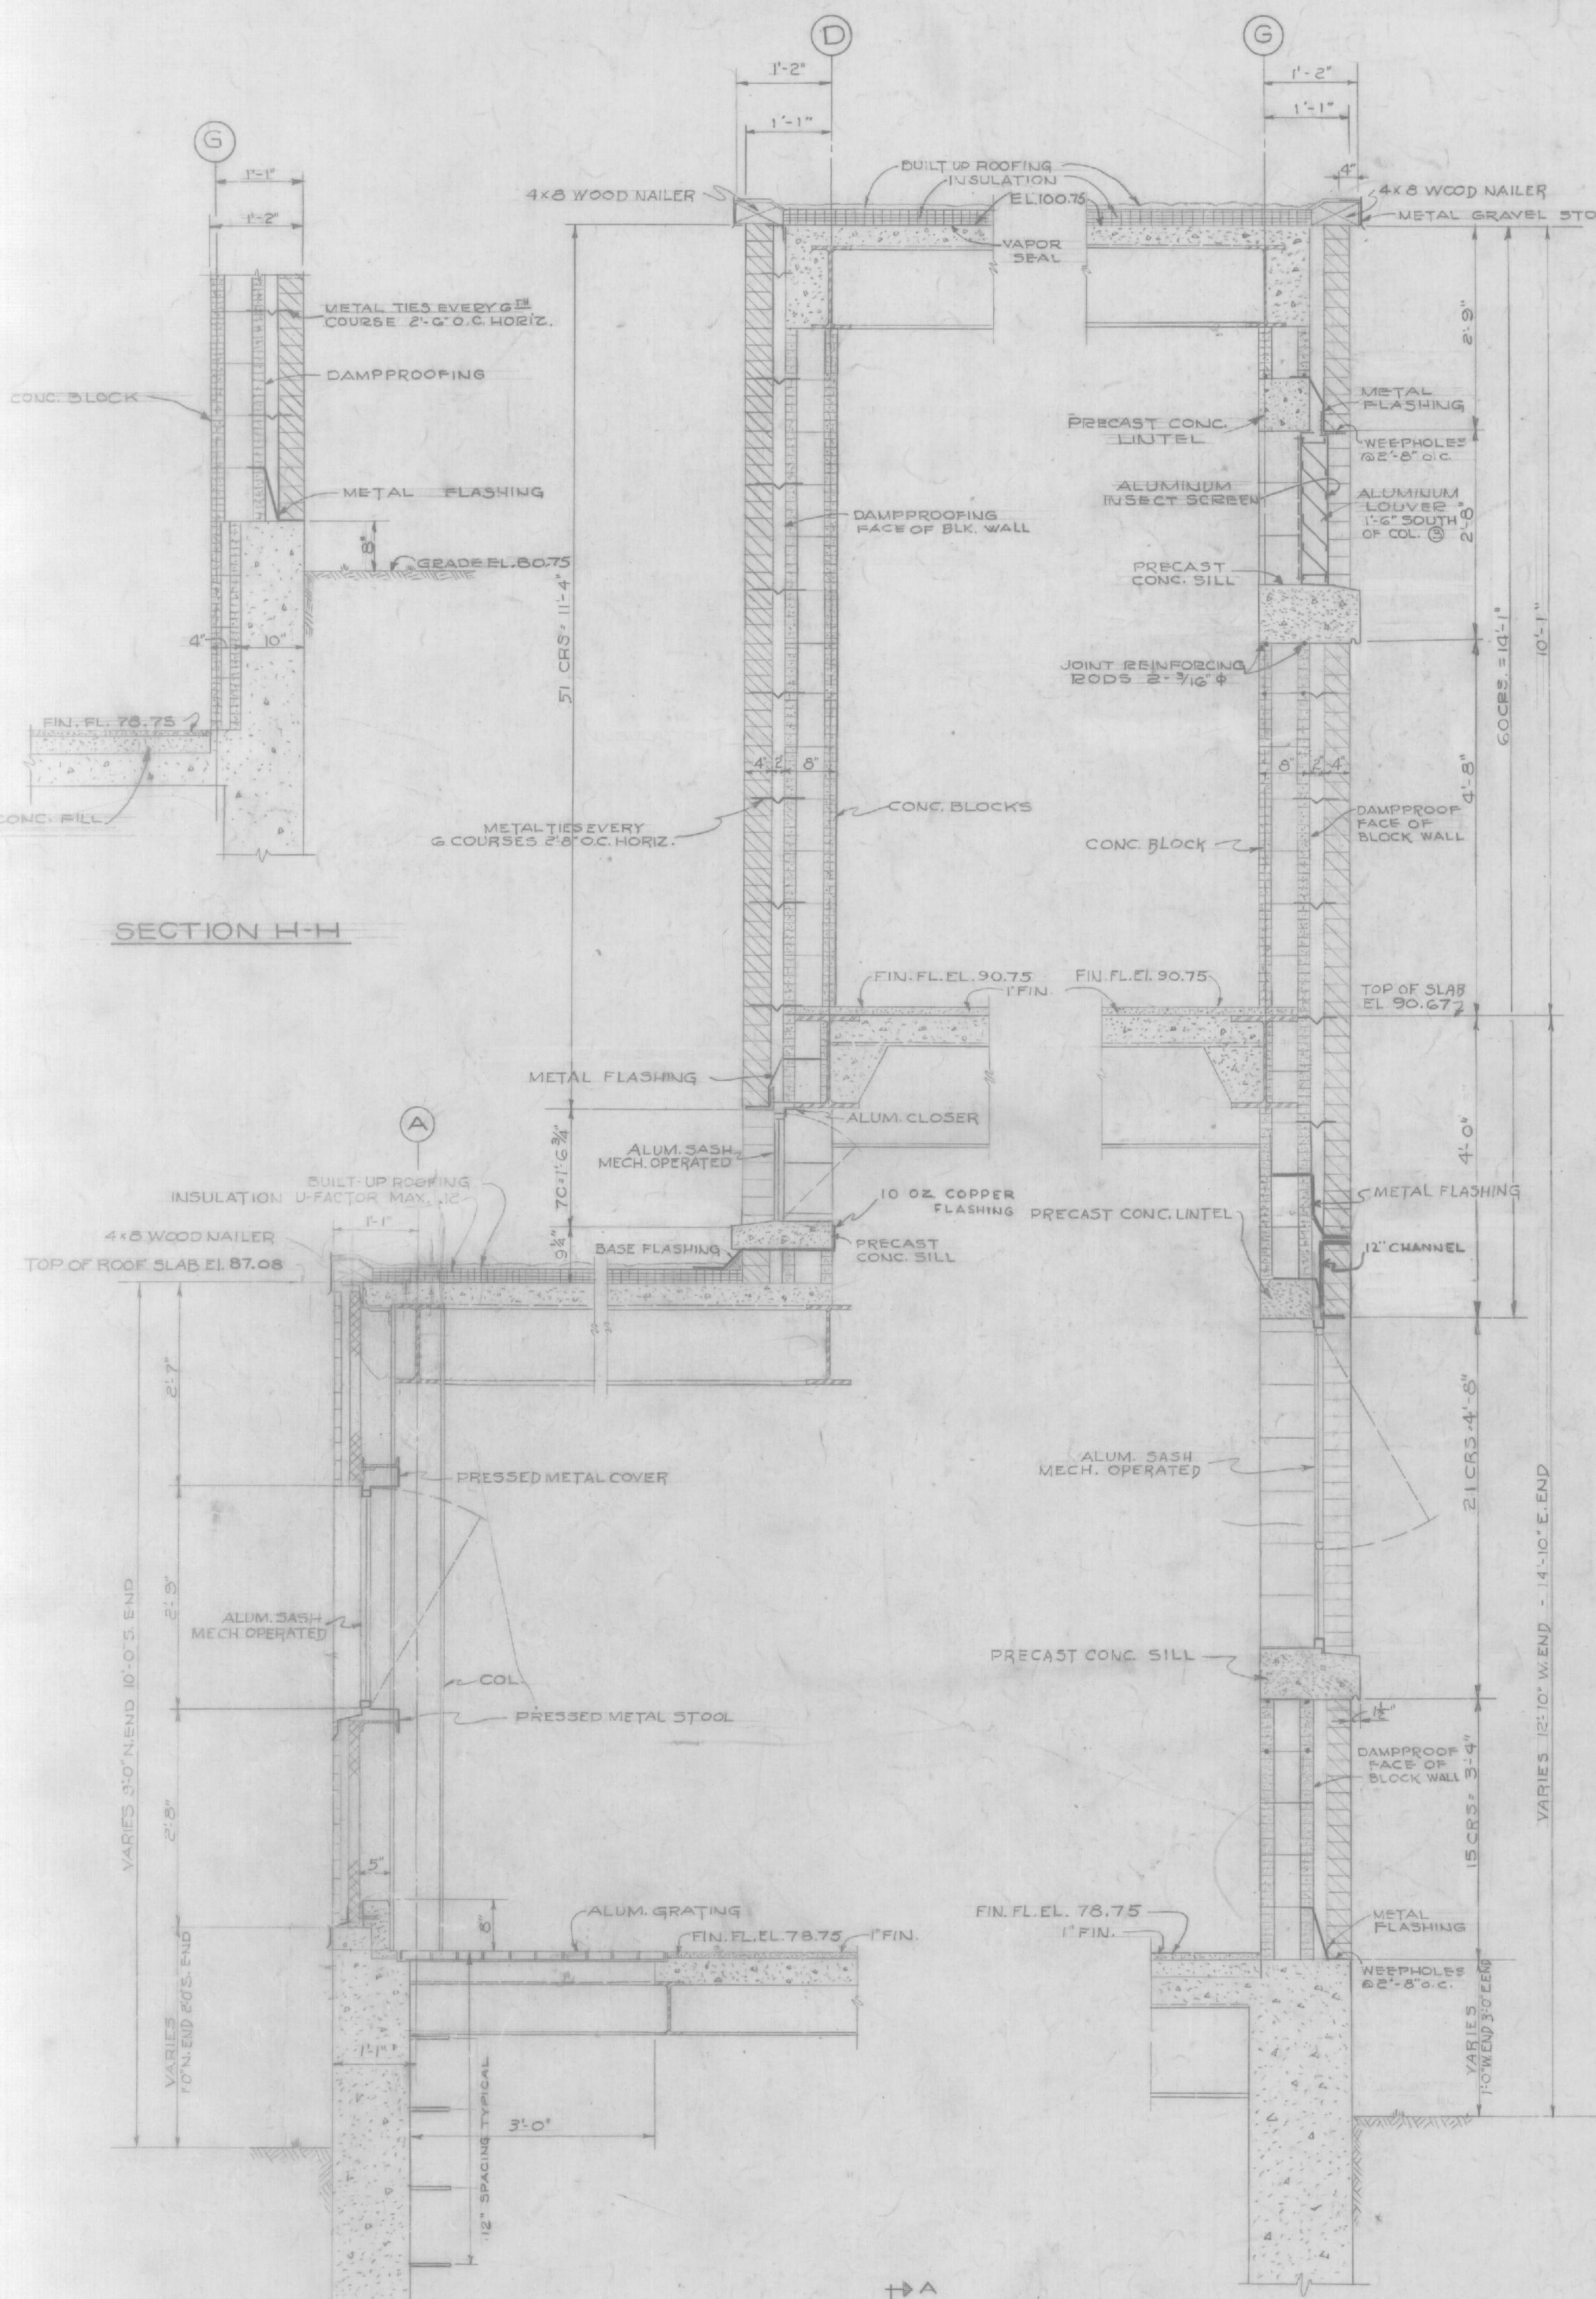


NOTE:
The base flashing on the low roof at the intersection of the high wall shall be 1003 copper thru wall. Copper pans will be provided at the sill for the three windows.

REVISION	DATE	DESCRIPTION	BY
10-4-41		FINAL FIELD CORRECTIONS.	
DRAWN BY:		WHITMAN & HOWARD, INC.	
TRACED BY:		CORPS OF ENGINEERS, U. S. ARMY	
CHECKED BY:		ENGINEERS	
SUBMITTED:		89 BROAD ST., BOSTON, MASS.	
APPROVED:		OFFICE OF THE DIVISION ENGINEER	
DESIGNED:		NEW ENGLAND DIVISION	
		WALTHAM, MASS.	
PEASE AIR FORCE BASE			
PORTSMOUTH, NEW HAMPSHIRE			
SURFACE WATER SUPPLY			
FILTER BUILDING			
ARCHITECTURAL			
WALL SECTIONS			
DATE		JUNE, 1959	
SCALE 3/8" = 1'-0"		SHEET NO. 29-102	
DRAWING NUMBER		AW71-05-31	
SHEET		6	


Record Drawing
Contract No. DA-19-016-ENG-6199

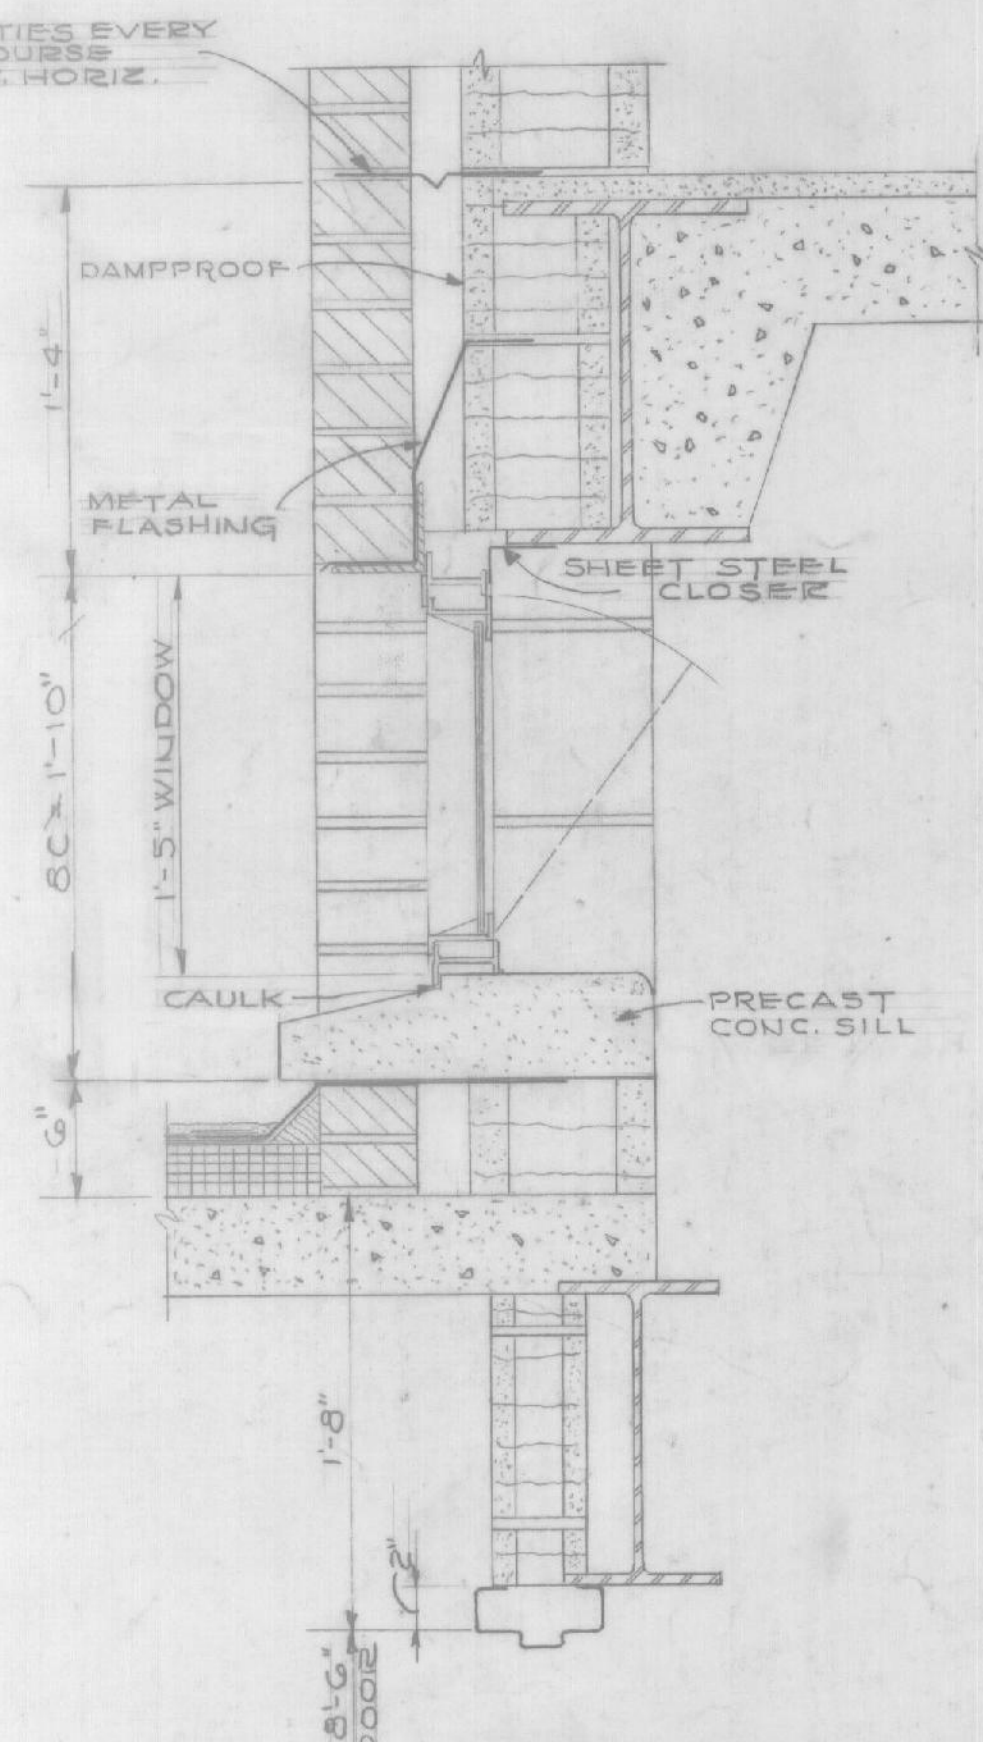


TOILET & CORRIDOR WINDOW DETAILS

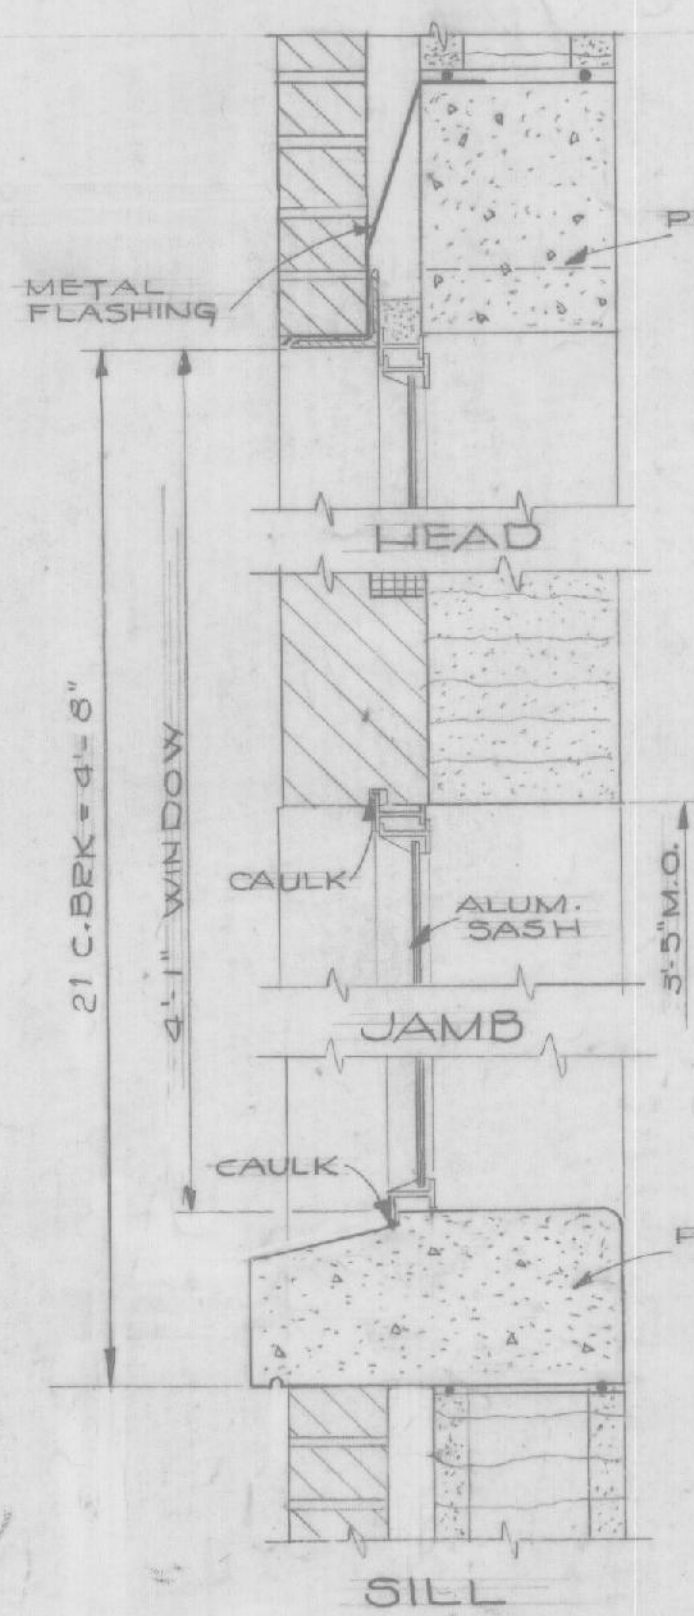


EAST WINDOW DETAILS

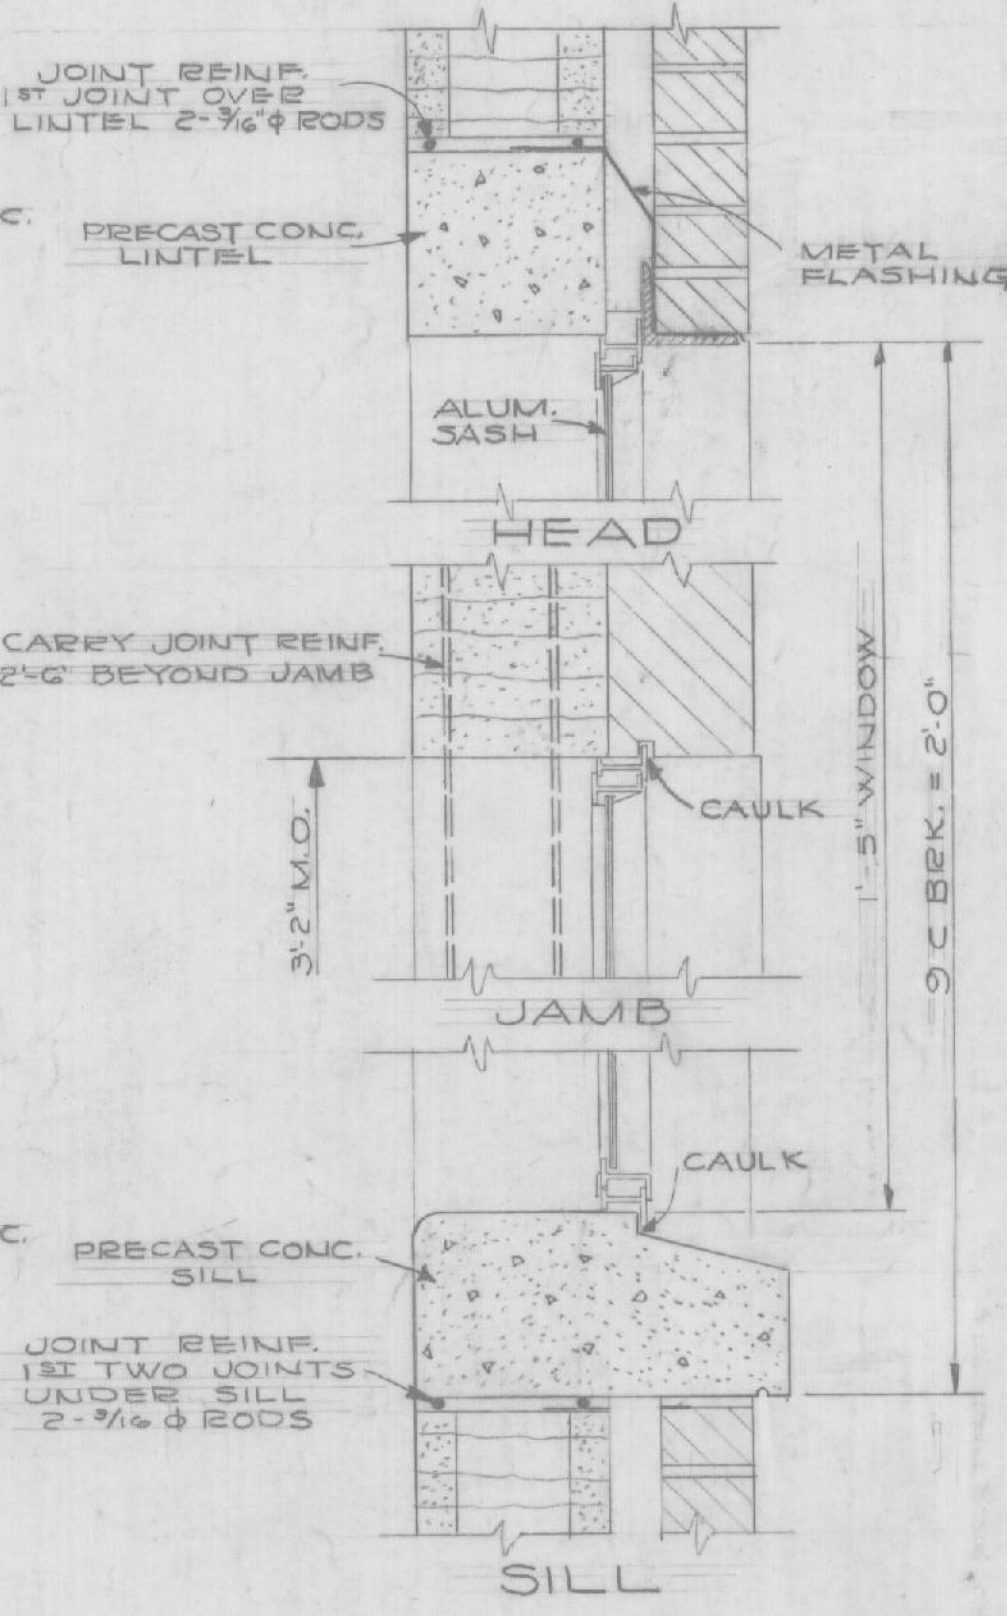


FILTER ROOM WINDOW DETAILS

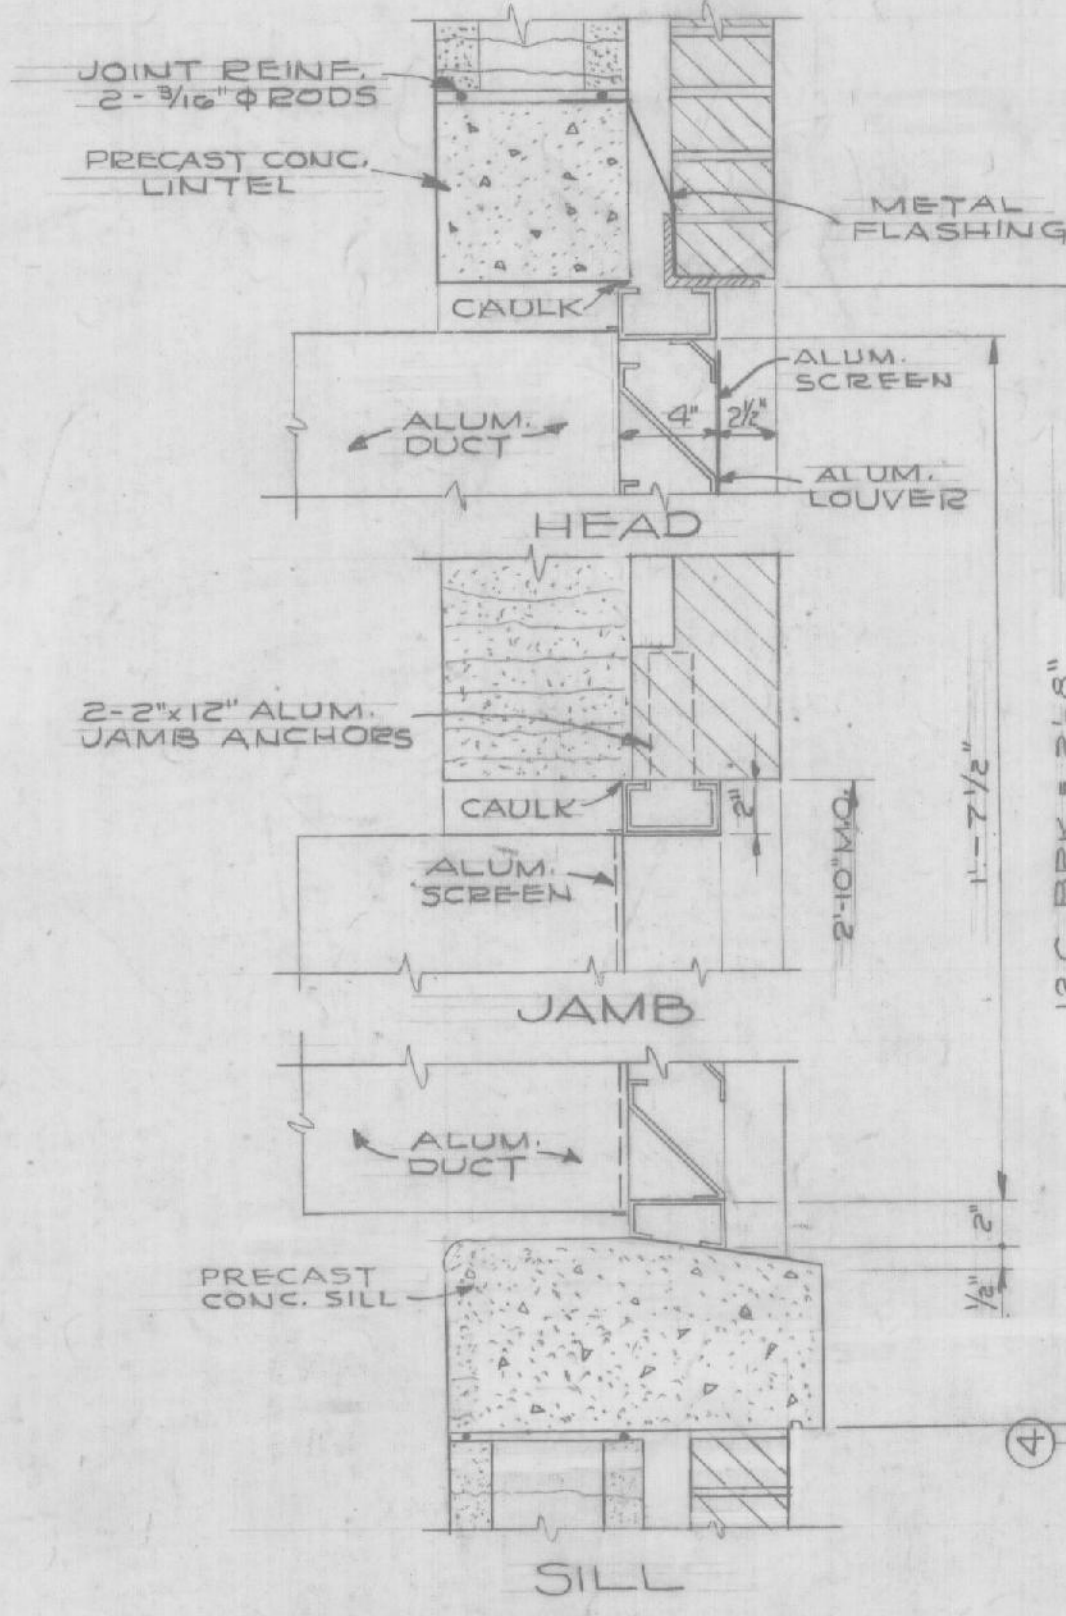


LOUVER DETAIL

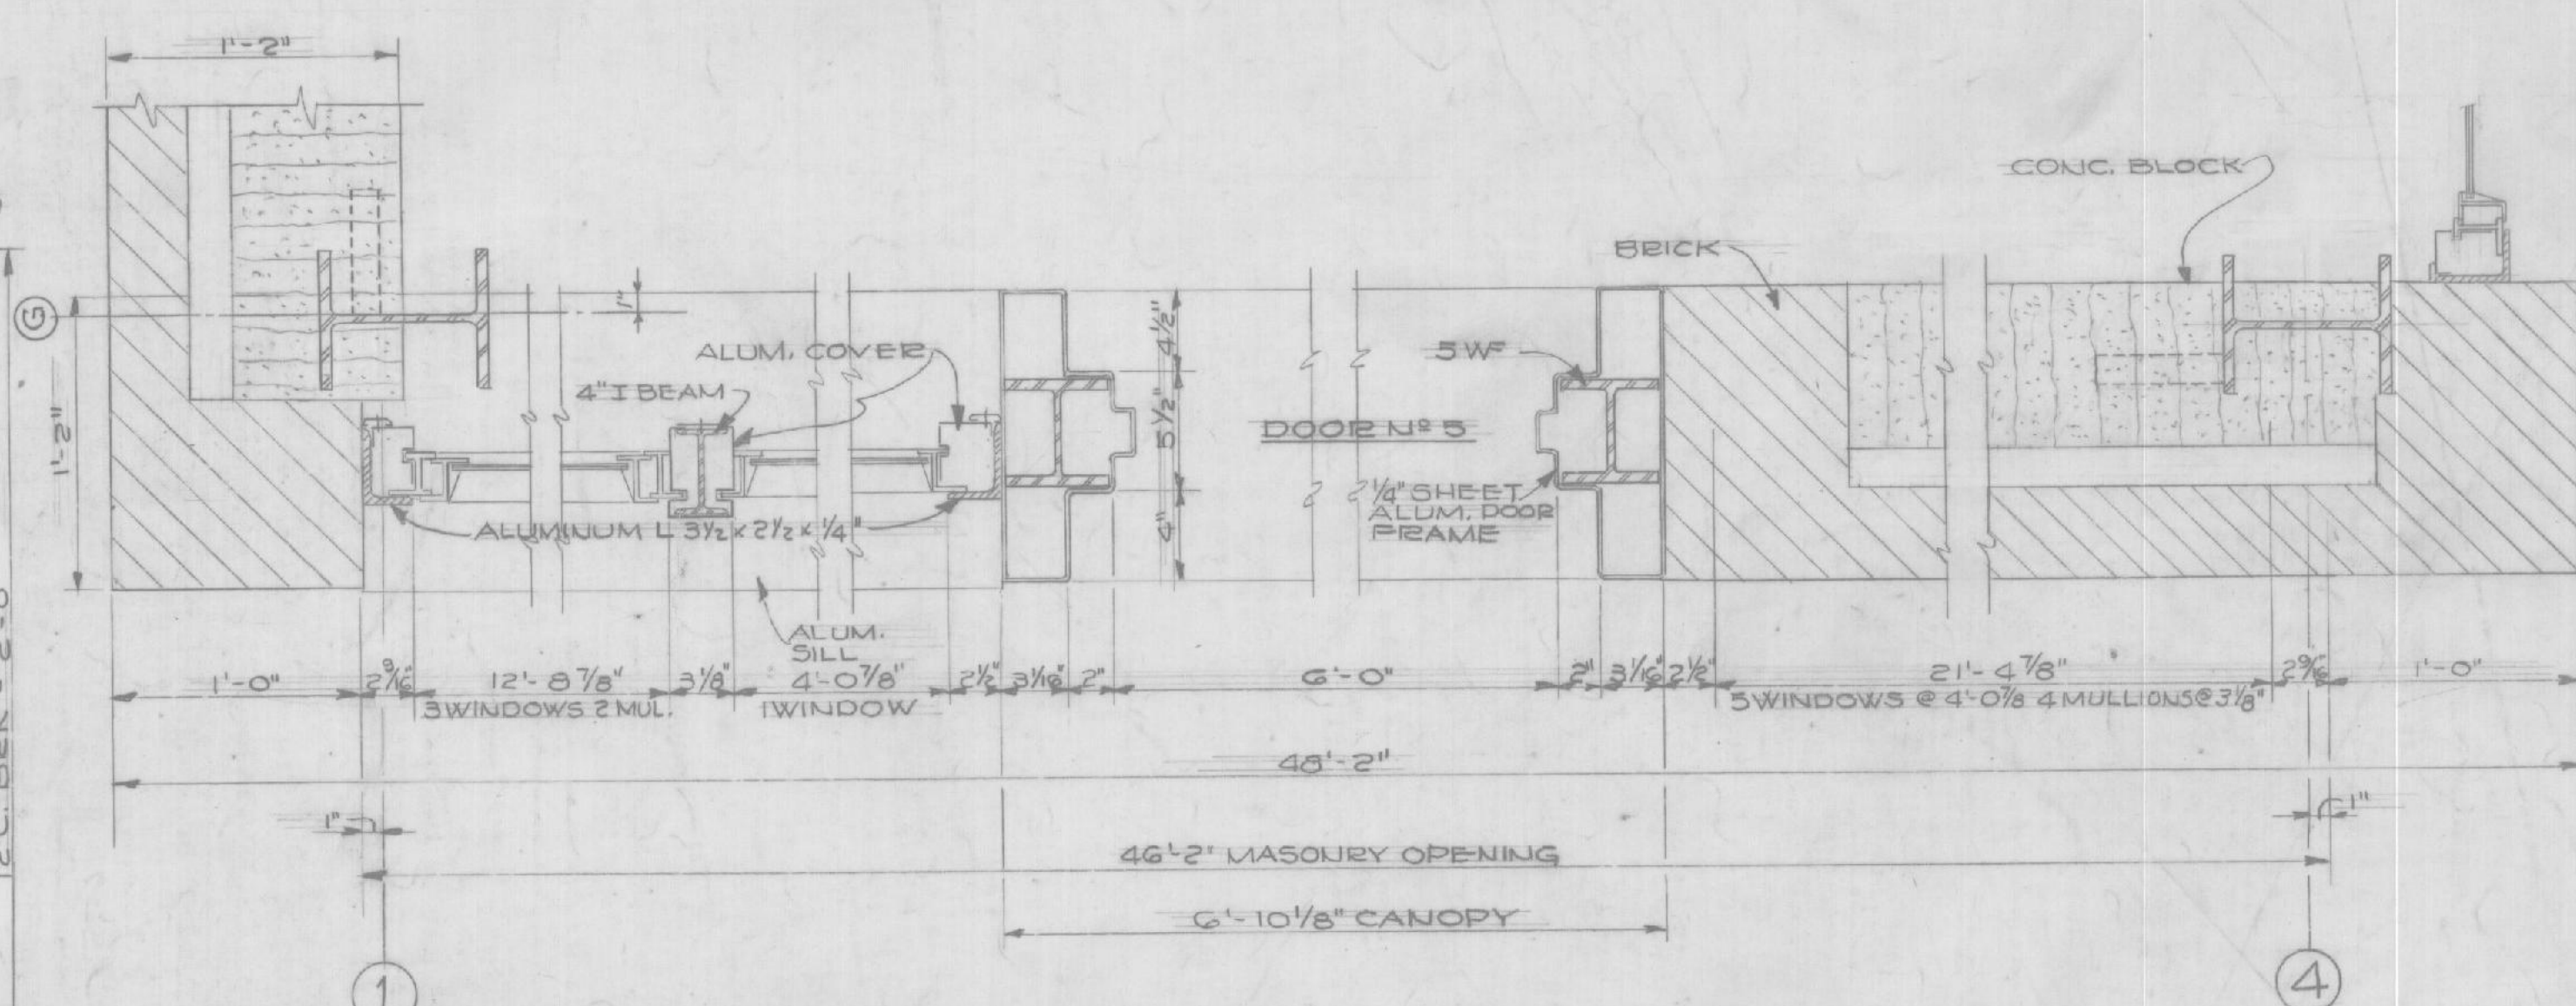


PART PLAN OF EAST WALL

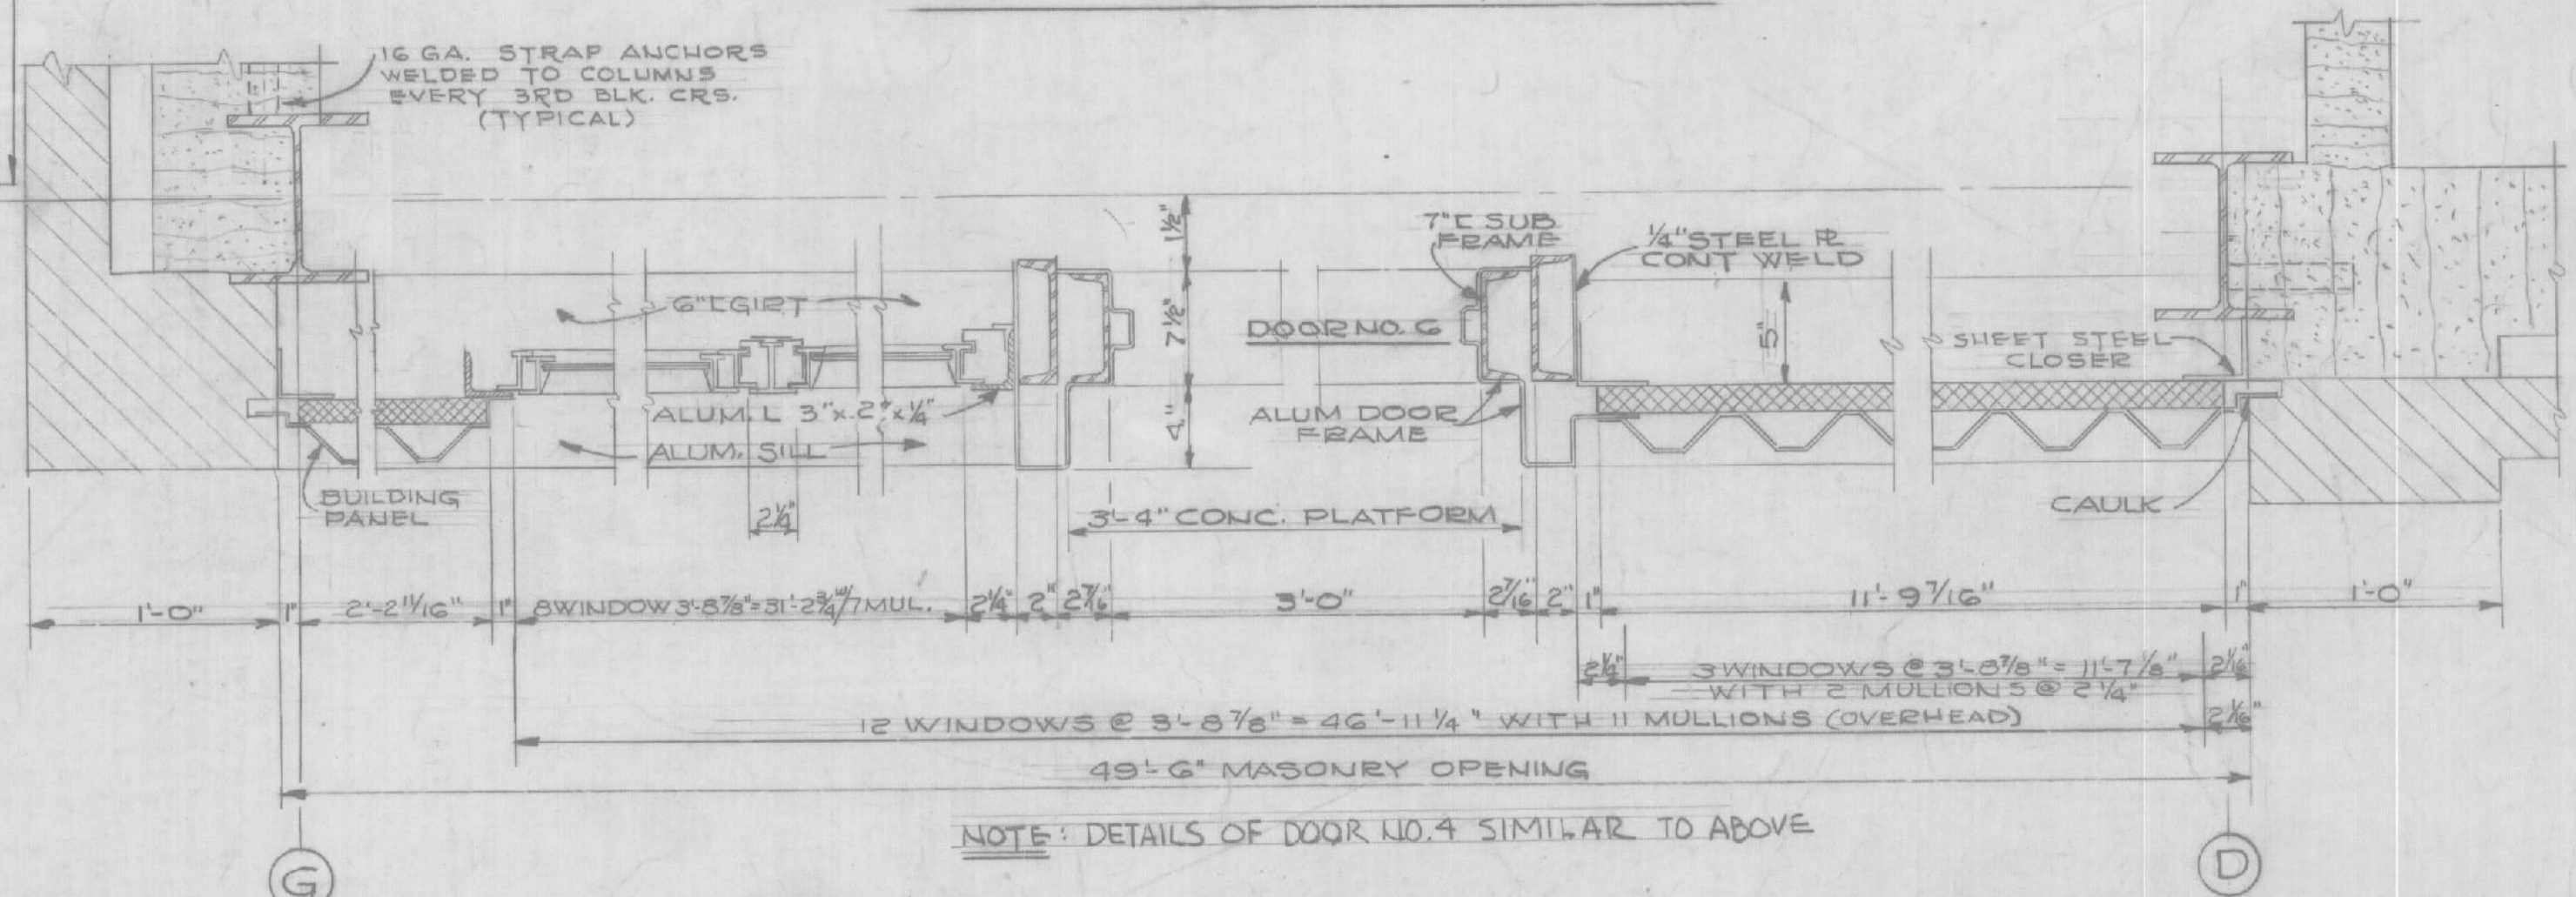


PART PLAN OF NORTH WALL

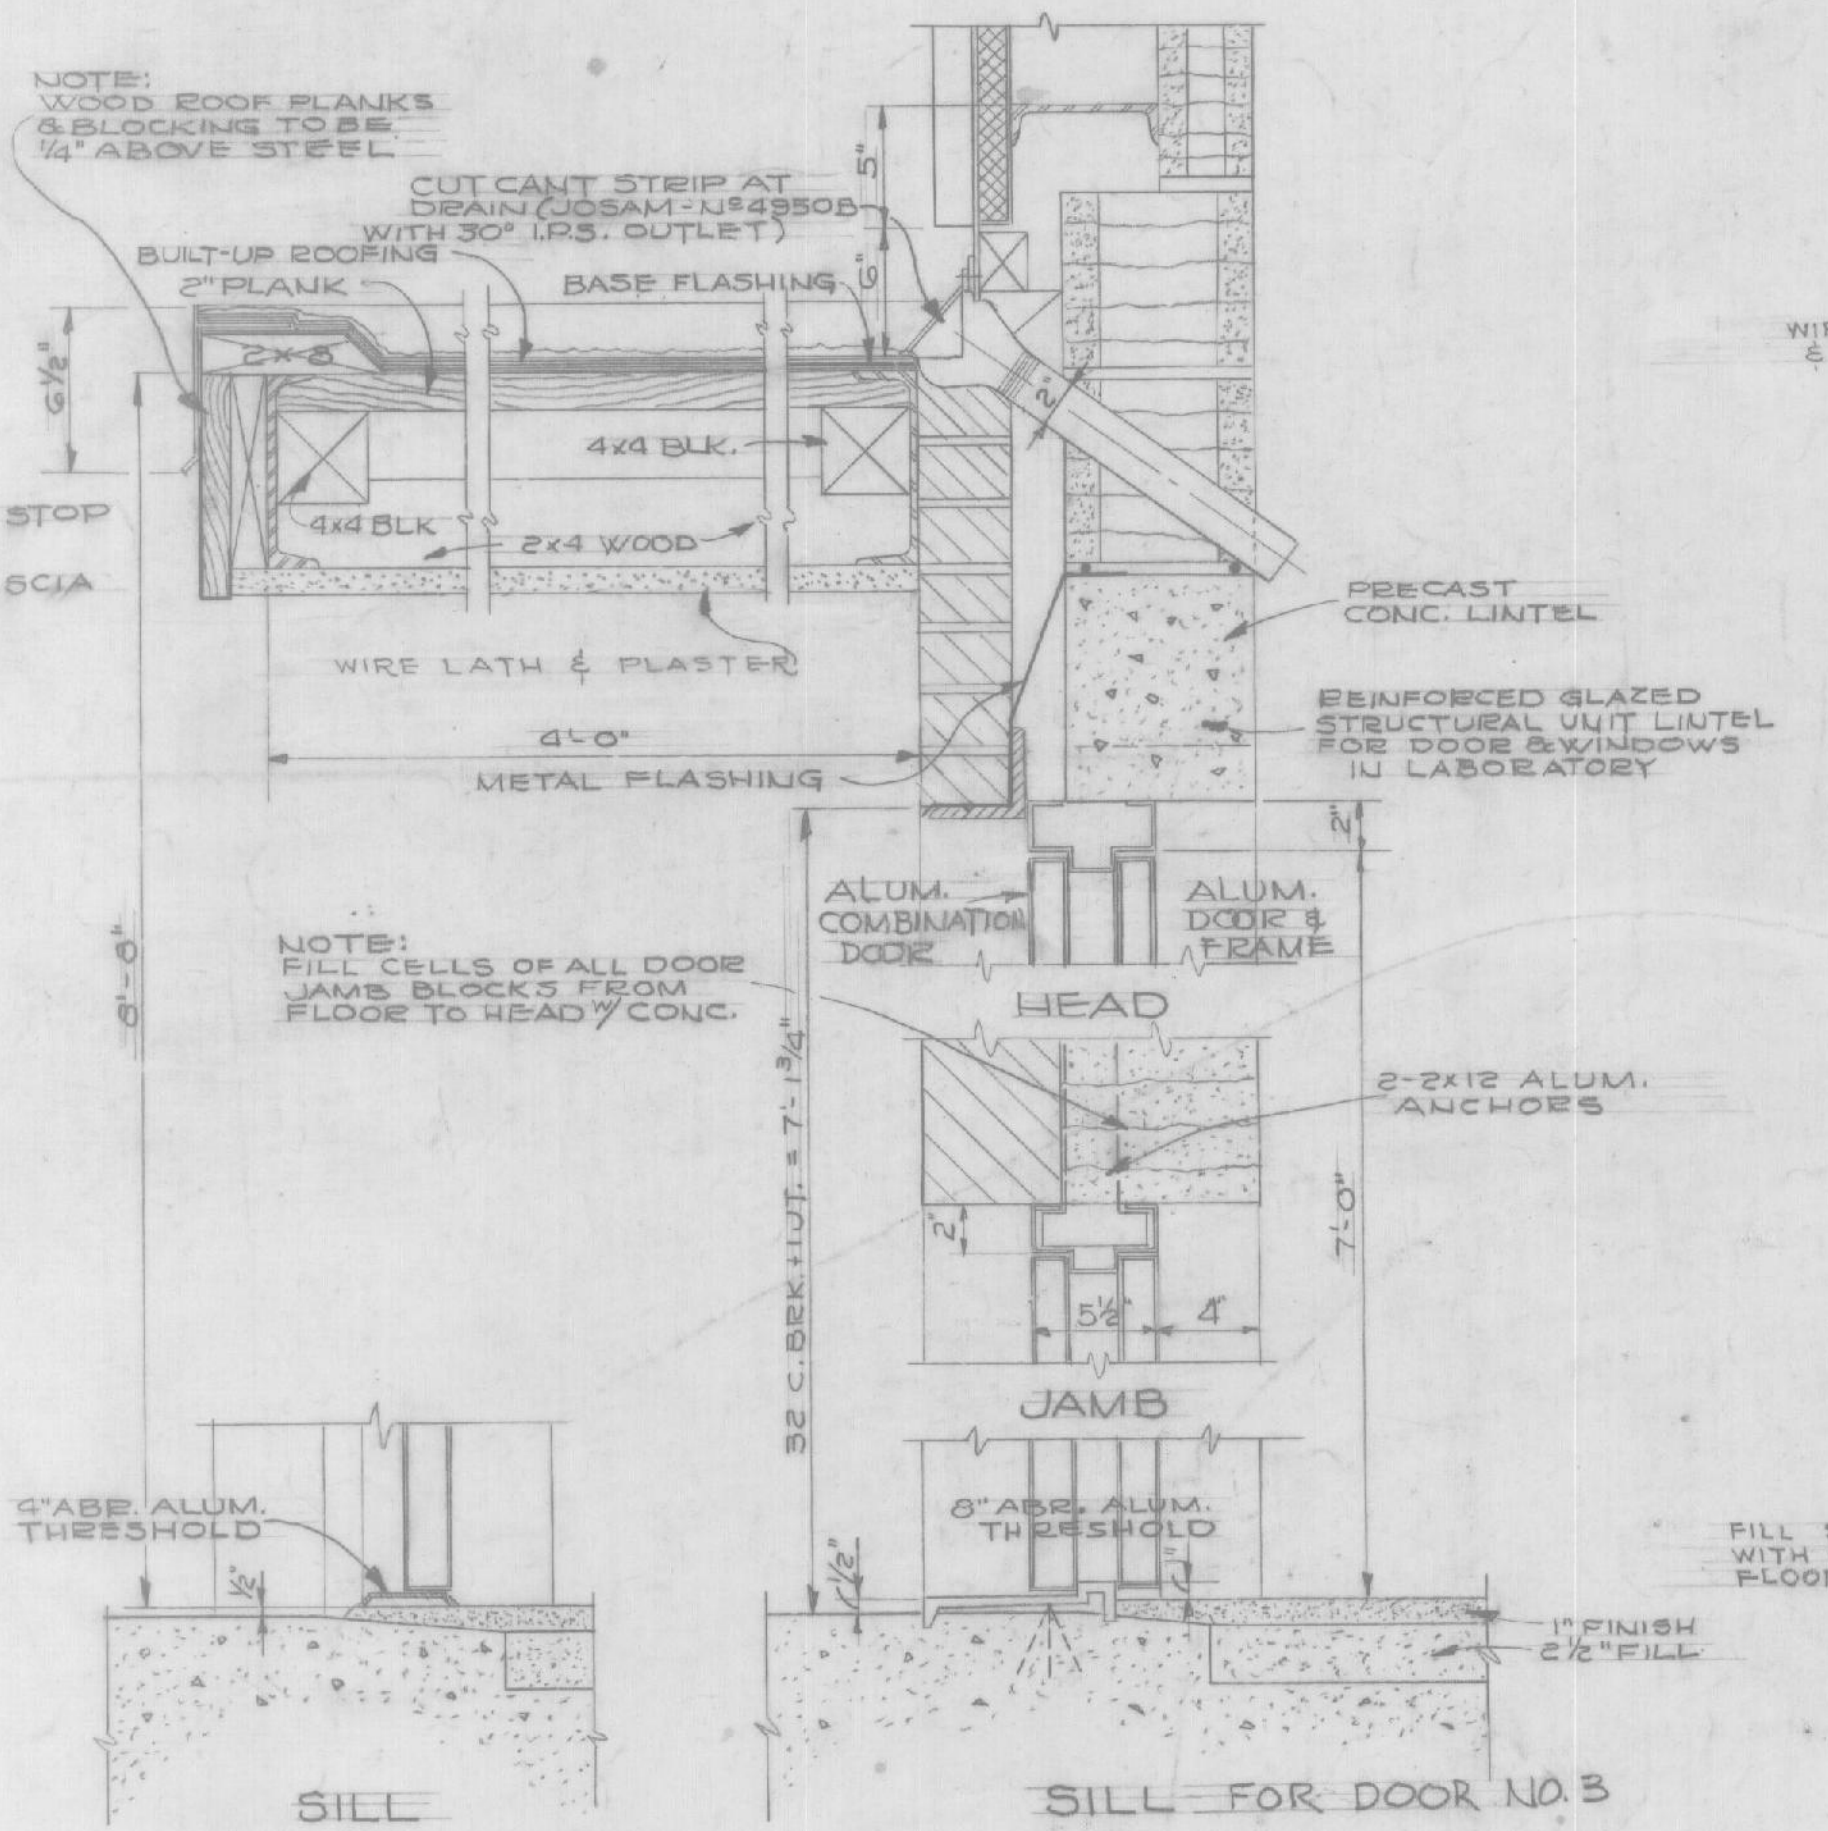


ENTRANCE DETAILS FOR DOOR NOS 2, 3 & 4

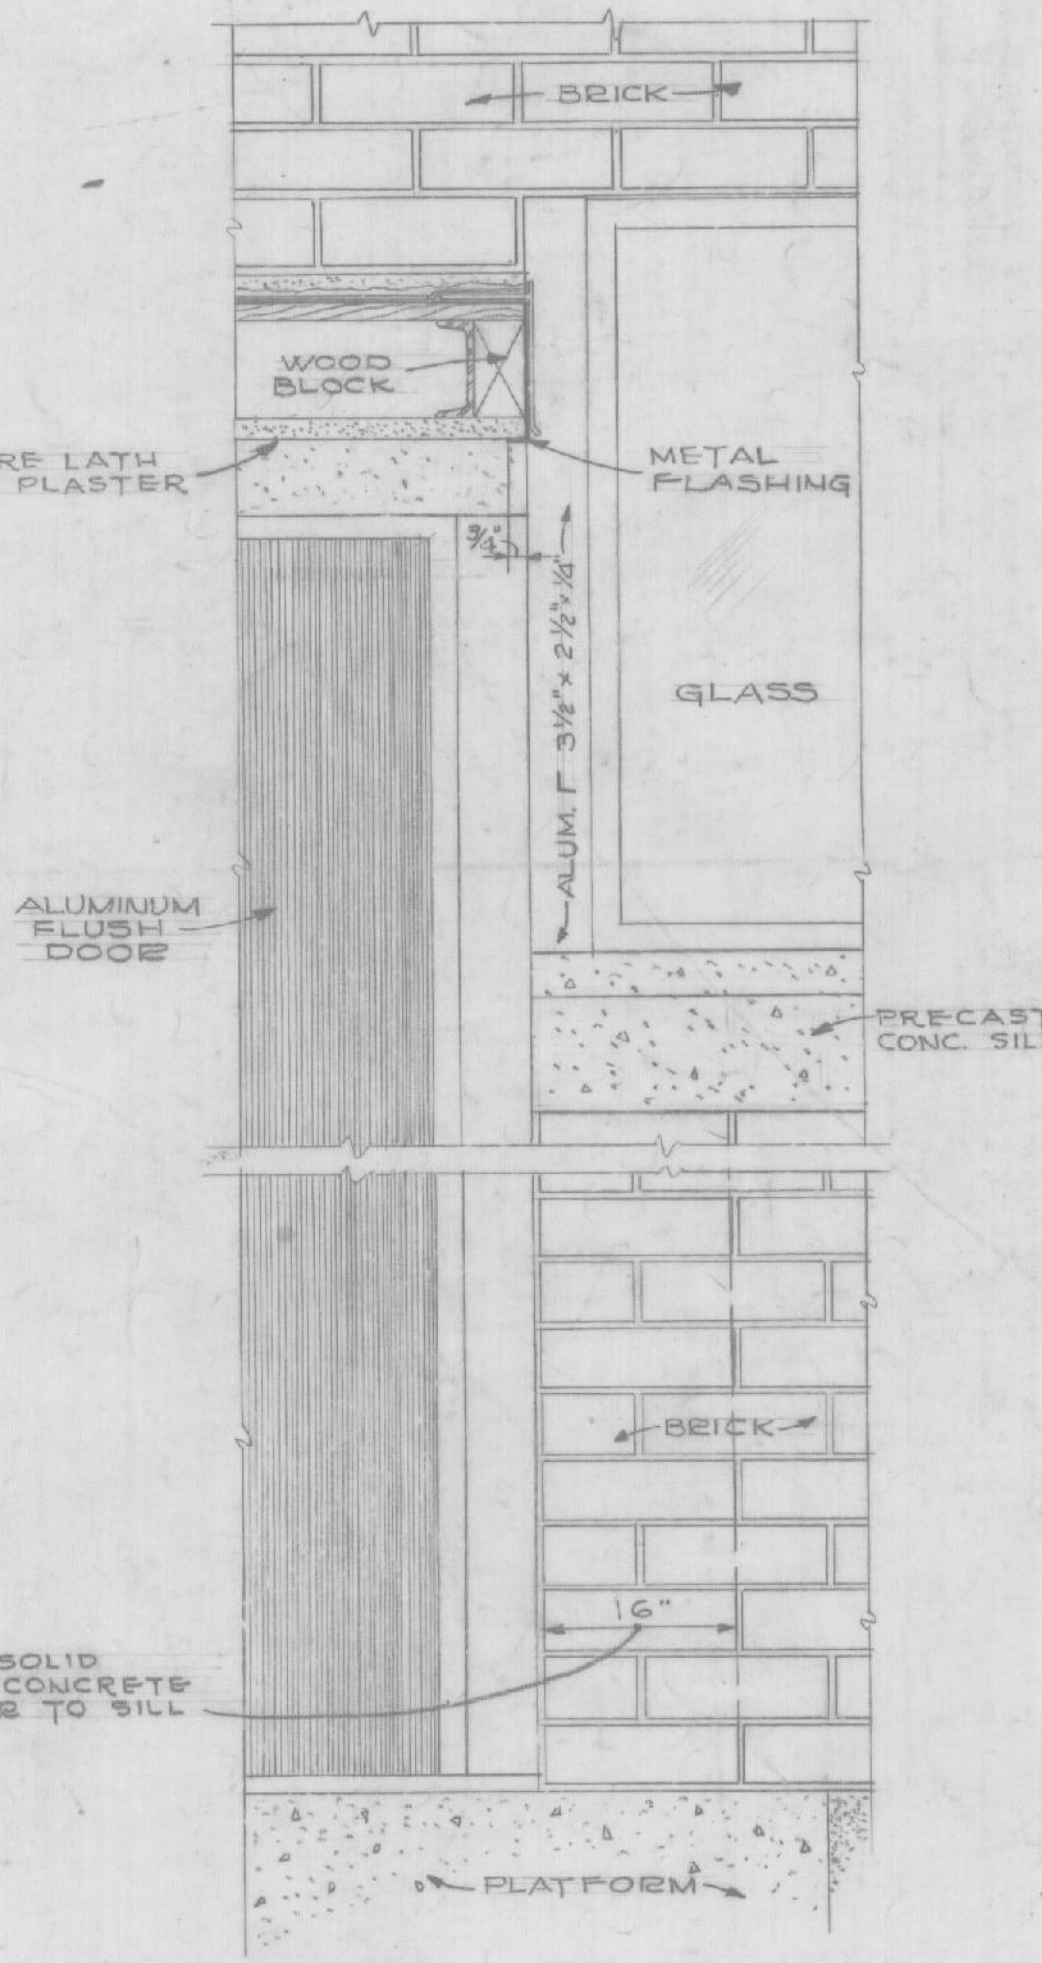


PART ELEVATION

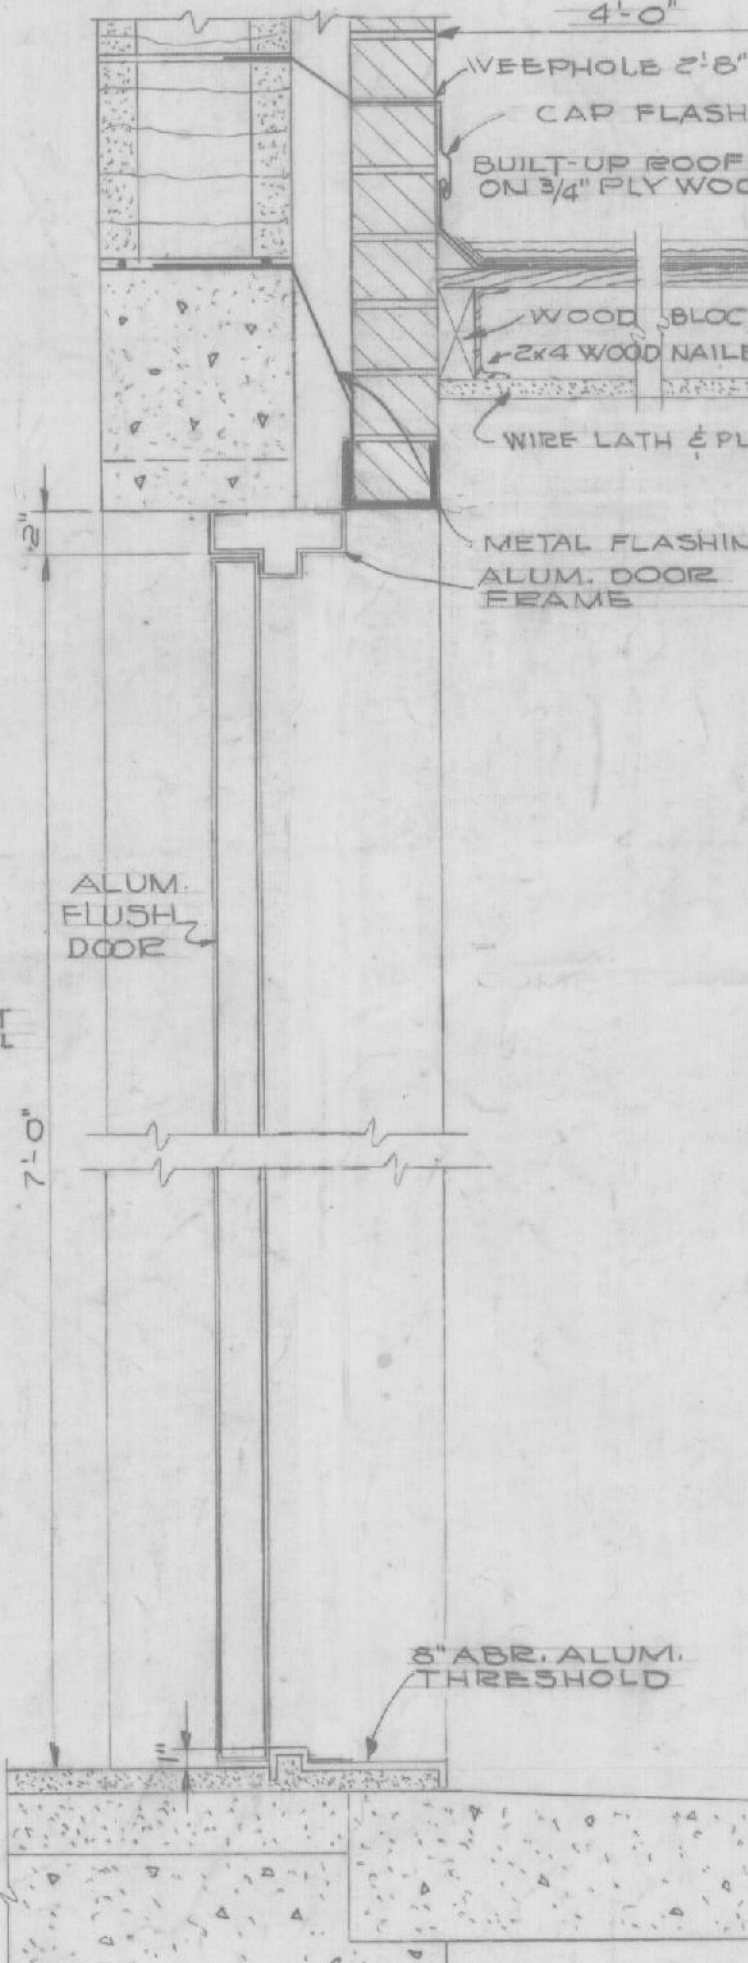

SECTION
















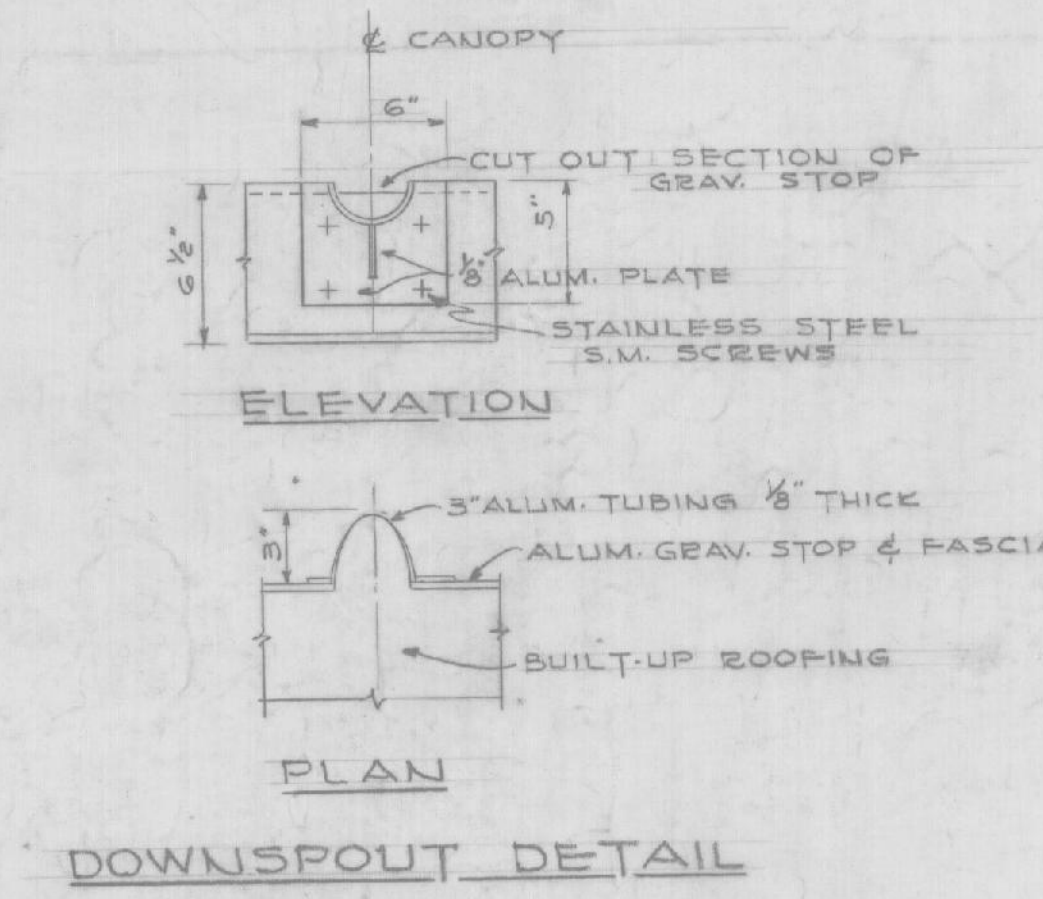


DOWNSPOUT DETAIL

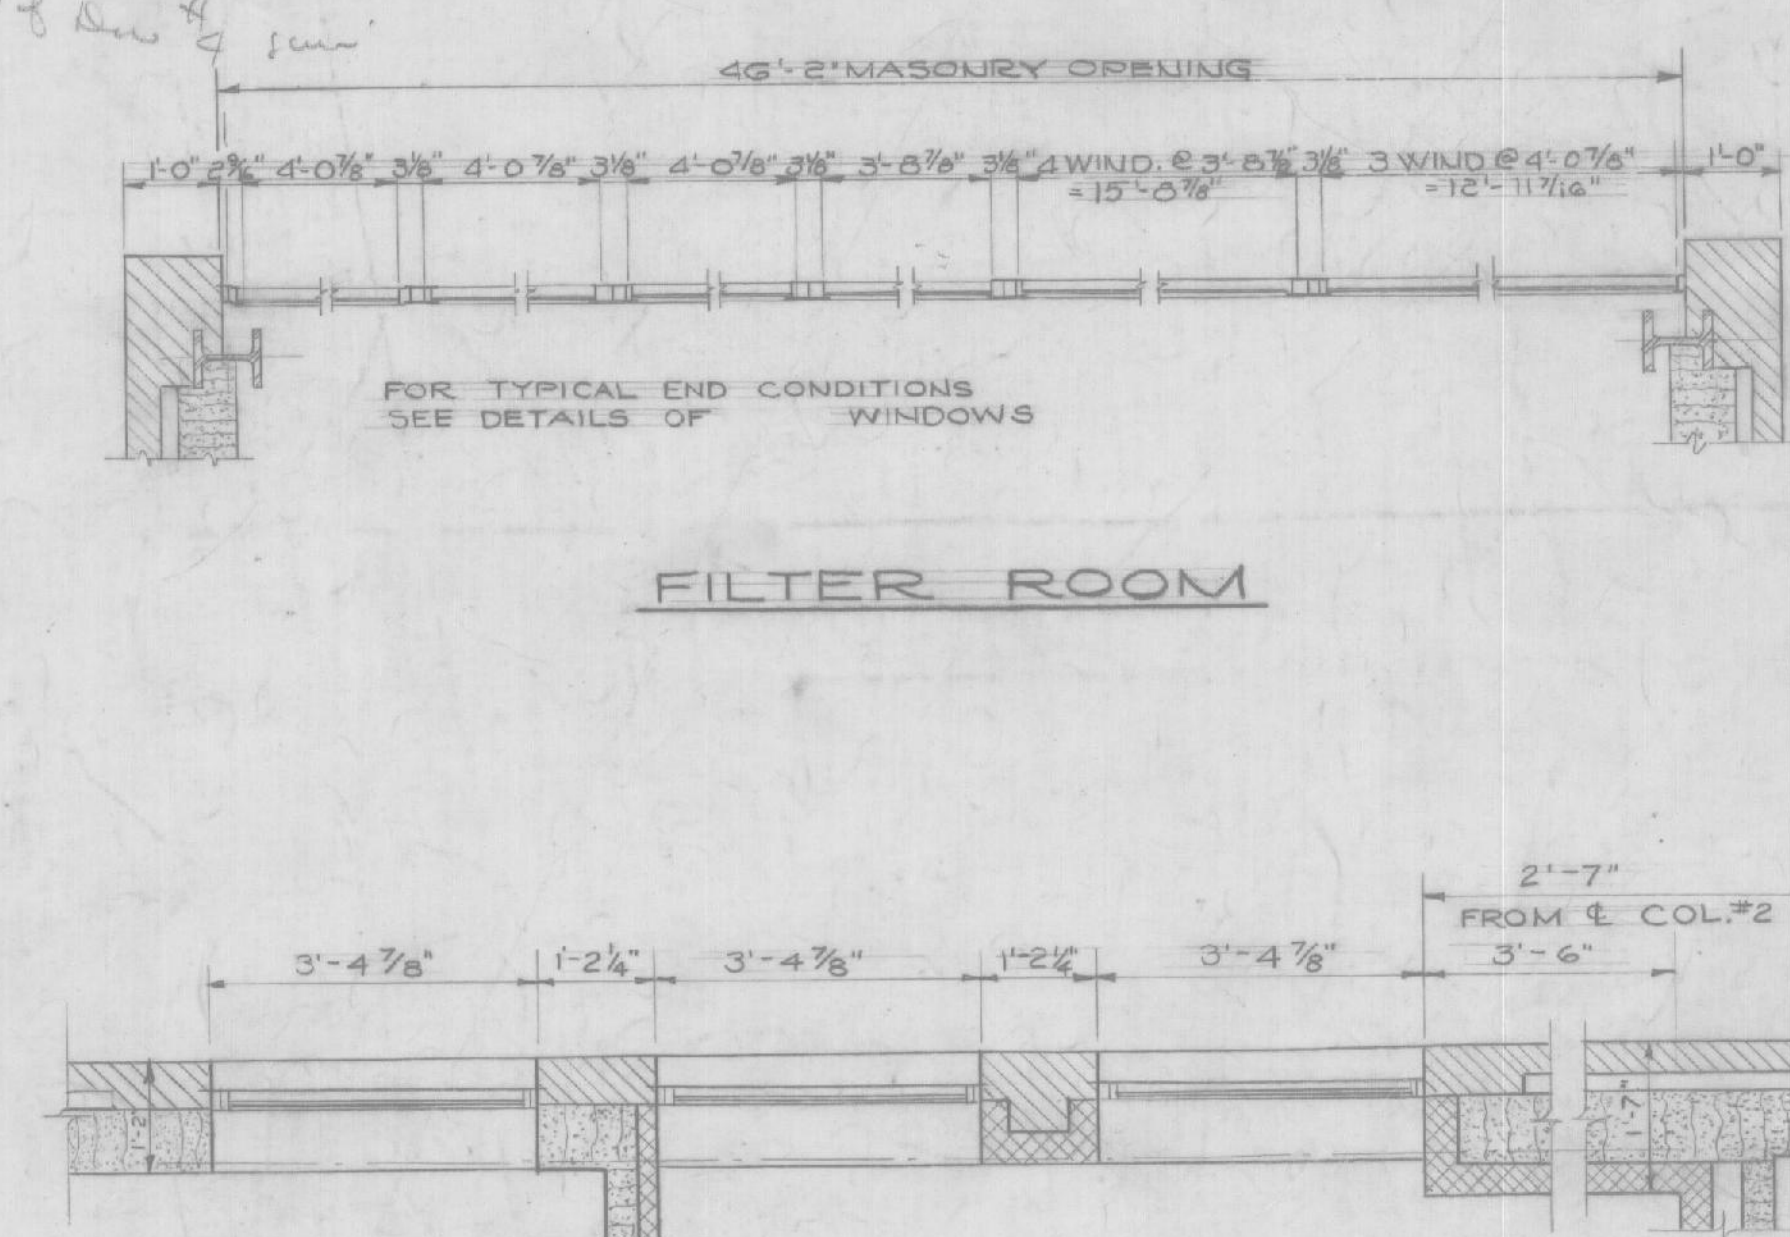

PART PLANS OF WEST WALL Scale: 1/2" = 1'-0"

REVISION	DATE	DESCRIPTION	BY
10-4-41		FINAL FIELD CORRECTIONS	
WHITMAN & HOWARD, INC. ENGINEERS 89 BROAD ST. BOSTON, MASS.		CORPS OF ENGINEERS, U. S. ARMY OFFICE OF THE DIVISION ENGINEER NEW ENGLAND DIVISION WALTHAM, MASS.	
DRAWN BY:	A.B.S.	PLEASE AIR FORCE BASE PORTSMOUTH, NEW HAMPSHIRE	
TRACED BY:		SURFACE WATER SUPPLY	
CHECKED BY:	C.G.M.	FILTER BUILDING ARCHITECTURAL EXTERIOR DETAILS	
SUBMITTED		APPROVED	DATE
		John W. ...	JUNE, 1959
RECORD DRAWING Contract No. DA-19-016-ENG-6199		SCALE: 1/2" = 1'-0"	SPEC. NO.
		DRAWING NUMBER	AW71-05-31
		SHEET	7

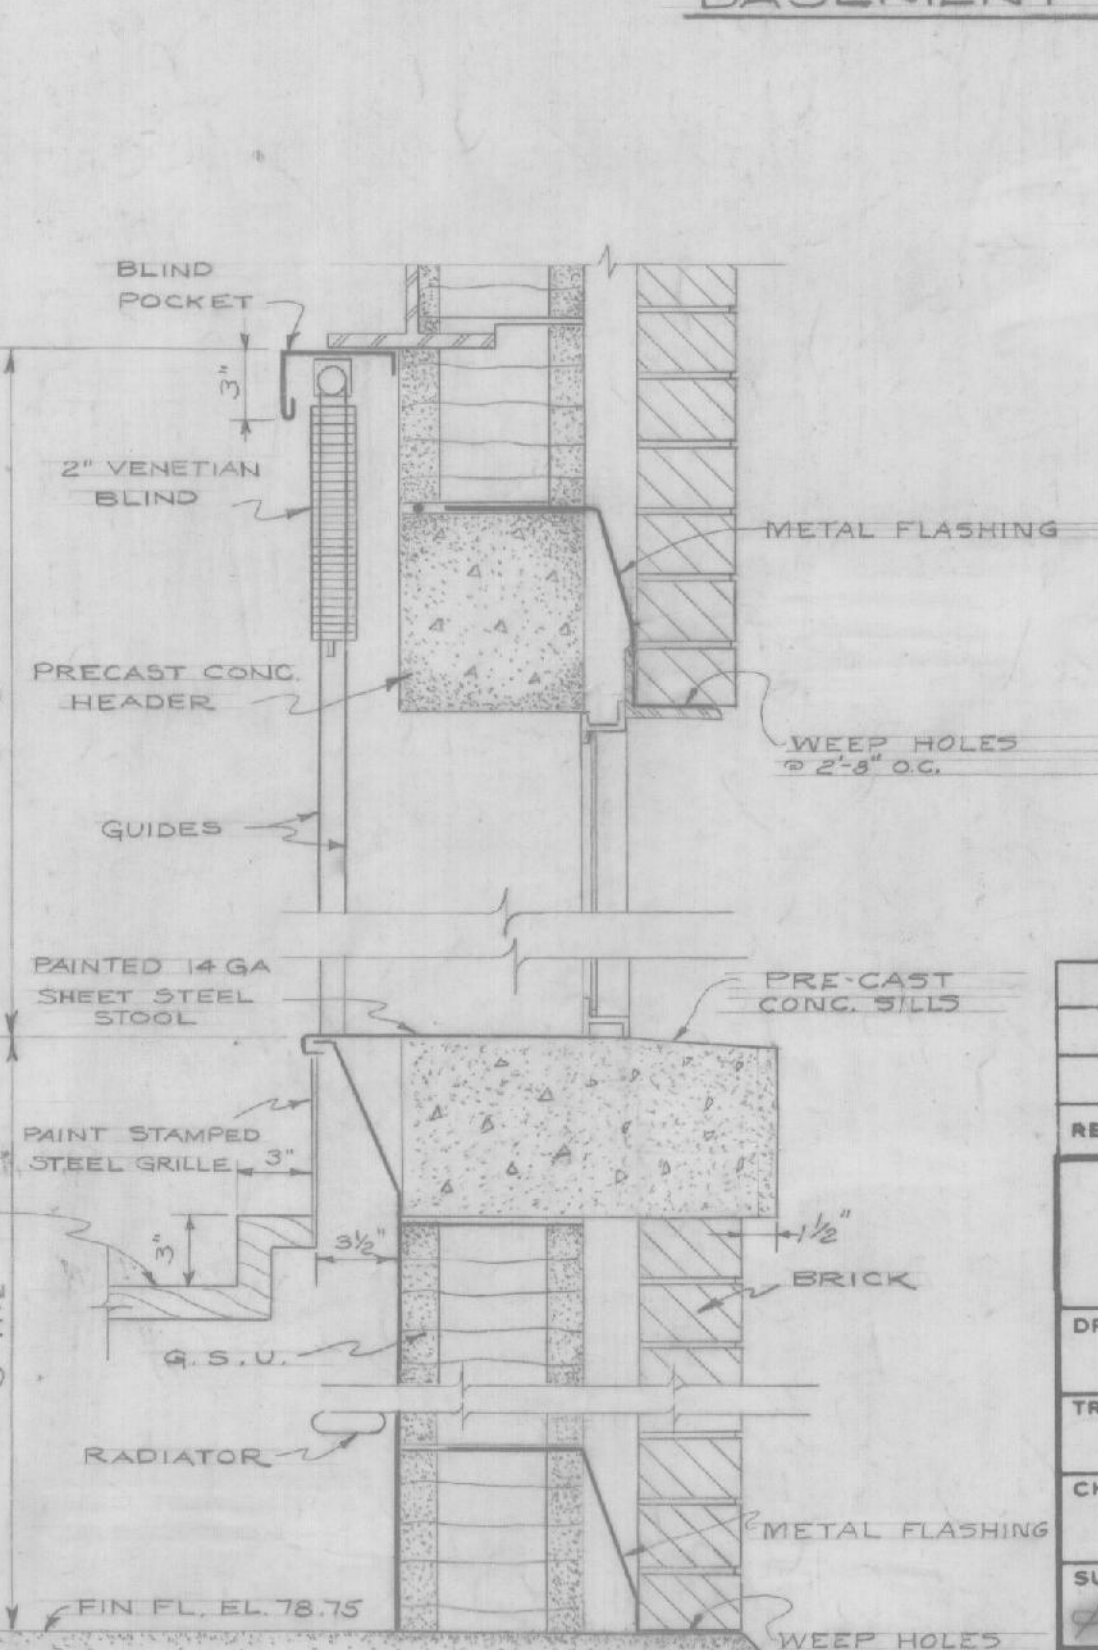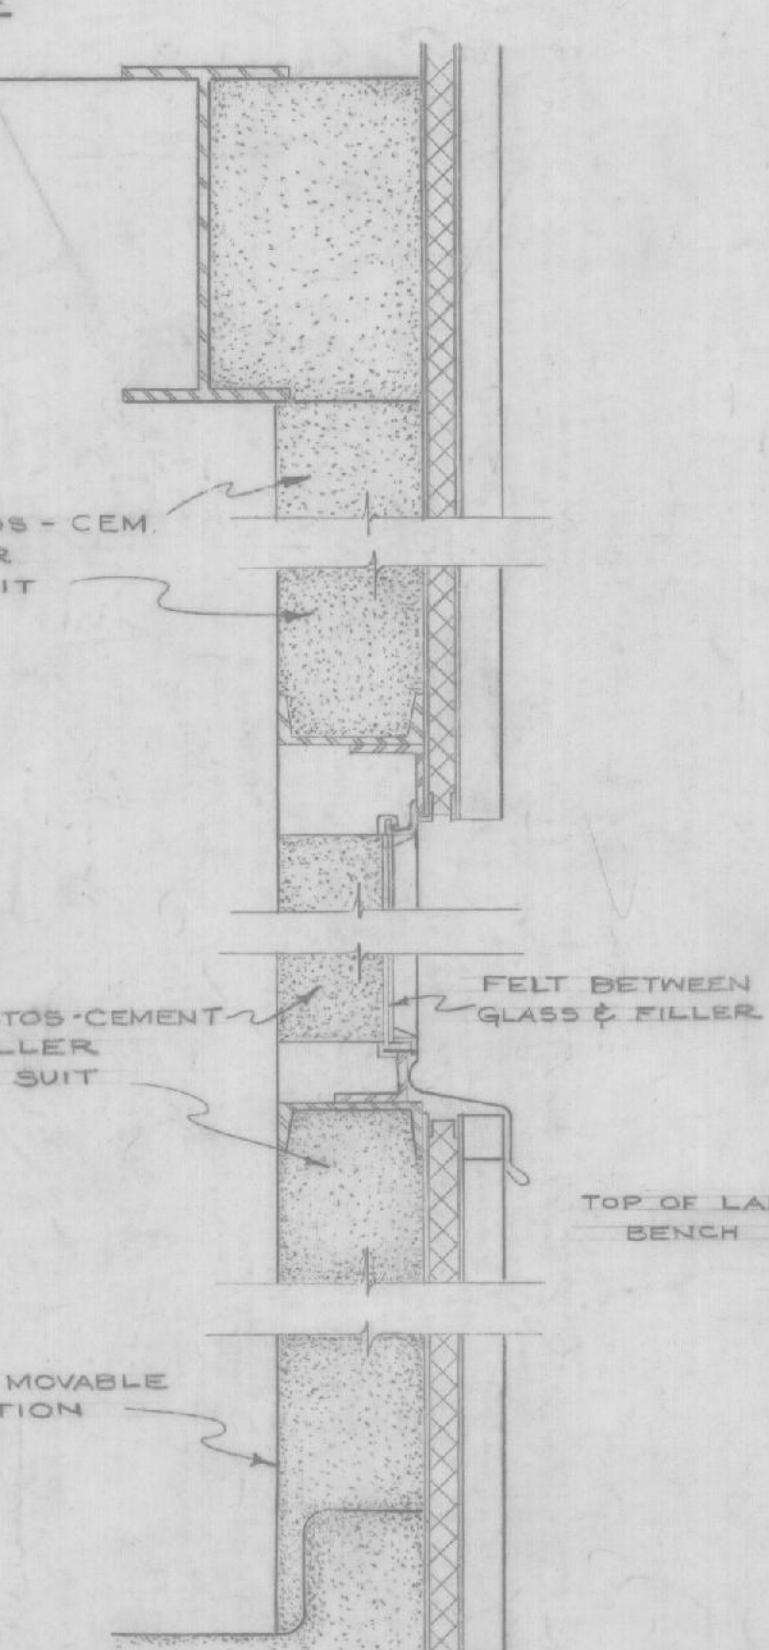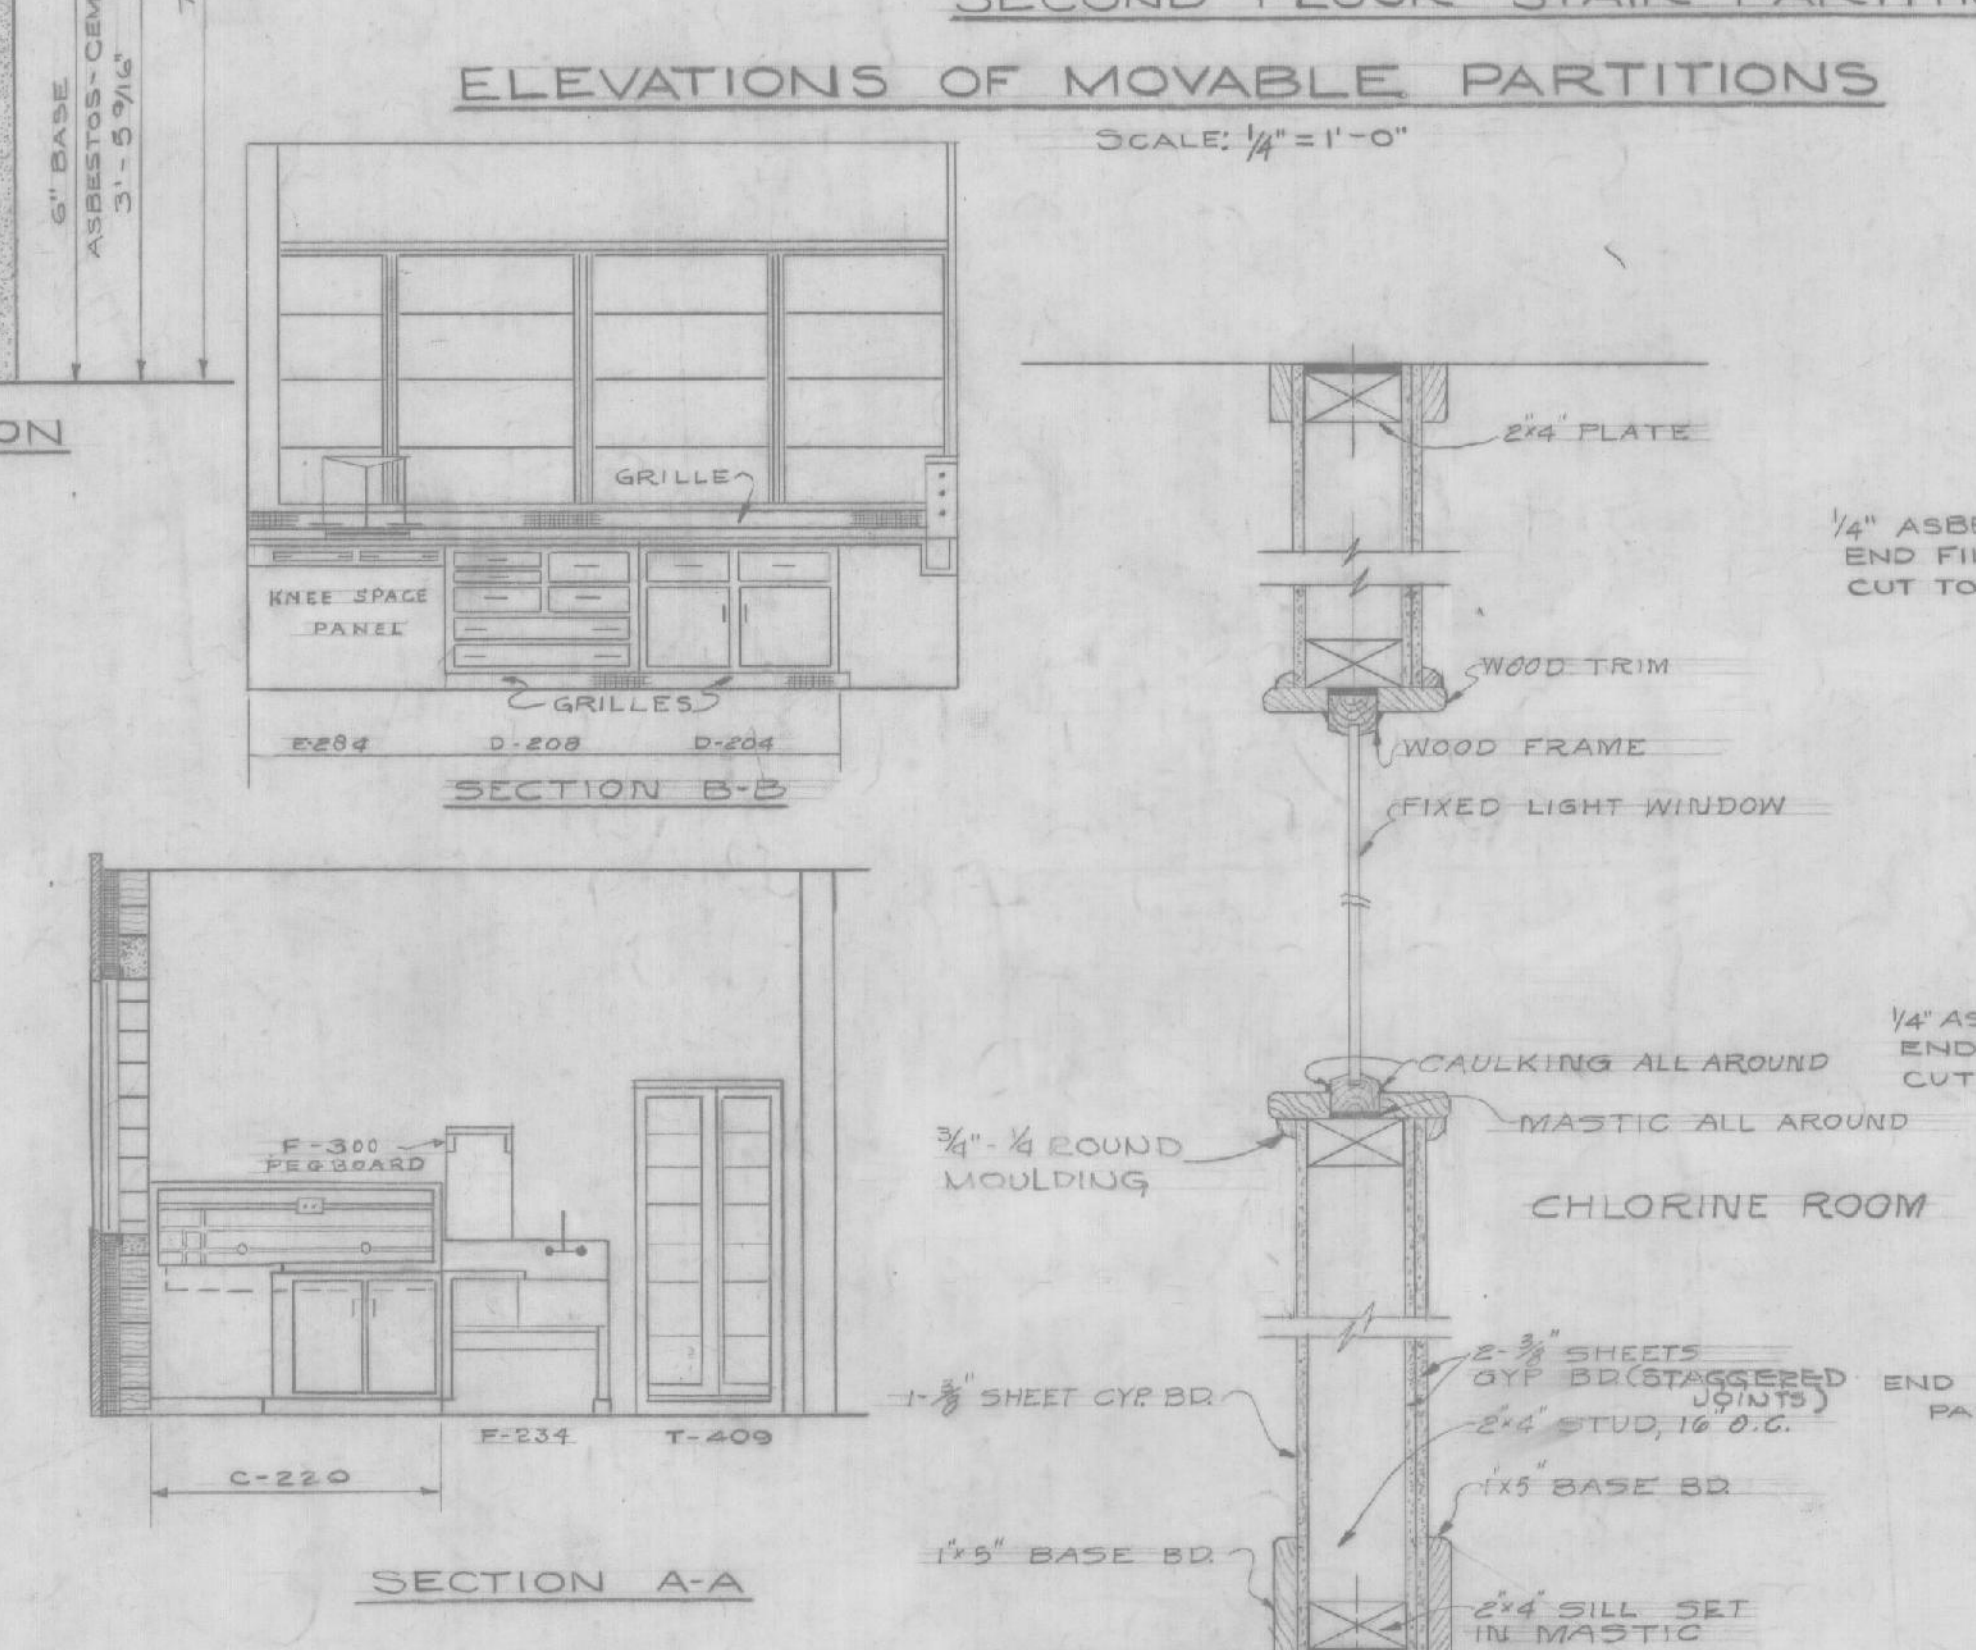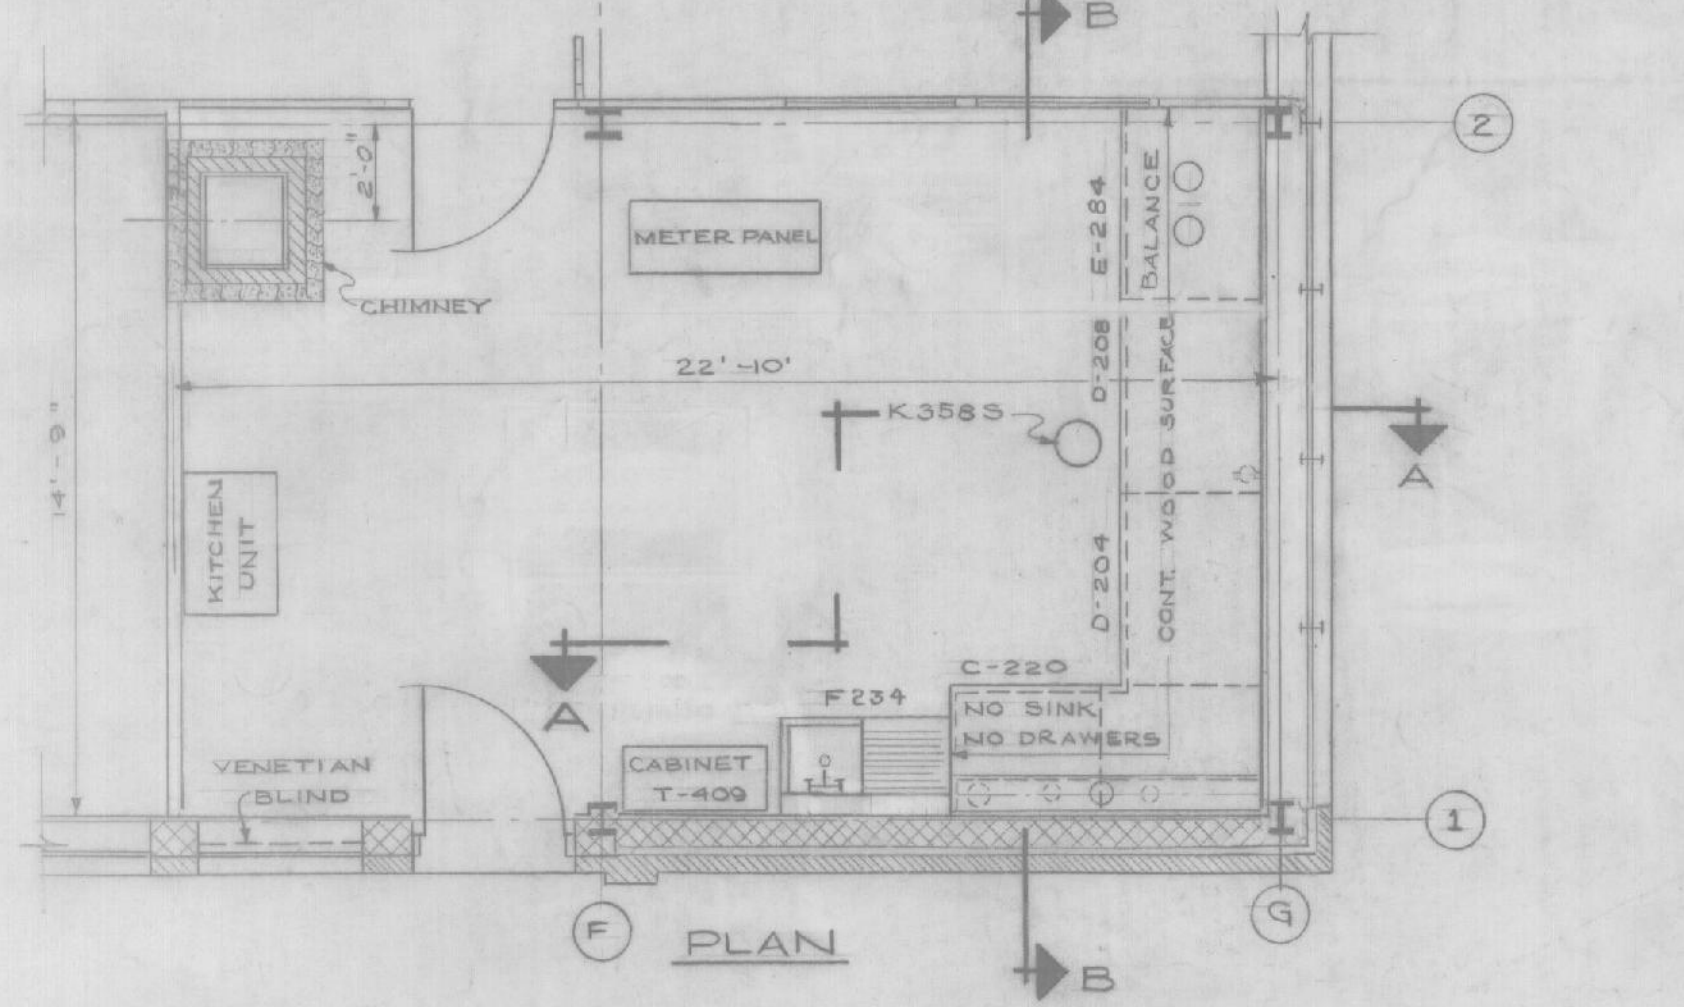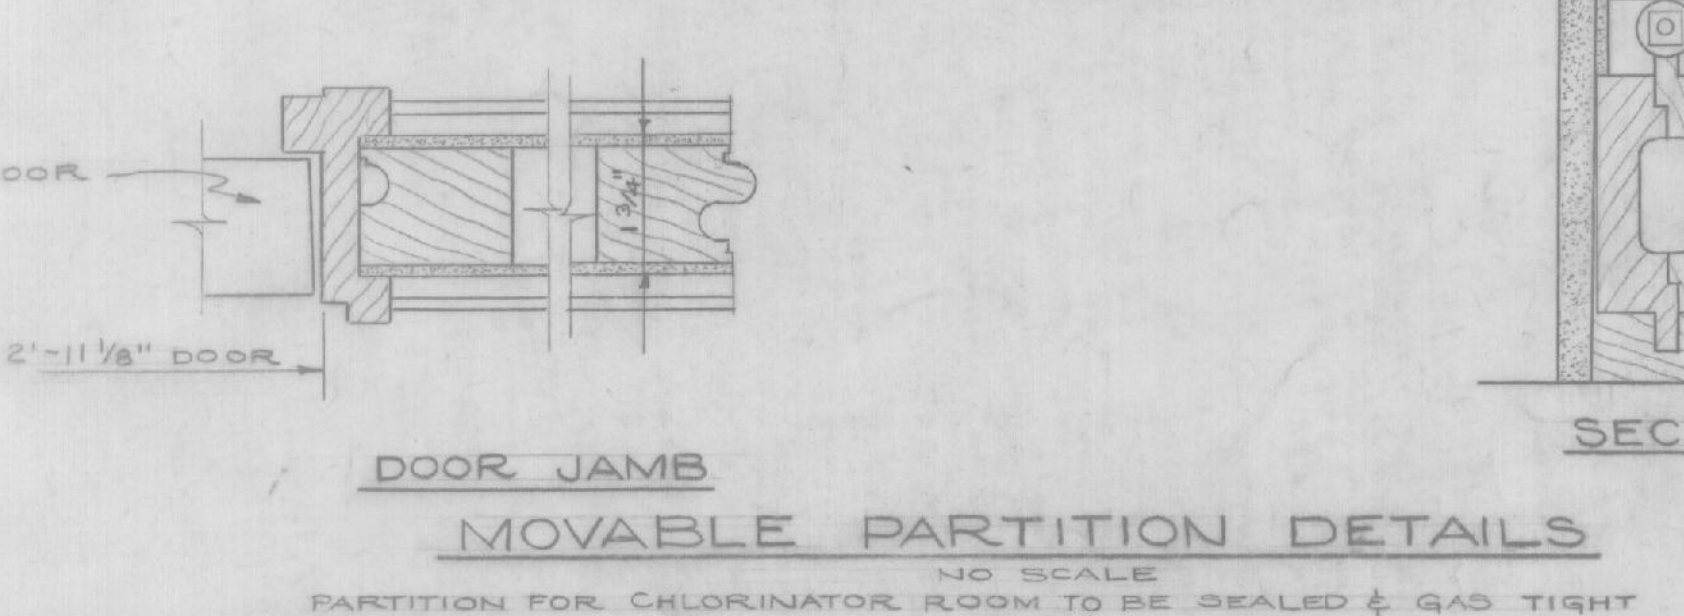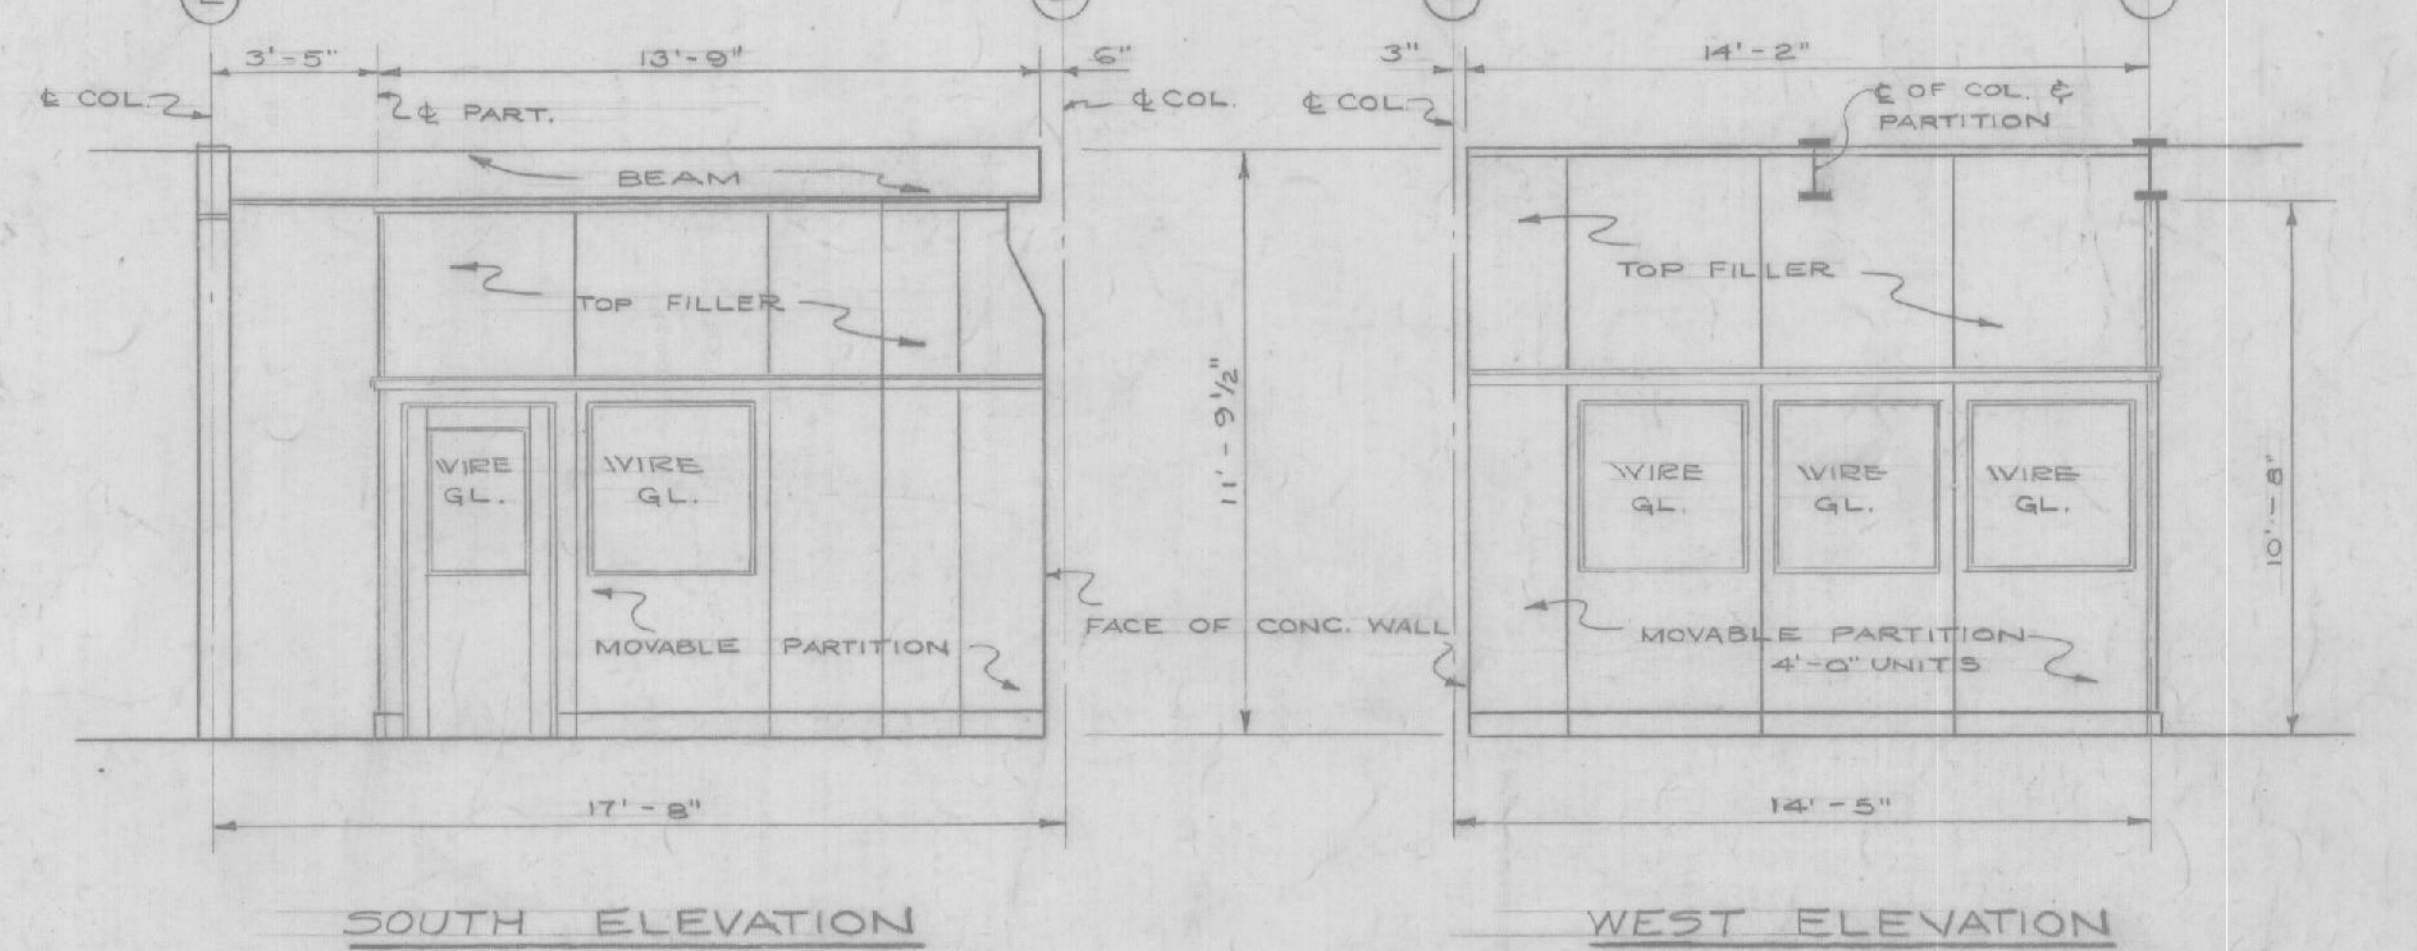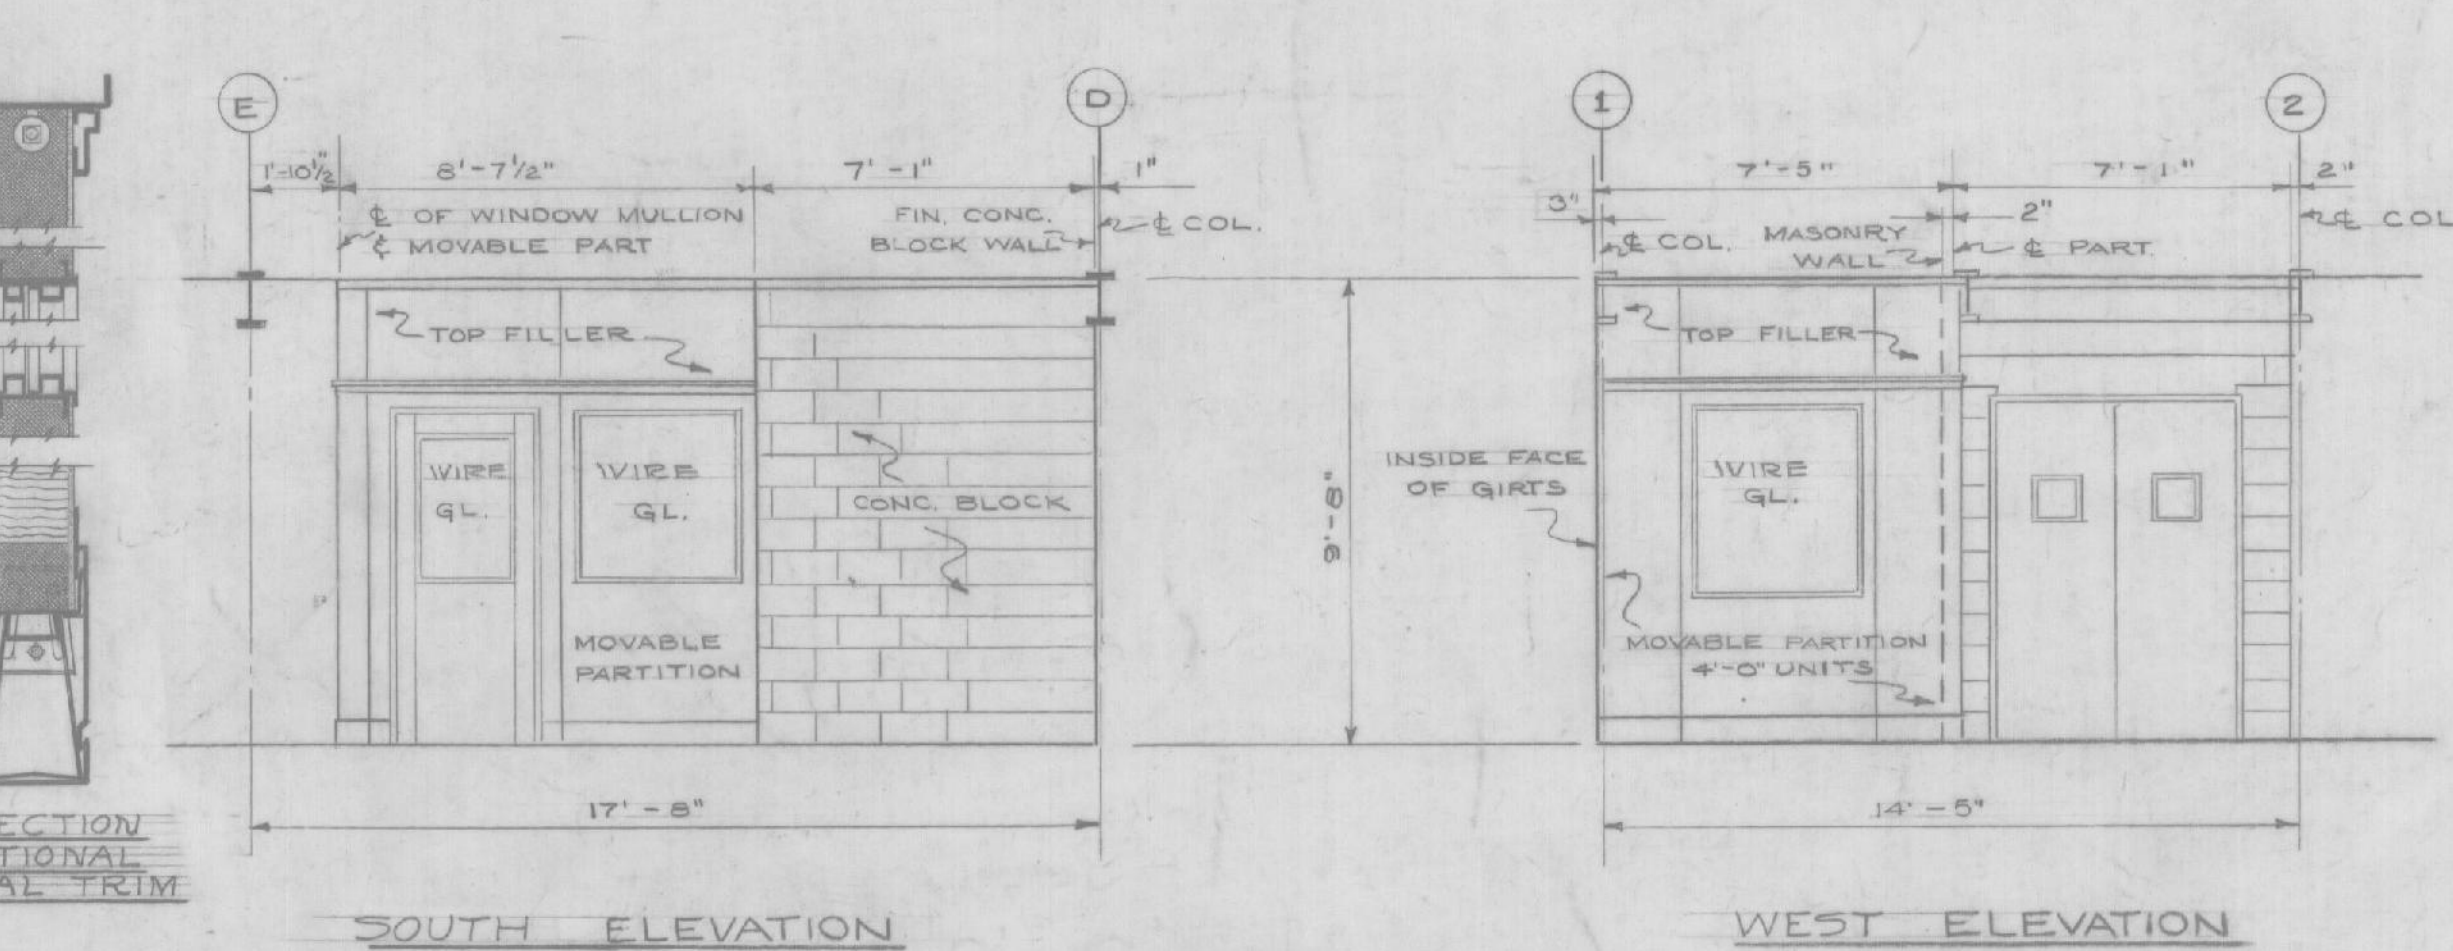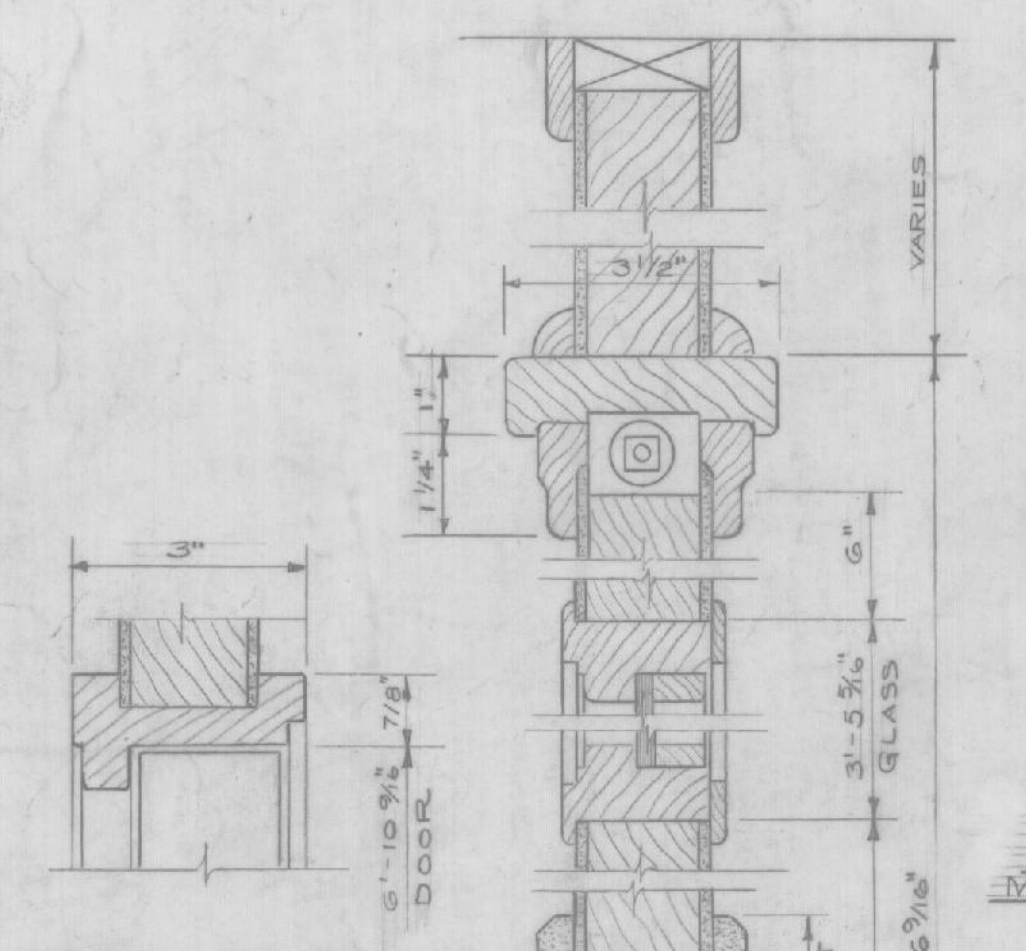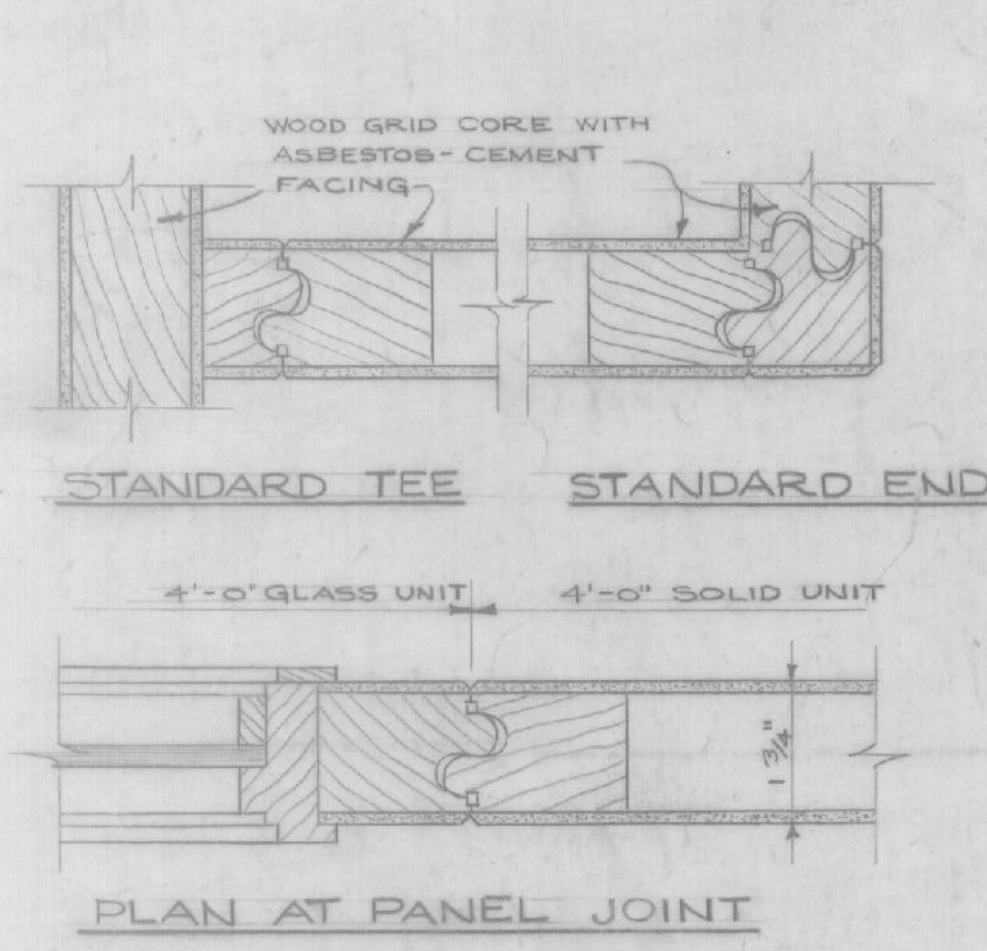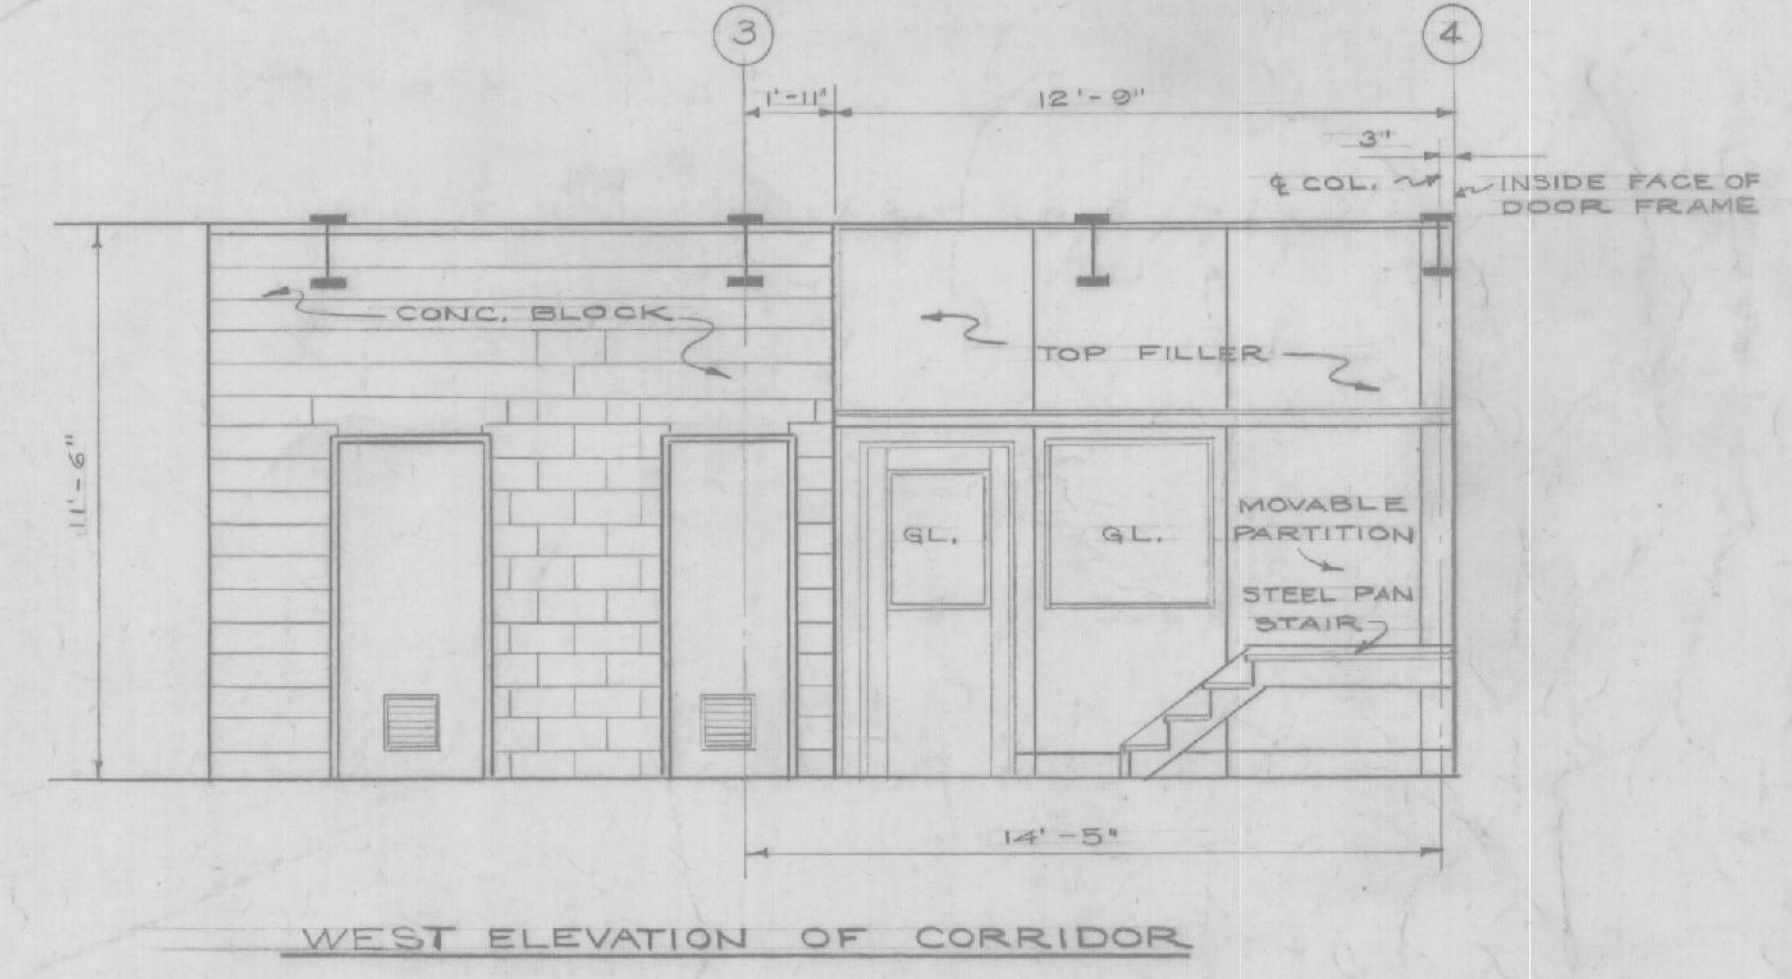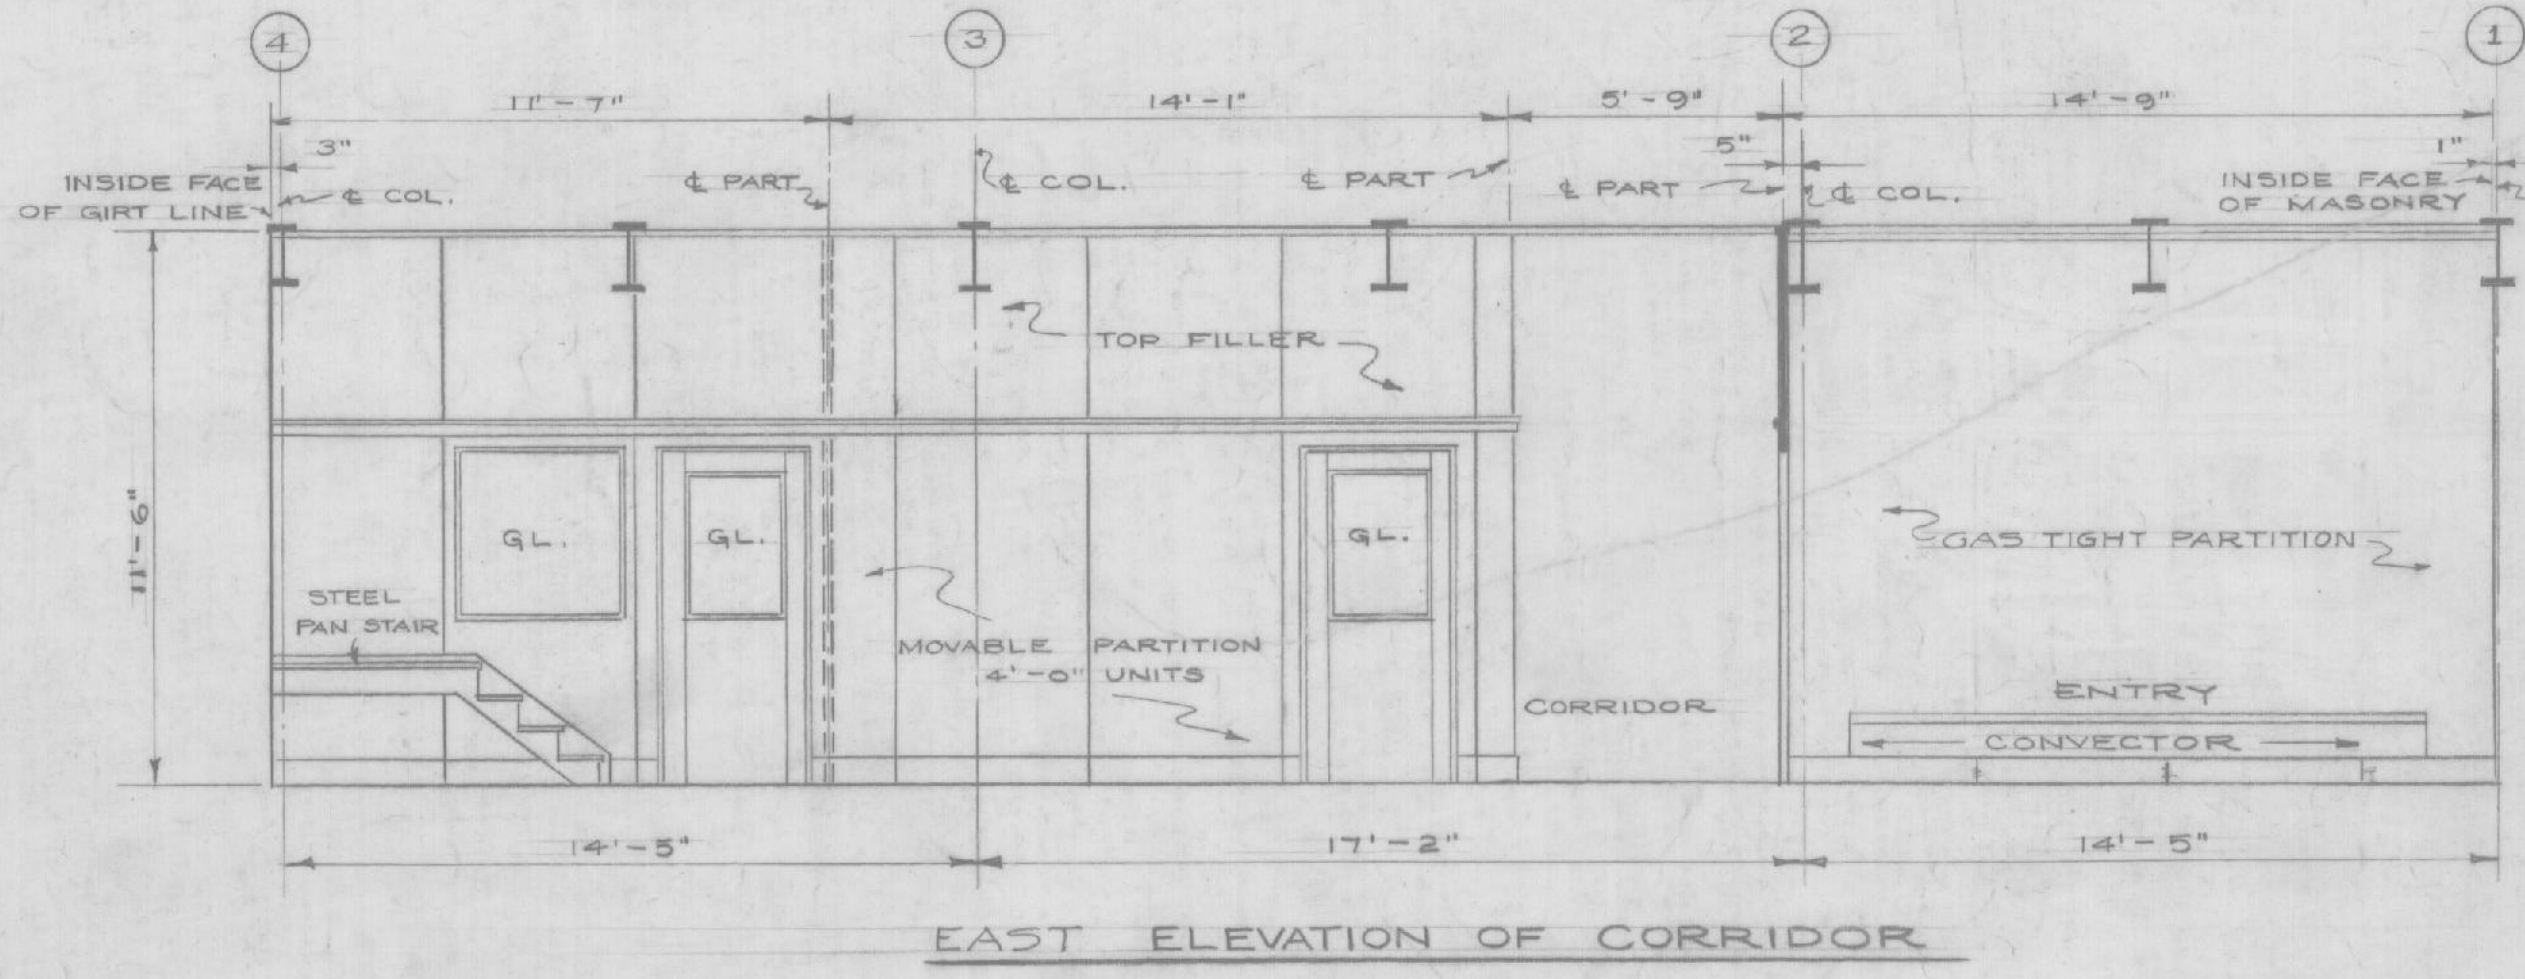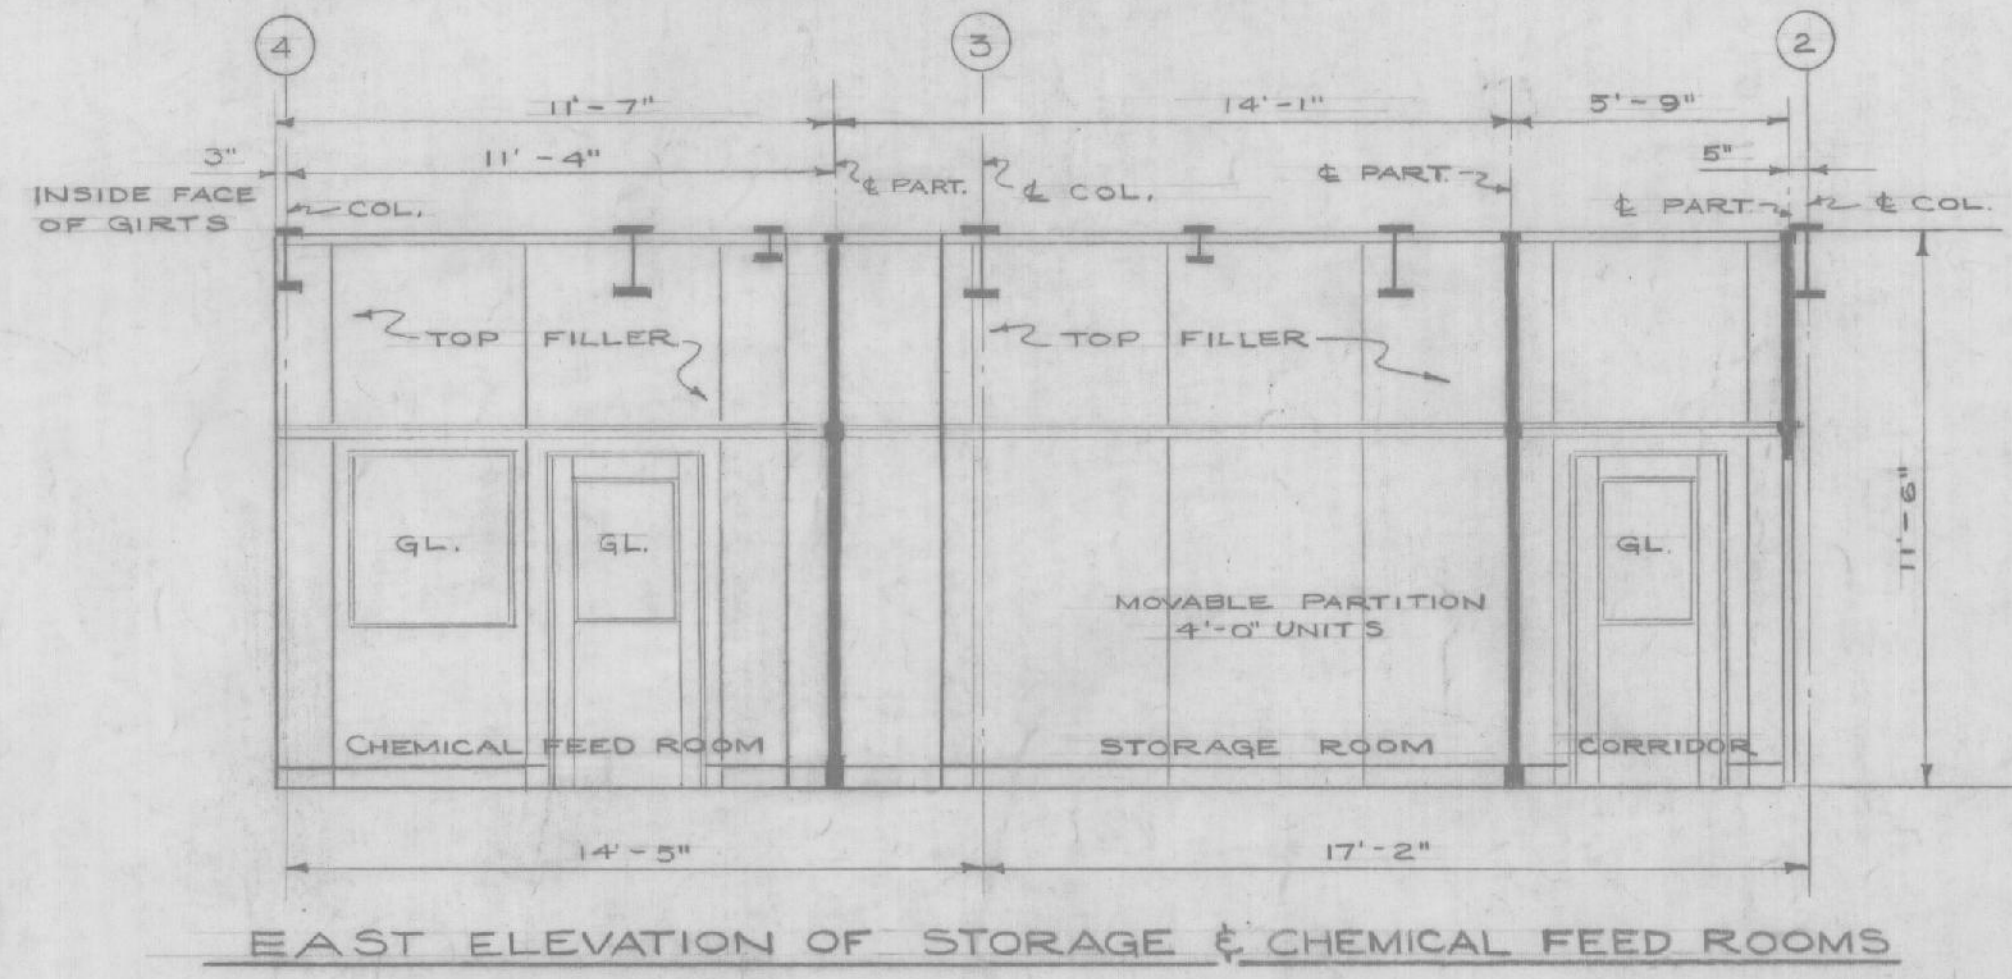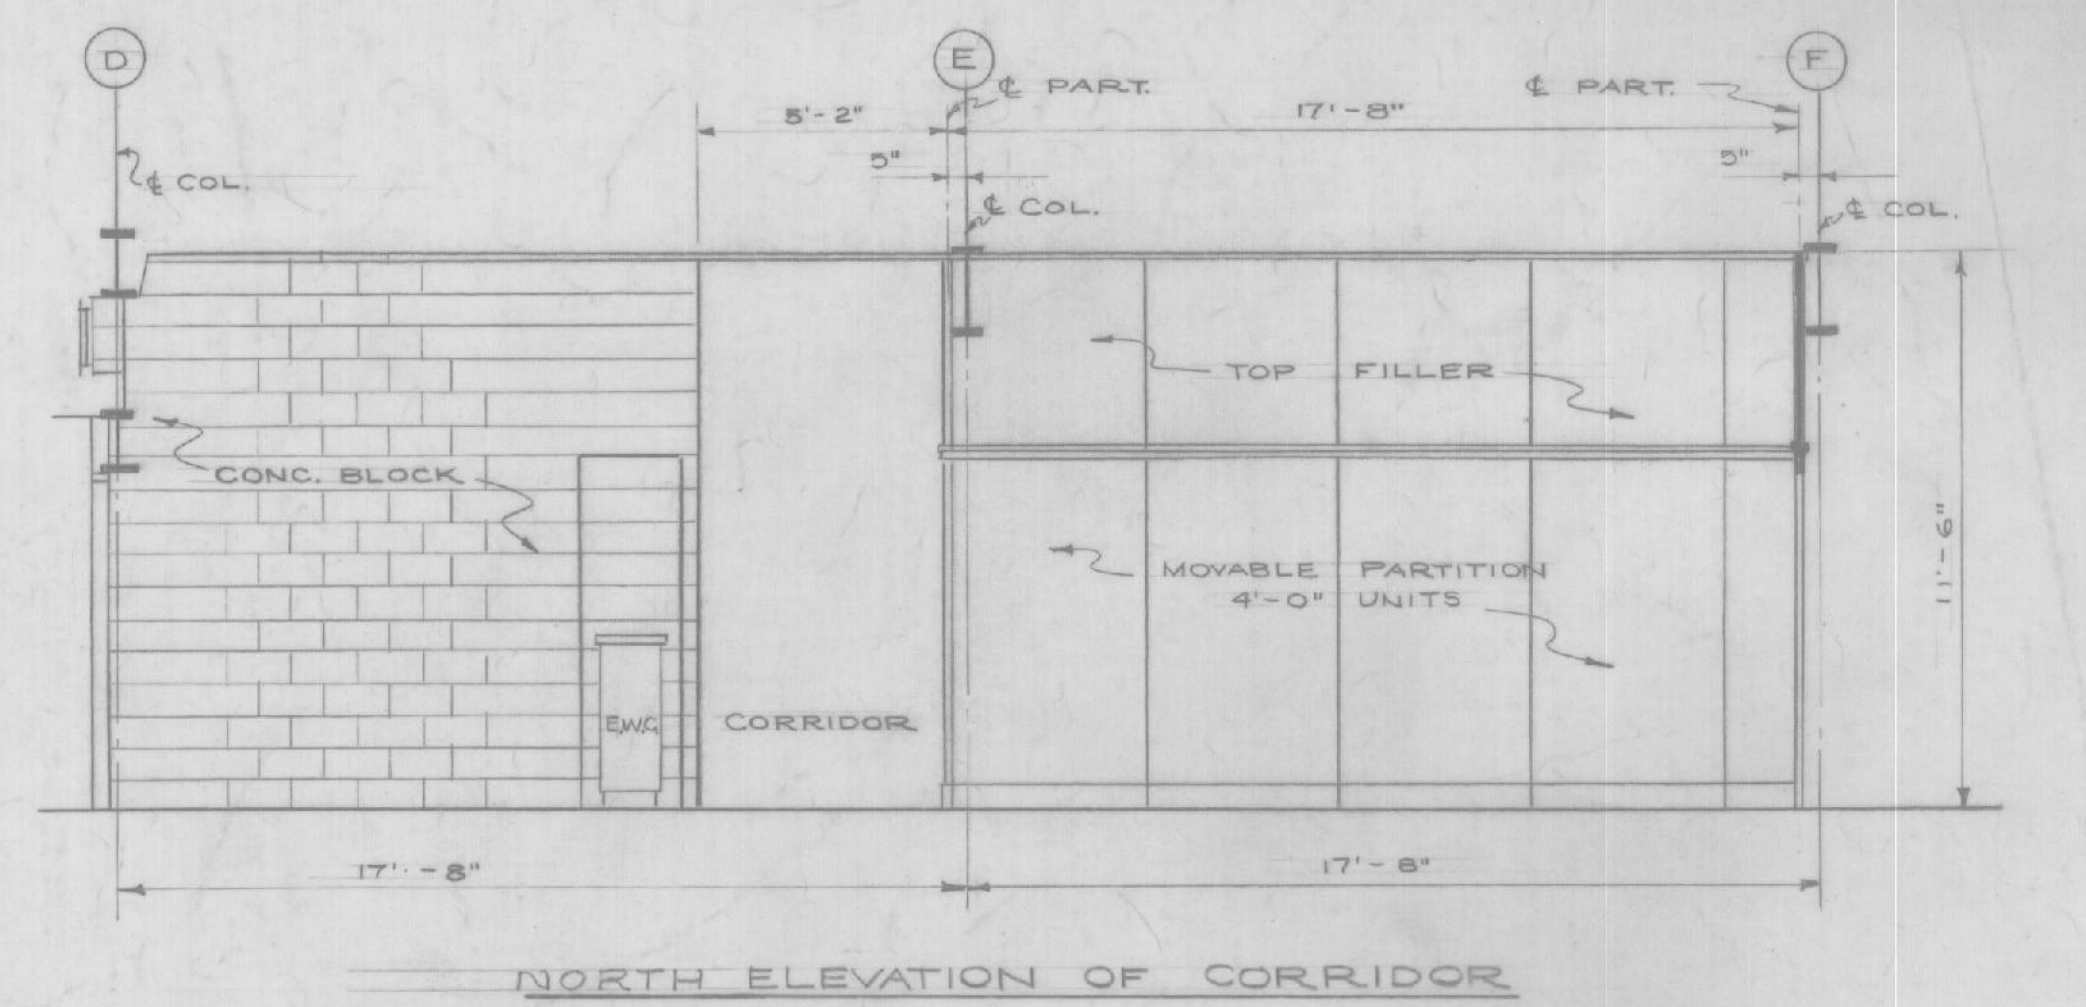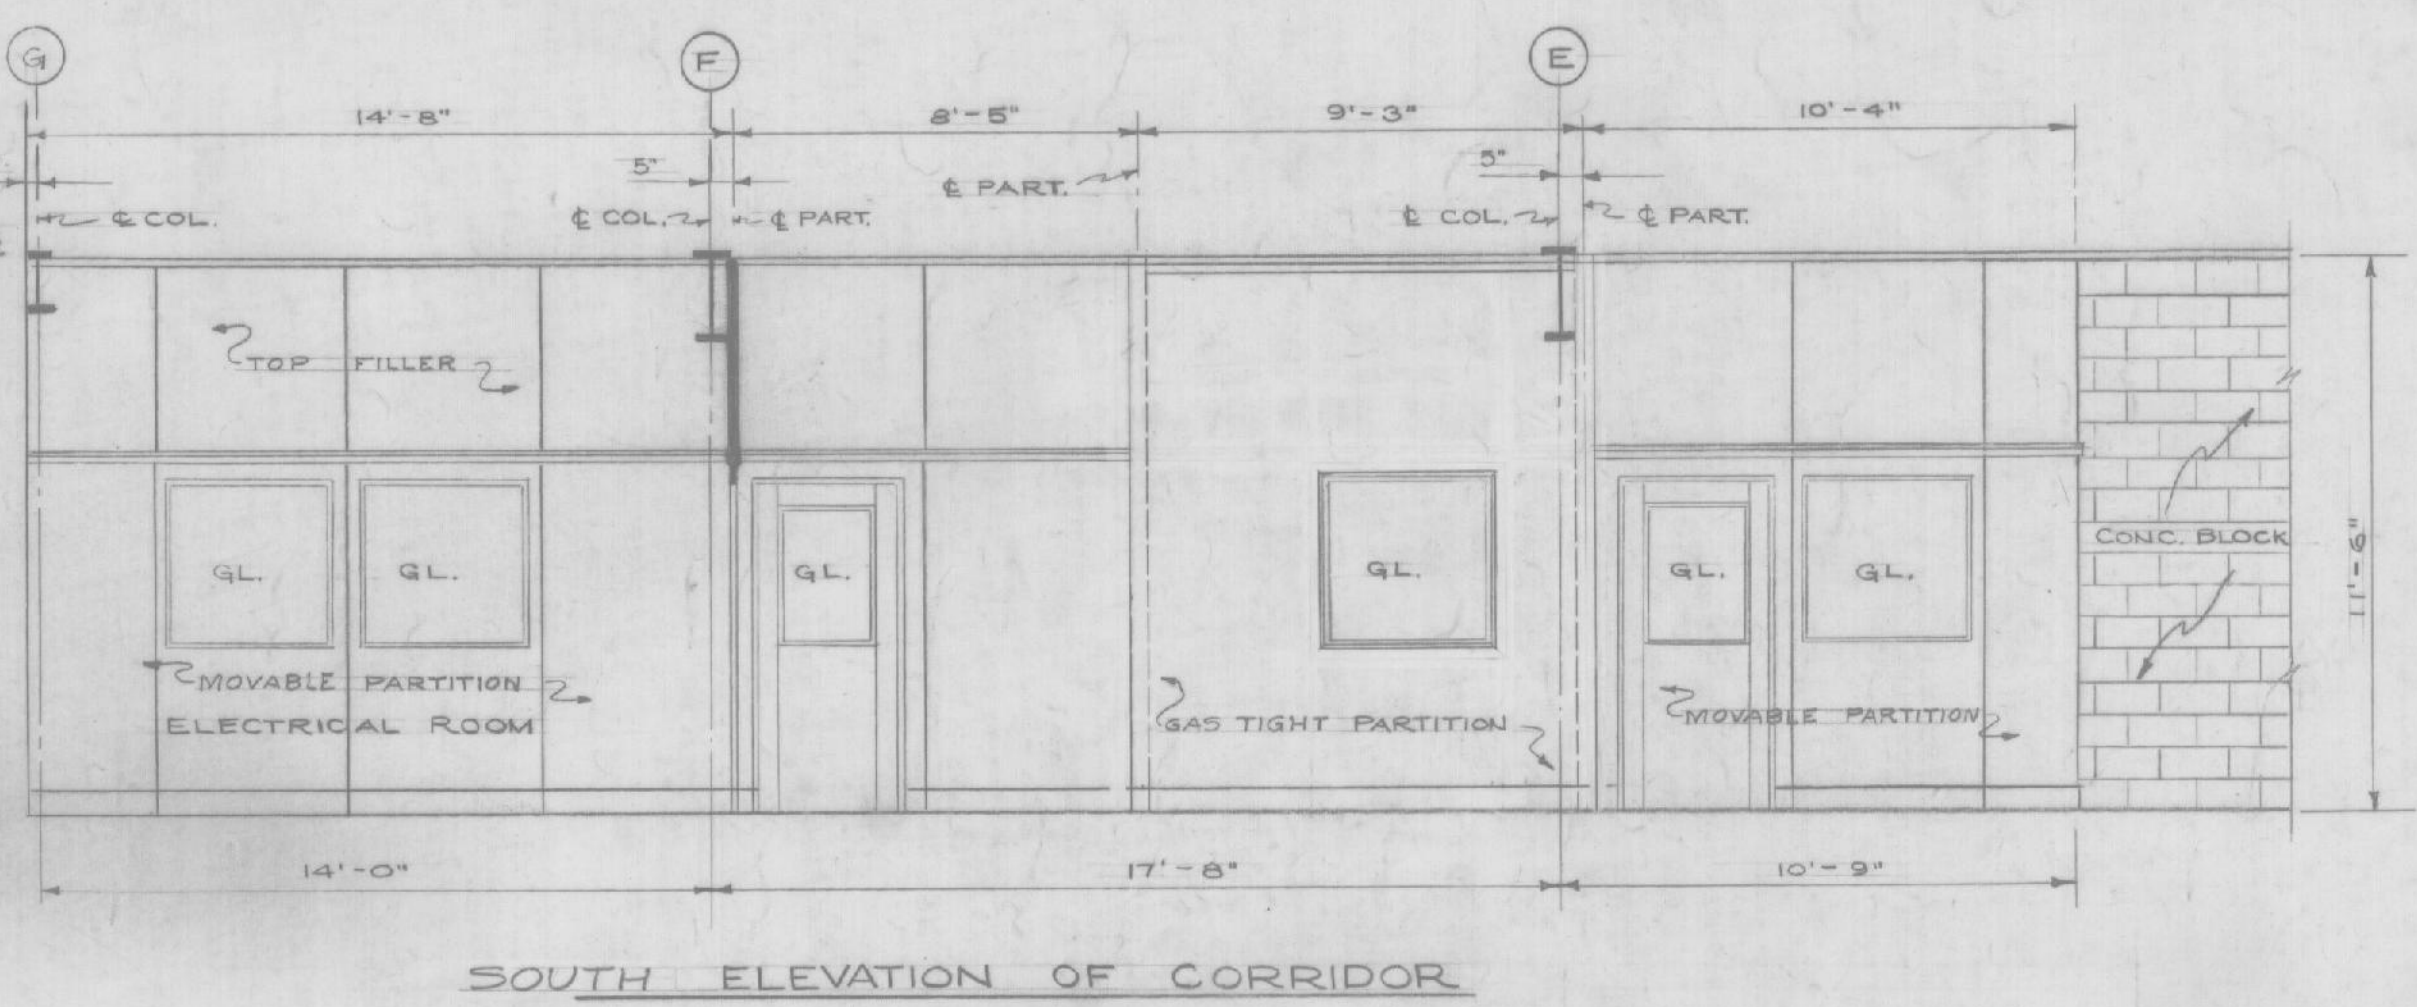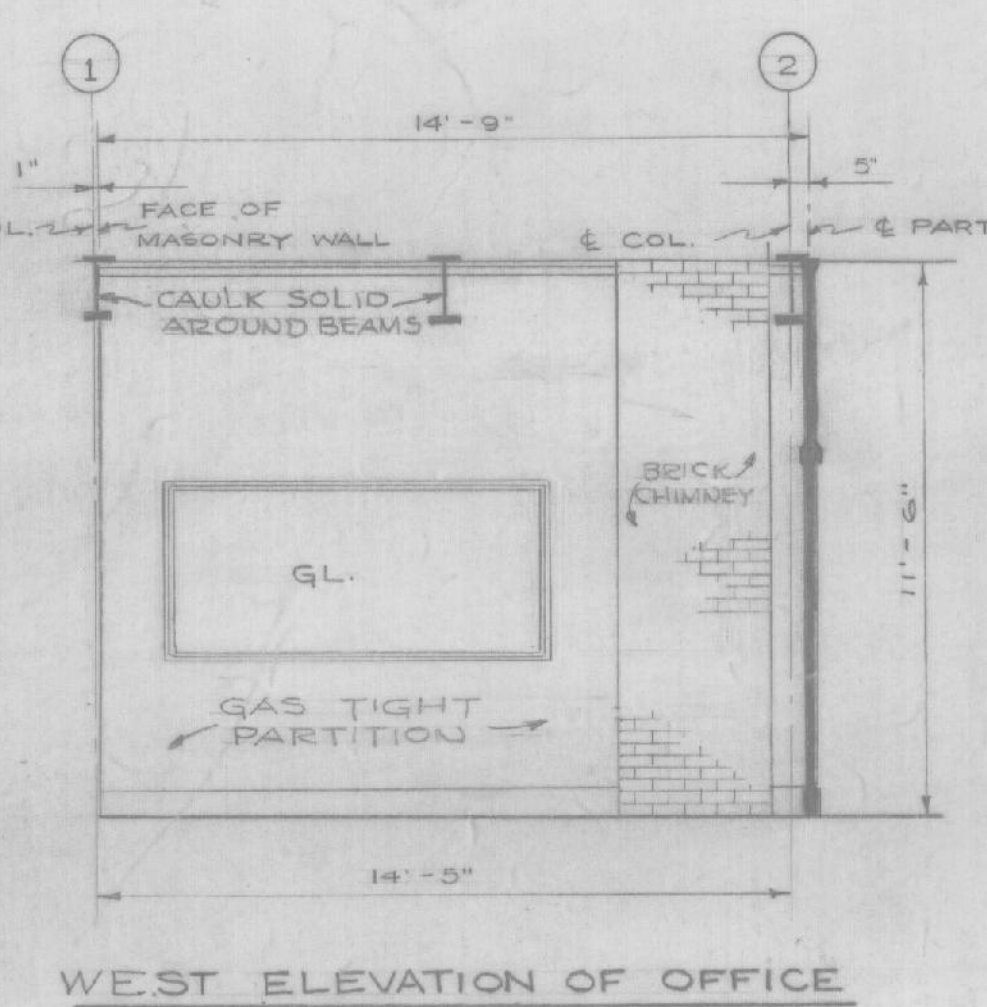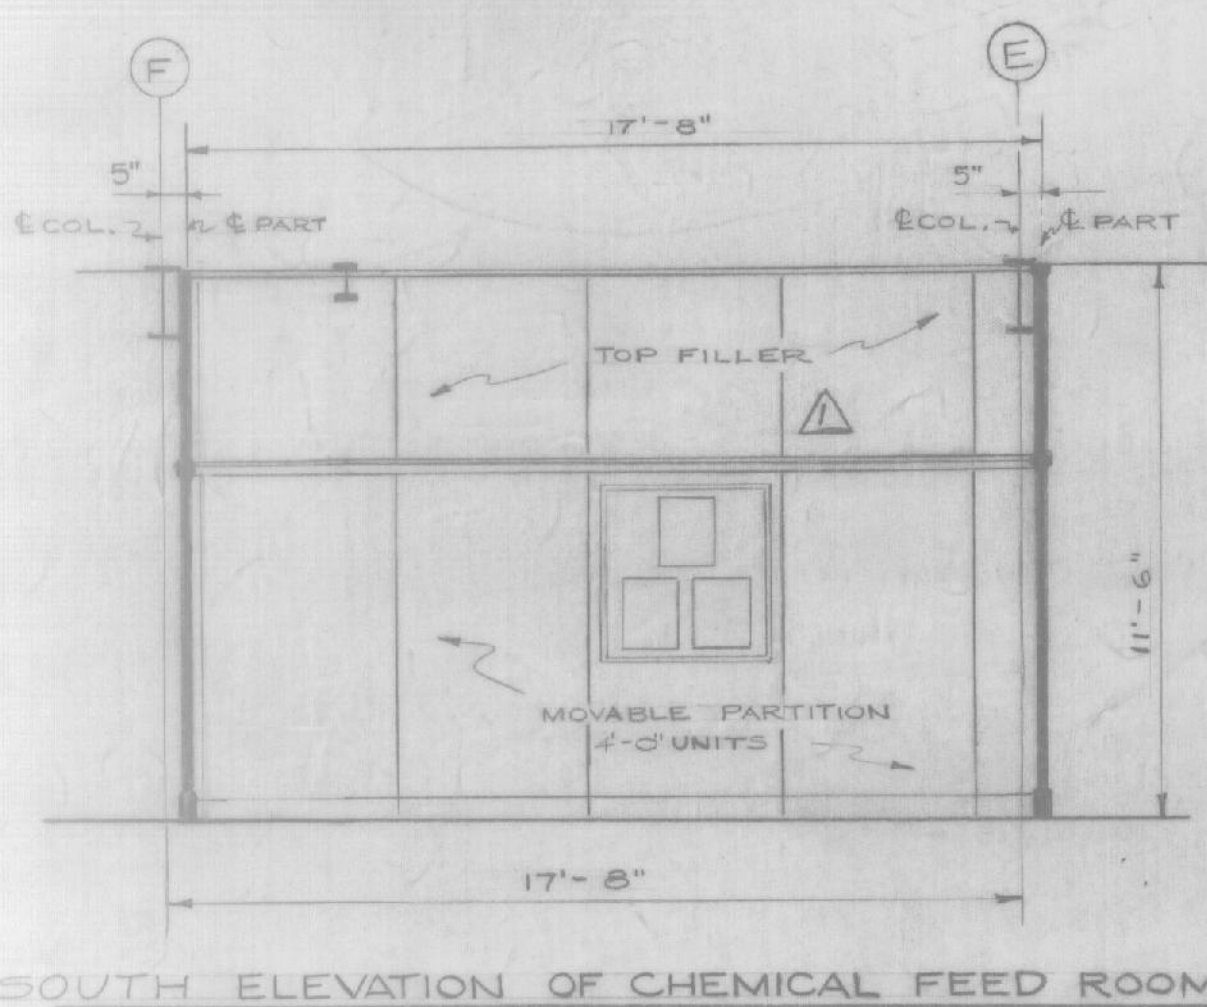

Record Drawing
 Contract No. DA-19-016-ENG-6199

REVISION	DATE	DESCRIPTION
1	9-14-59	CLOCK, PANEL AND NOTE DELETED (ADD #3)


















WHITMAN & HOWARD, INC.
 ENGINEERS
 89 BROAD ST., BOSTON, MASS.

CORPS OF ENGINEERS, U. S. ARMY
 OFFICE OF THE DIVISION ENGINEER
 NEW ENGLAND DIVISION
 WALTHAM, MASS.










PEASE AIR FORCE BASE
 PORTSMOUTH, NEW HAMPSHIRE
SURFACE WATER SUPPLY
 FILTER BUILDING
 ARCHITECTURAL
 LABORATORY AND MOVABLE PARTITIONS

DRAWN BY: ABS
 TRACED BY: ABS
 CHECKED BY: CGM
 SUBMITTED: [Signature]
 APPROVED: [Signature]
 DATE: JUNE, 1959

SCALE: As Noted
 SPEC NO: 157-157-157-59-152
 DRAWING NUMBER: AW 71-05-31
 SHEET 8

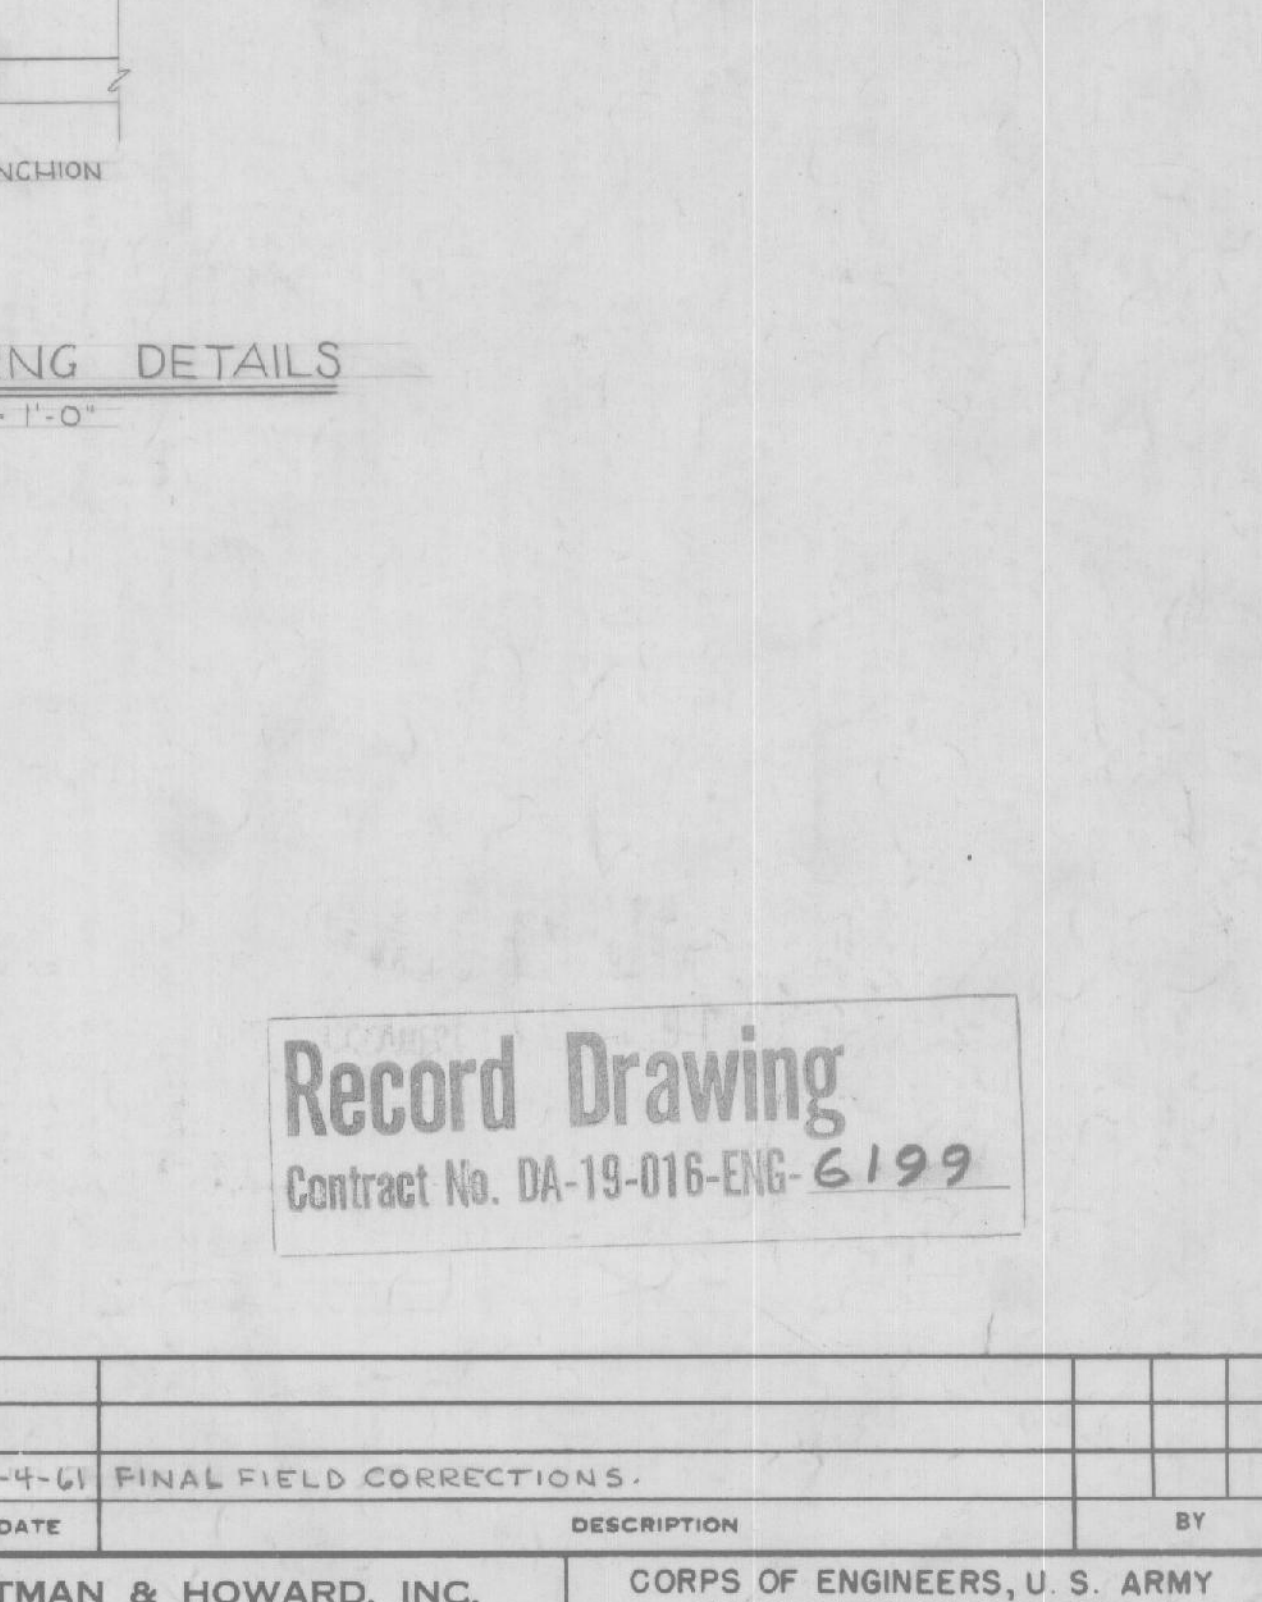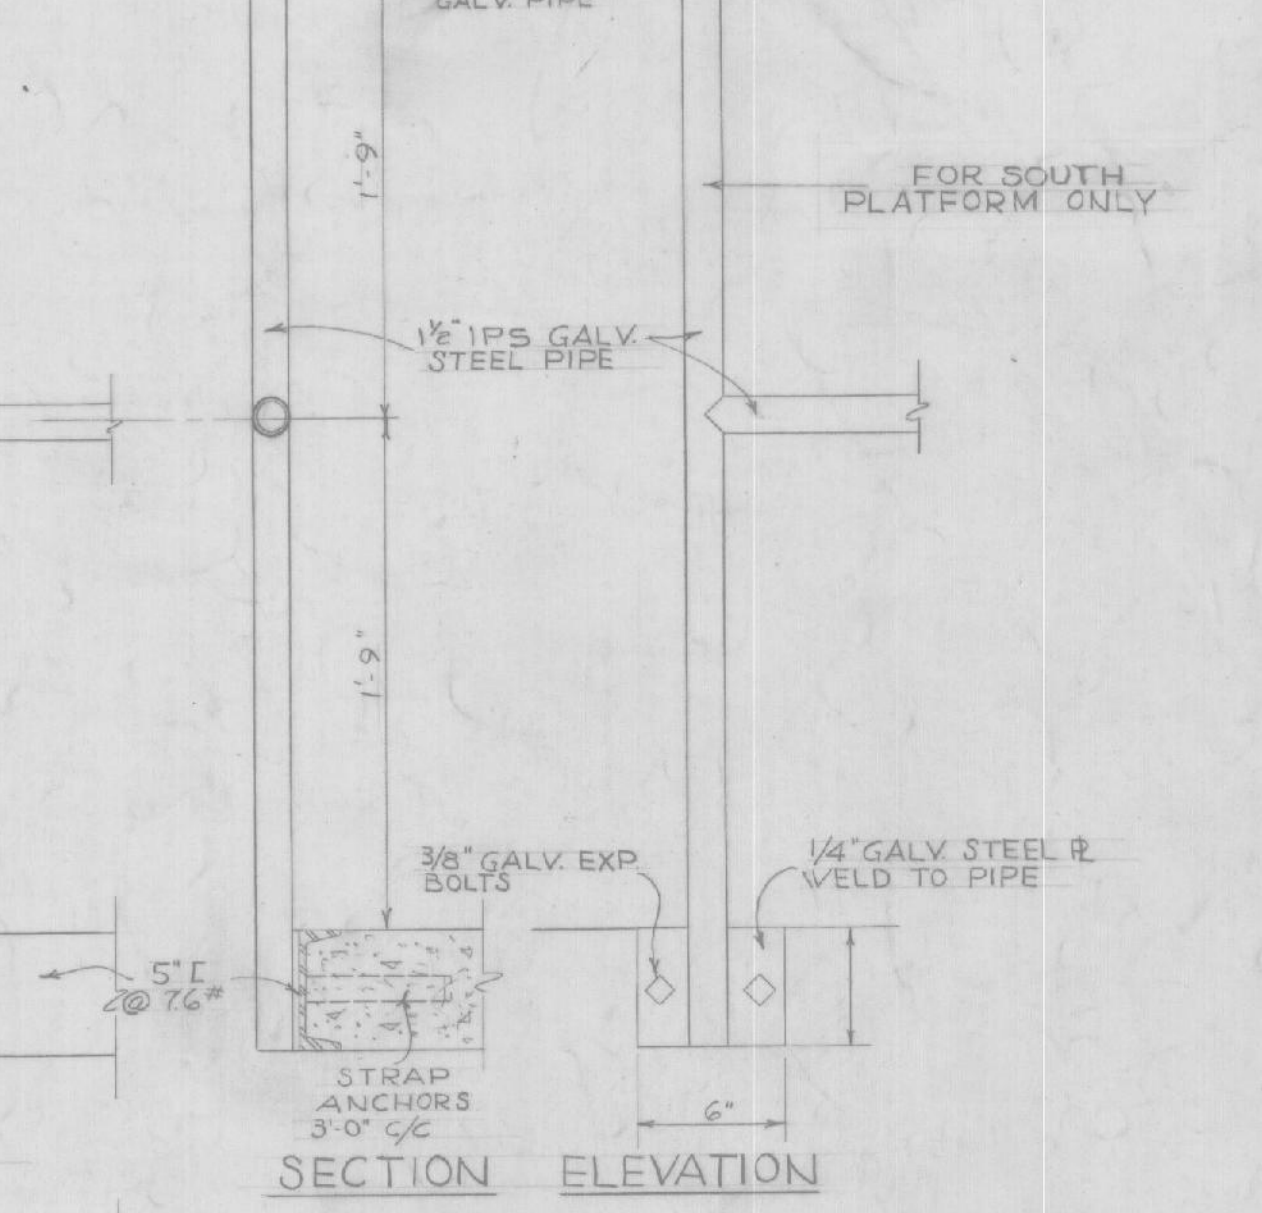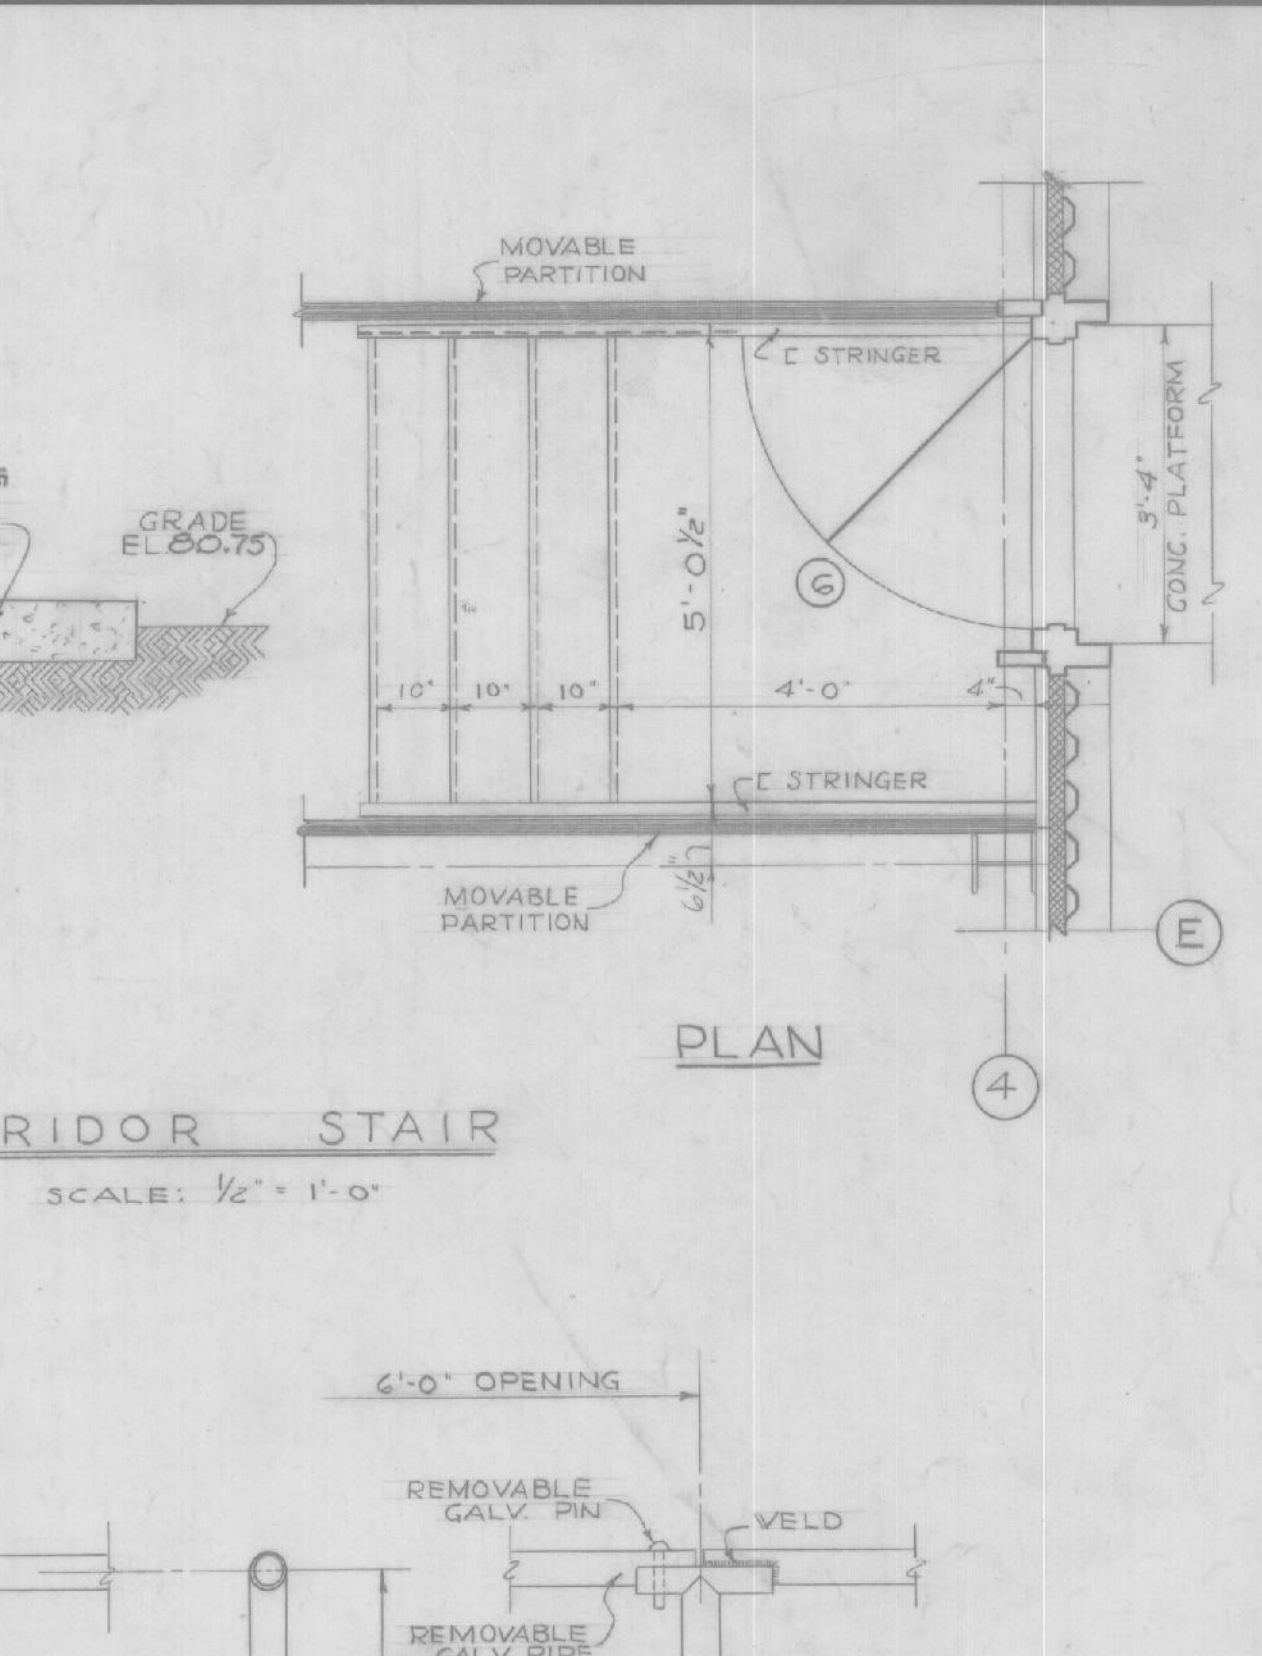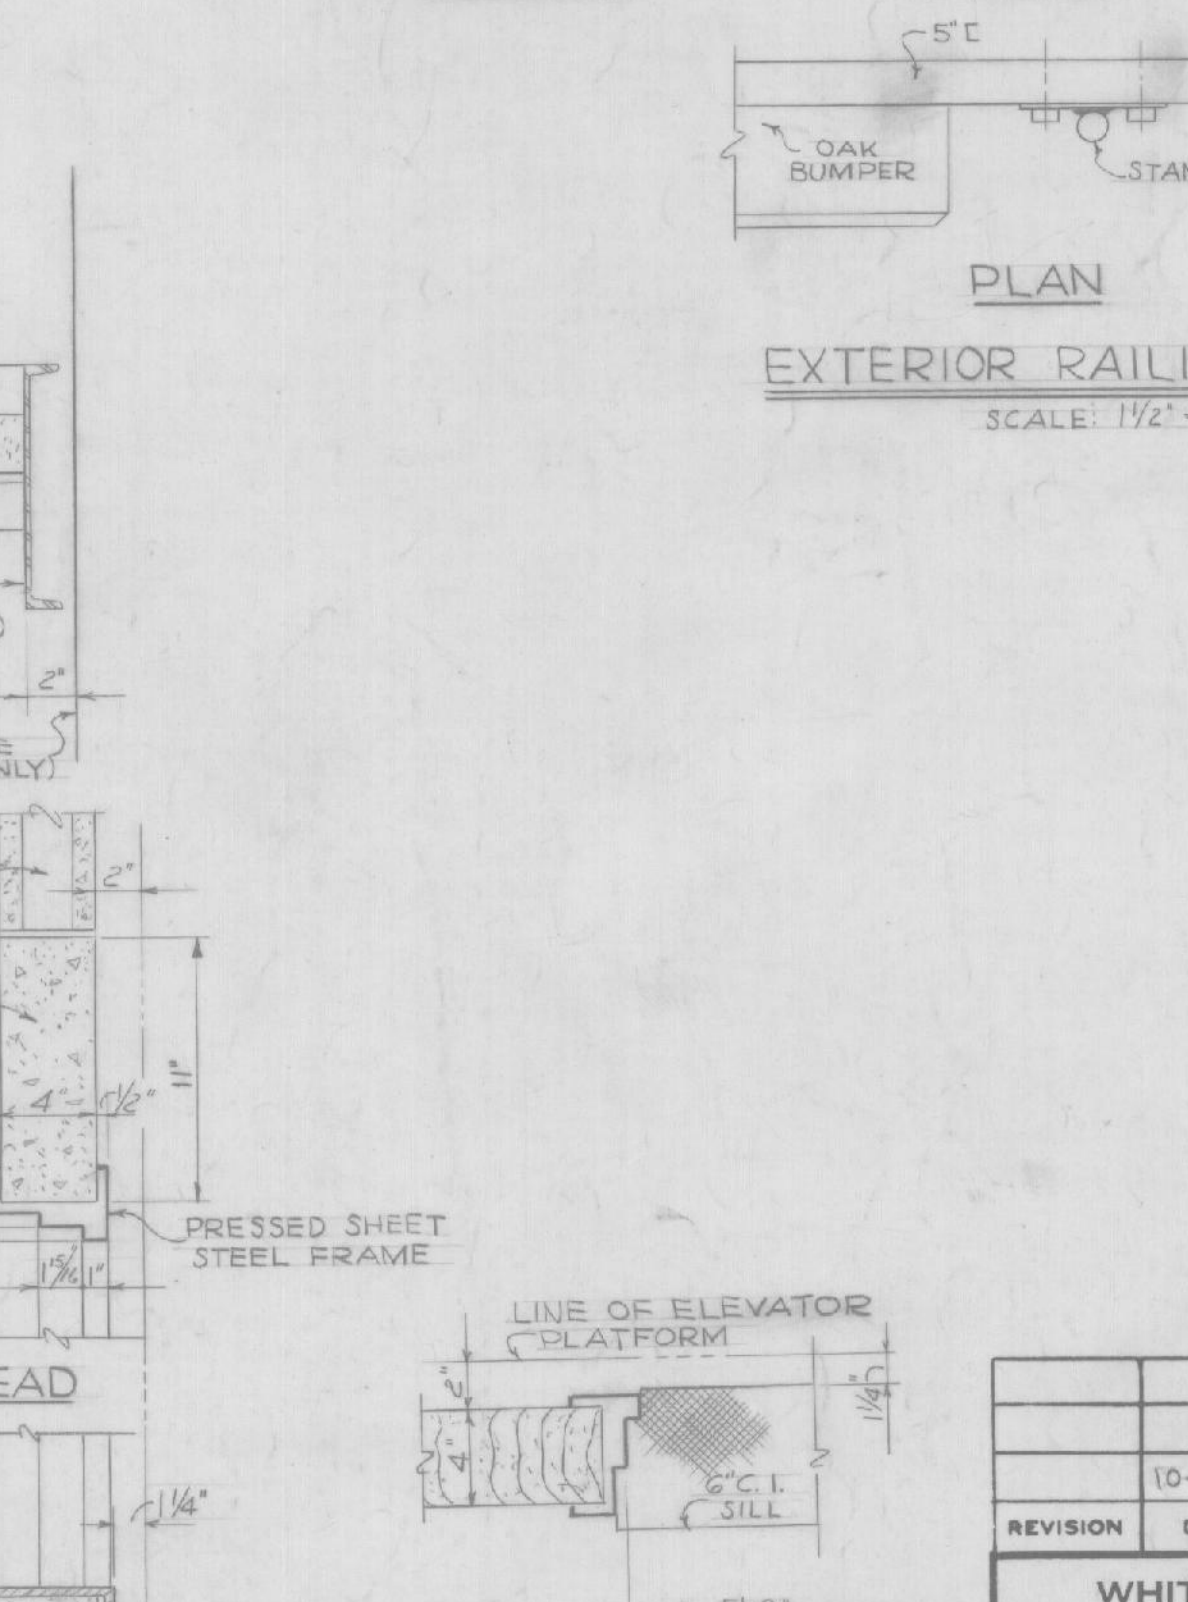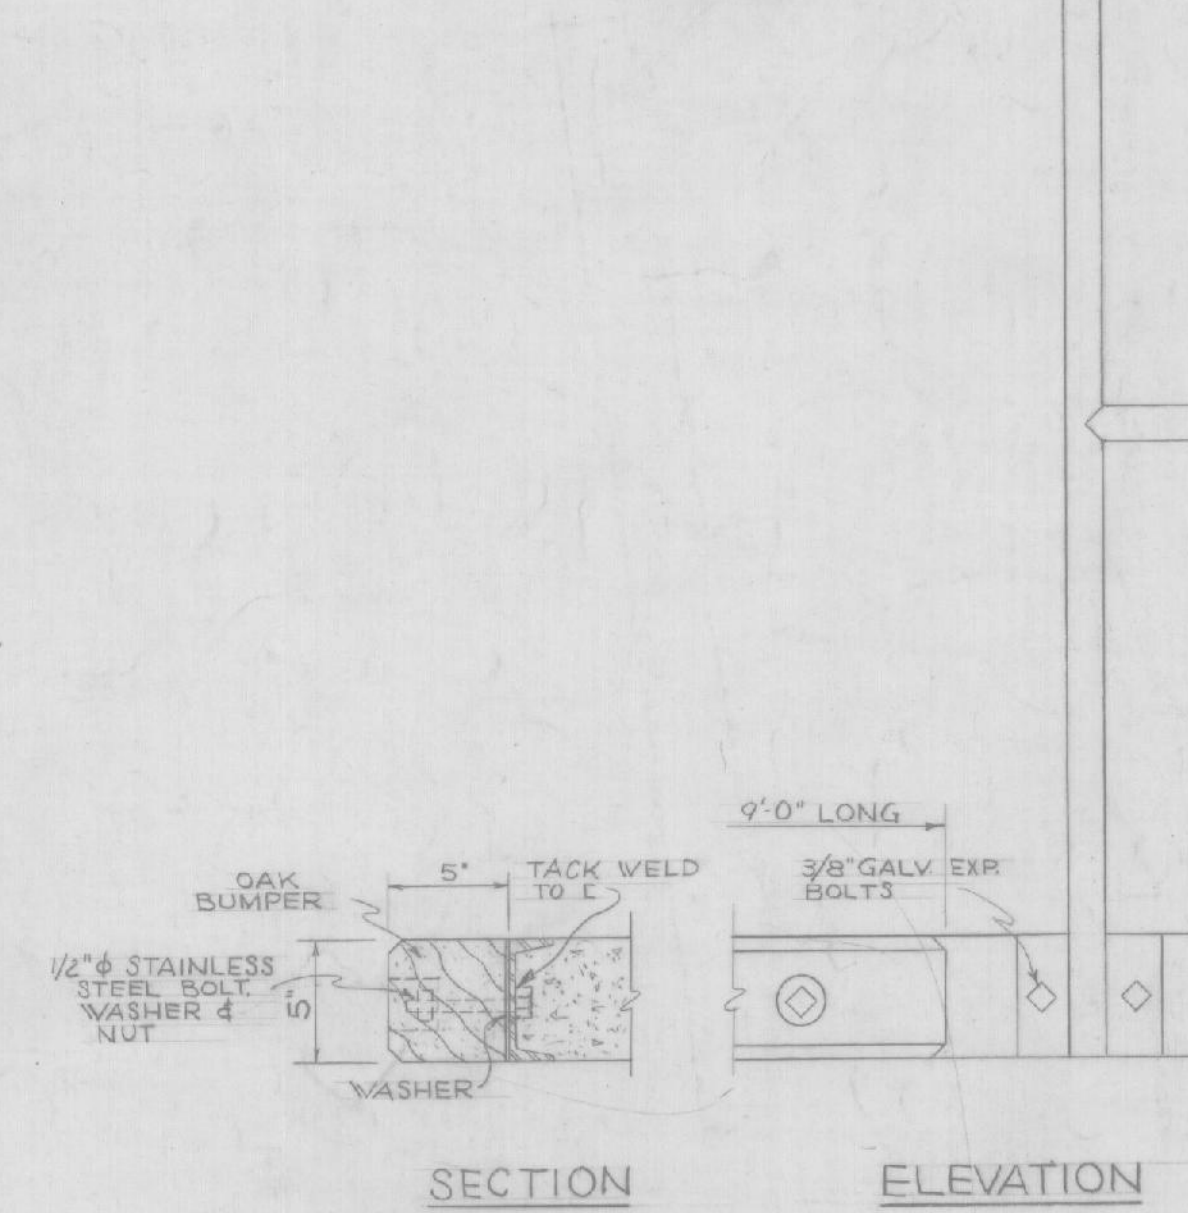
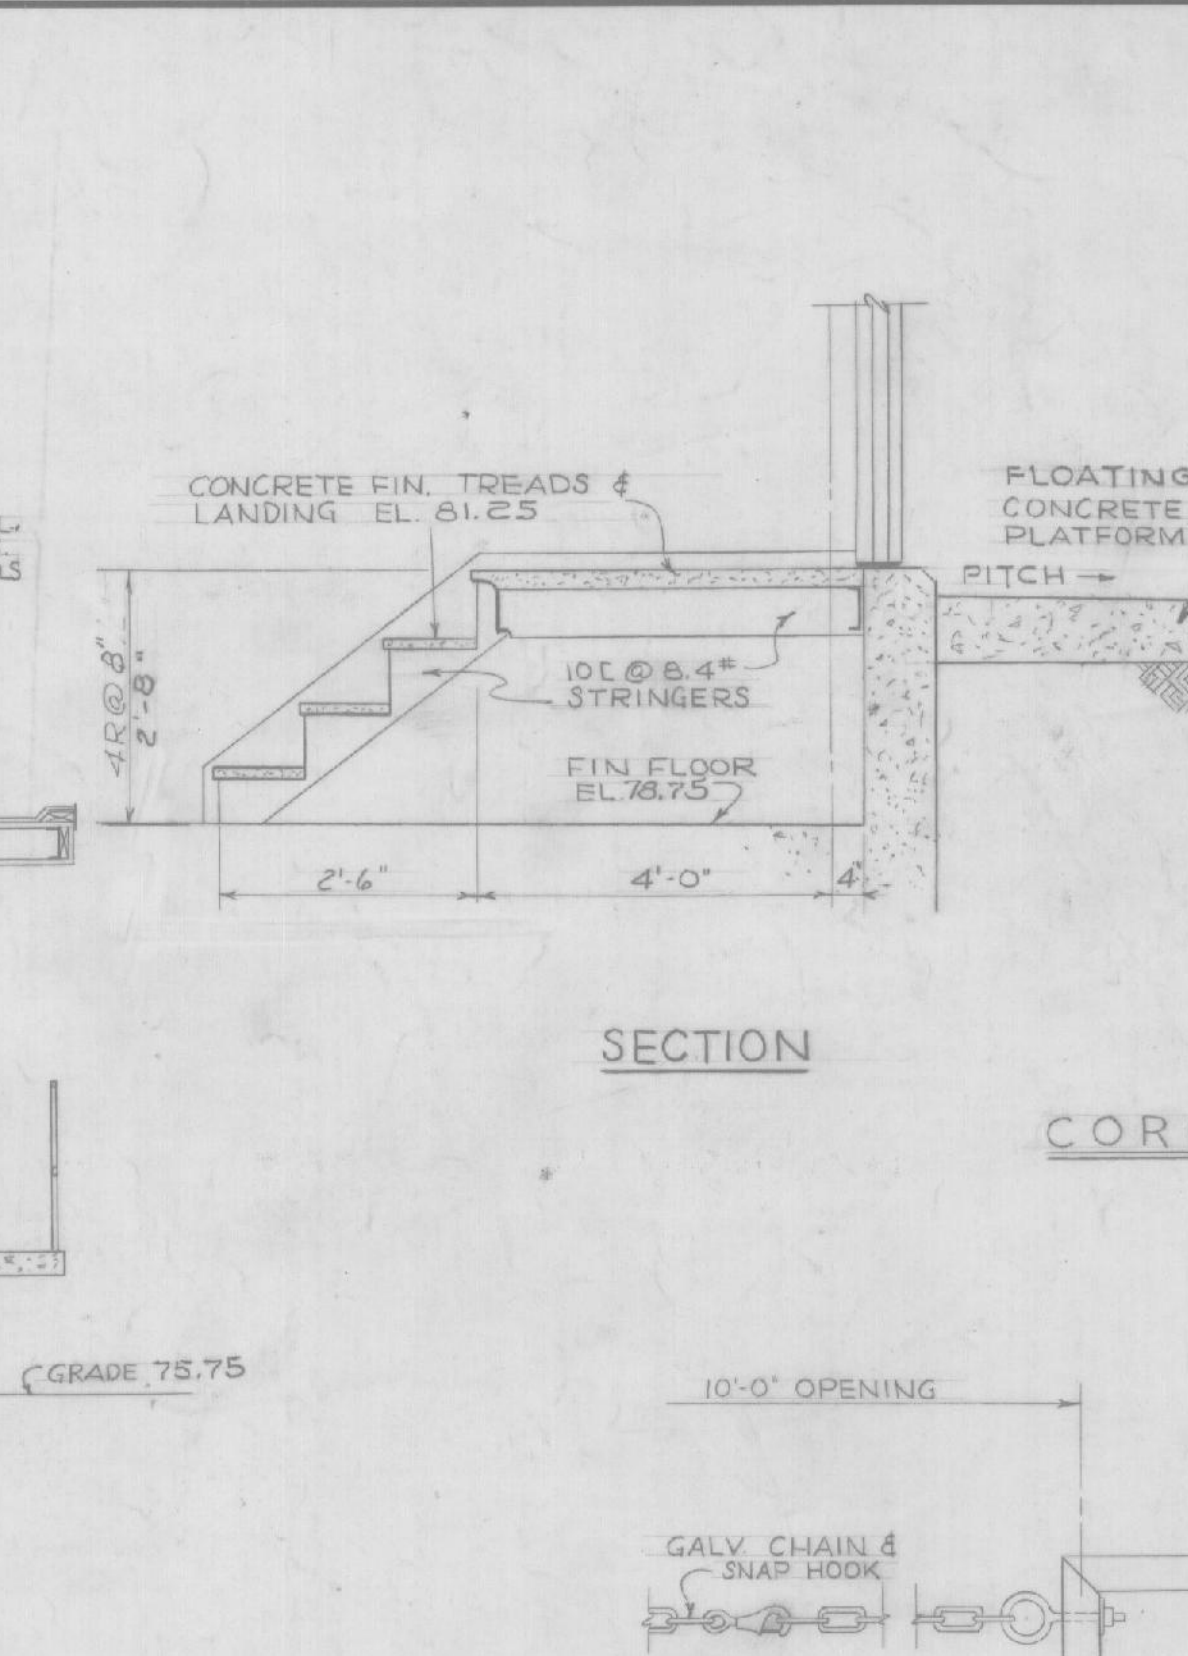
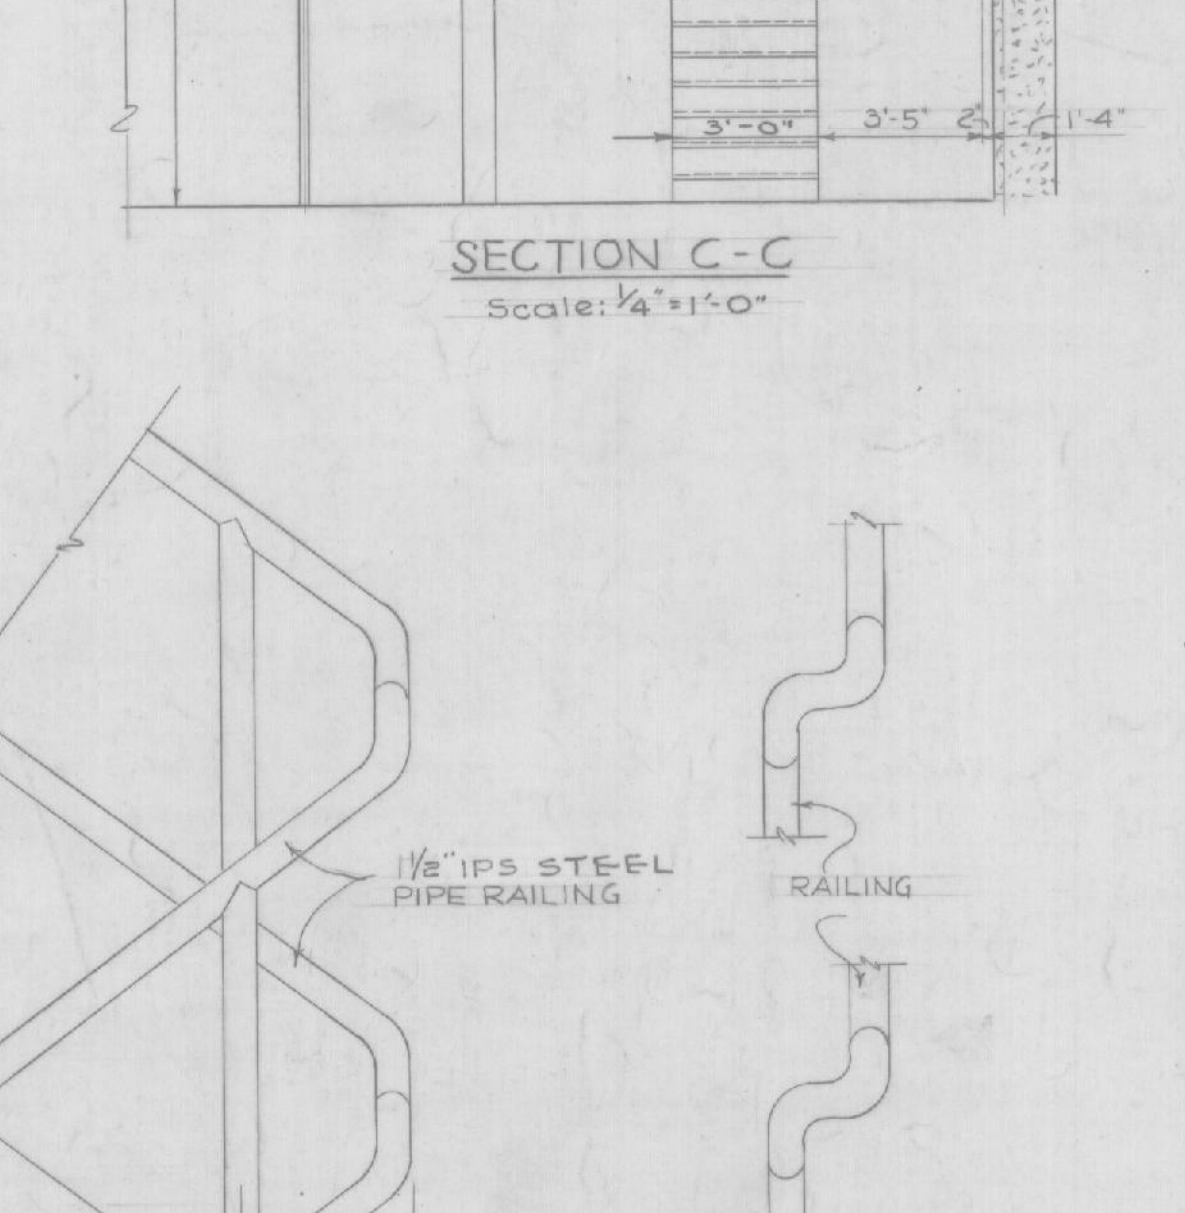
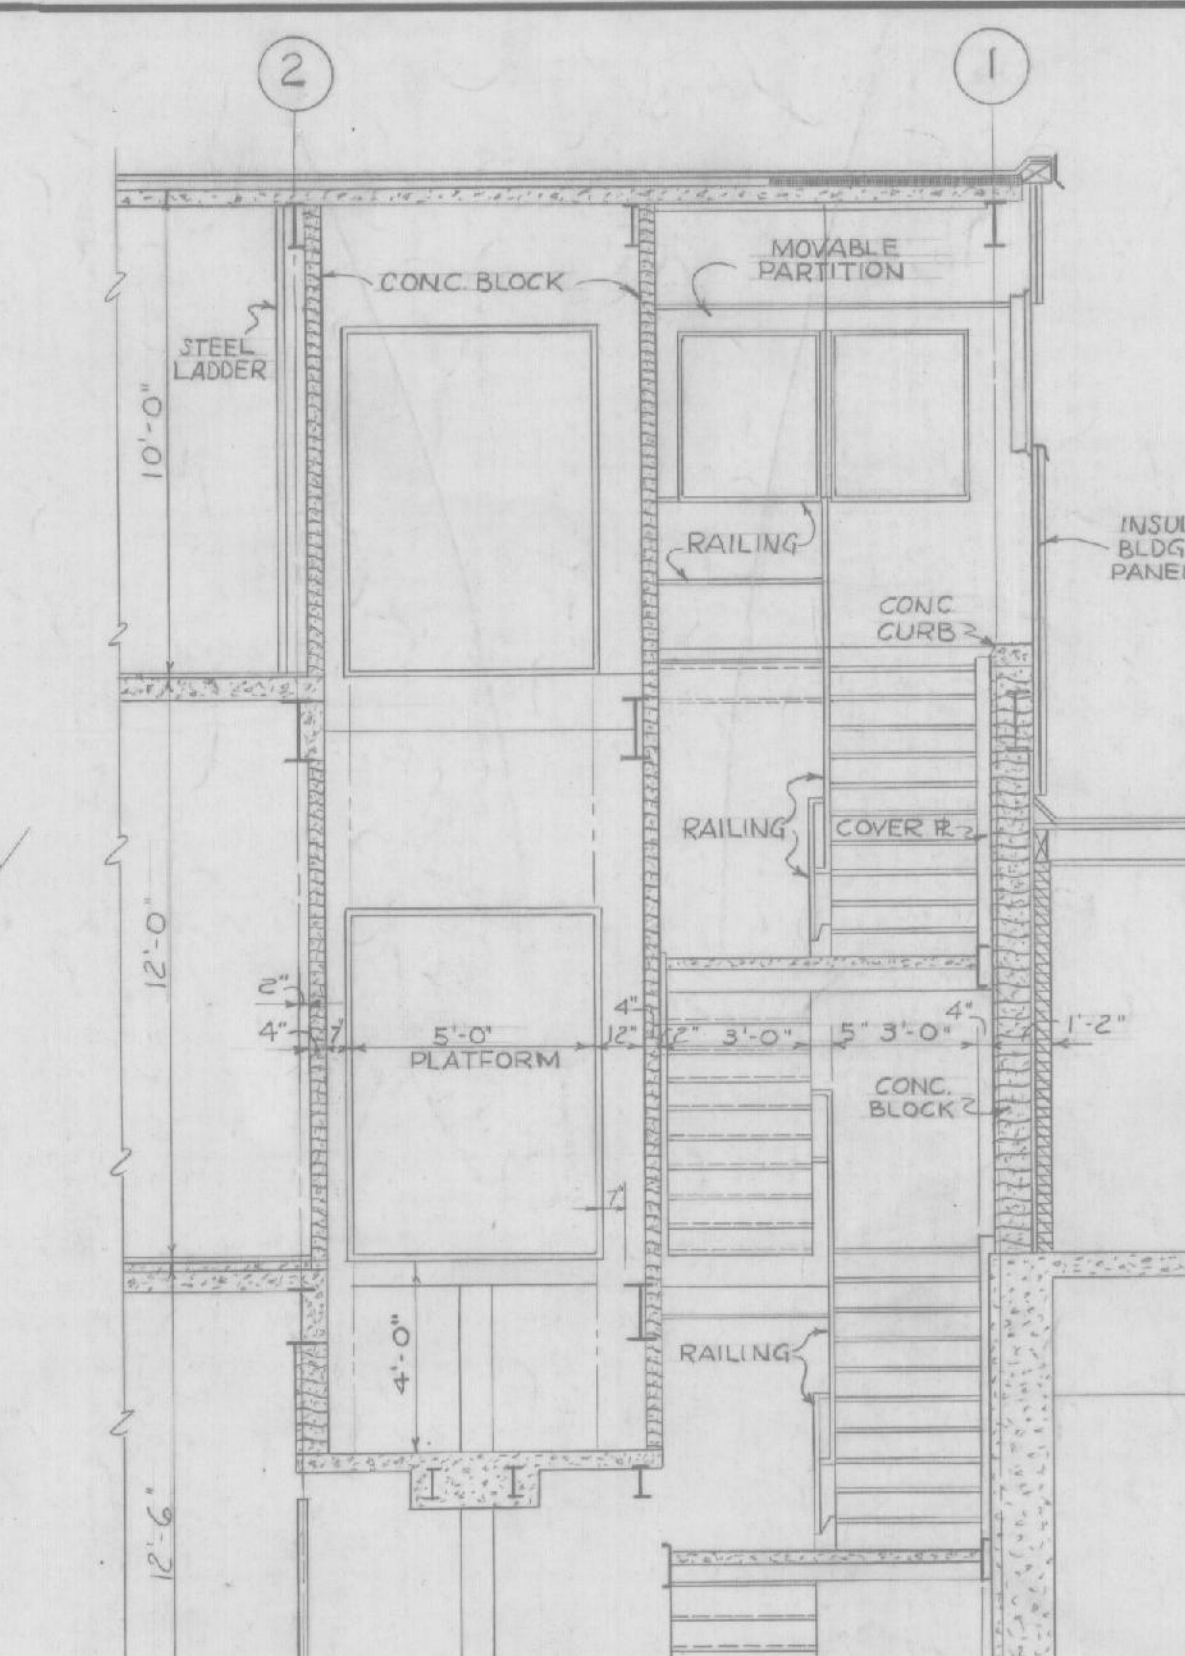
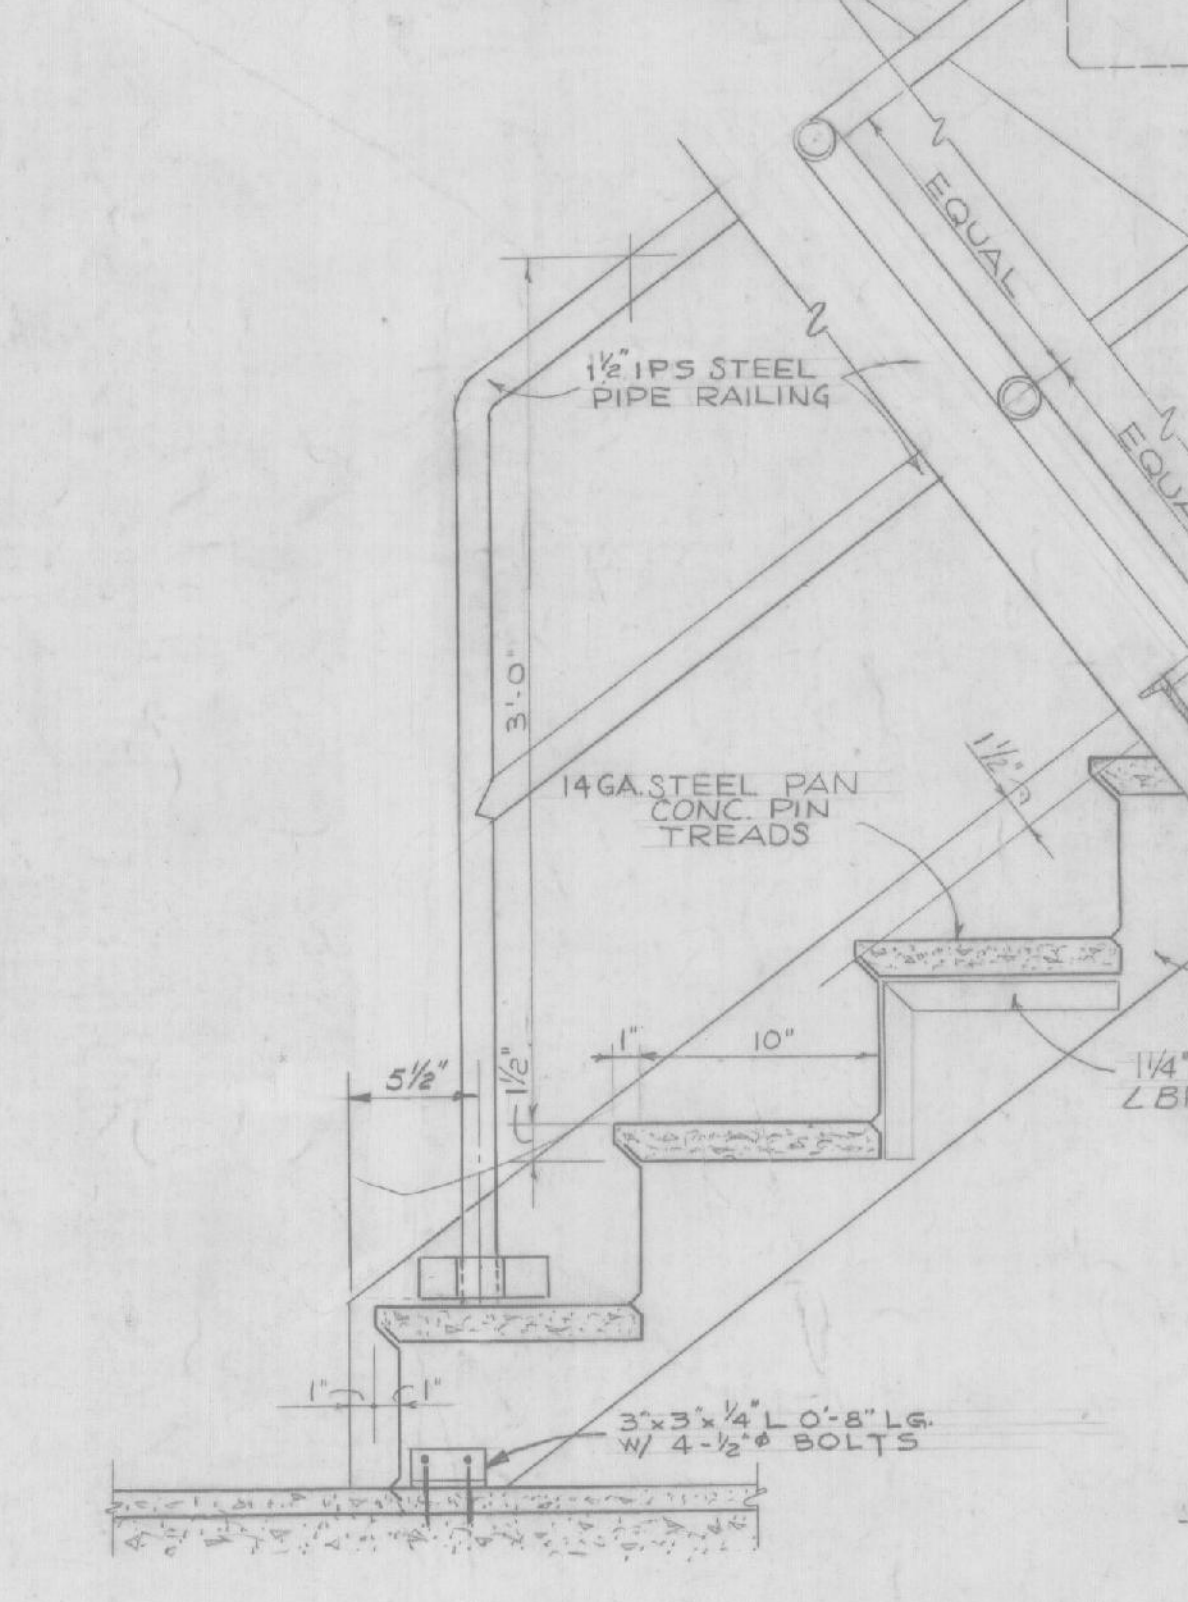
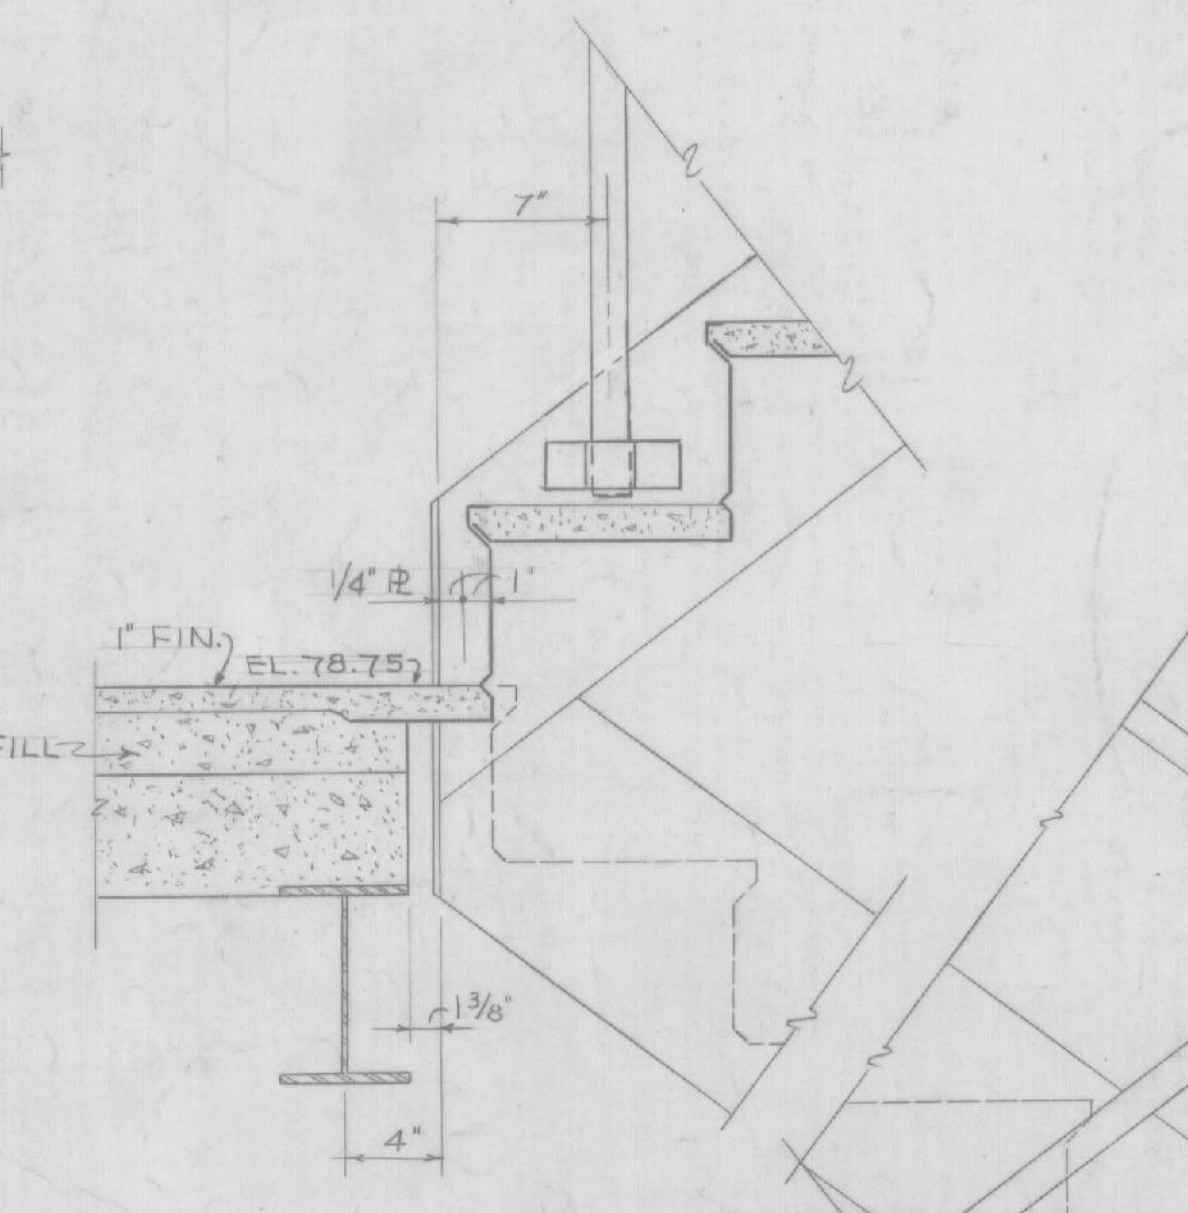
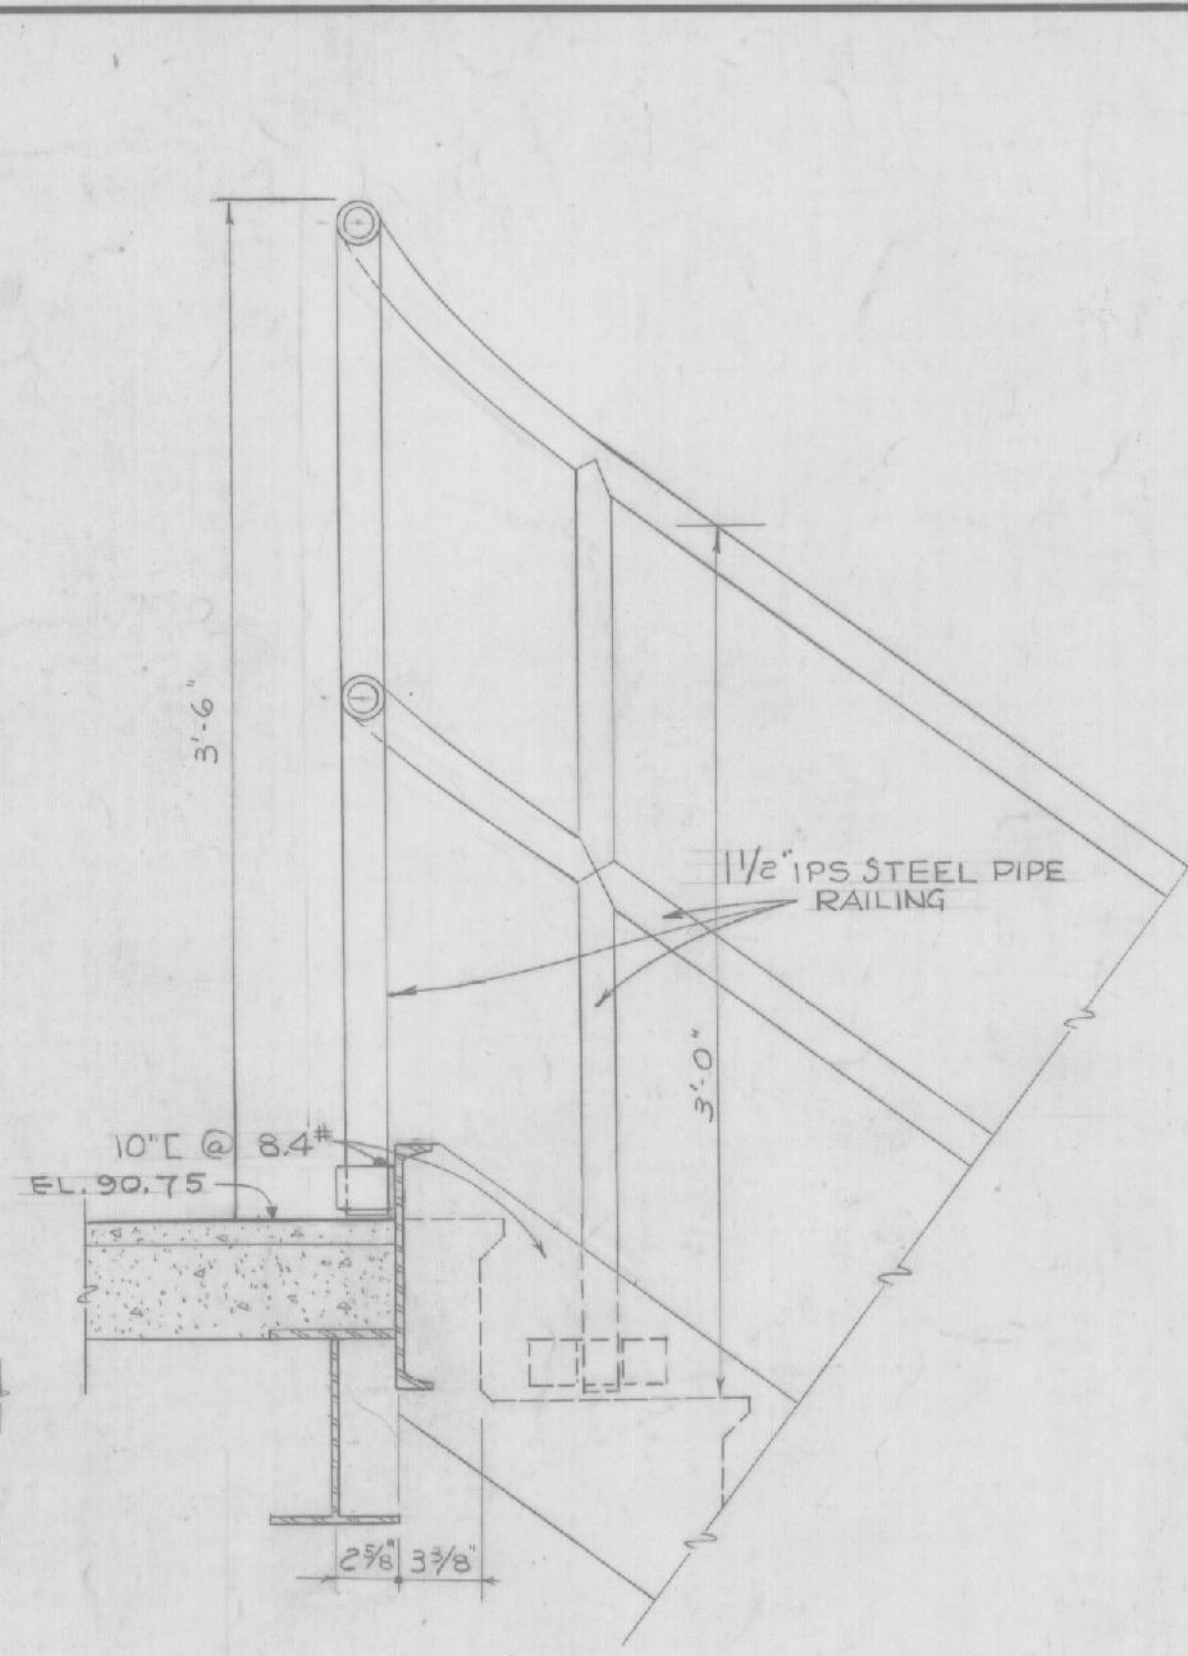
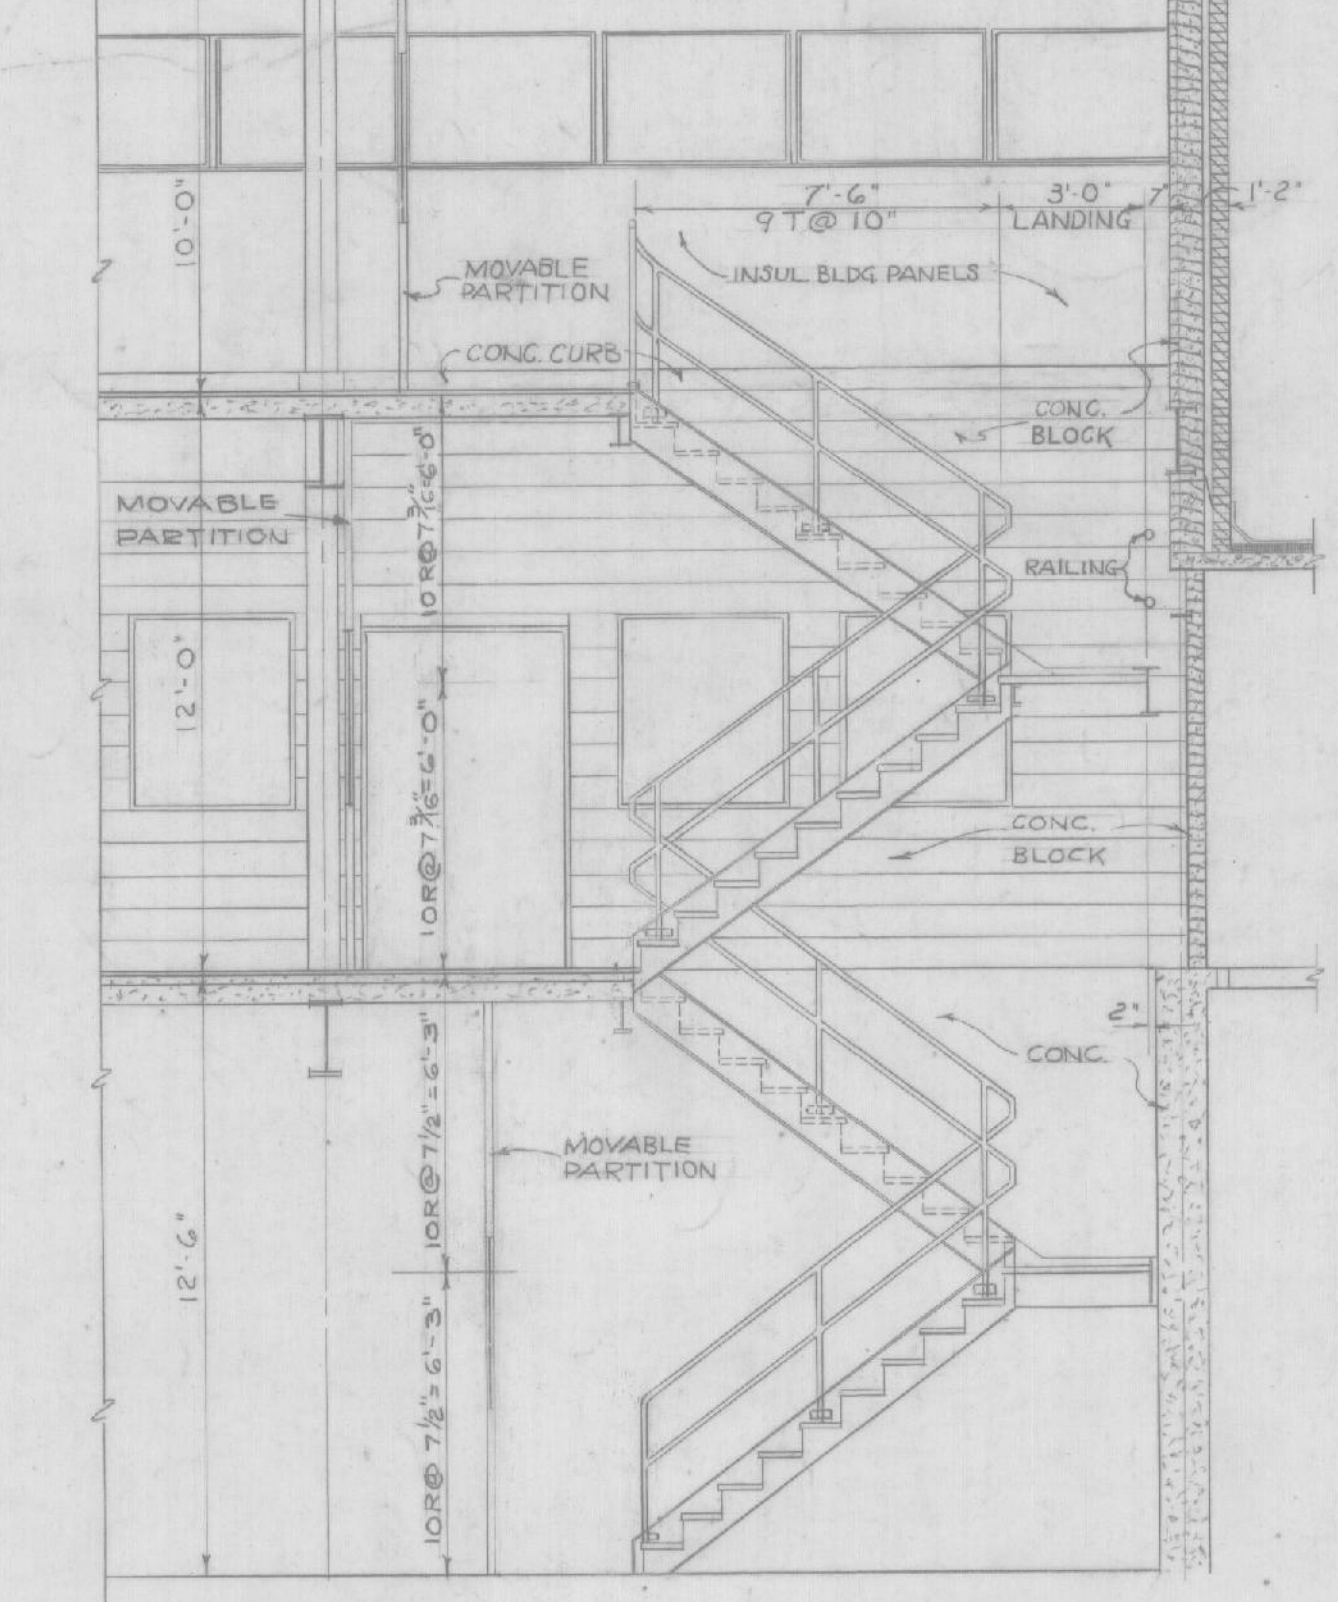
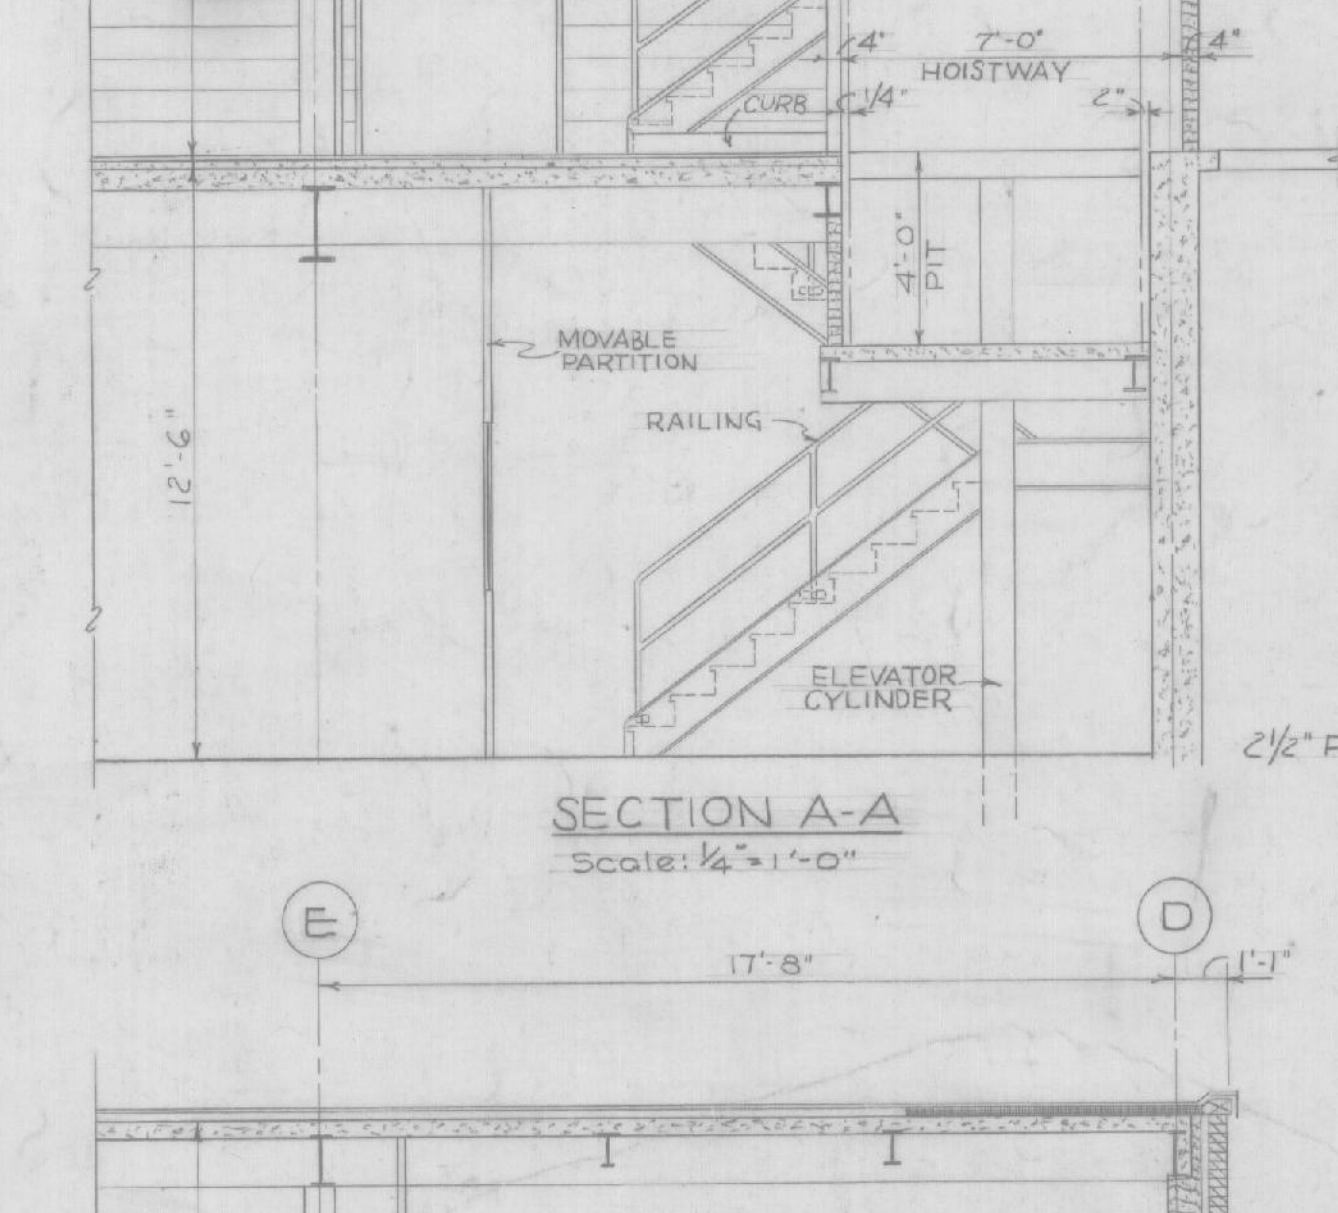
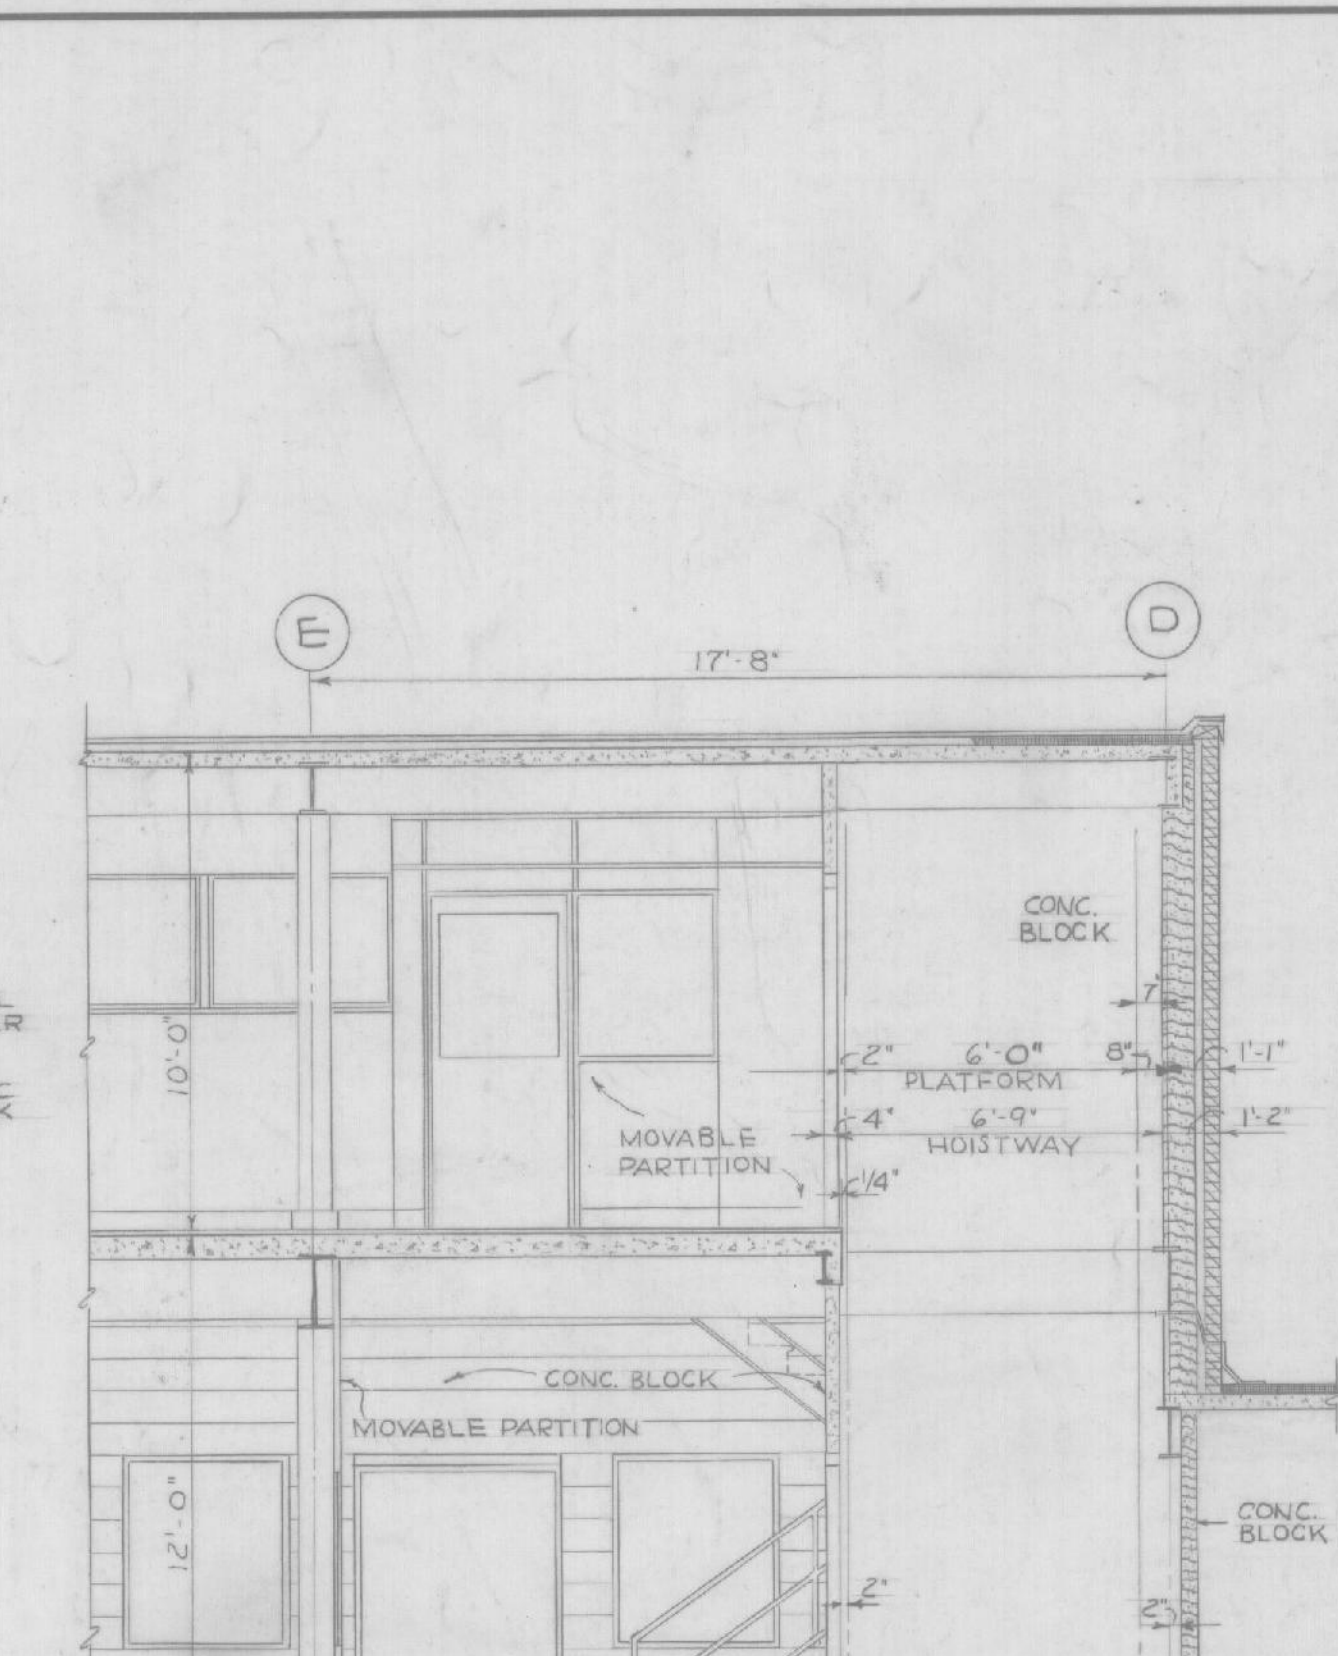
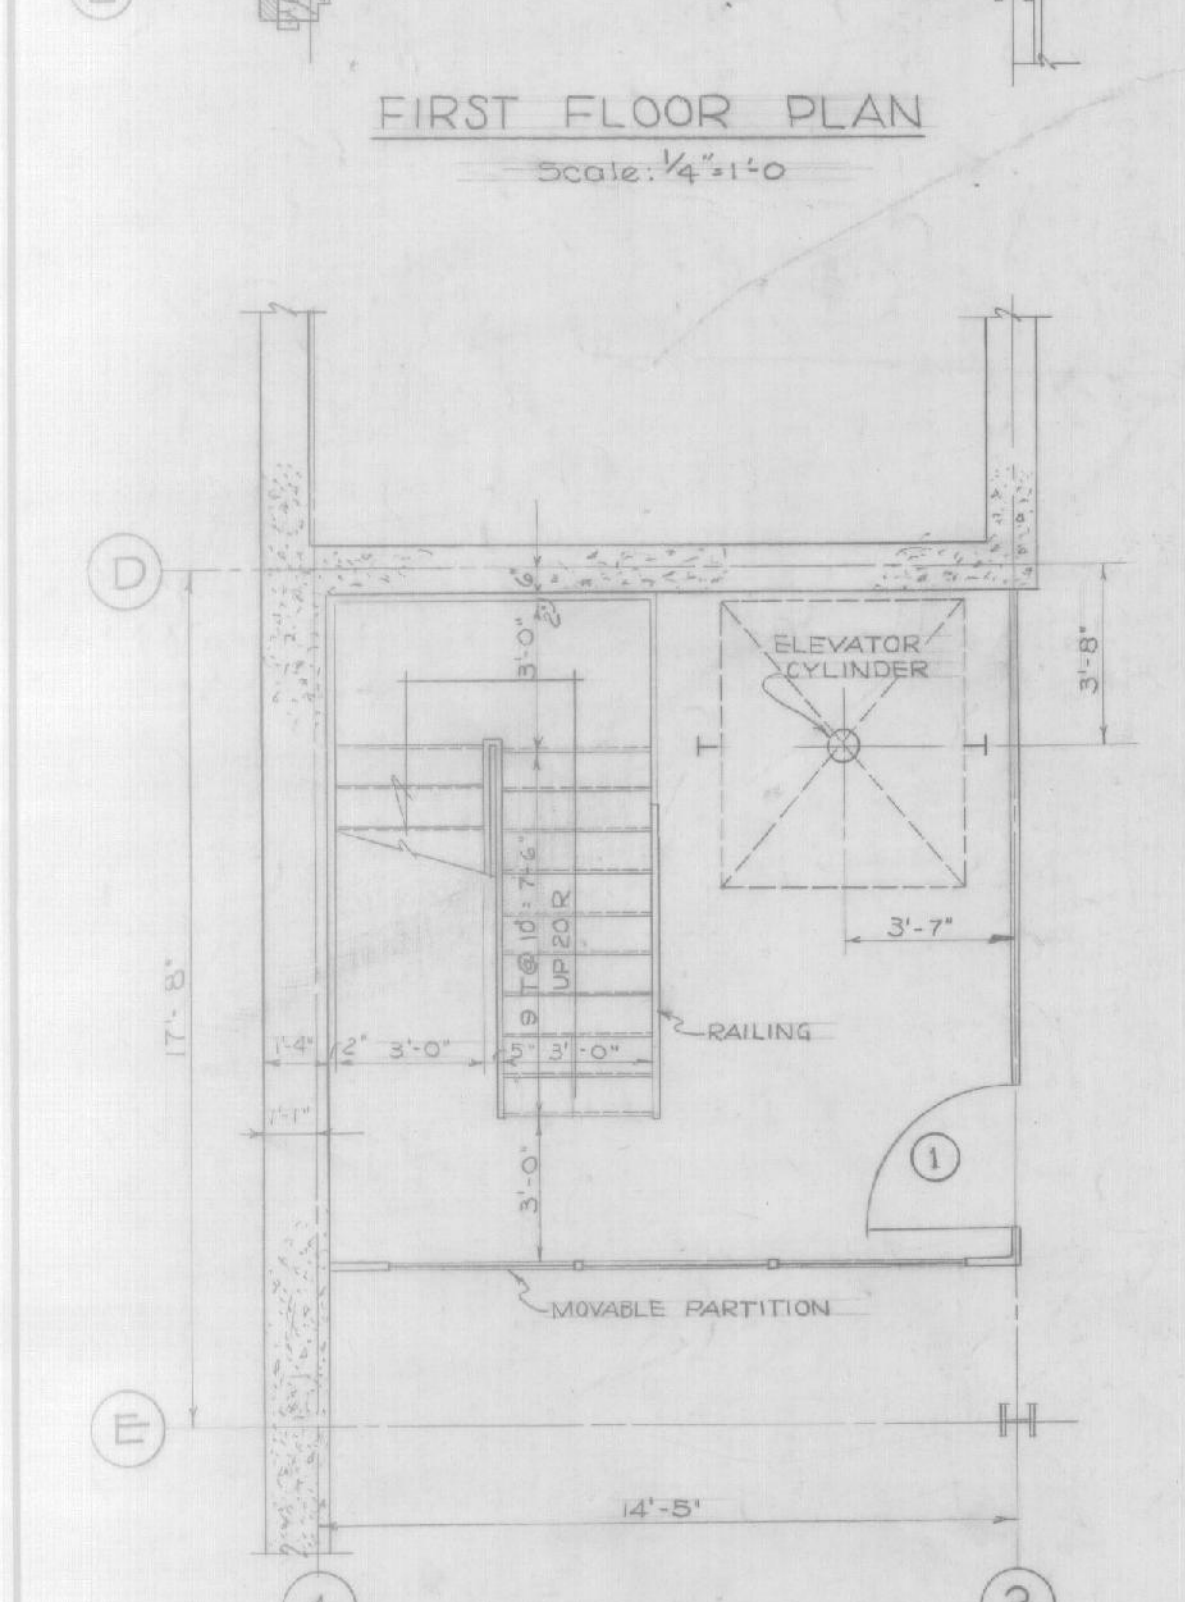
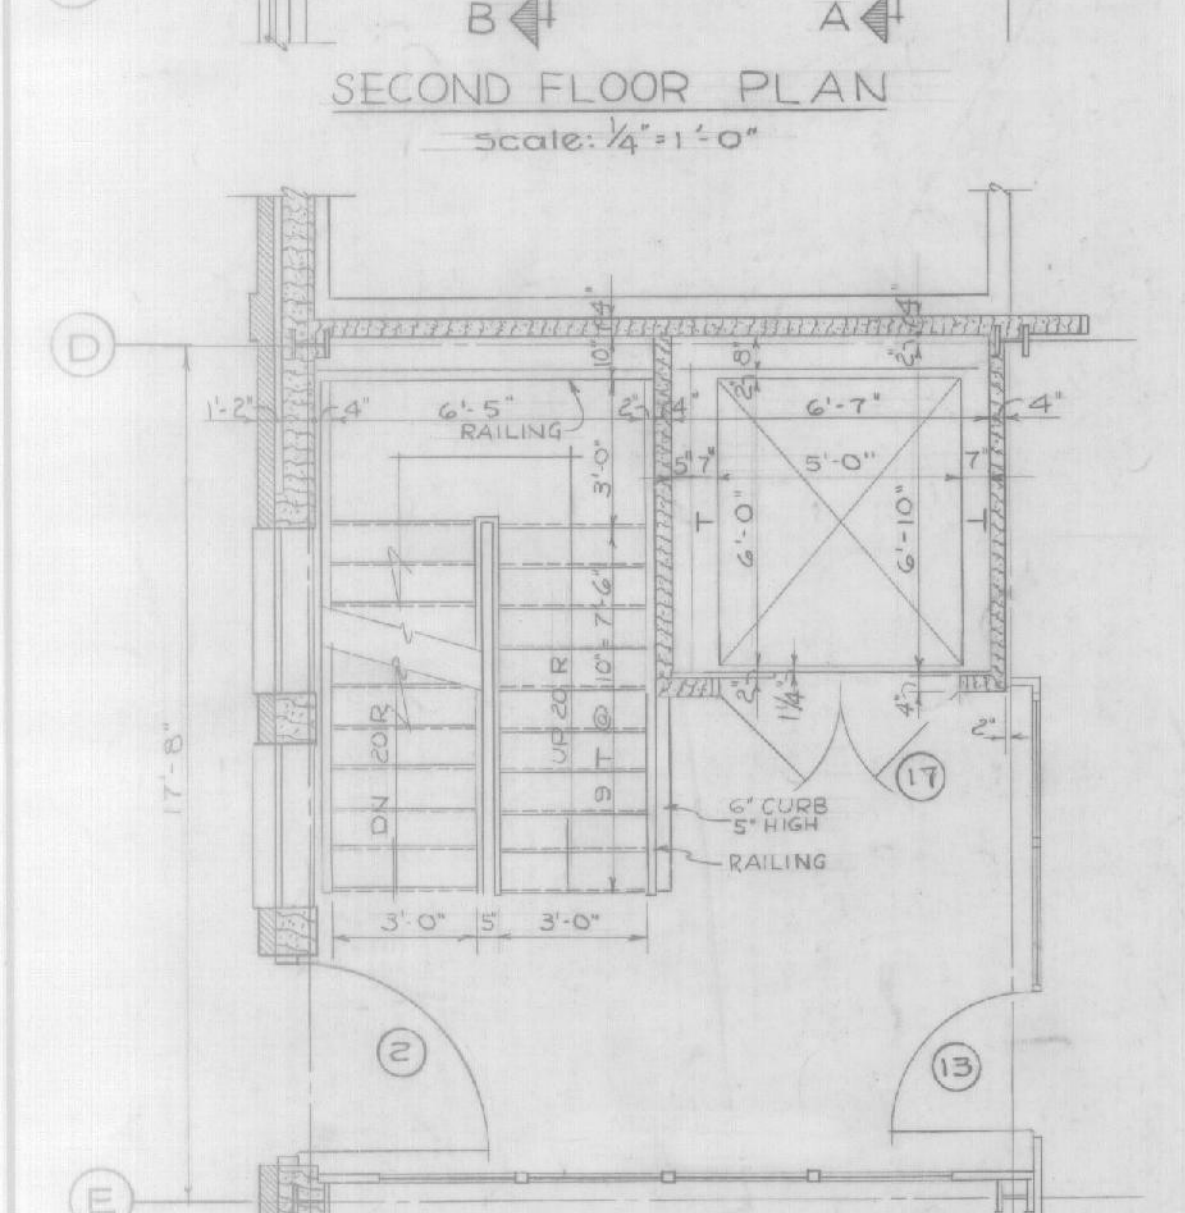
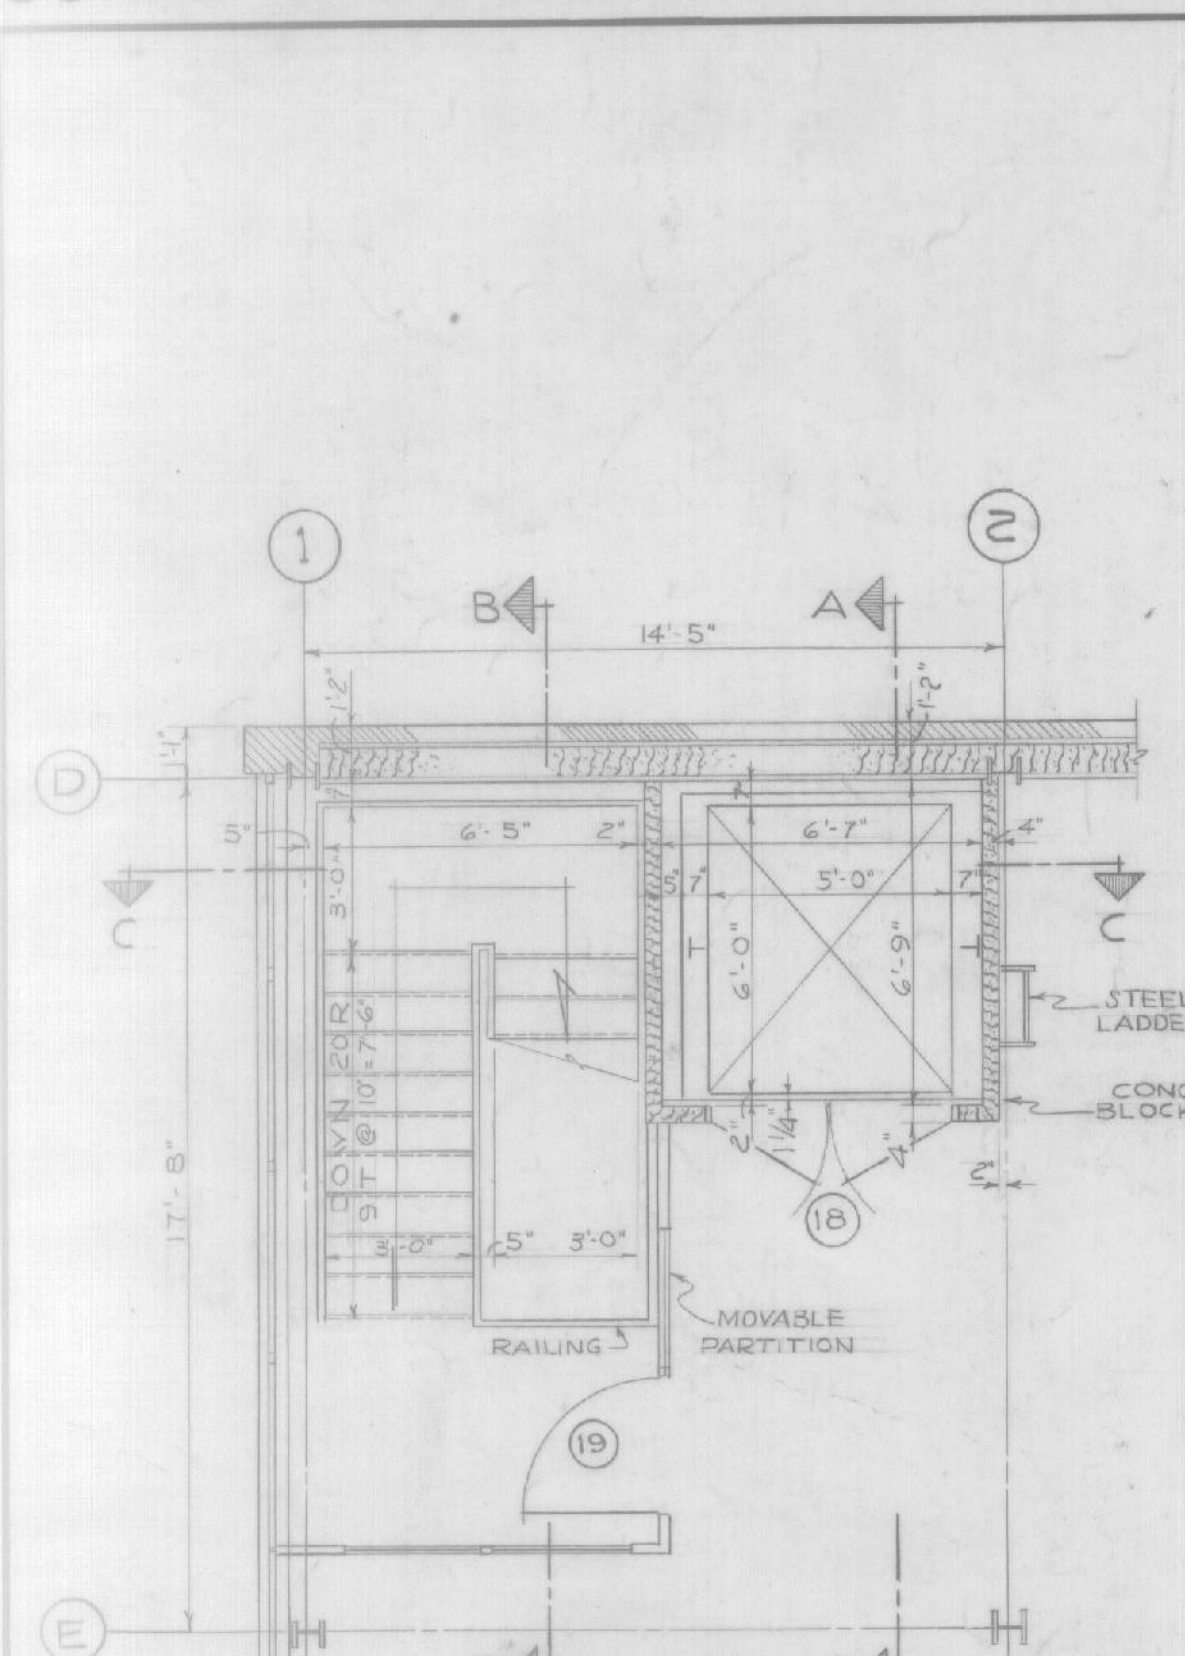


10-4-61 FINAL FIELD CORRECTIONS.			
REVISION	DATE	DESCRIPTION	BY
WHITMAN & HOWARD, INC. ENGINEERS 89 BROAD ST., BOSTON, MASS.		CORPS OF ENGINEERS, U. S. ARMY OFFICE OF THE DIVISION ENGINEER NEW ENGLAND DIVISION WALTHAM, MASS.	
PEASE AIR FORCE BASE			
PORTSMOUTH, NEW HAMPSHIRE			
SURFACE WATER SUPPLY			
FILTER BUILDING			
ARCHITECTURAL			
STAIRS & ELEVATOR DETAILS			
DRAWN BY:	RAR.		
TRACED BY:	RAR.		
CHECKED BY:	C.G.M.		
SUBMITTED:	<i>[Signature]</i>		
APPROVED:	<i>[Signature]</i>	DATE	JUNE 1959
ENGINEERING DIVISION	COL. DEPUTY	DIVISION ENGINEER	
SCALE AS SHOWN	SPEC. NO. 016-59-152	DRAWING NUMBER	AW71-05-31
SHEET 9			

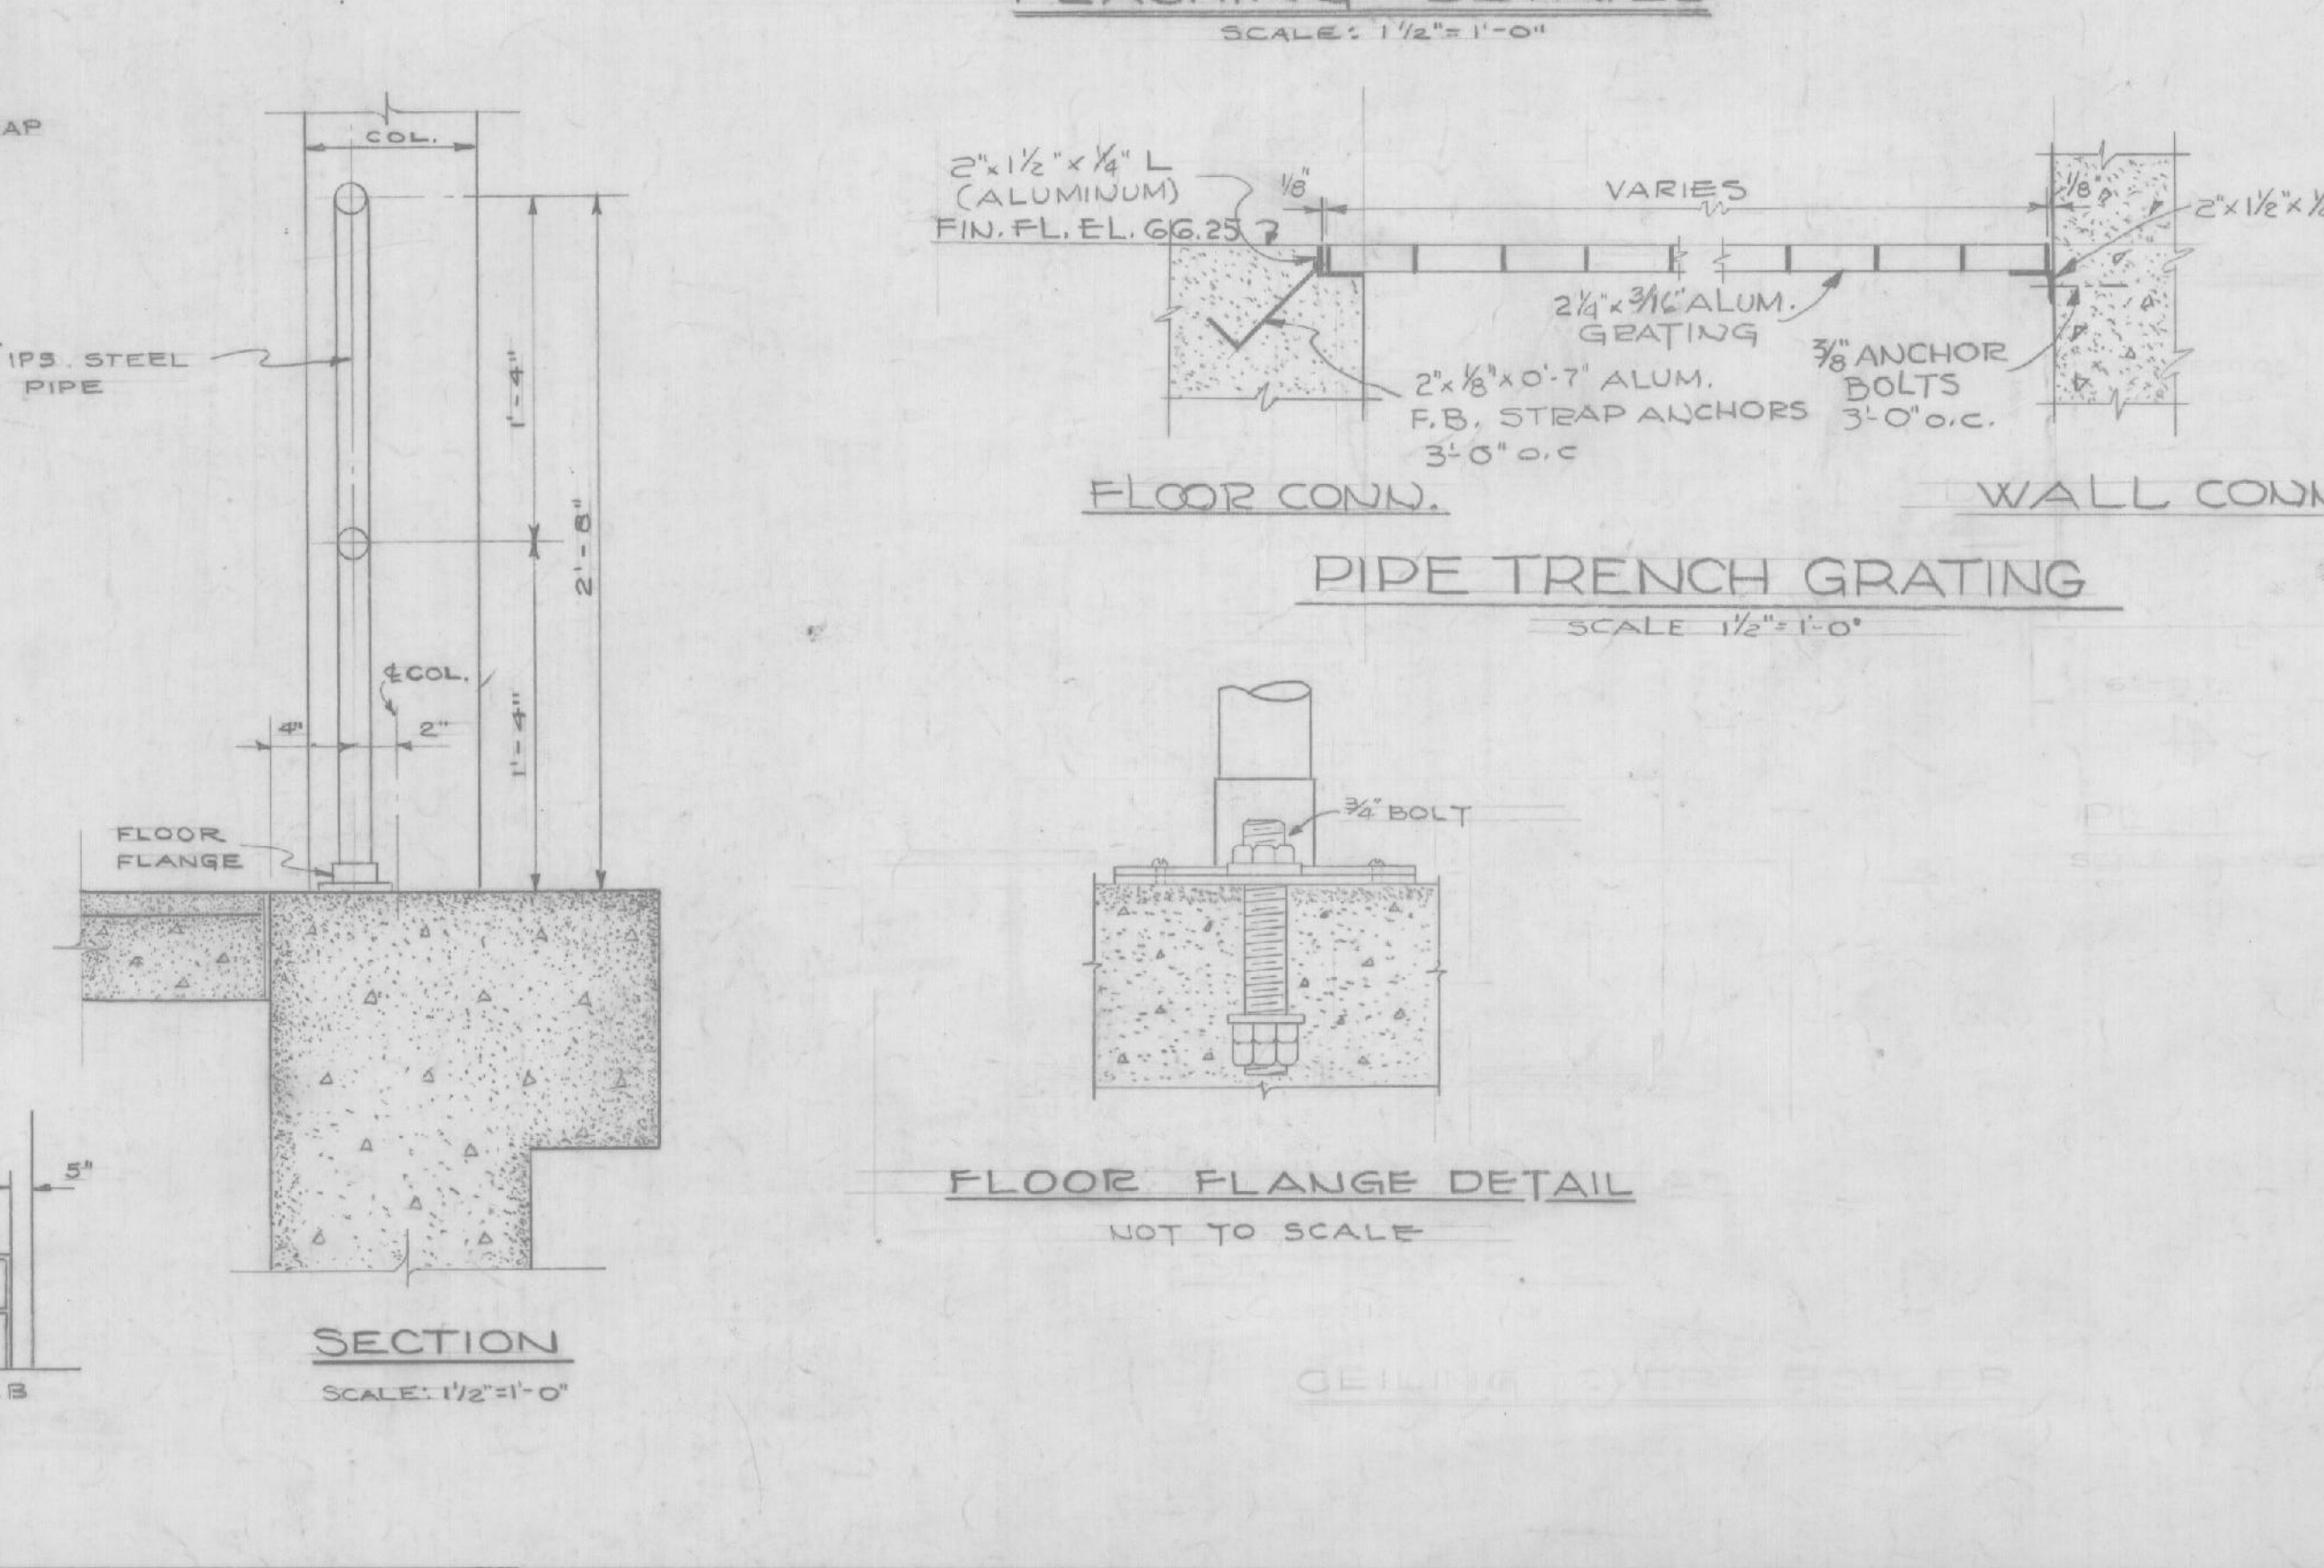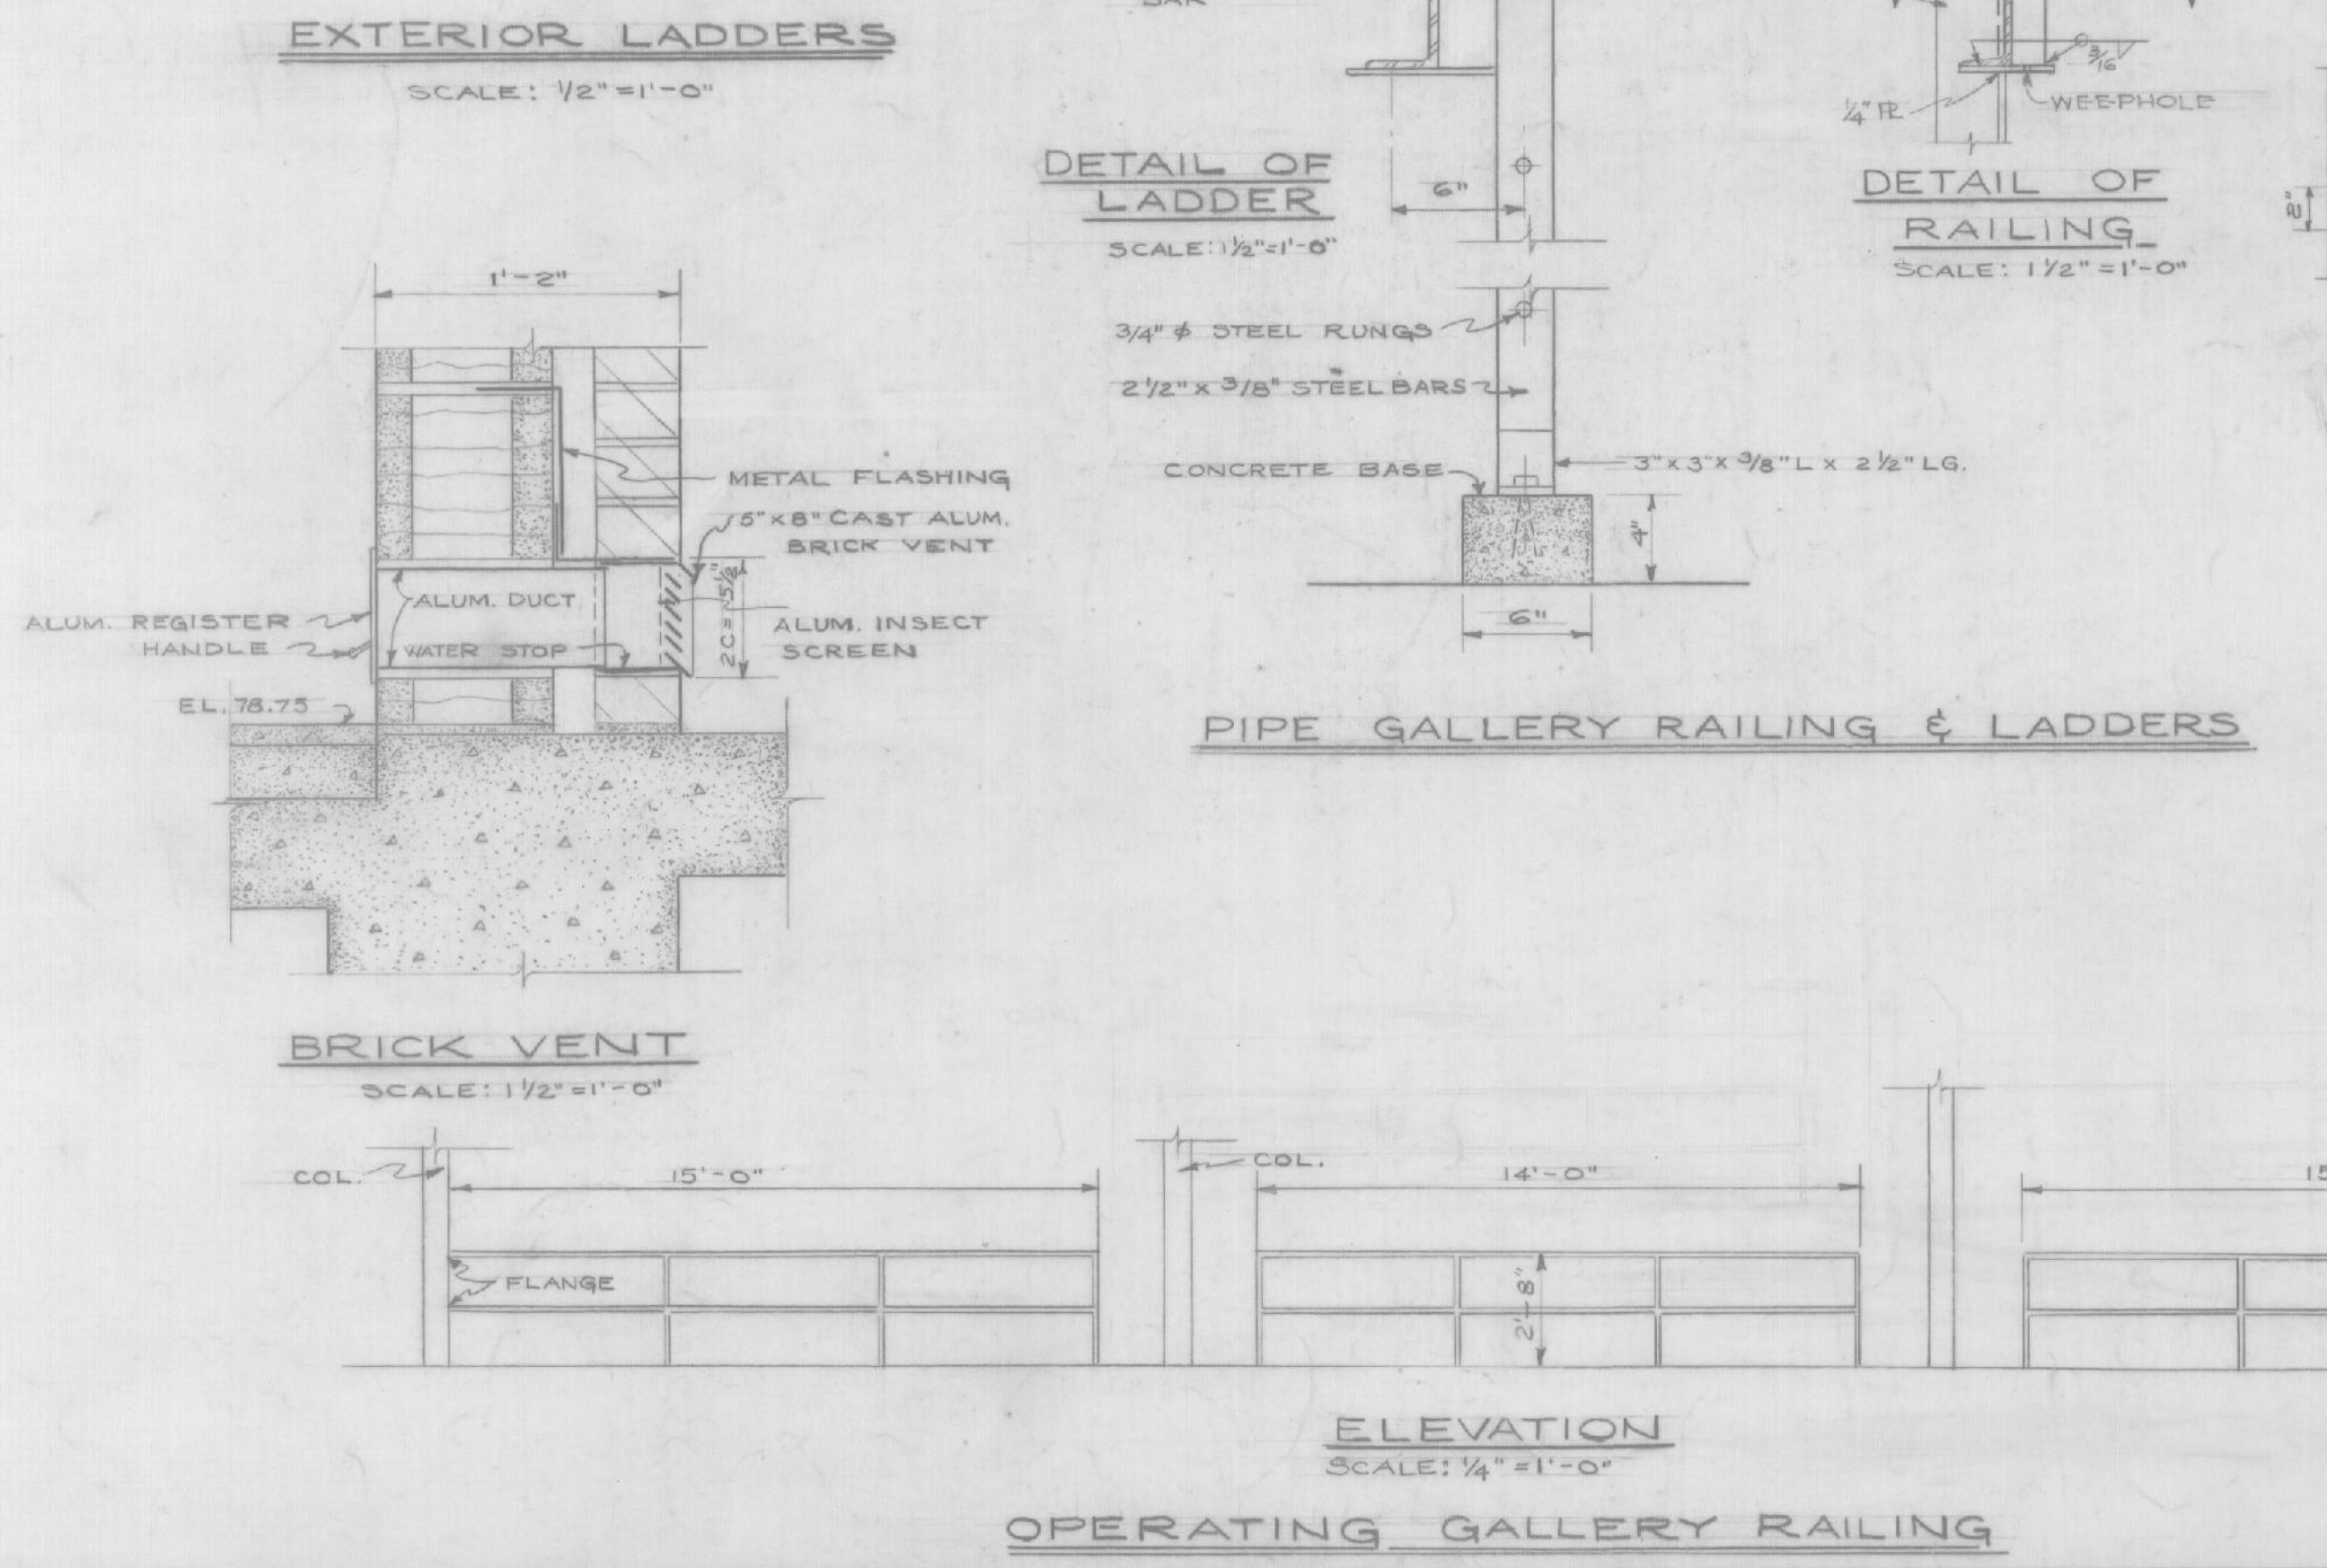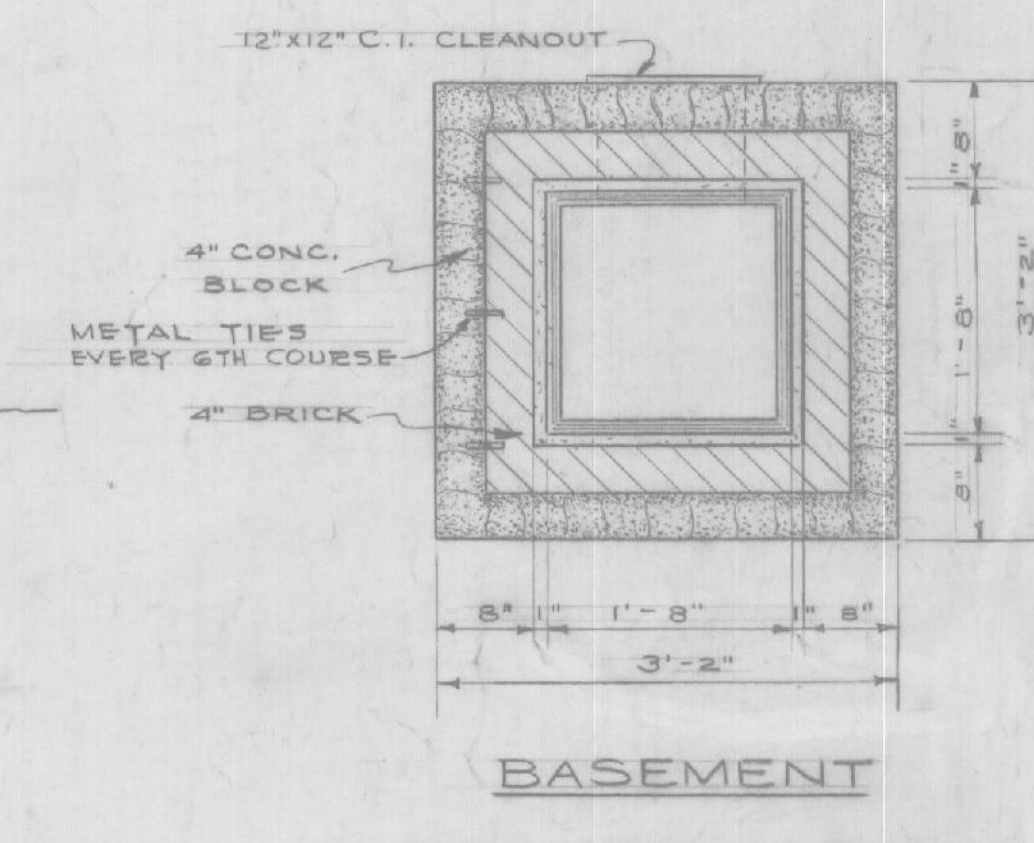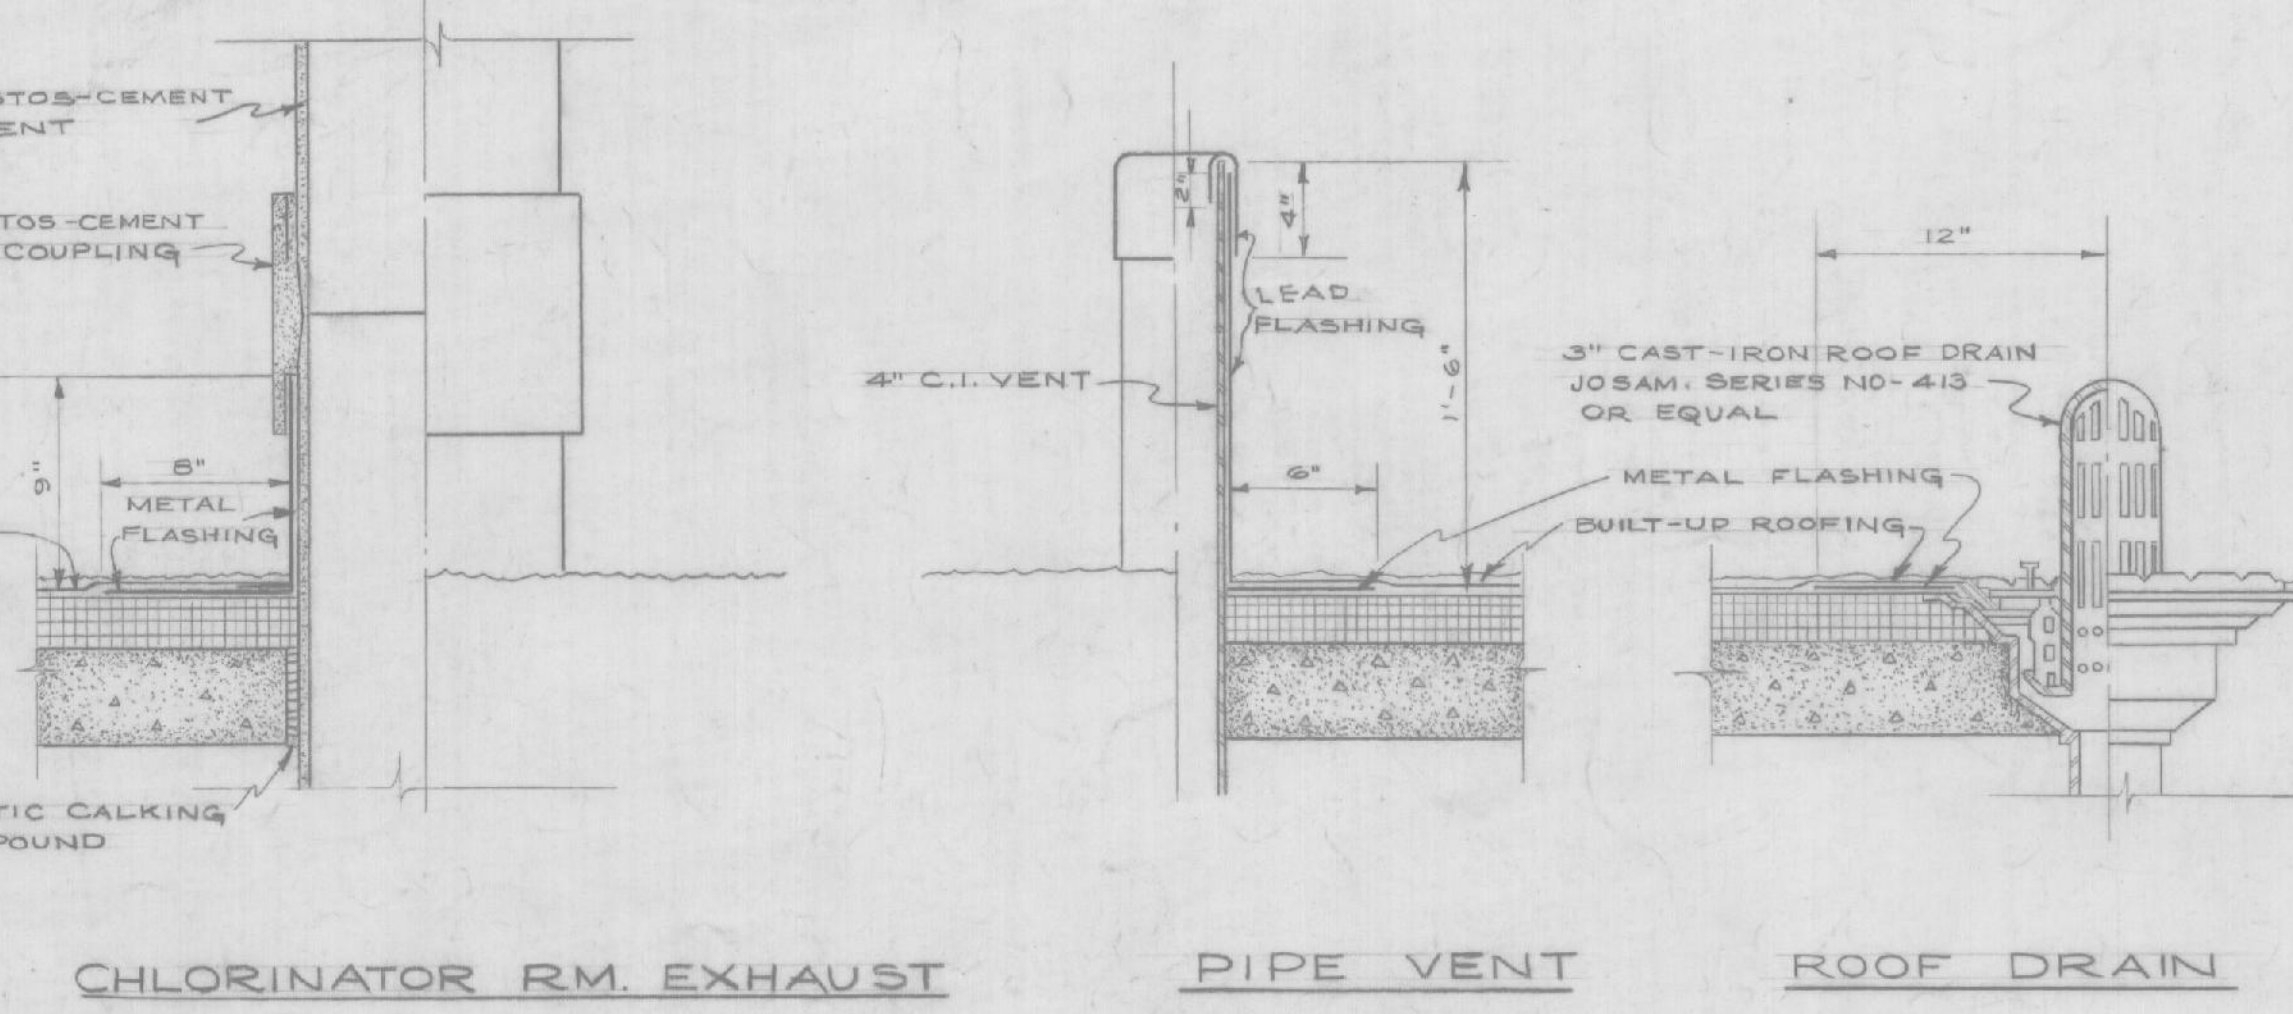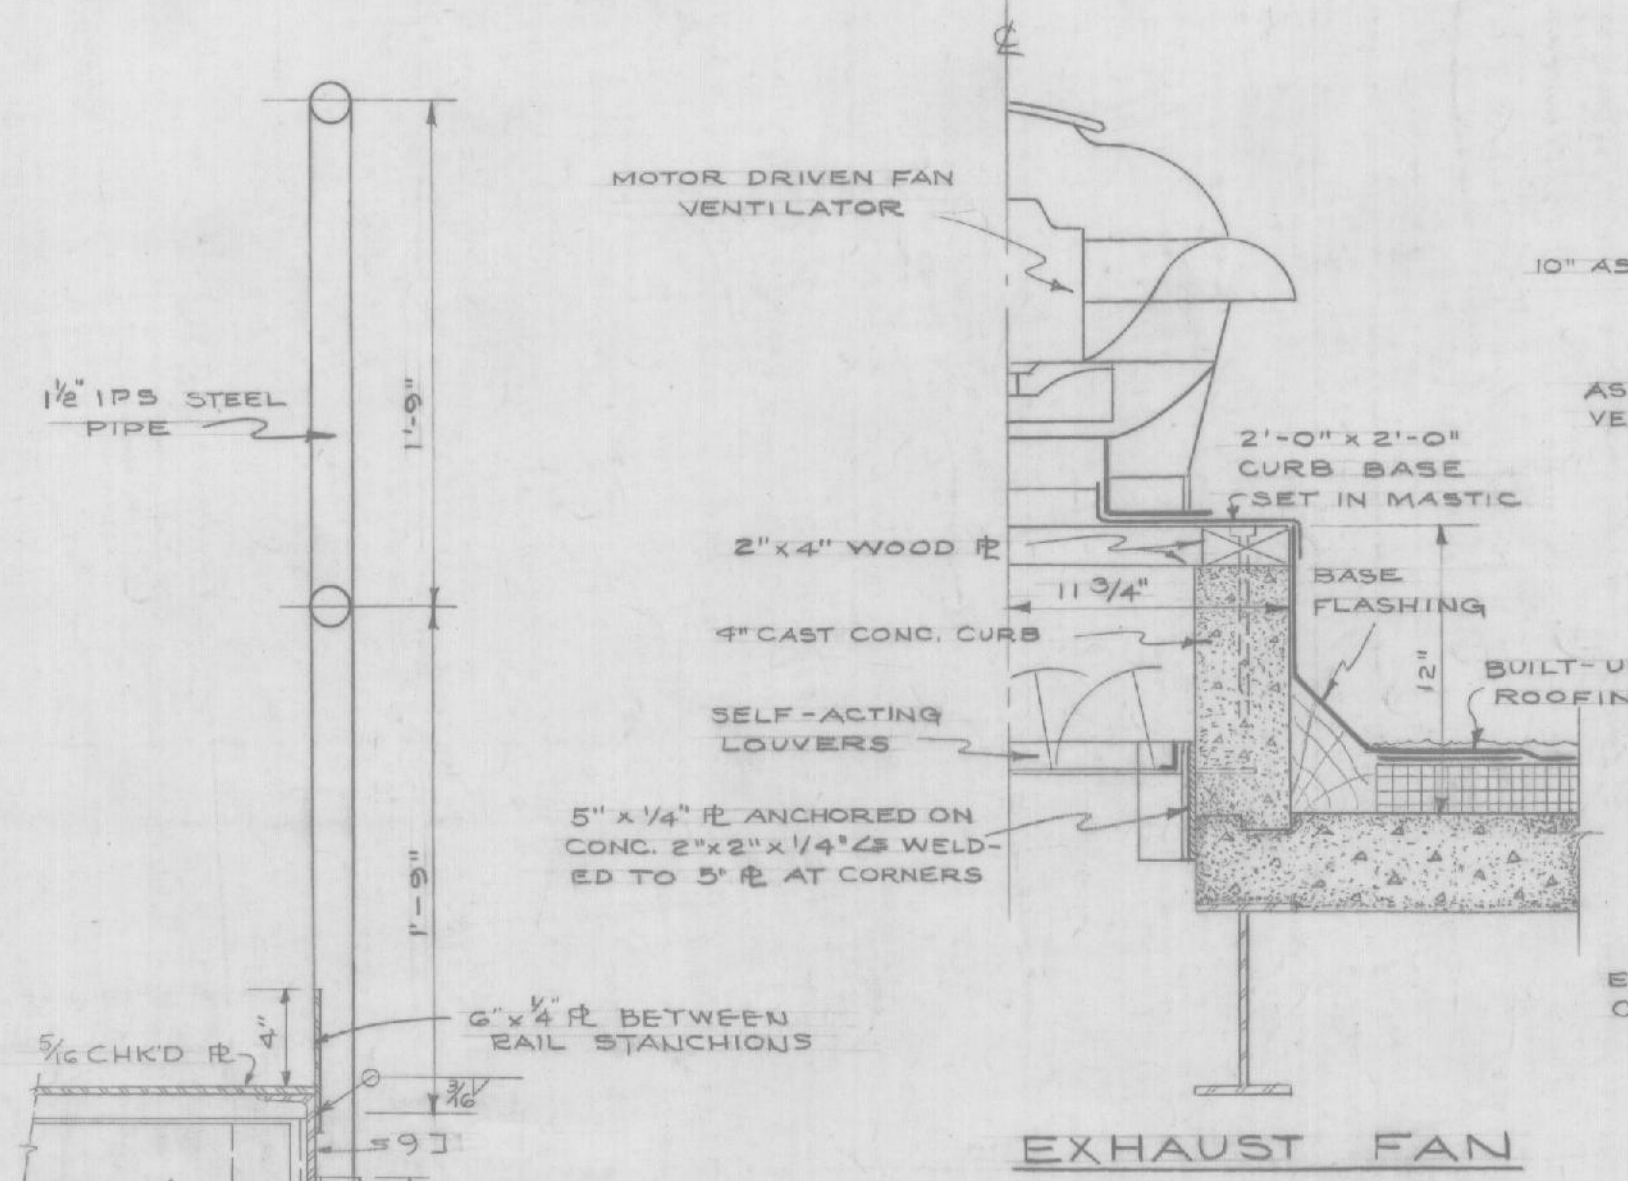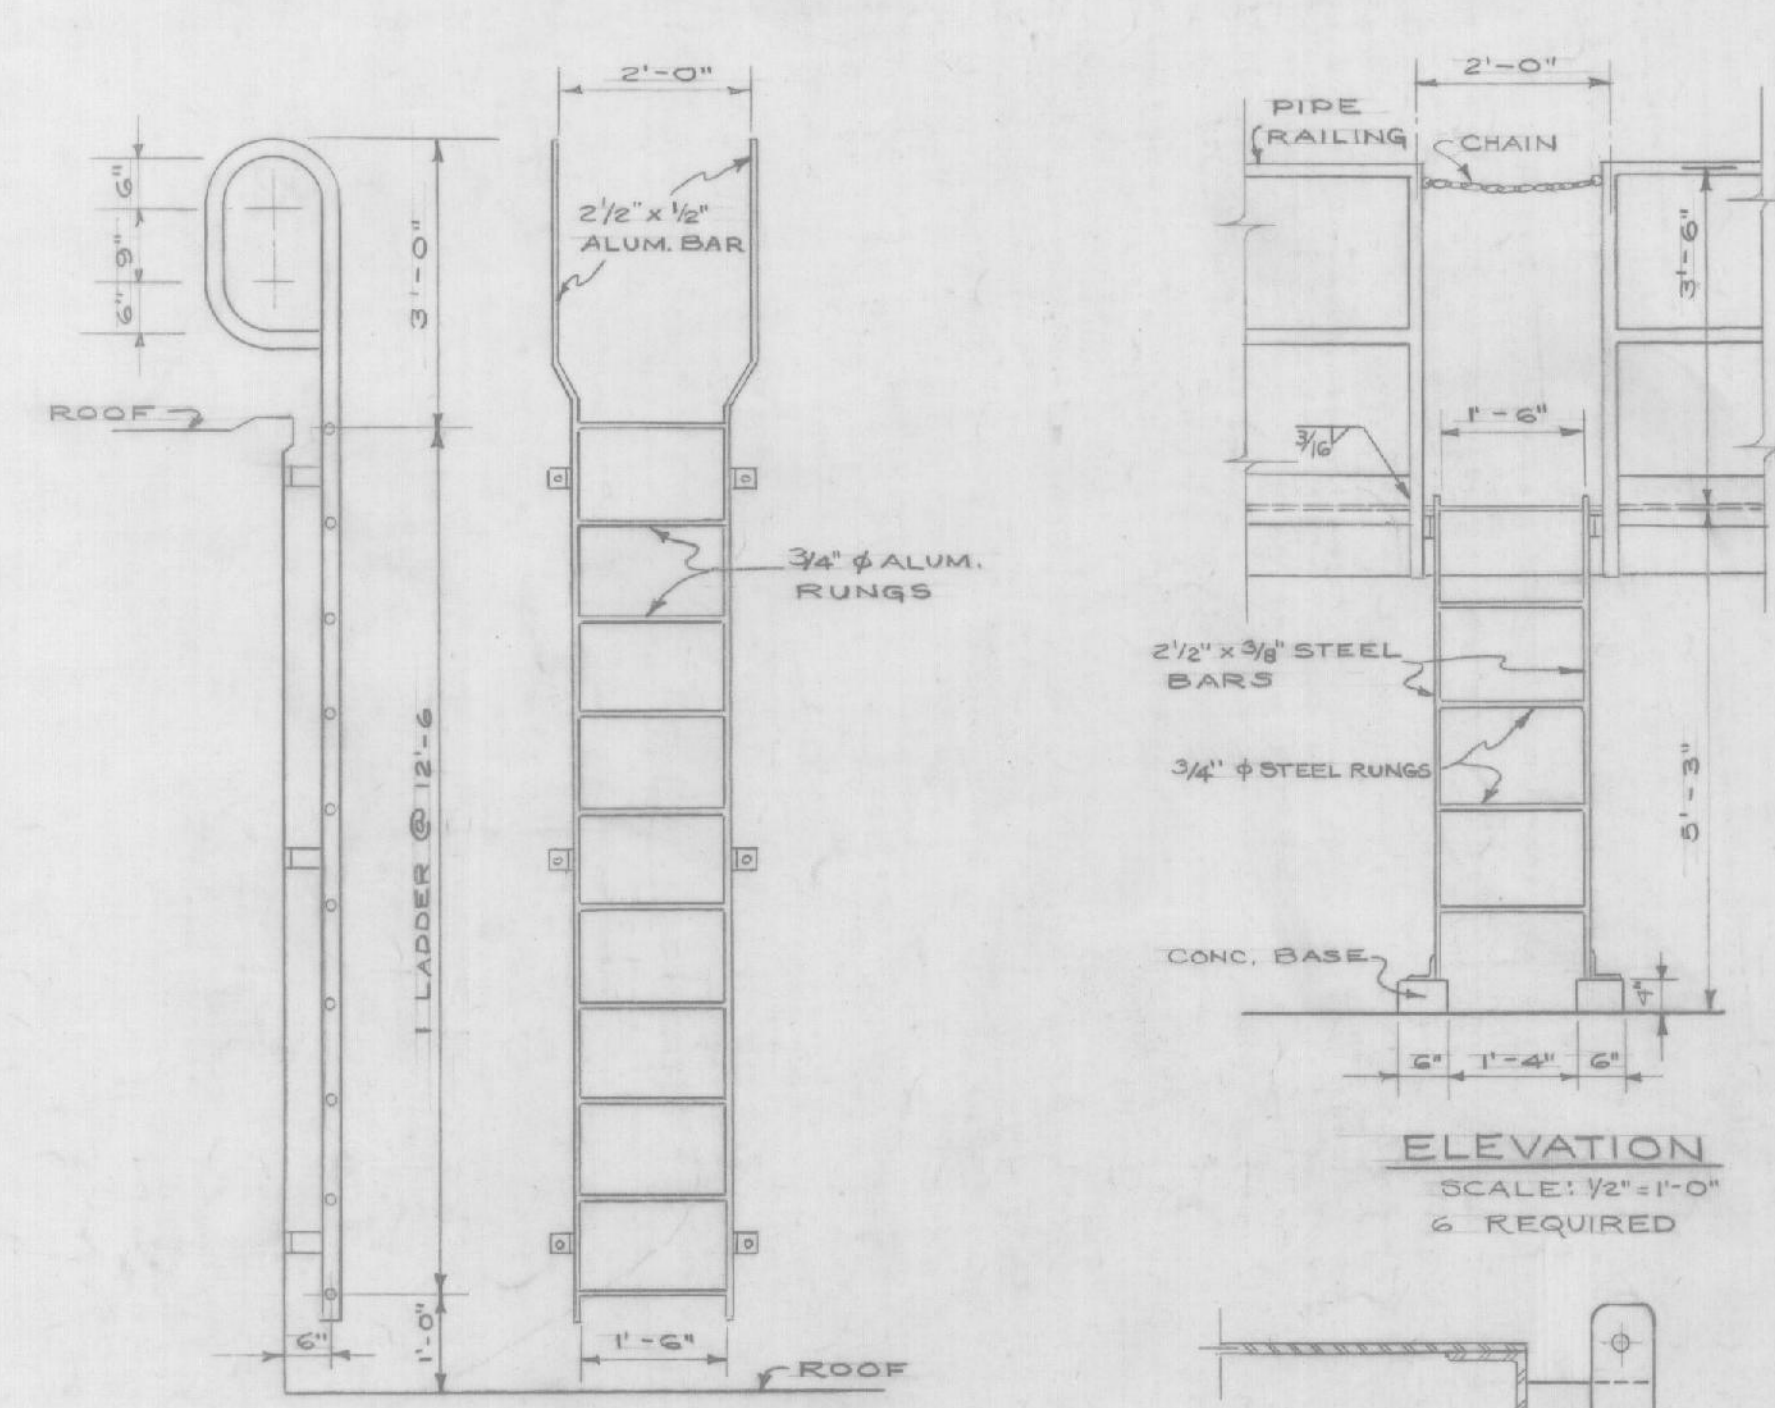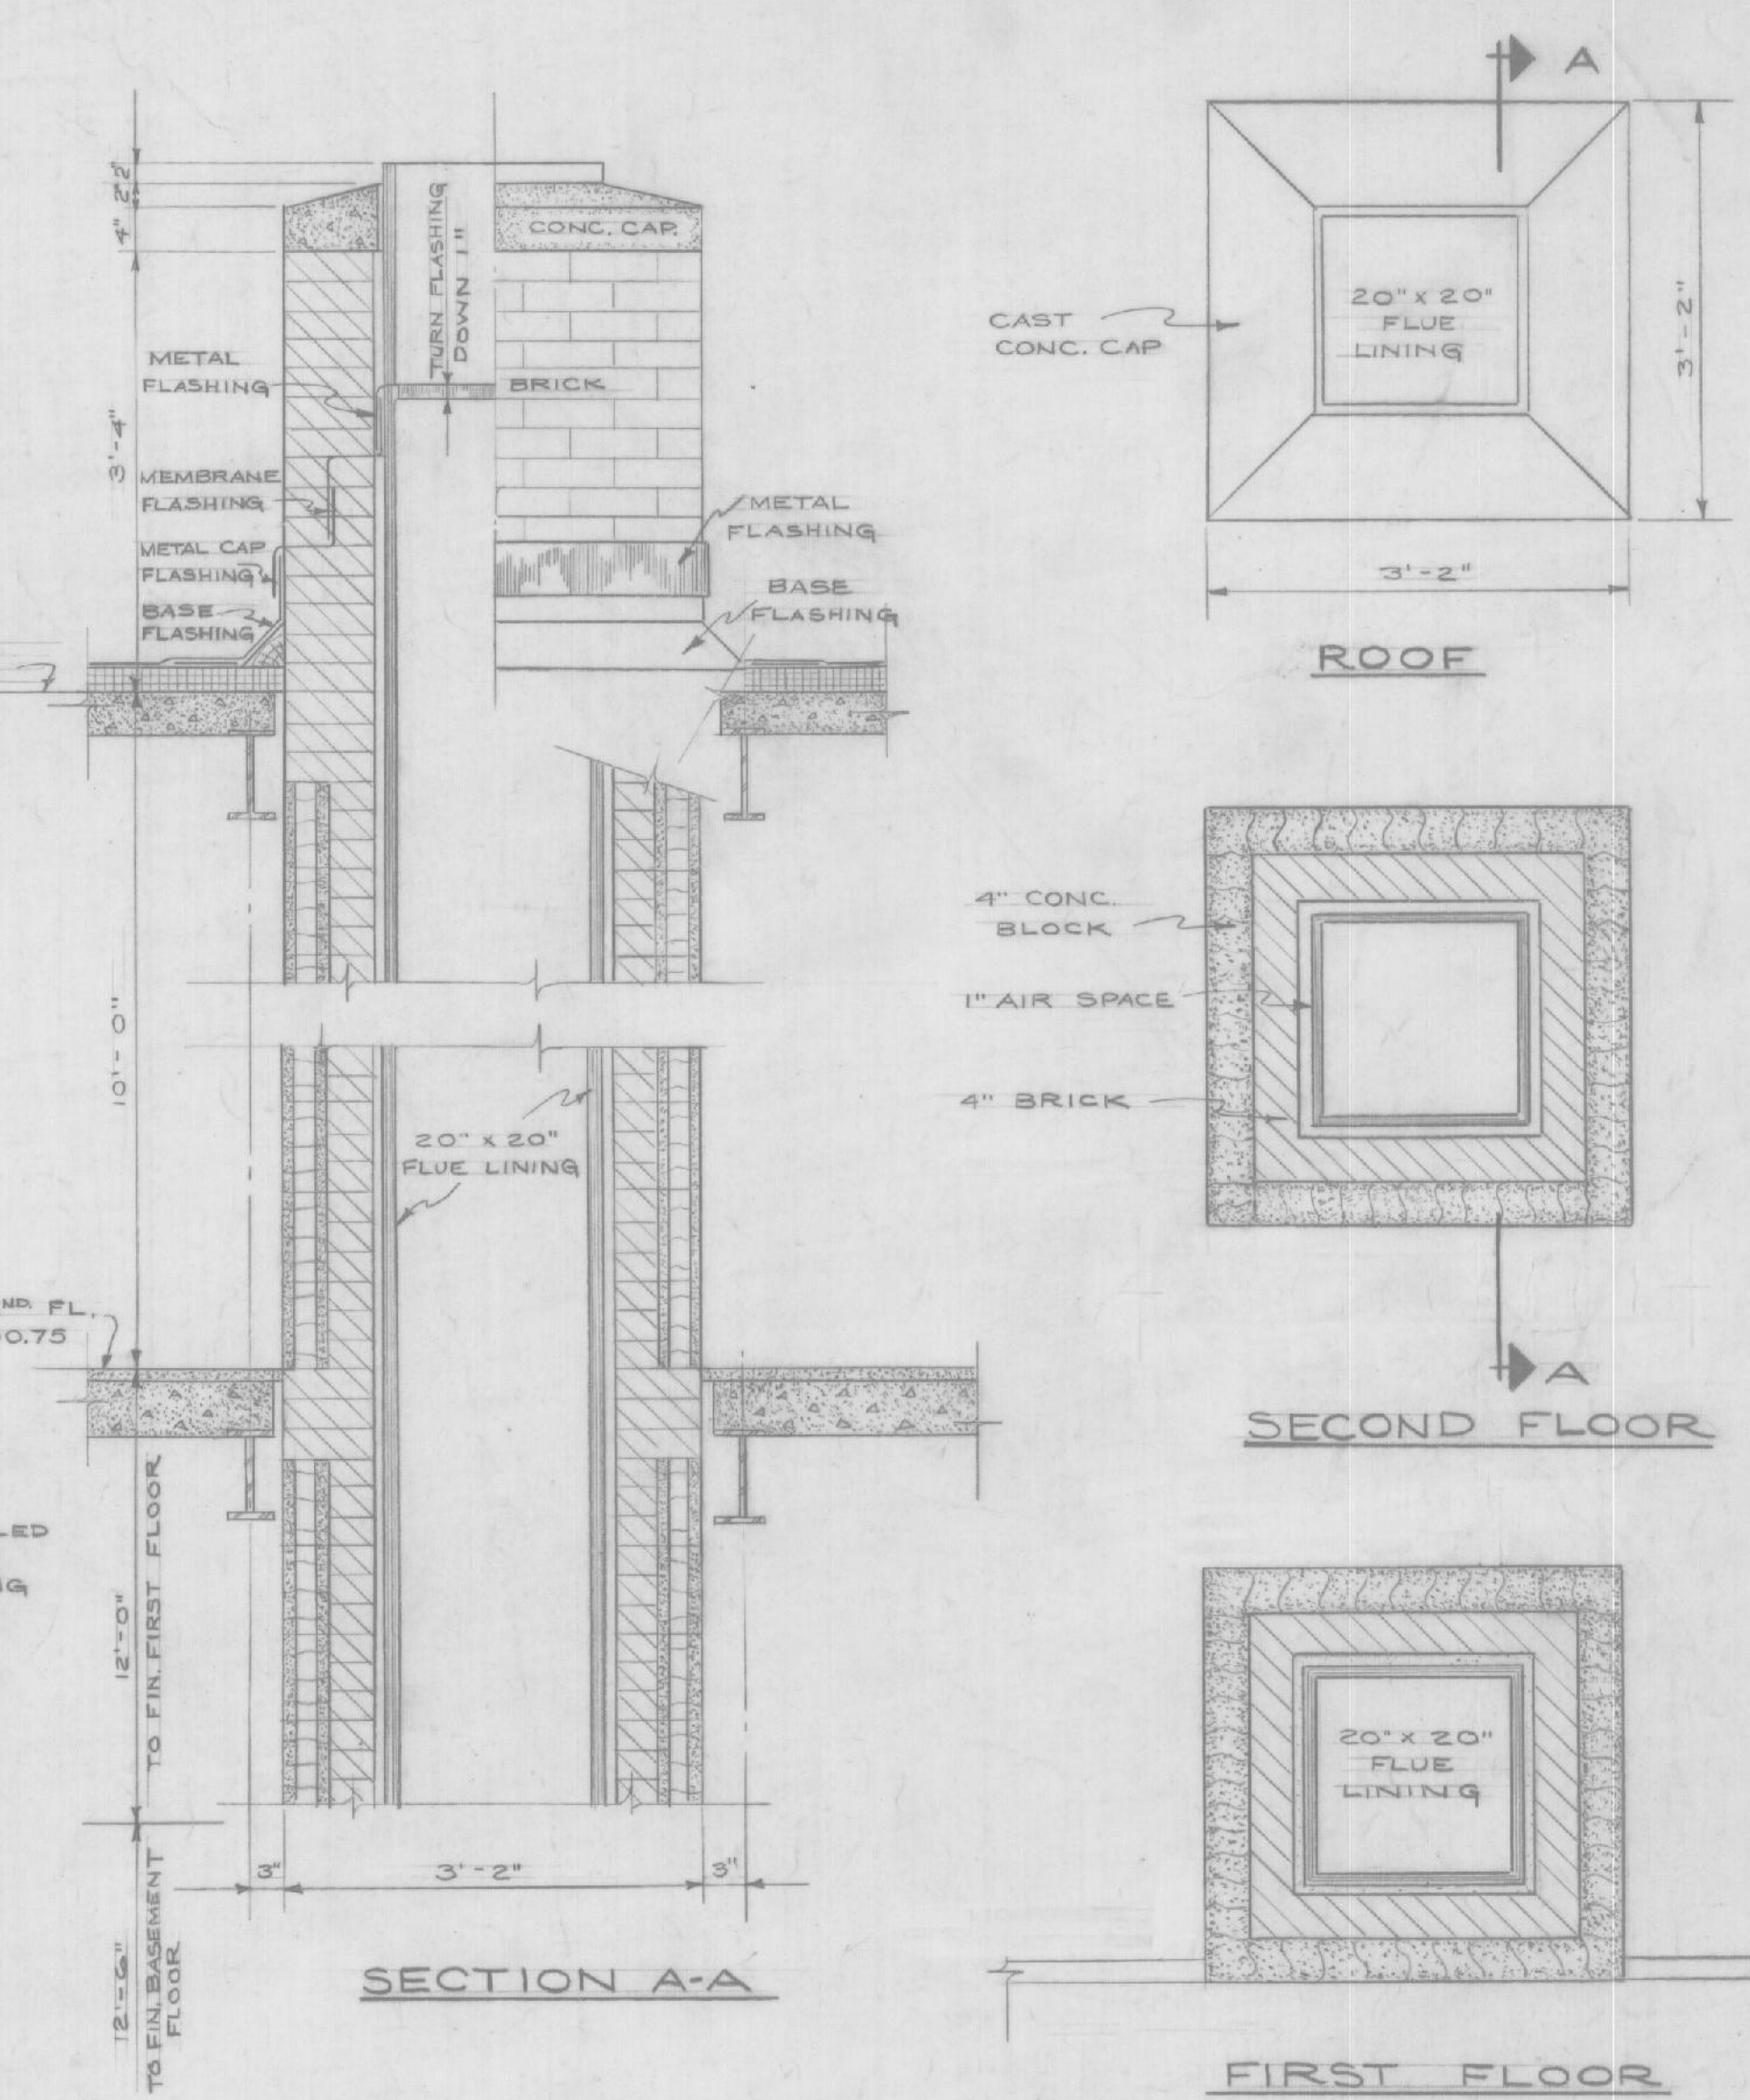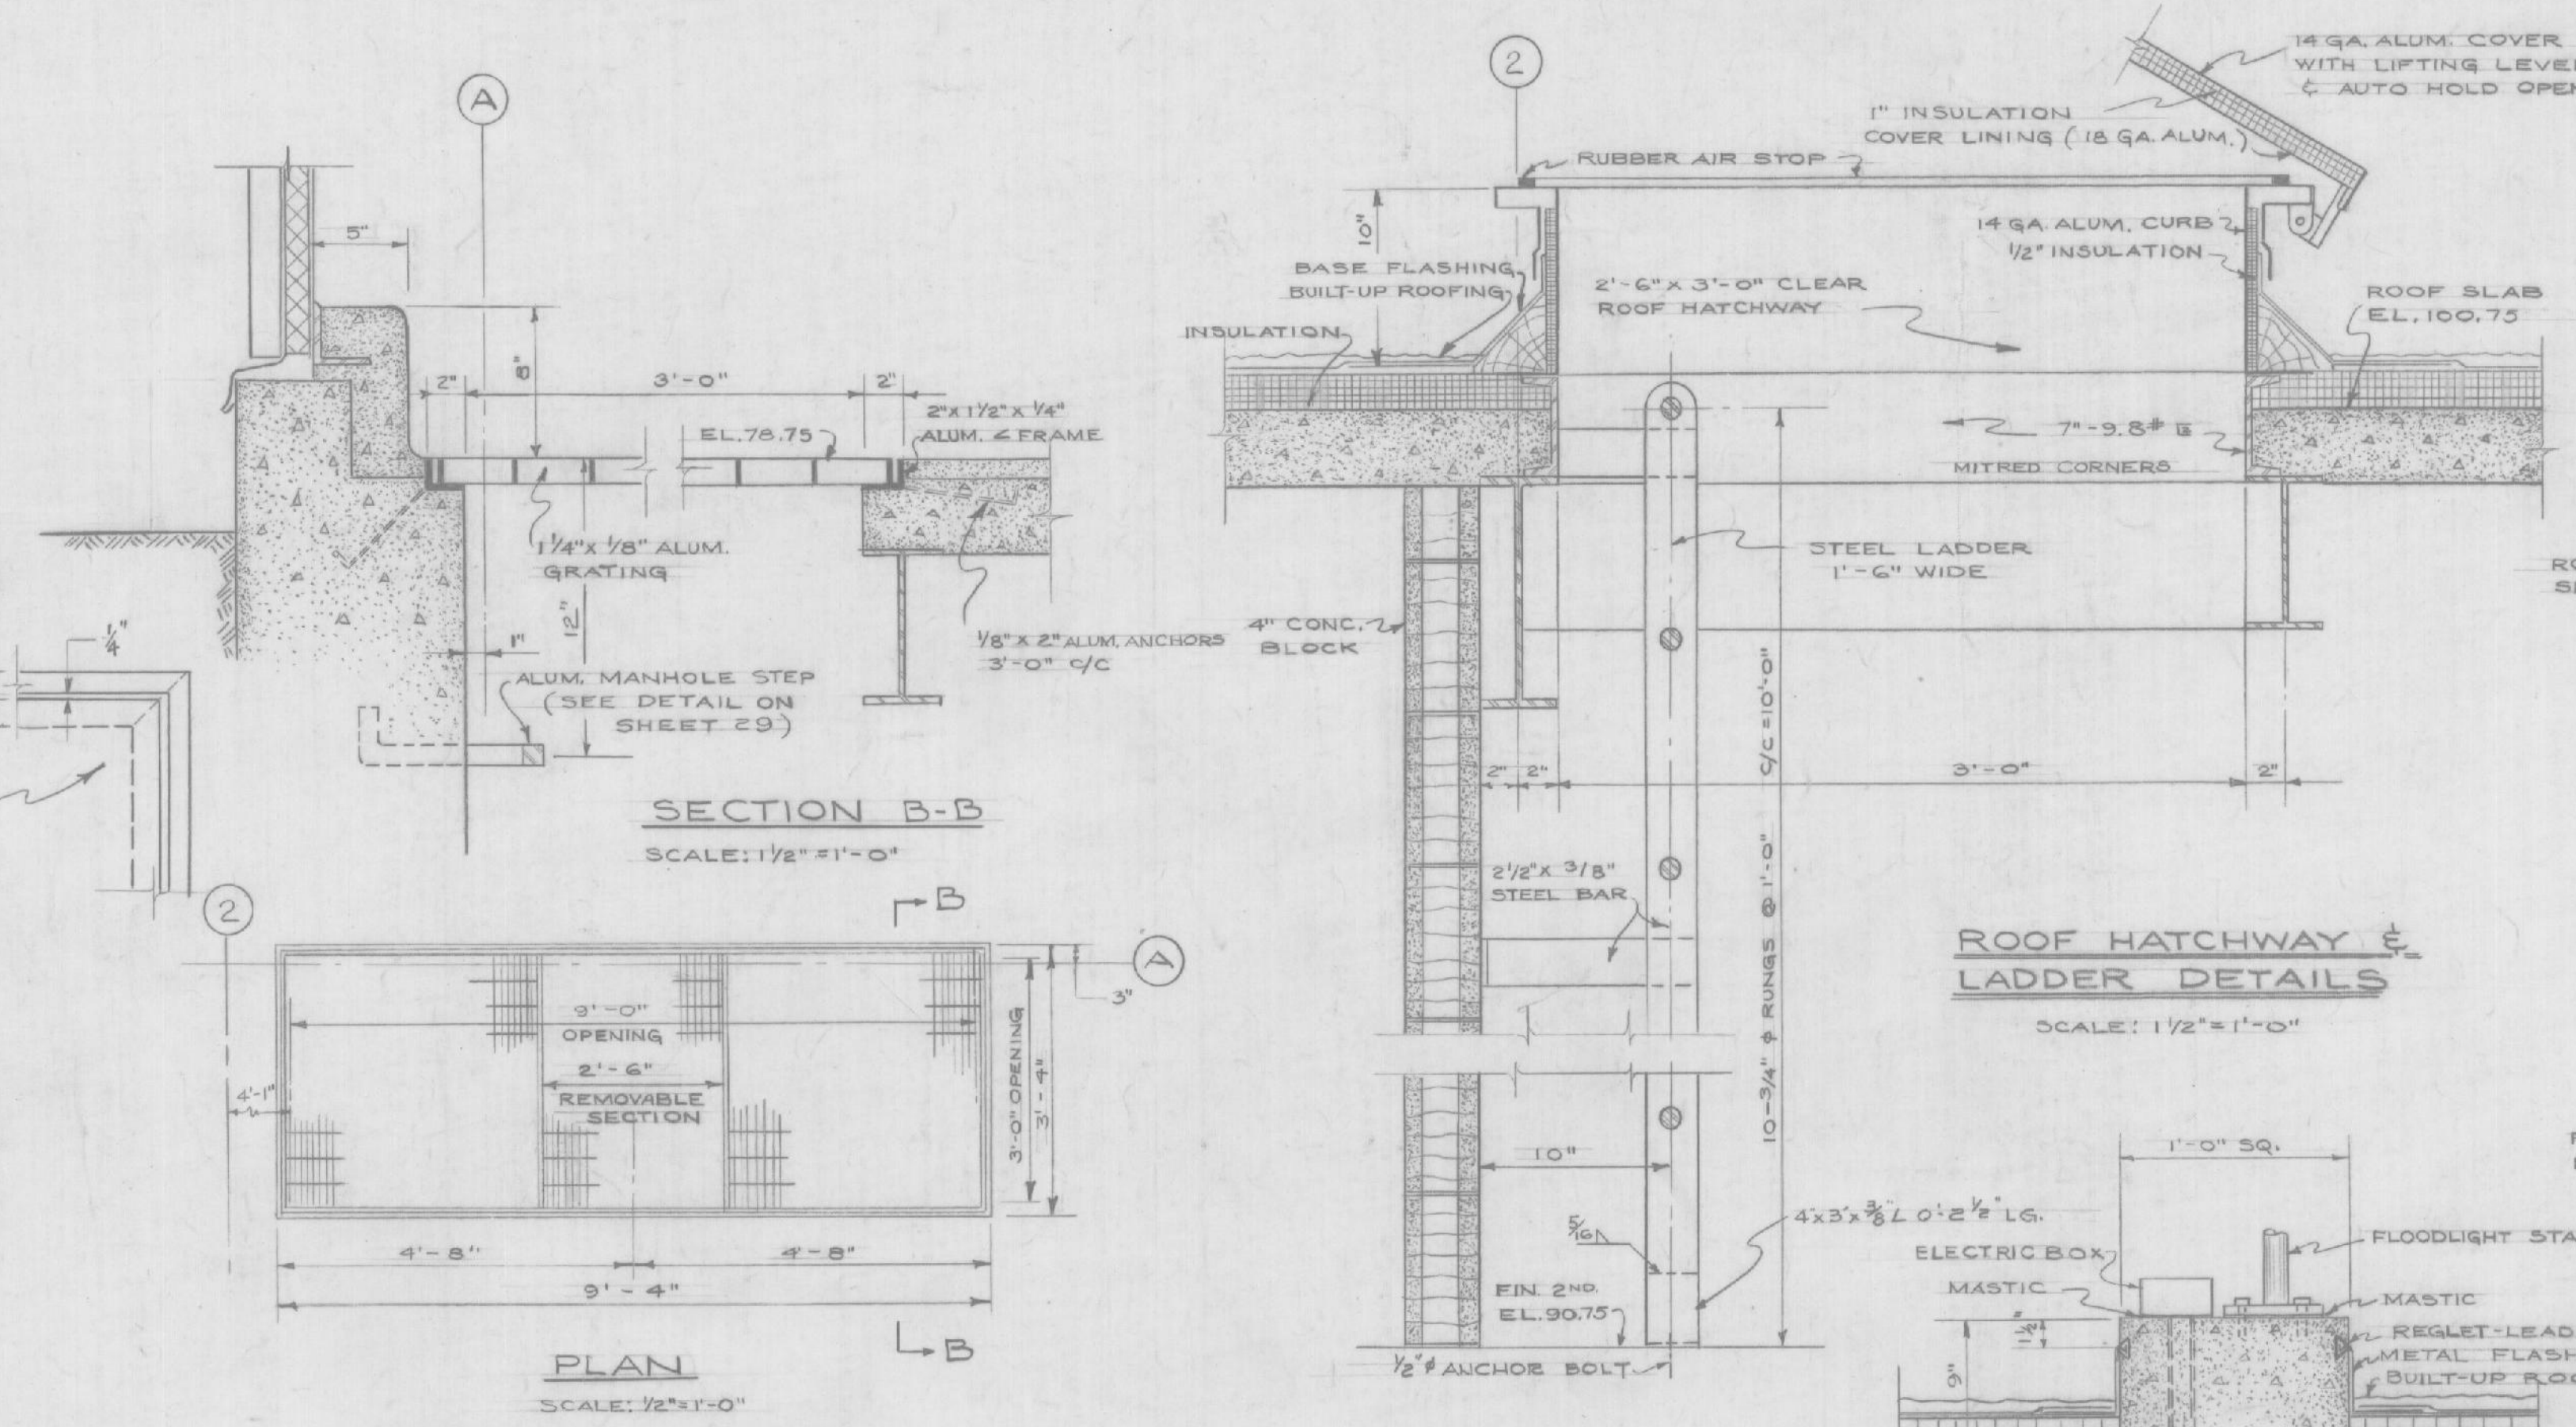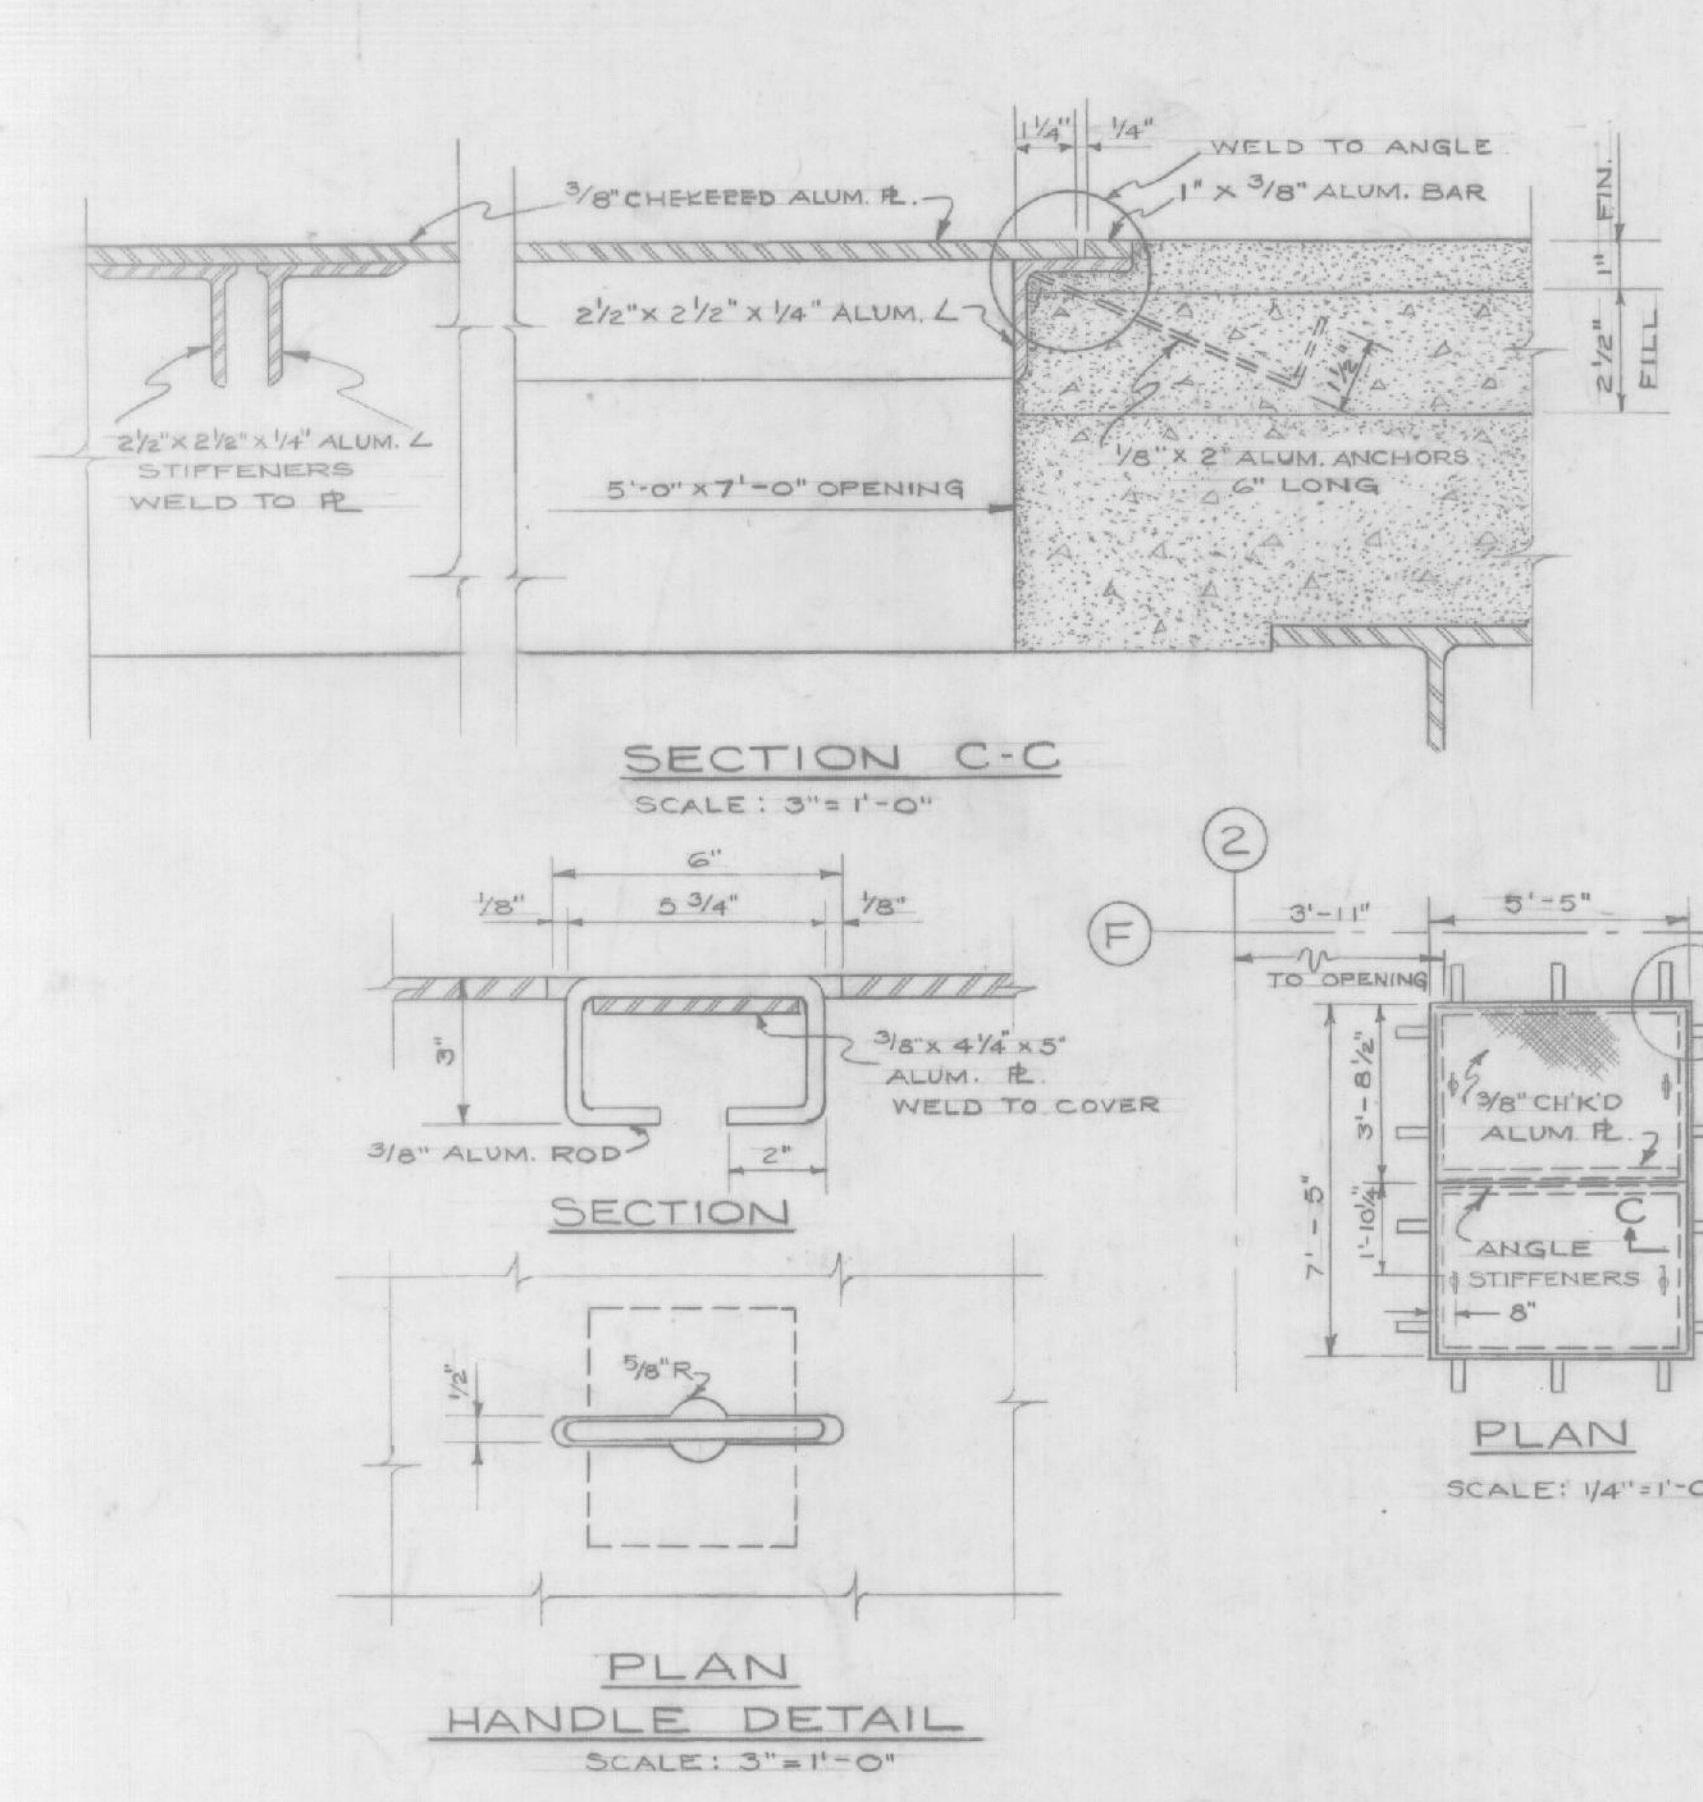

Record Drawing
Contract No. DA-19-016-ENG-6199

REVISION	DATE	DESCRIPTION	BY
2-17-52		FINAL FIELD CORRECTIONS.	
DRAWN BY: ABS.		WHITMAN & HOWARD, INC. ENGINEERS 89 BROAD ST., BOSTON, MASS.	
TRACED BY: ABS.		CORPS OF ENGINEERS, U. S. ARMY OFFICE OF THE DIVISION ENGINEER NEW ENGLAND DIVISION WALTHAM, MASS.	
CHECKED BY: C.G.M.		PEASE AIR FORCE BASE PORTSMOUTH, NEW HAMPSHIRE SURFACE WATER SUPPLY FILTER BUILDING ARCHITECTURAL MISCELLANEOUS DETAILS	
SUBMITTED: <i>Handwritten Signature</i>		DATE: JUNE, 1959	
APPROVED: <i>Handwritten Signature</i>		SCALE AS NOTED SPEC. NO. 10-016-23-10	
DRAWING NUMBER: AW71-05-31		SHEET 10	

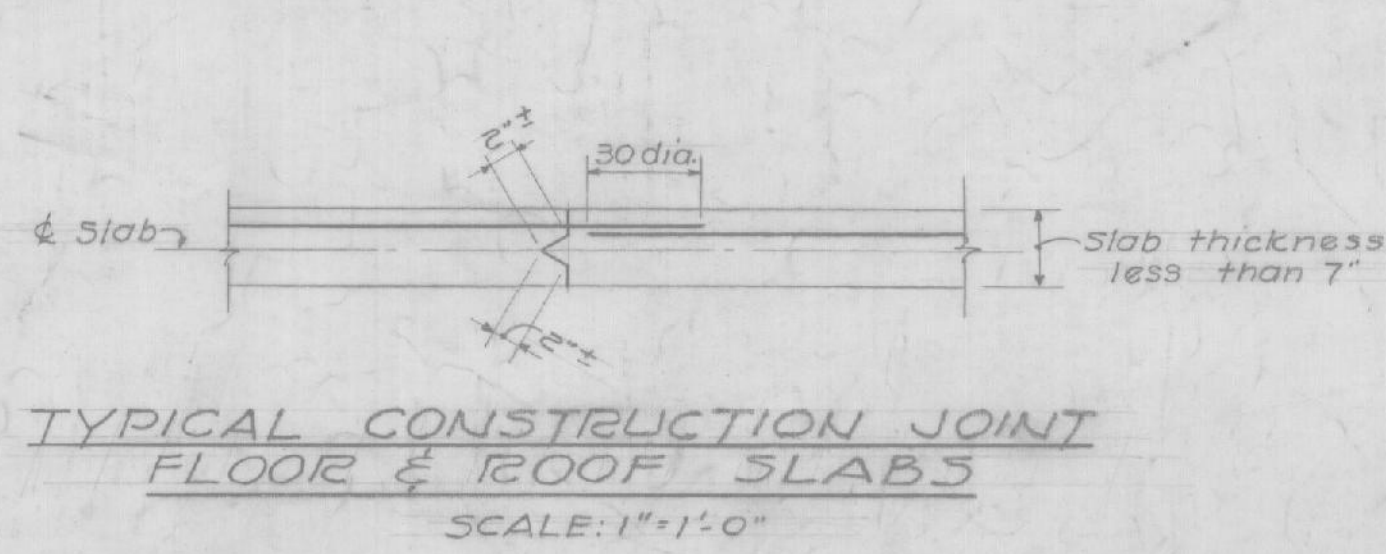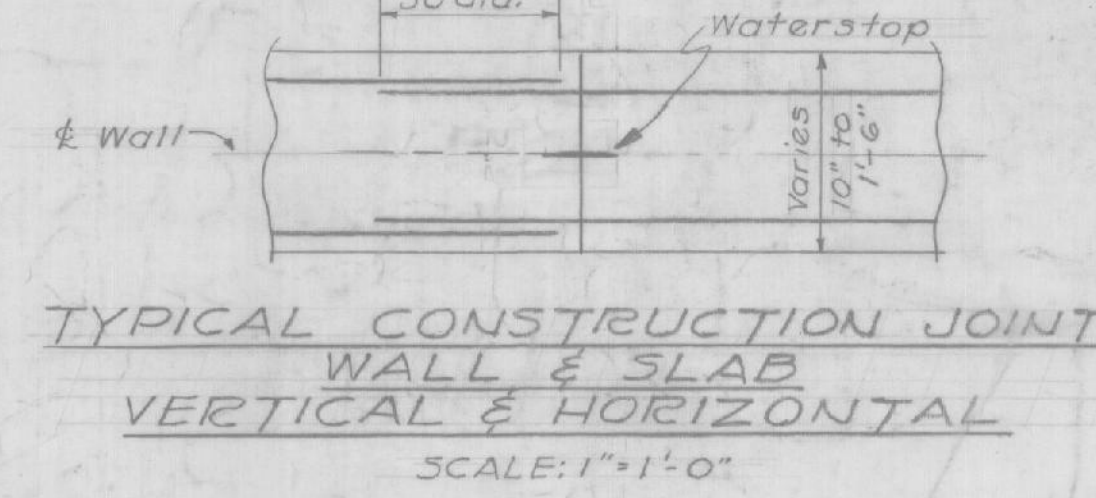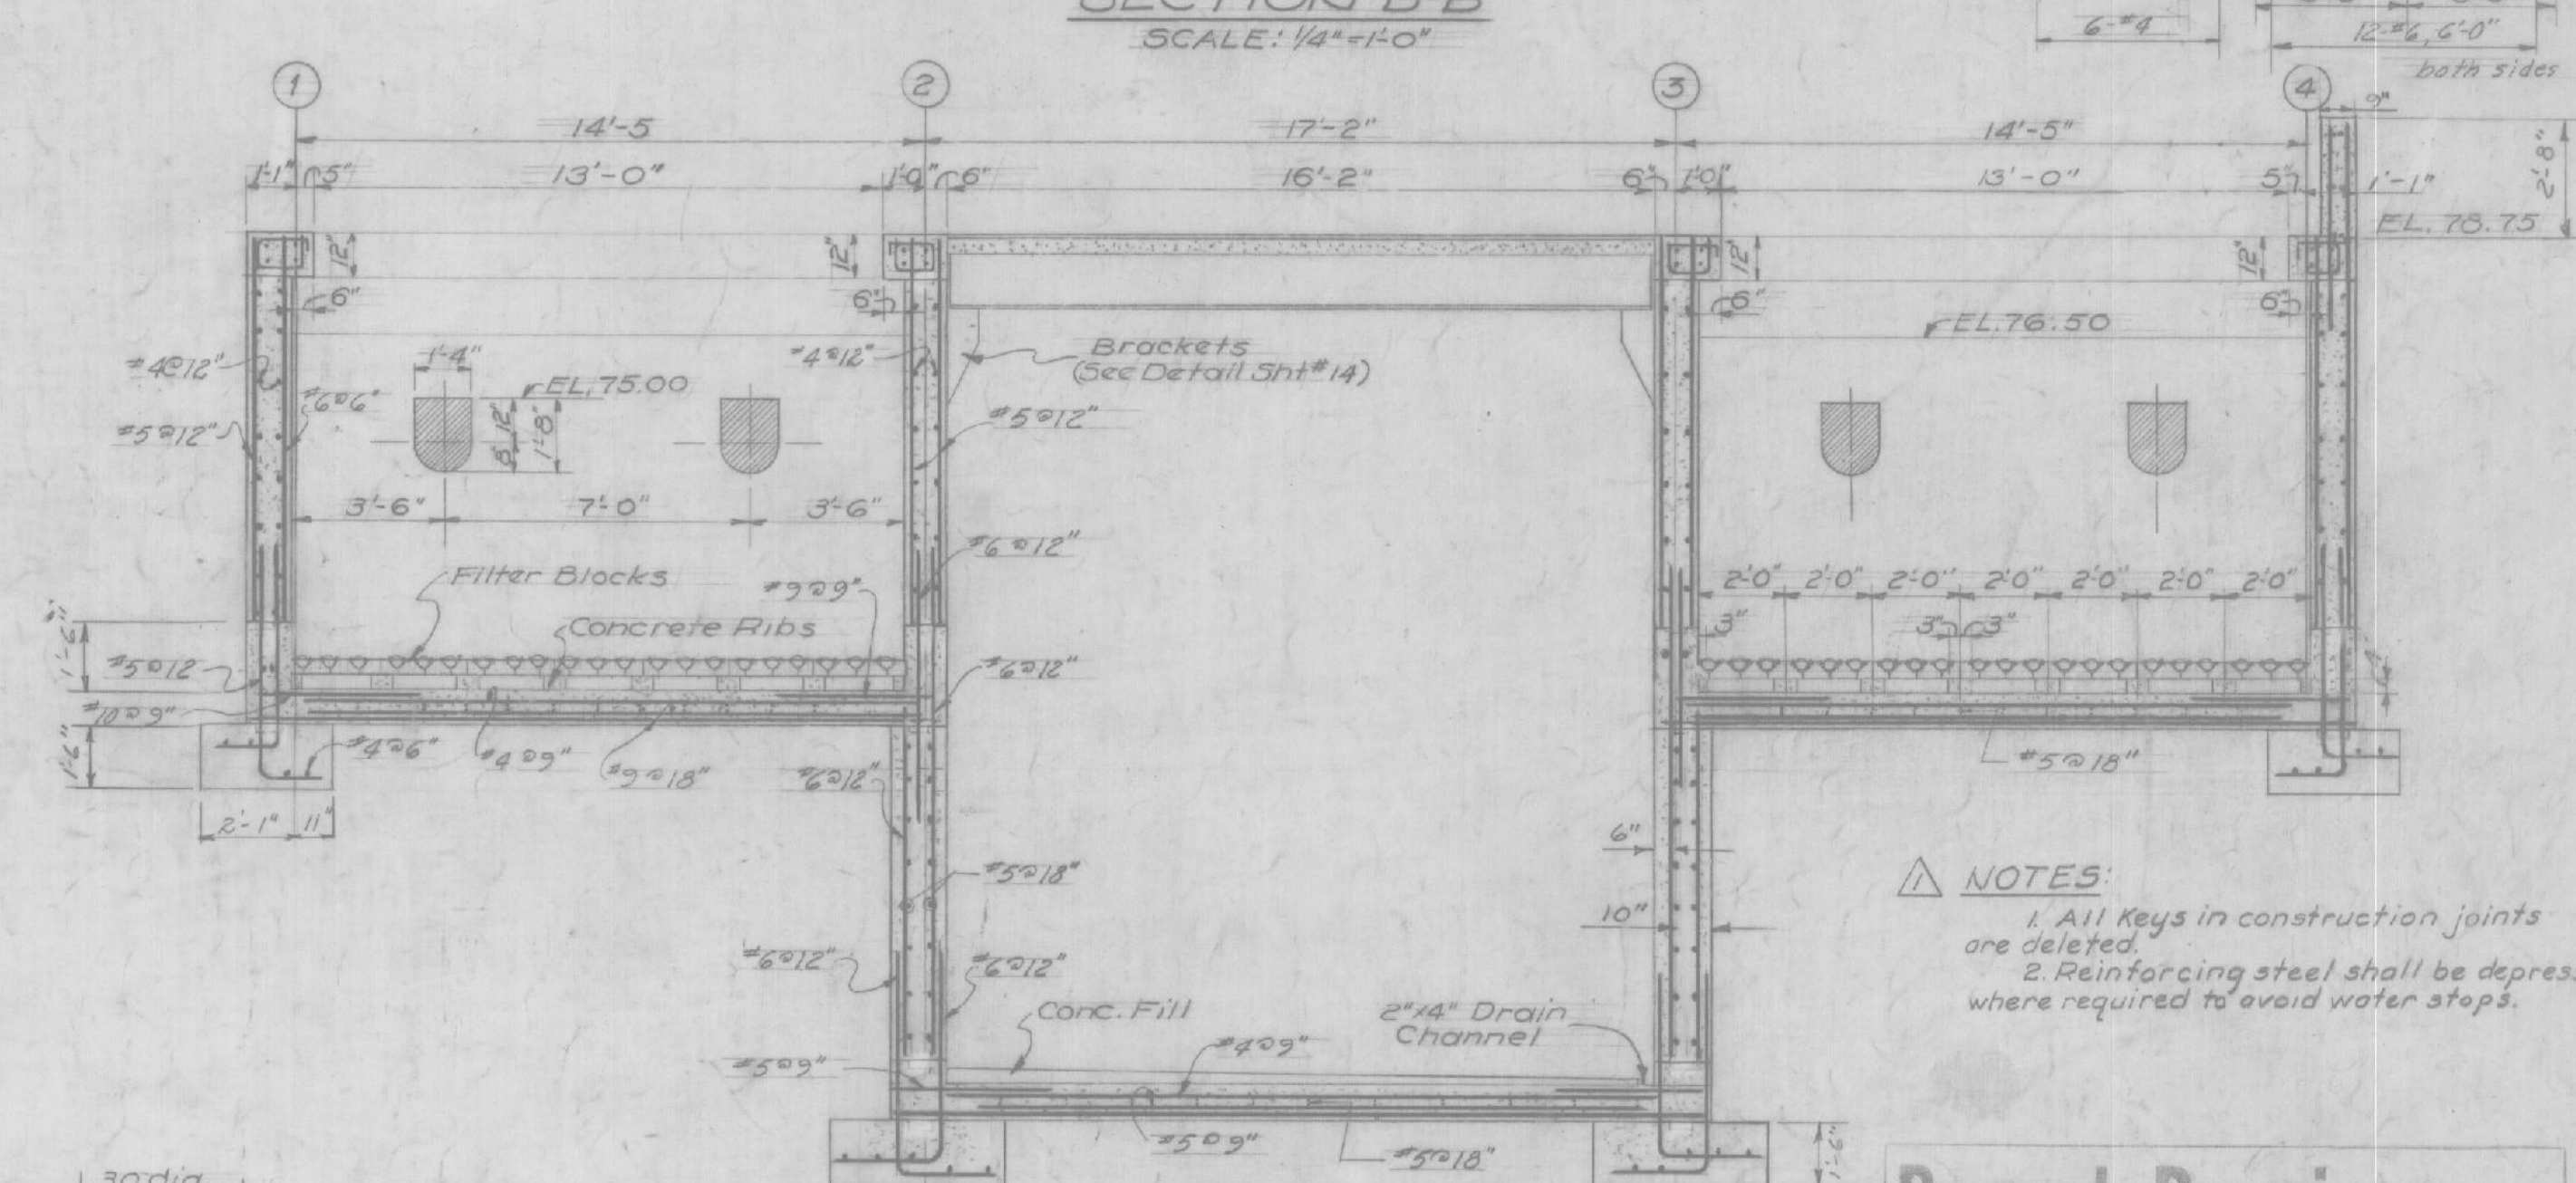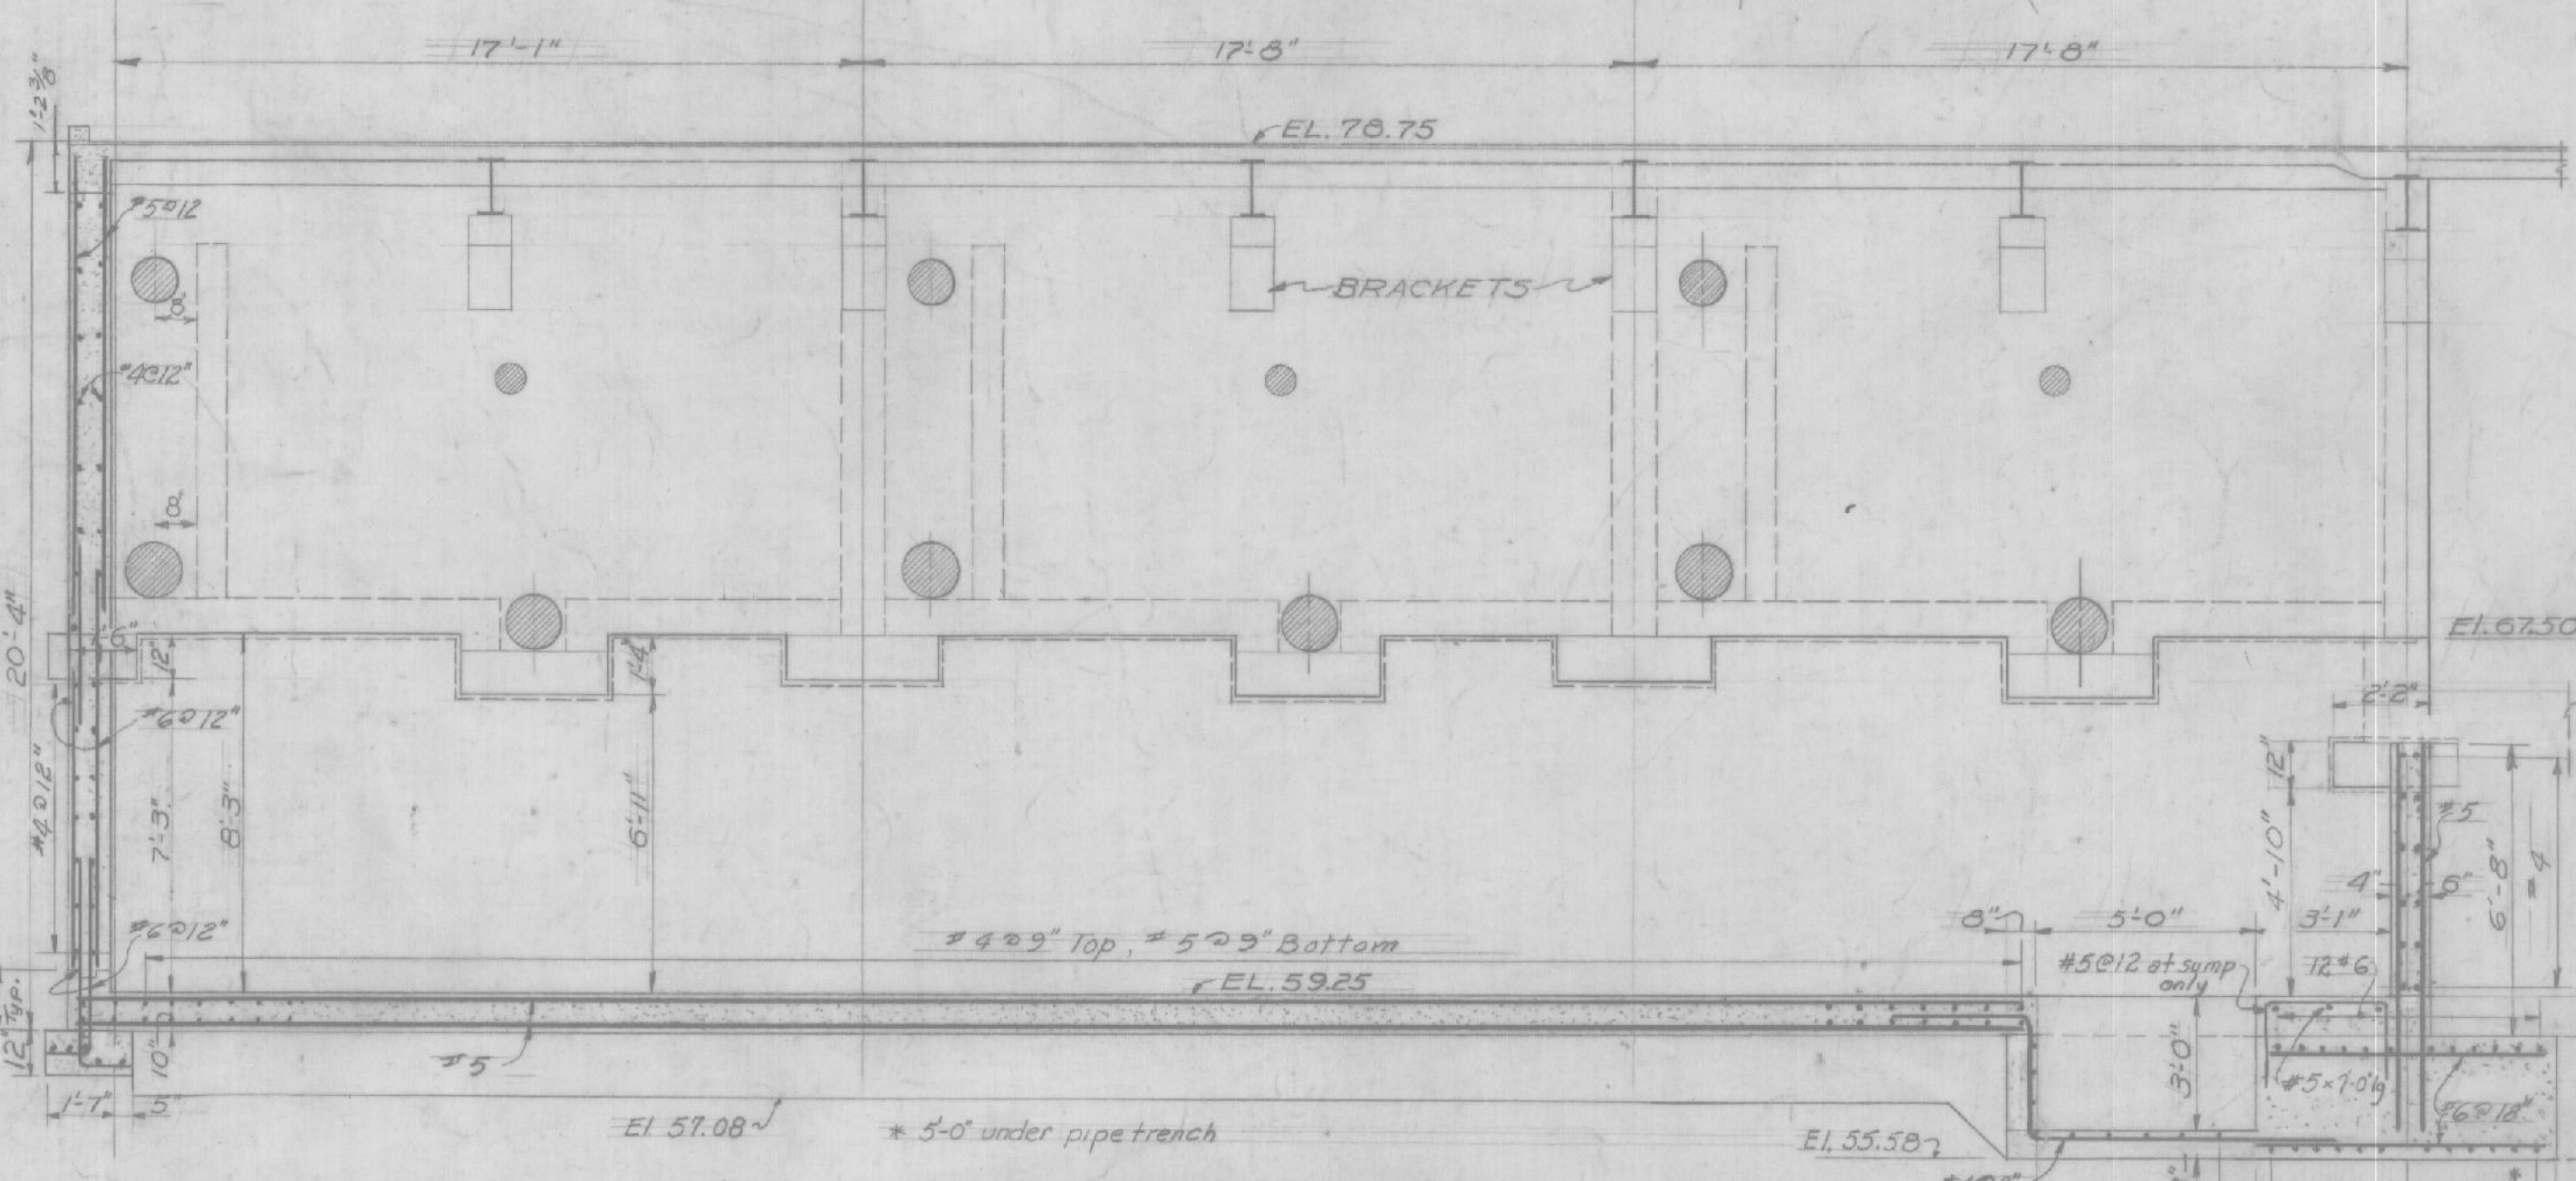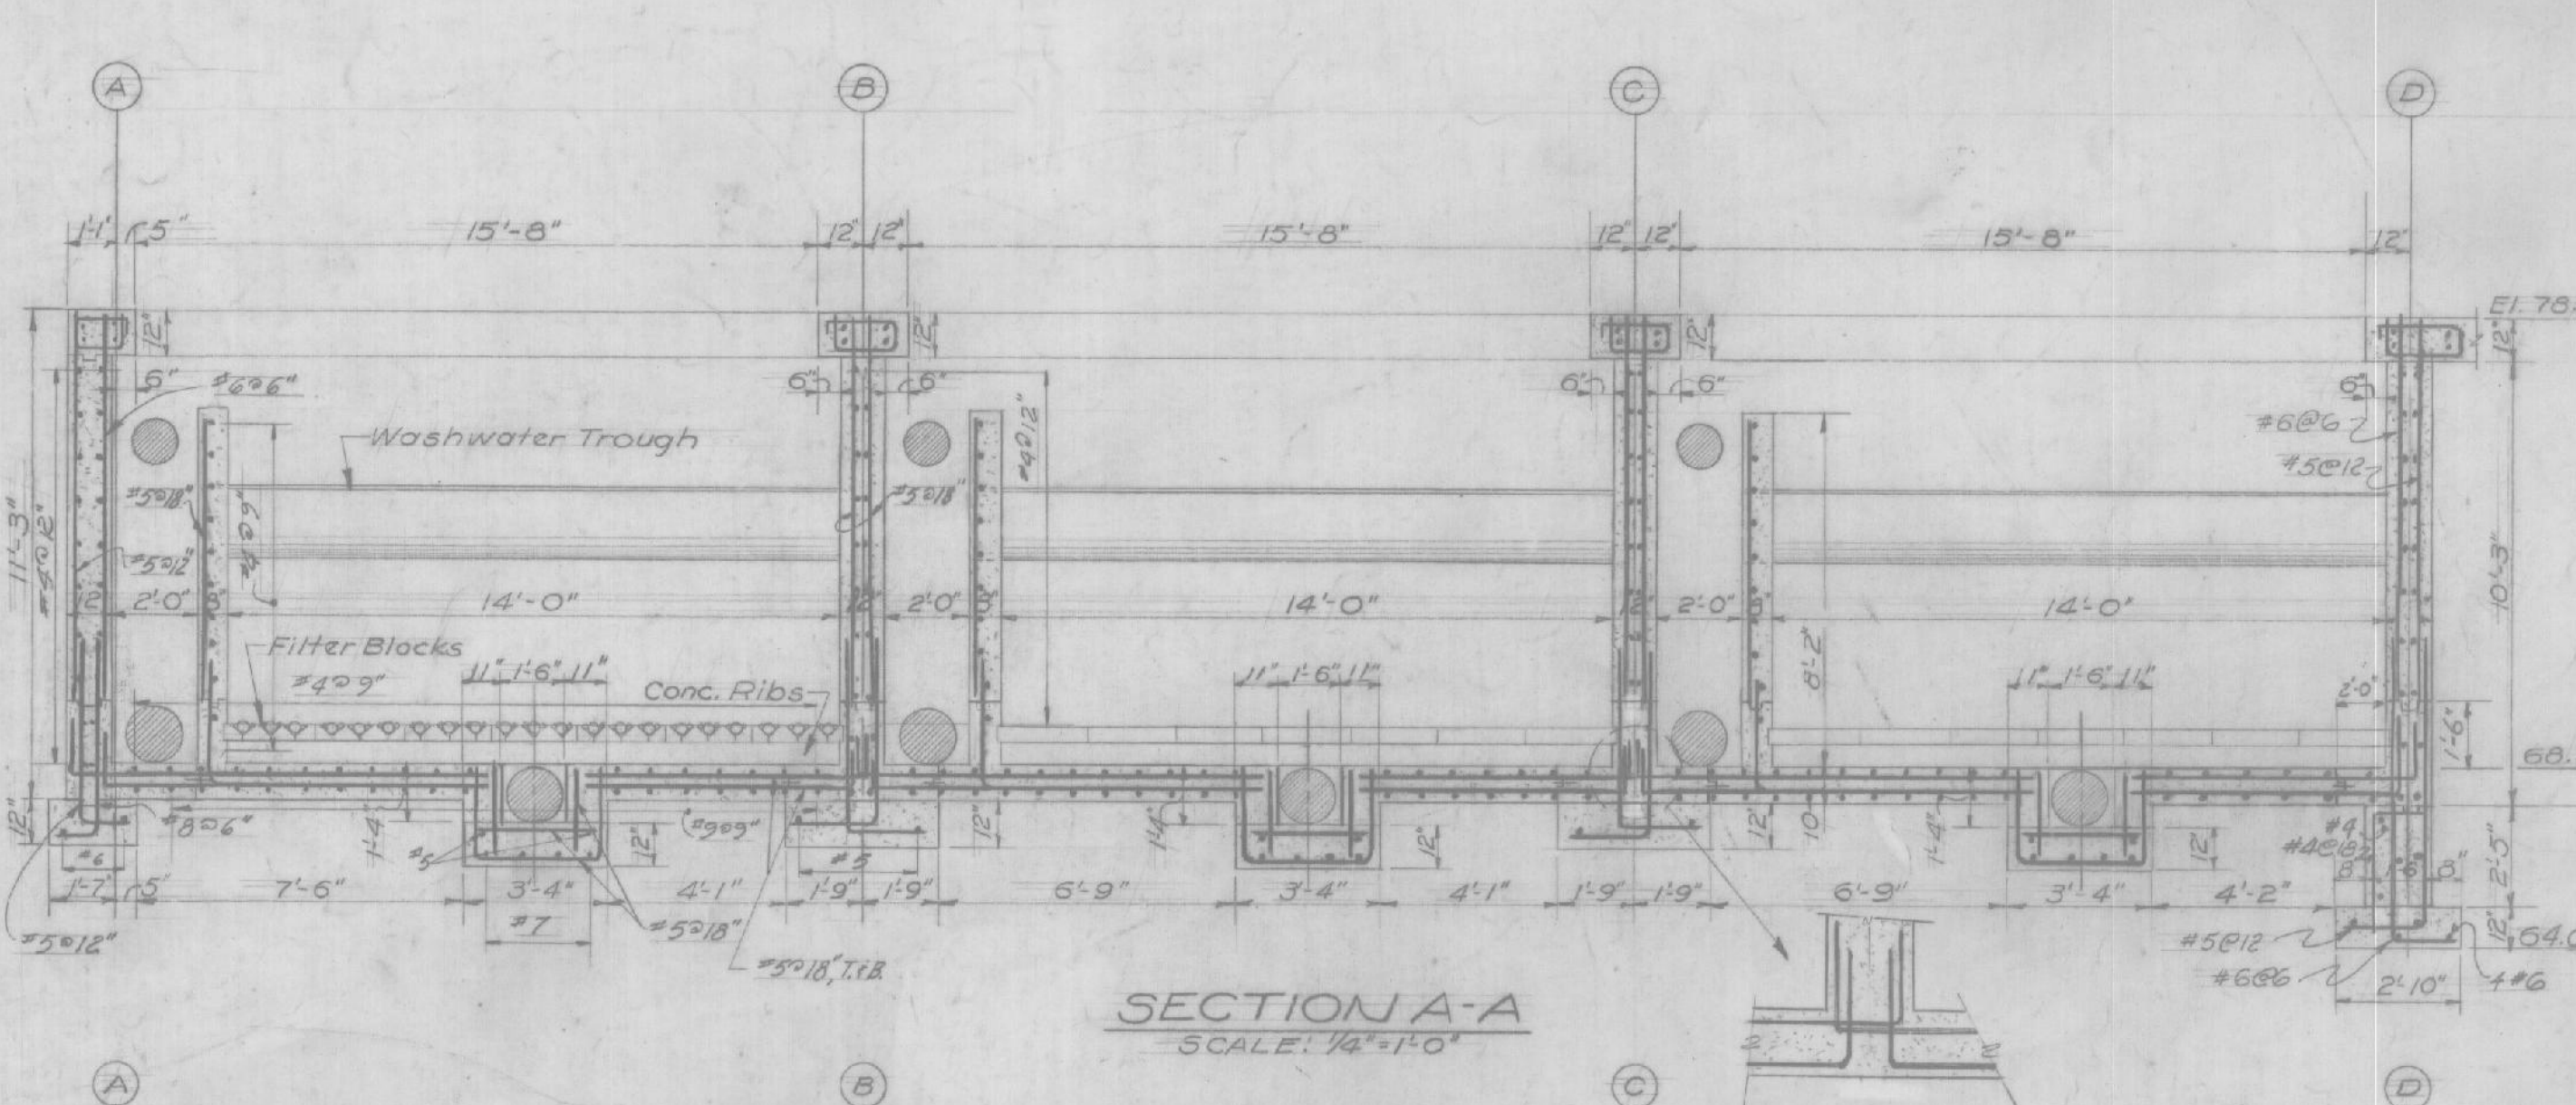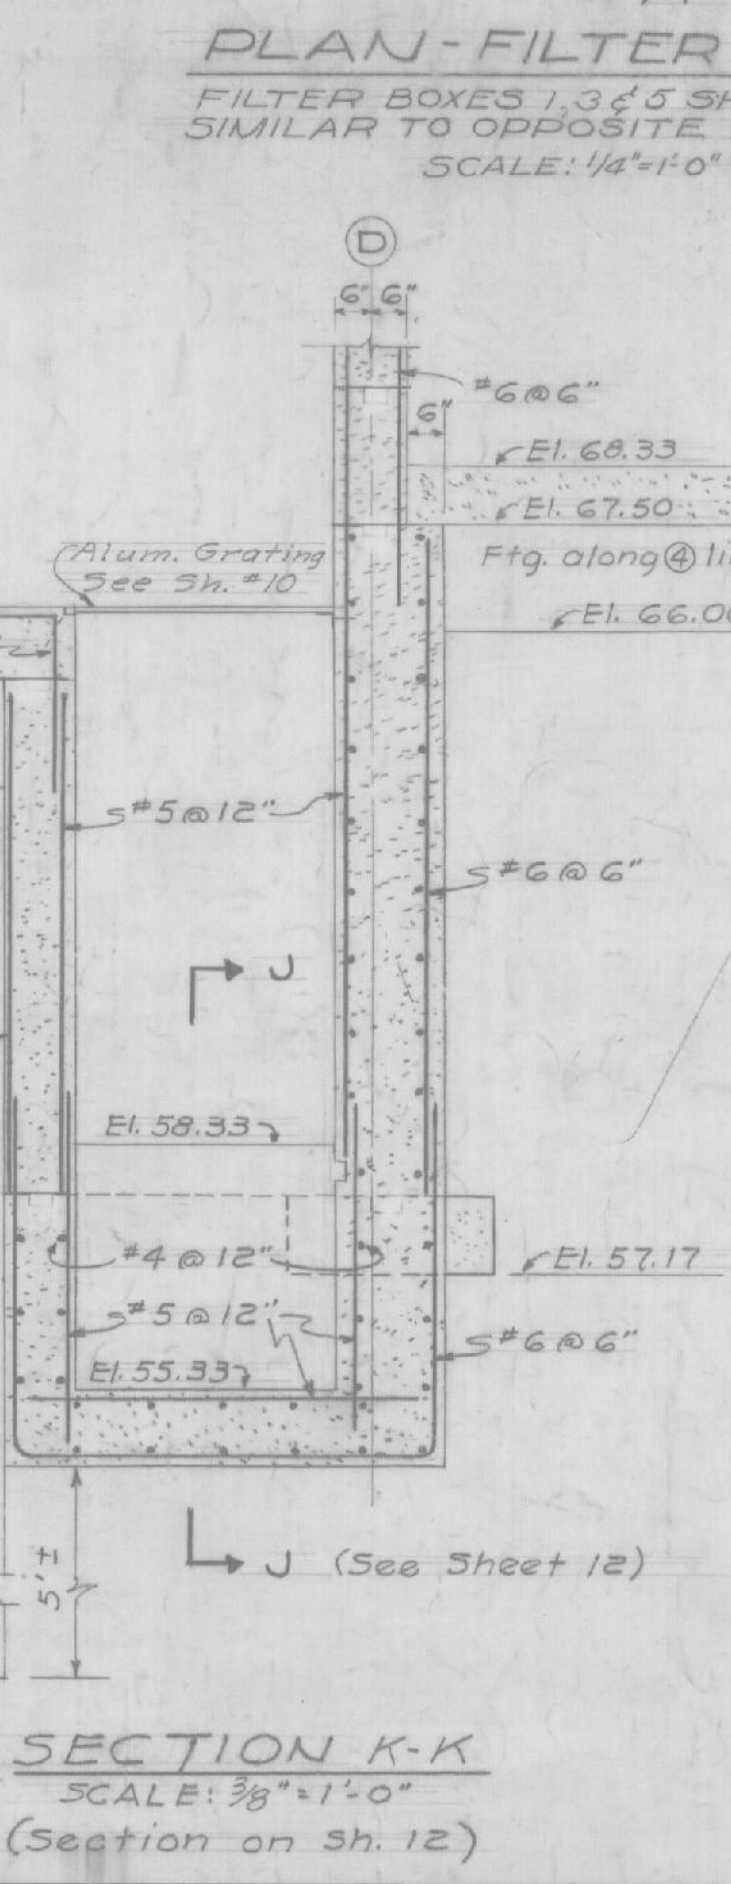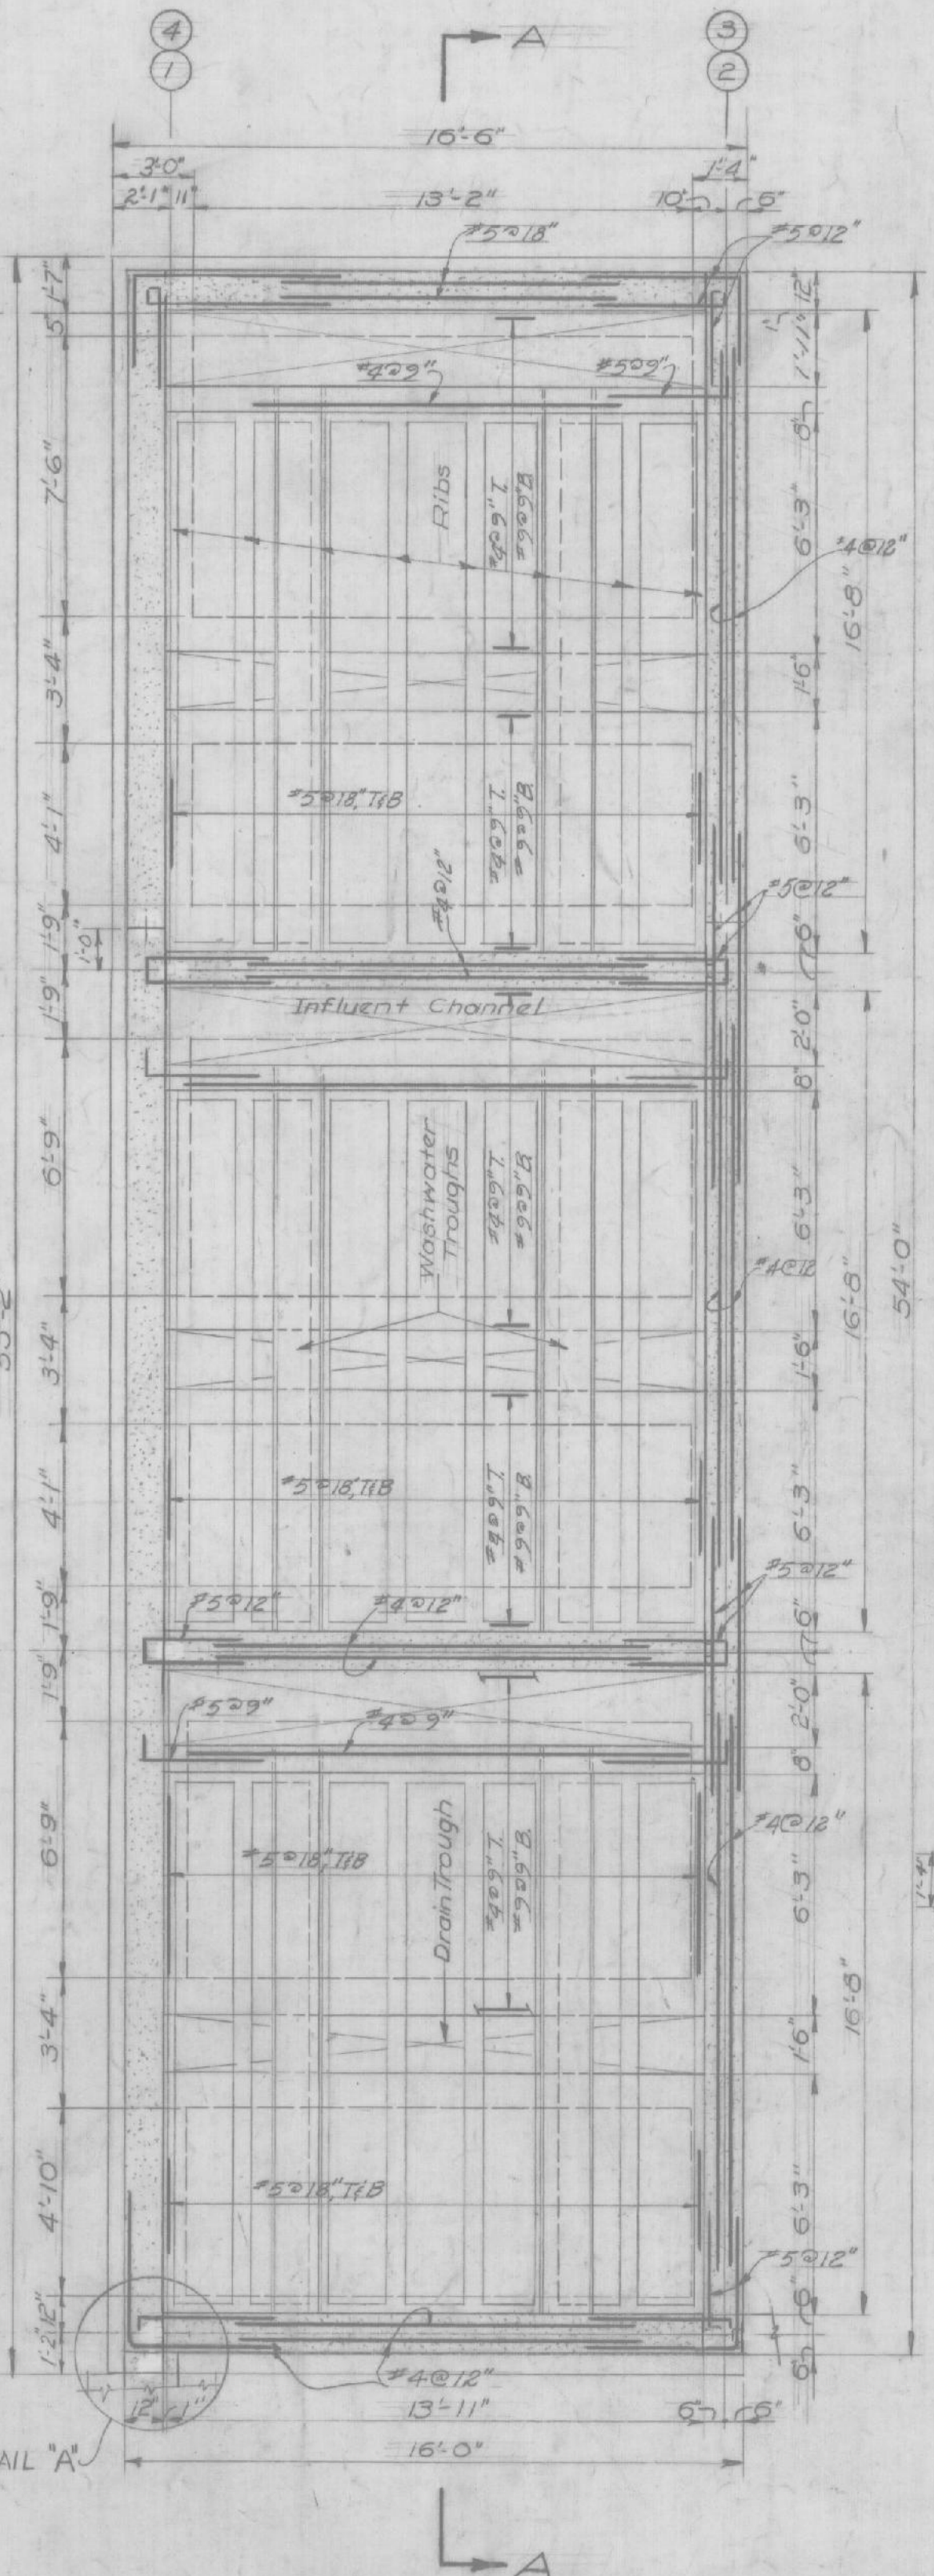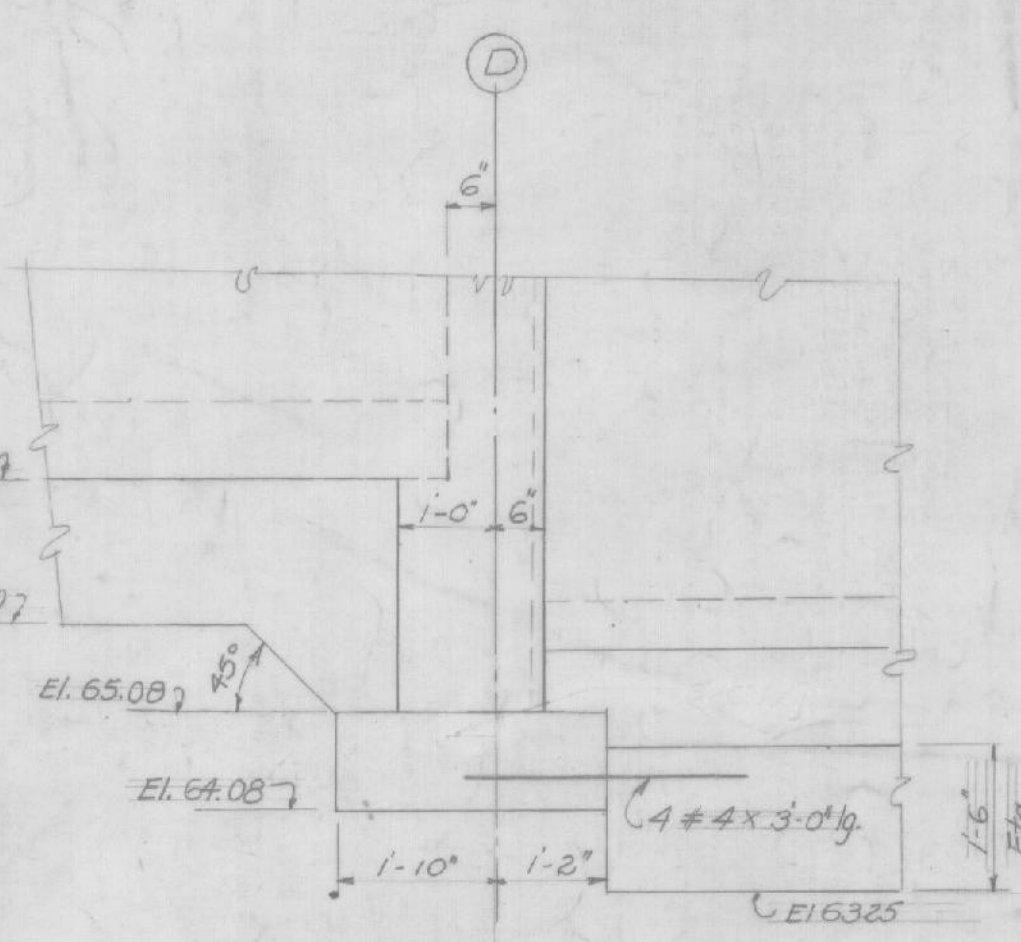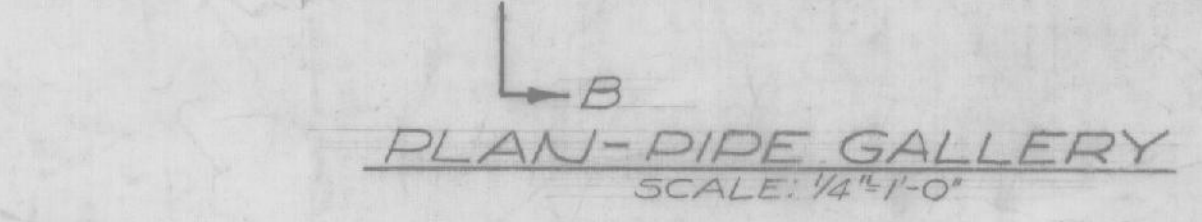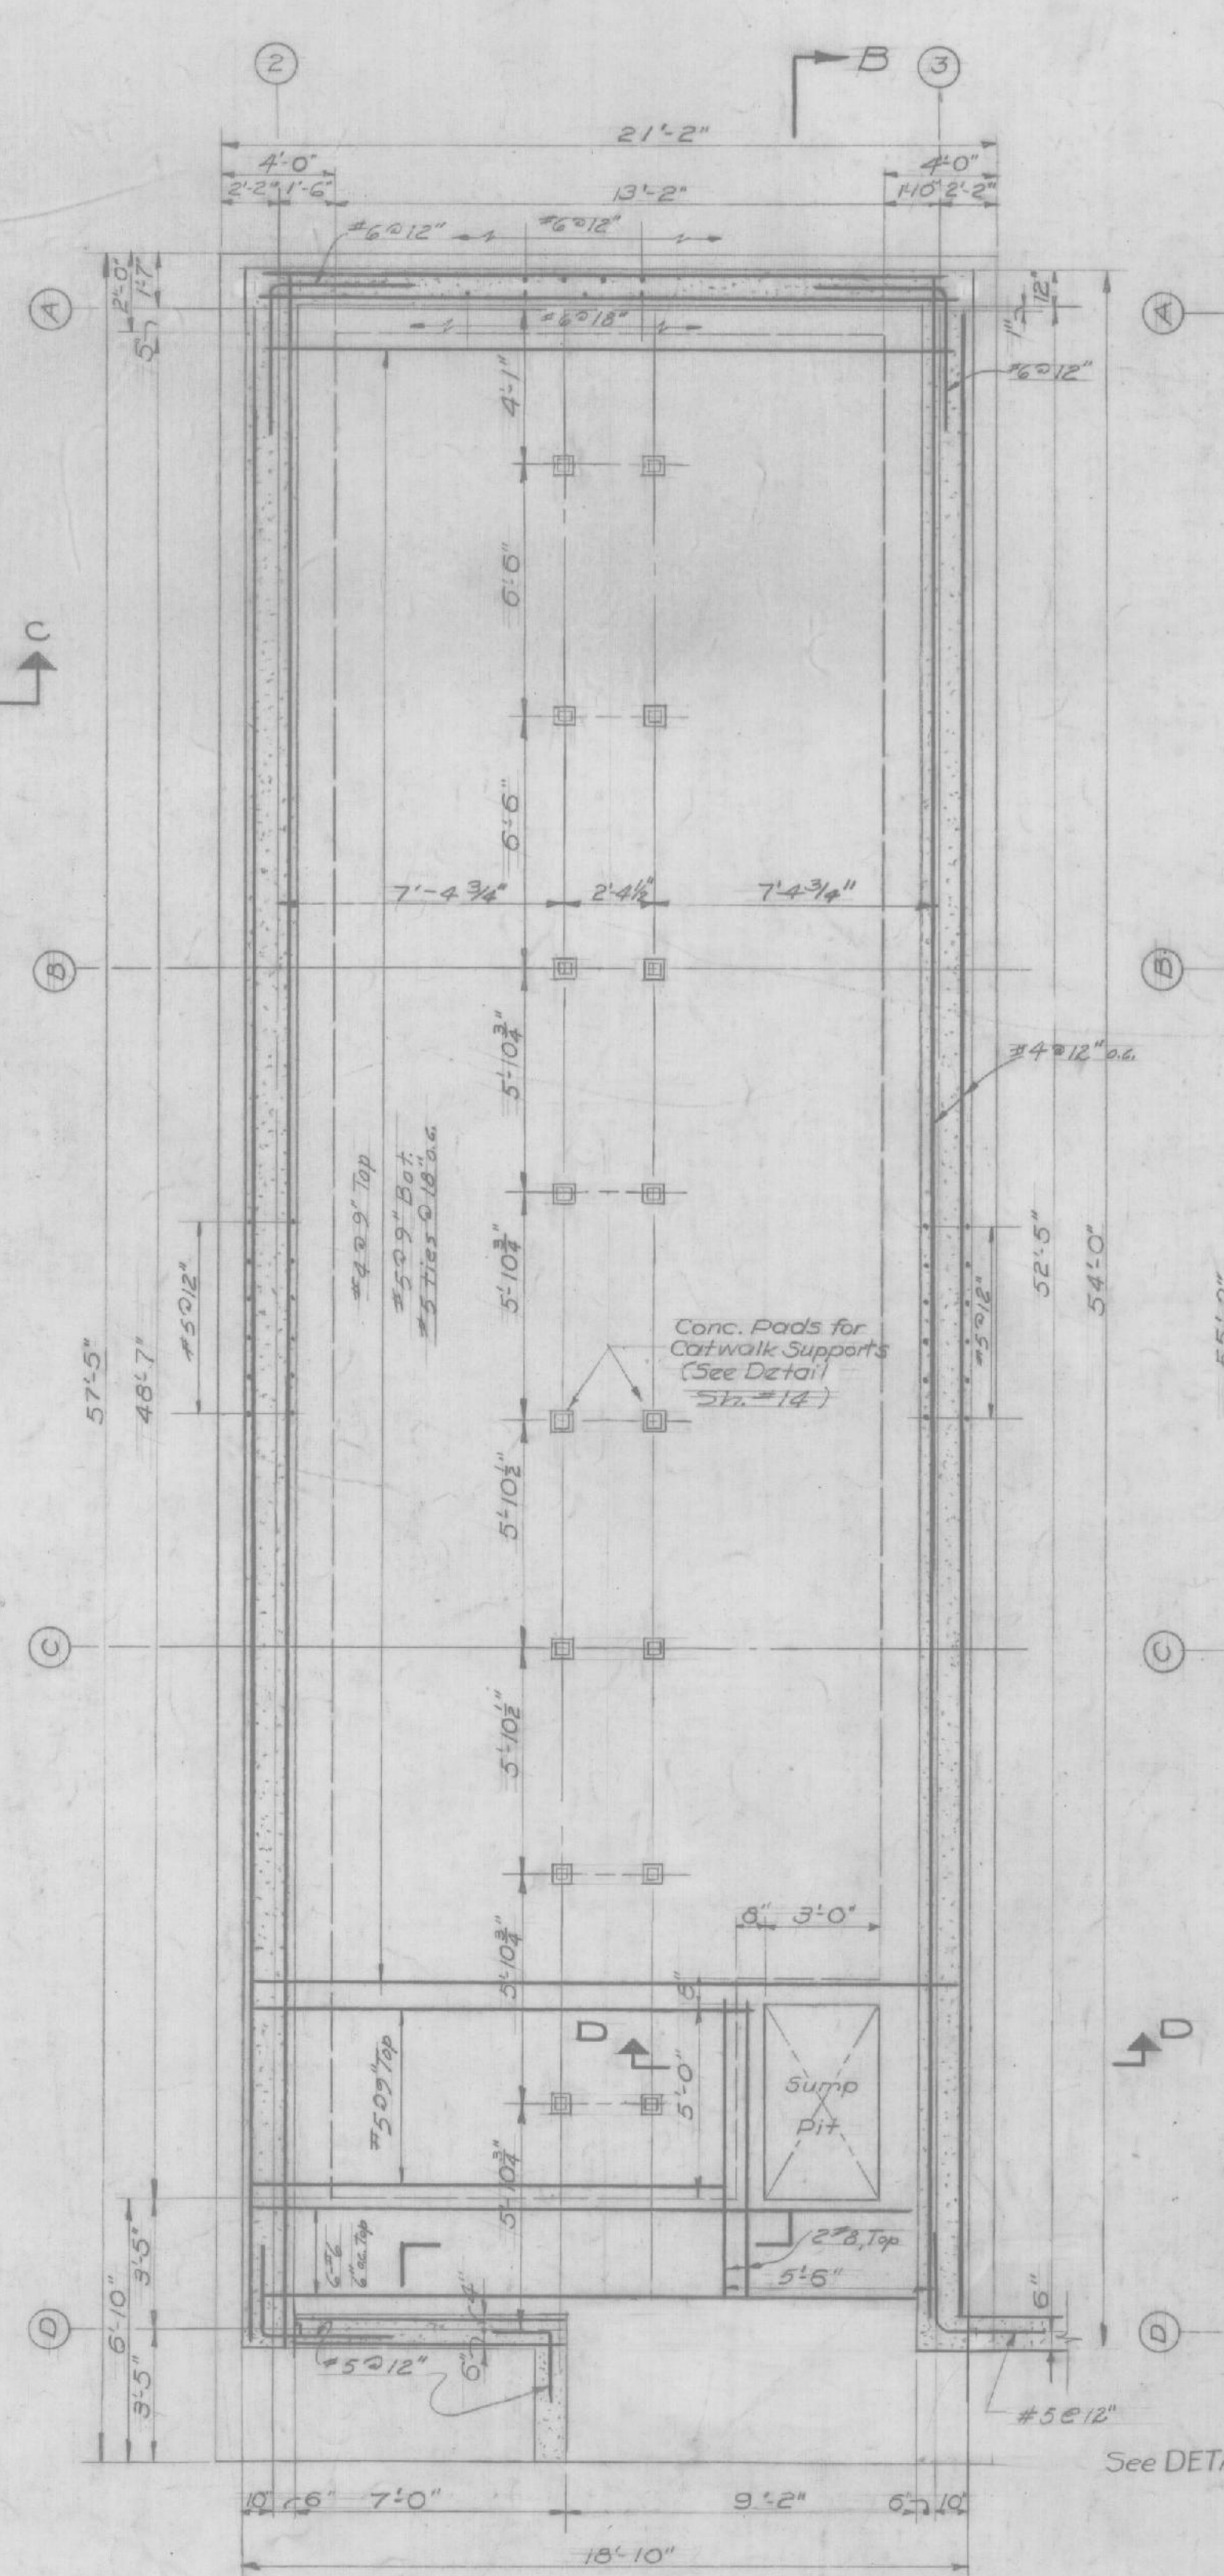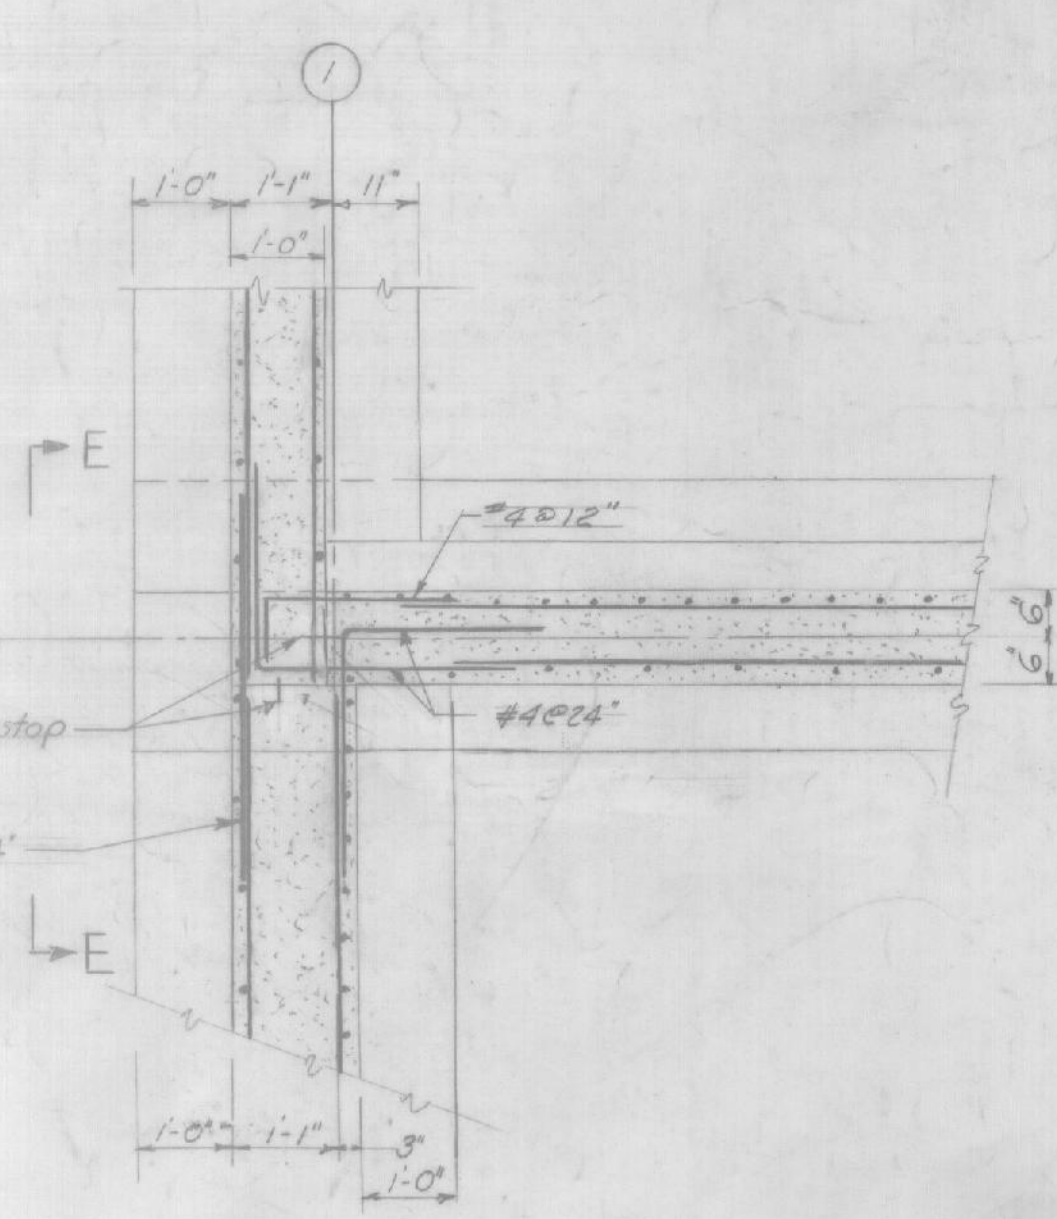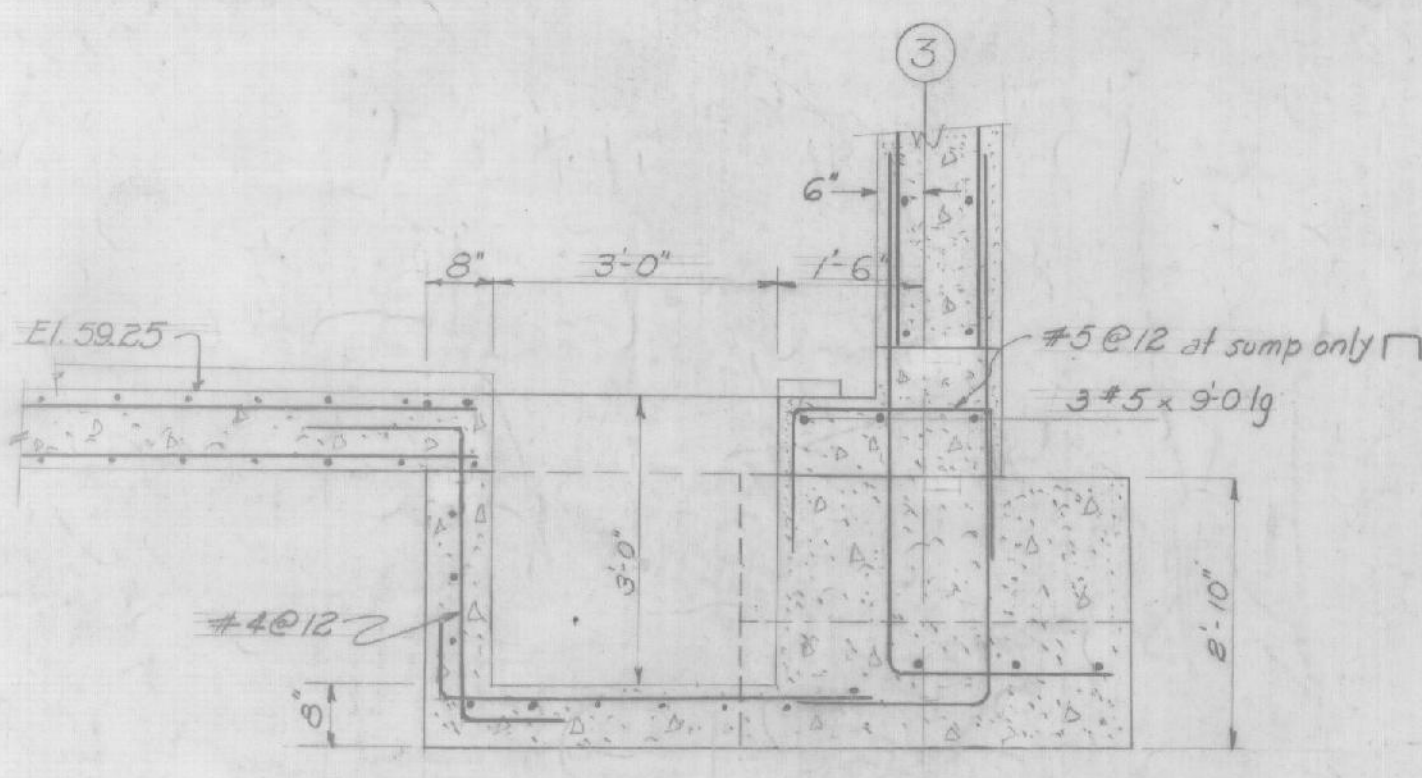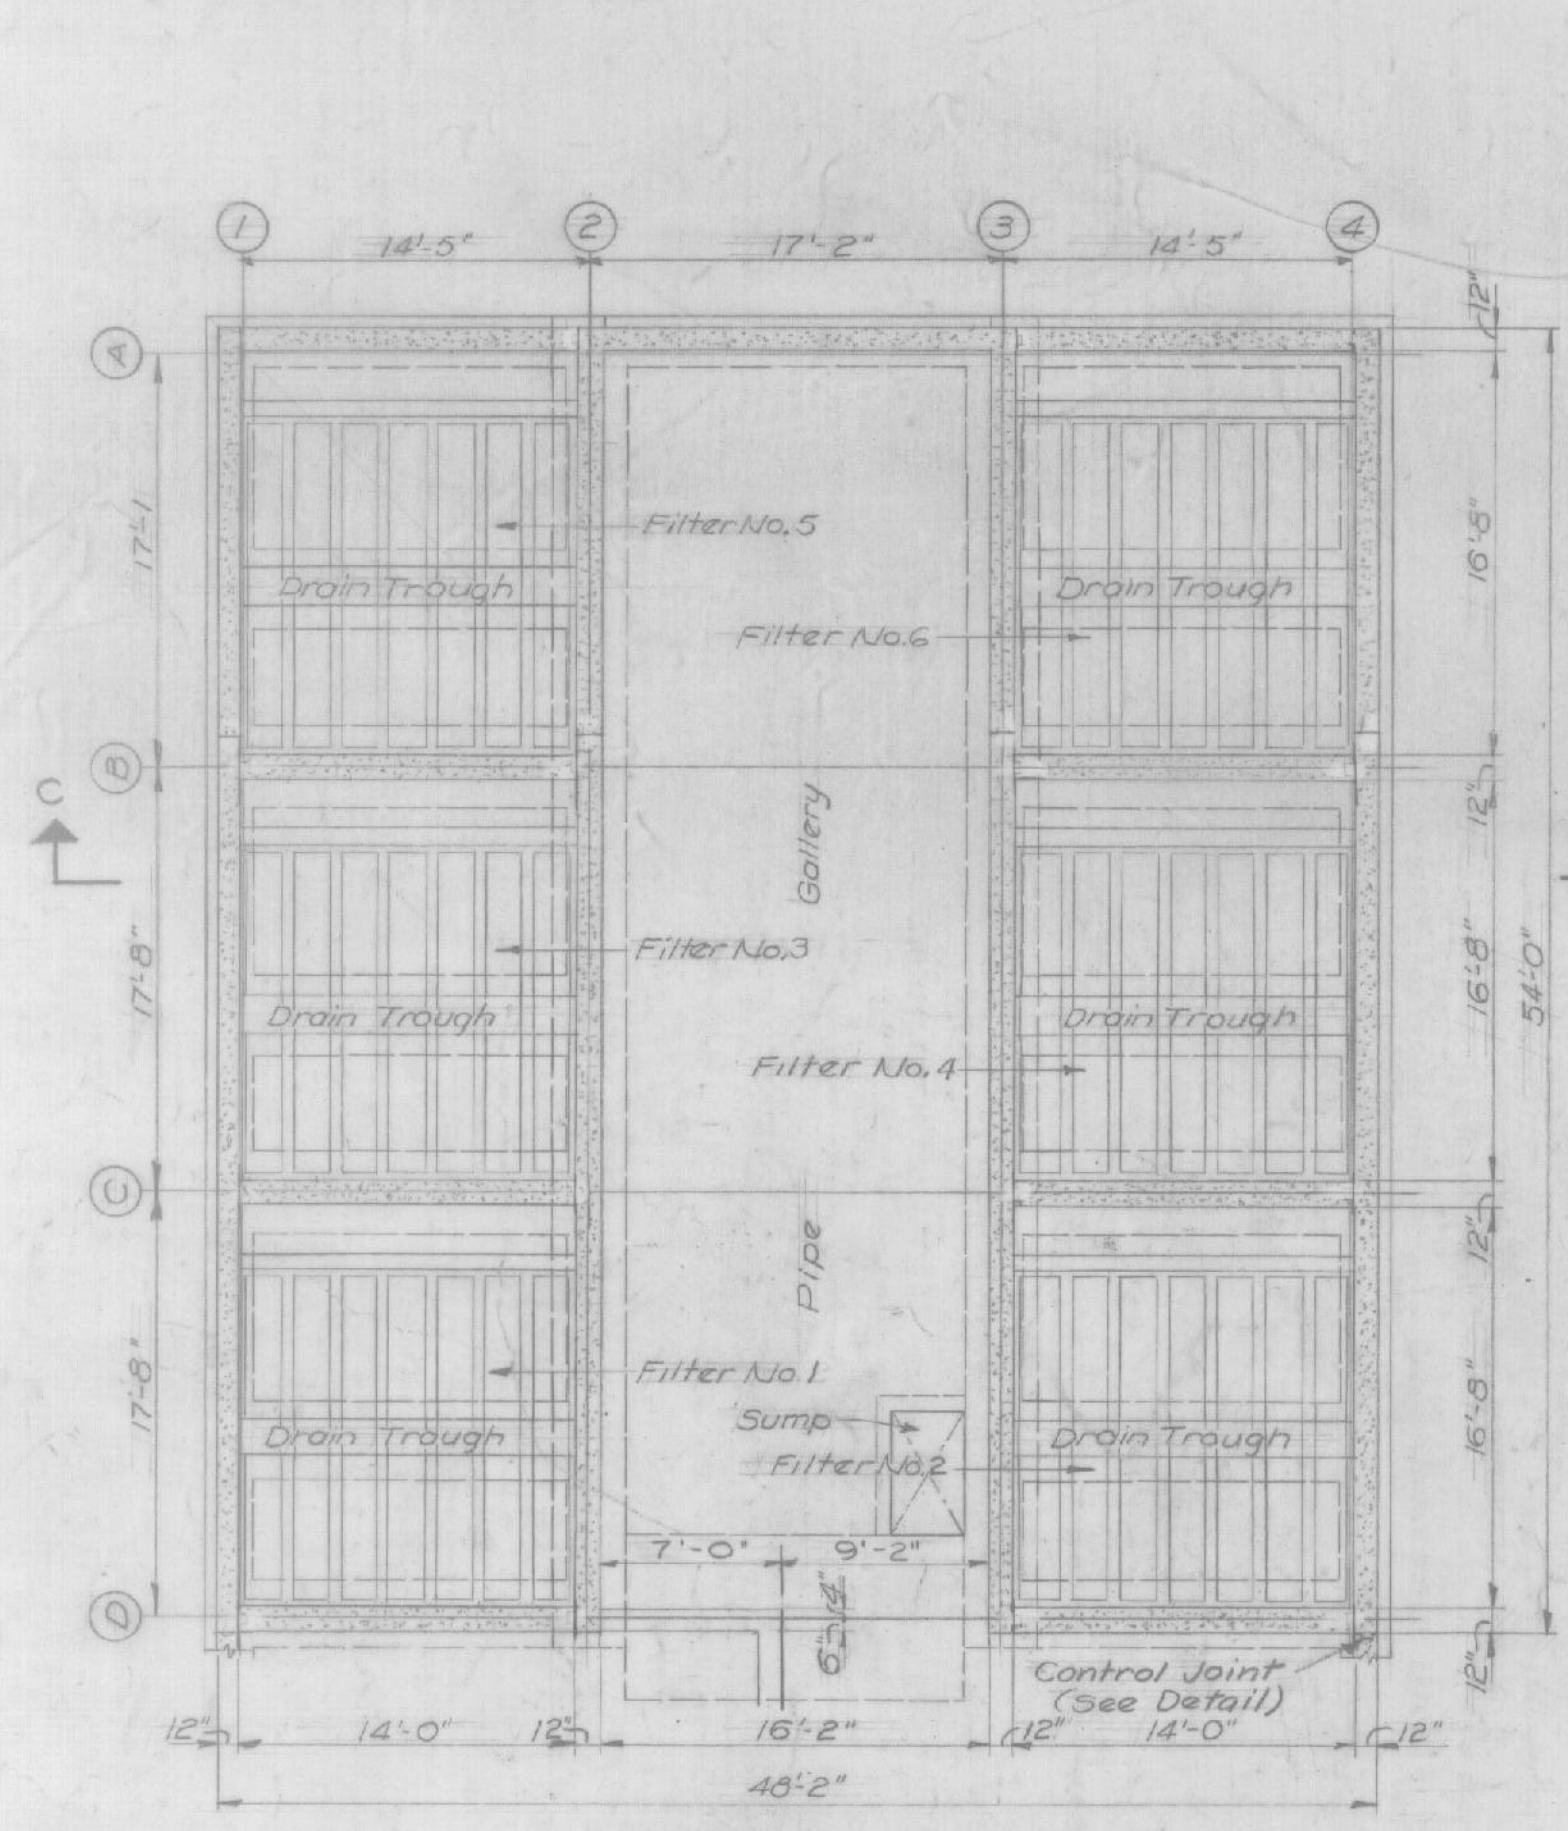

NOTES:
1. All keys in construction joints are deleted.
2. Reinforcing steel shall be depressed where required to avoid water stops.

Record Drawing
Contract No. DA-19-018-ENG-6199

REVISION	DATE	NOTES ADDED (ADD #3)	DESCRIPTION	BY	CHK
1	9-14-59	NOTES ADDED (ADD #3)			

WHITMAN & HOWARD, INC.
ENGINEERS
89 BROAD ST., BOSTON, MASS.






CORPS OF ENGINEERS, U. S. ARMY
OFFICE OF THE DIVISION ENGINEER
NEW ENGLAND DIVISION
WALTHAM, MASS.

PEASE AIR FORCE BASE
PORTSMOUTH, NEW HAMPSHIRE
SURFACE WATER SUPPLY
FILTER BUILDING
STRUCTURAL
FOUNDATION (FILTERS & GALLERY)

DRAWN BY: *Arthur Wilson*
TRACED BY:
CHECKED BY:
SUBMITTED: *Arthur Wilson*
APPROVED: *John W. Locke* CHIEF ENGINEERING DIVISION
APPROVED: *Raymond A. Siefert* COL. CH. DEPUTY DIVISION ENGINEER











DATE: JUNE, 1959

SCALE: AS NOTED SPEC. NO. 35010-1015-09-15
DRAWING NUMBER: AW71-05-31
SHEET 11

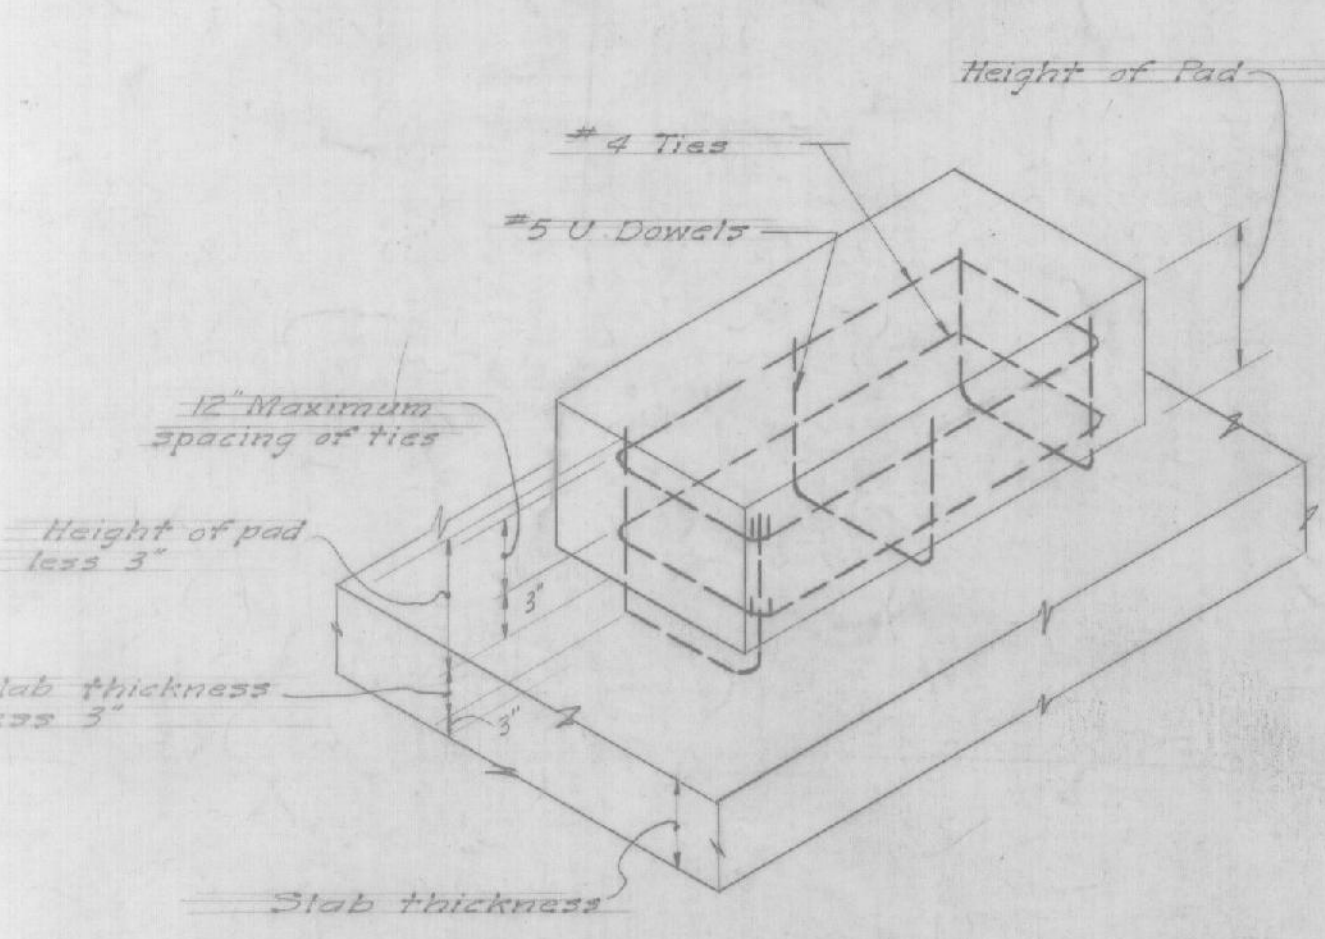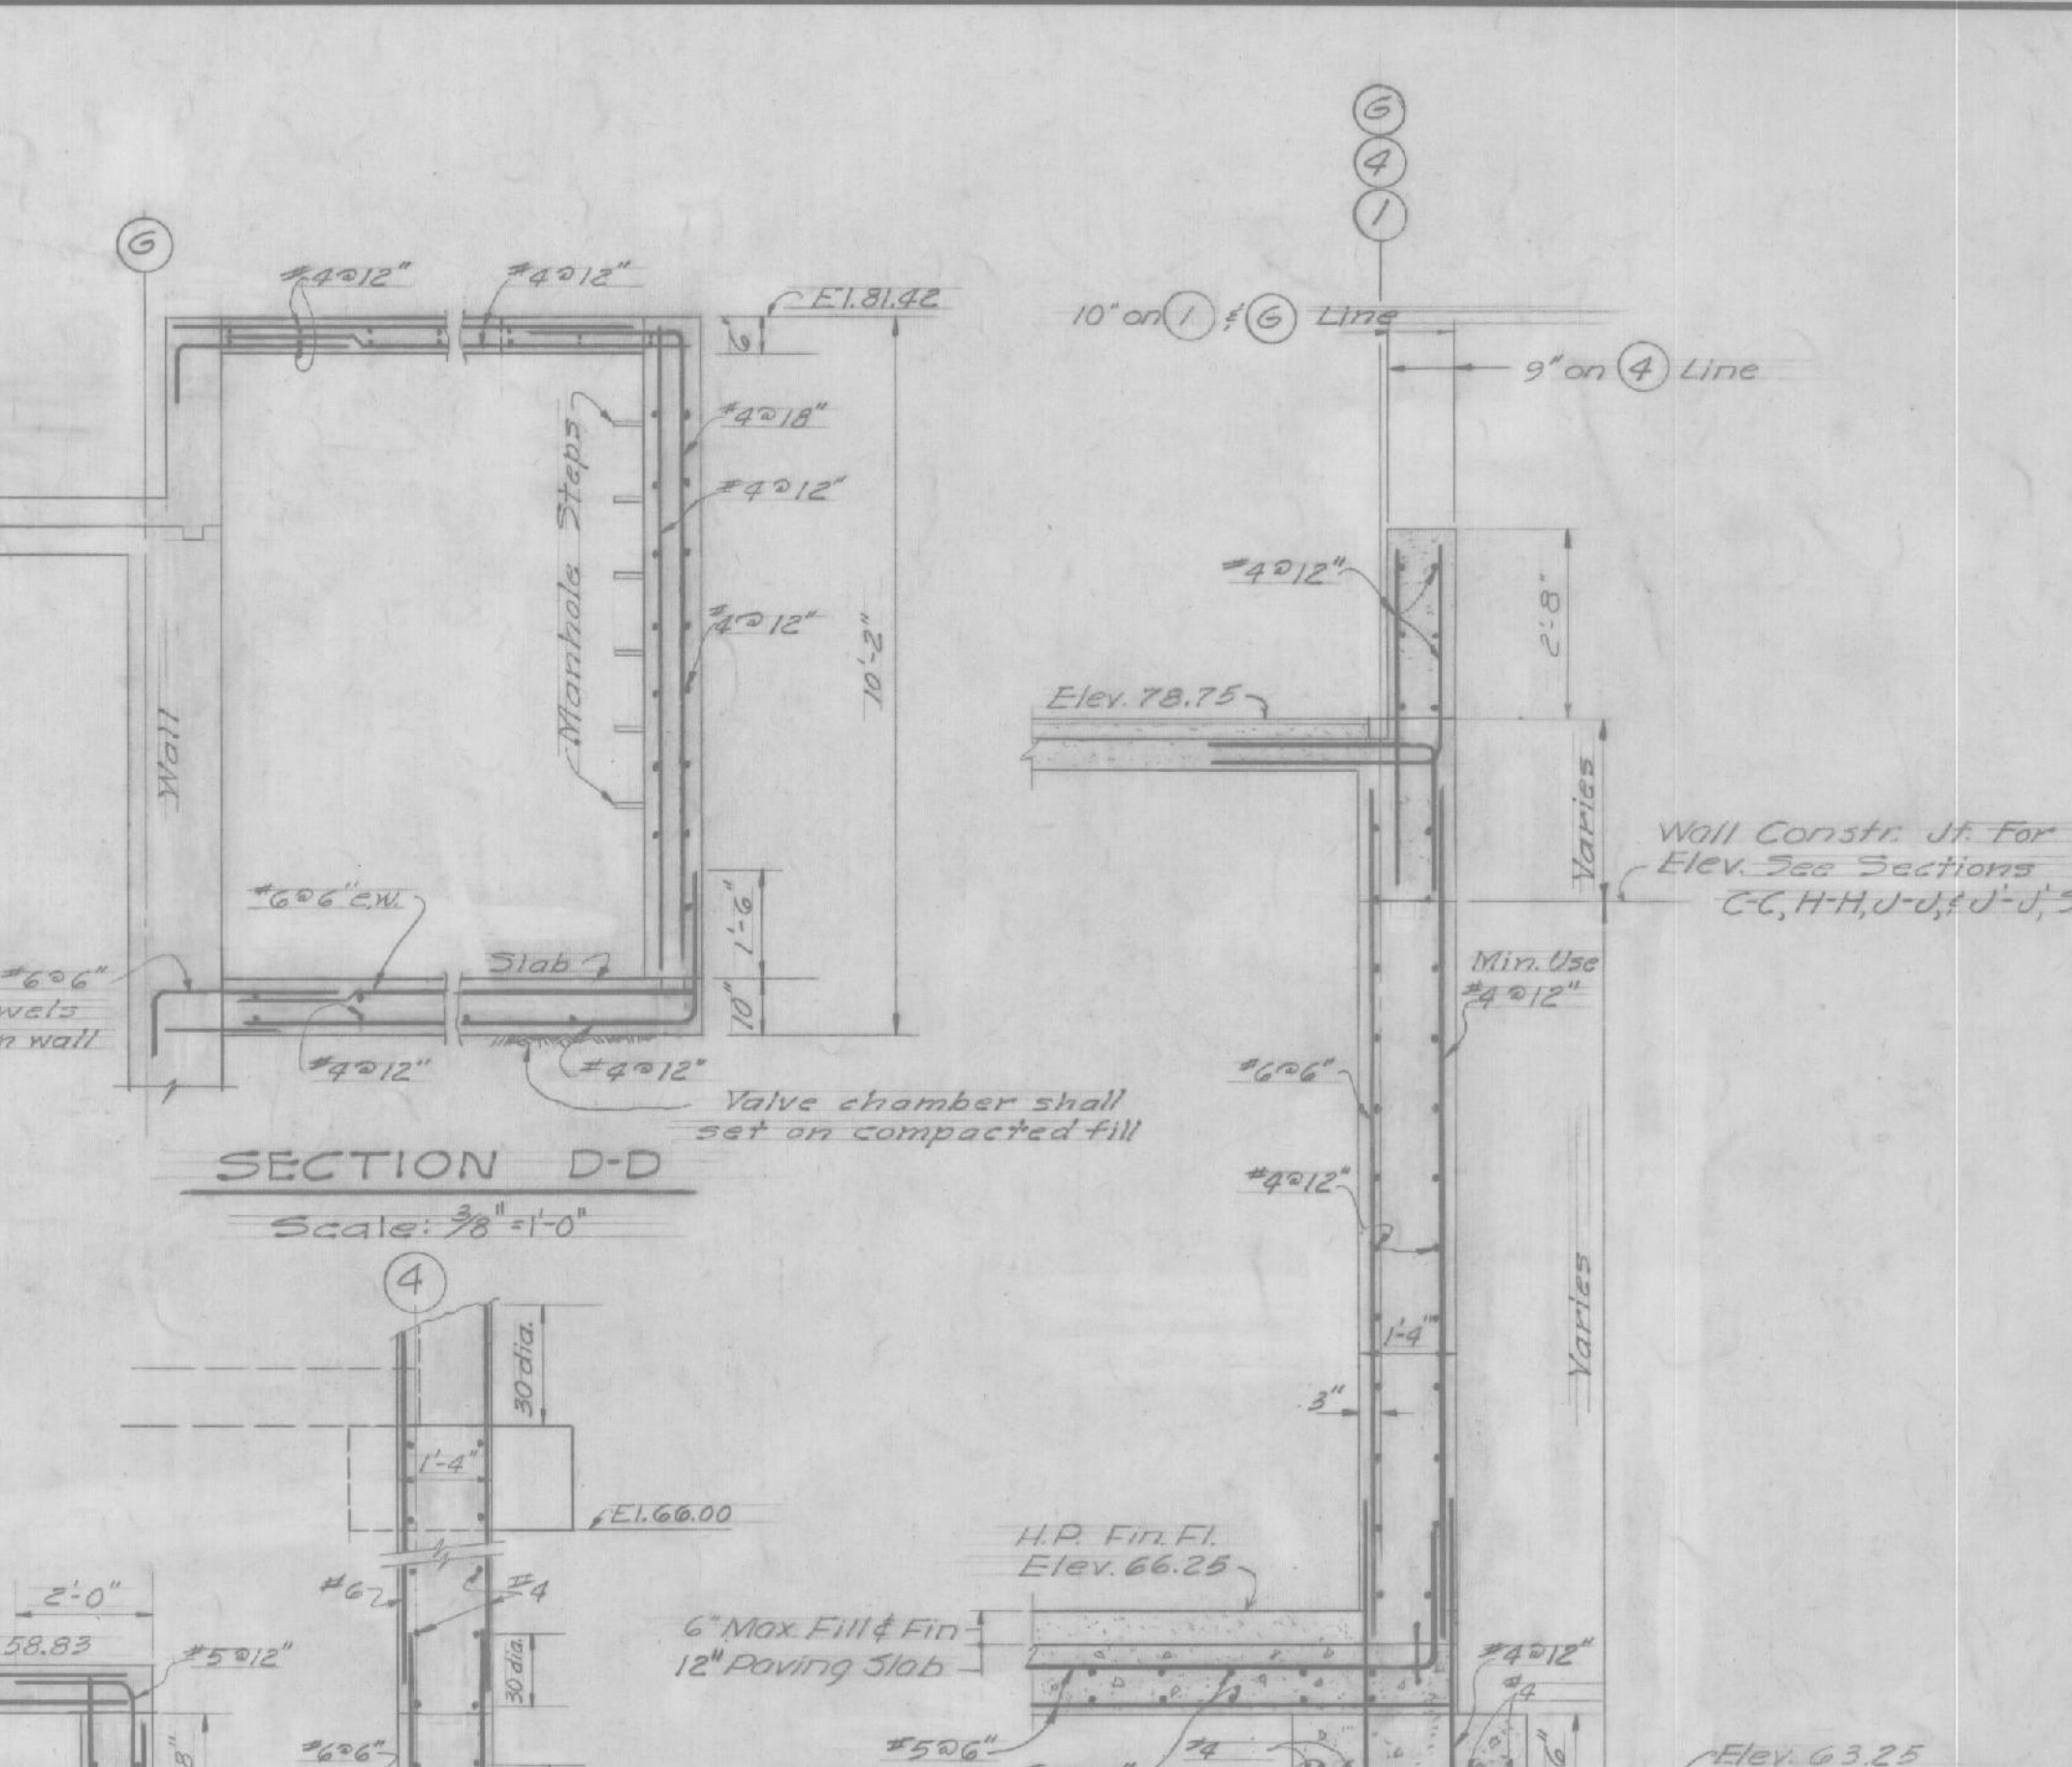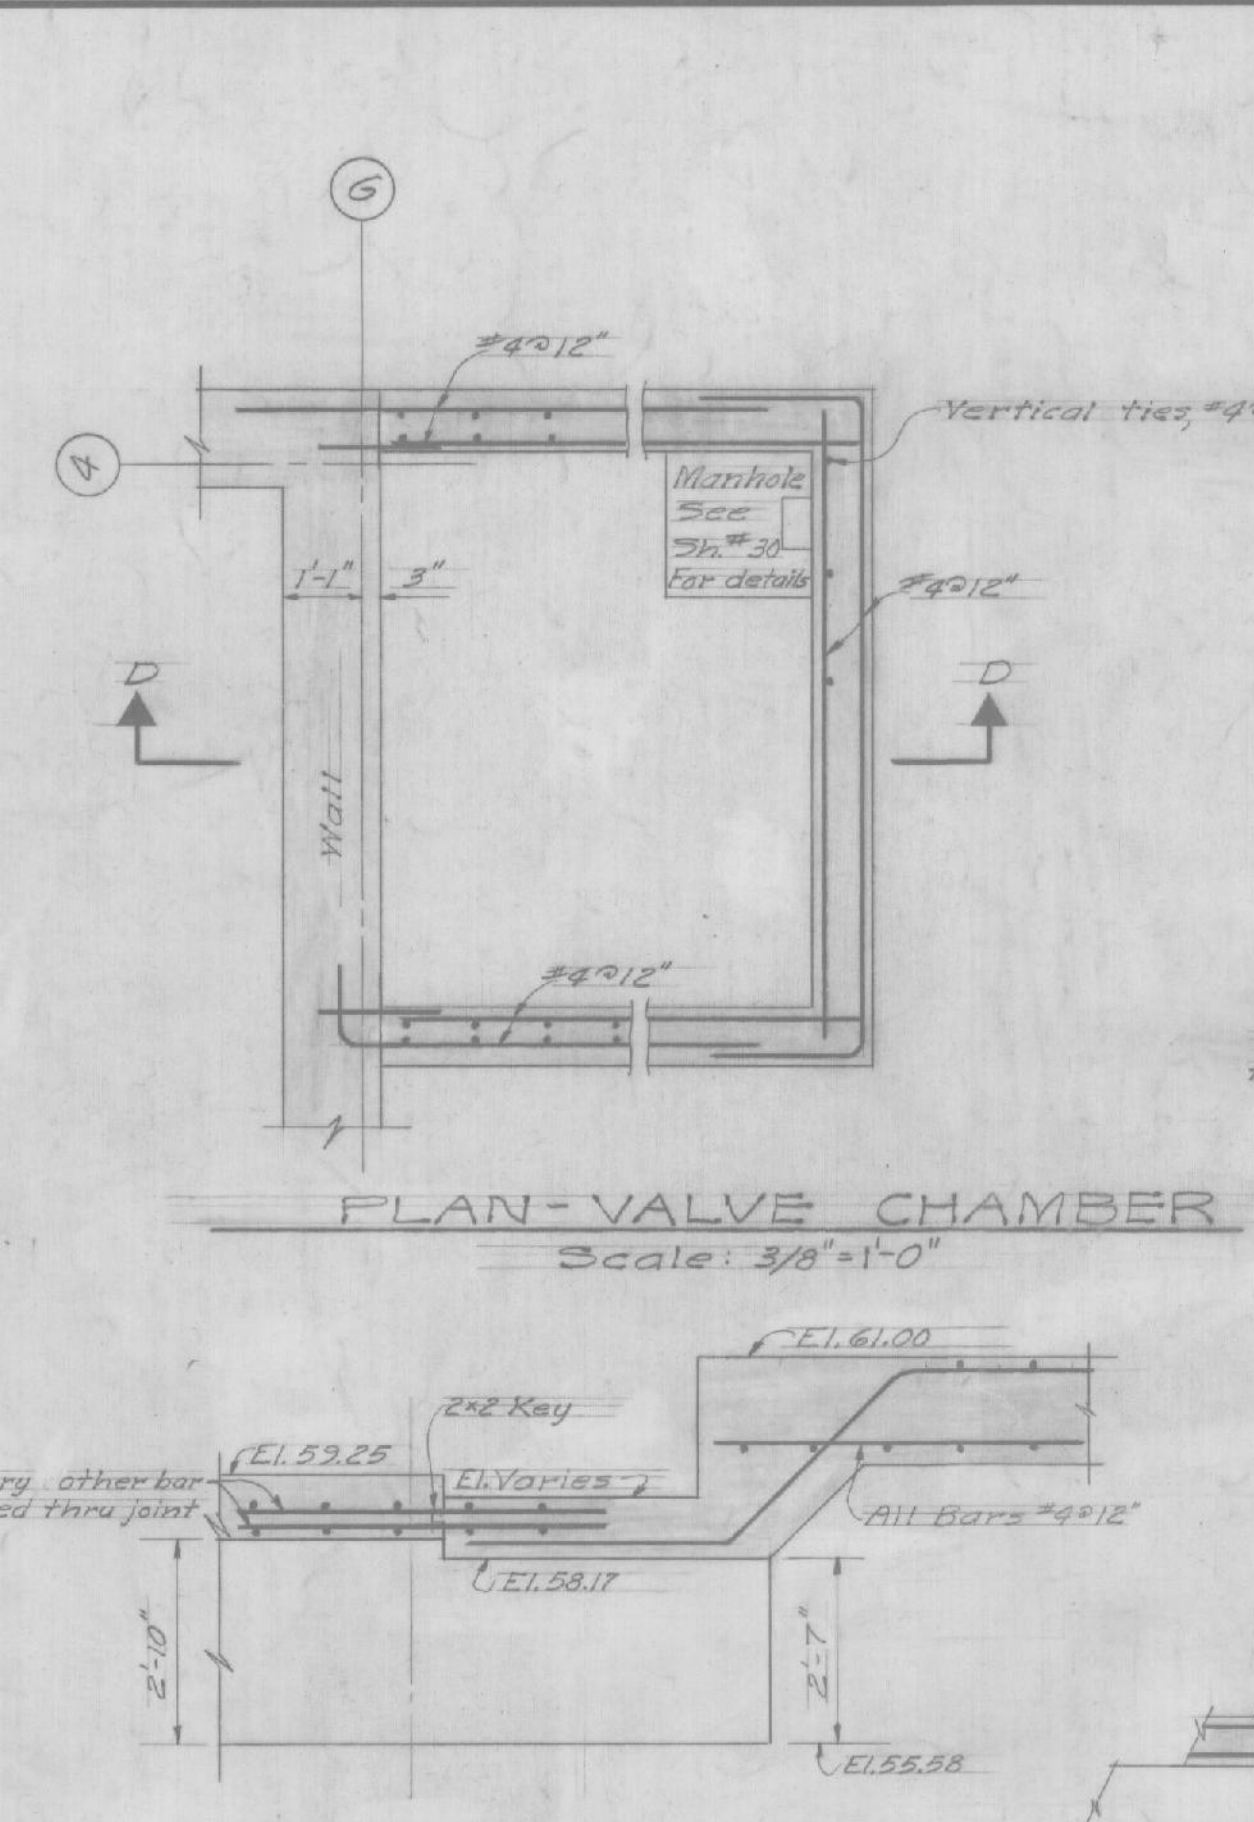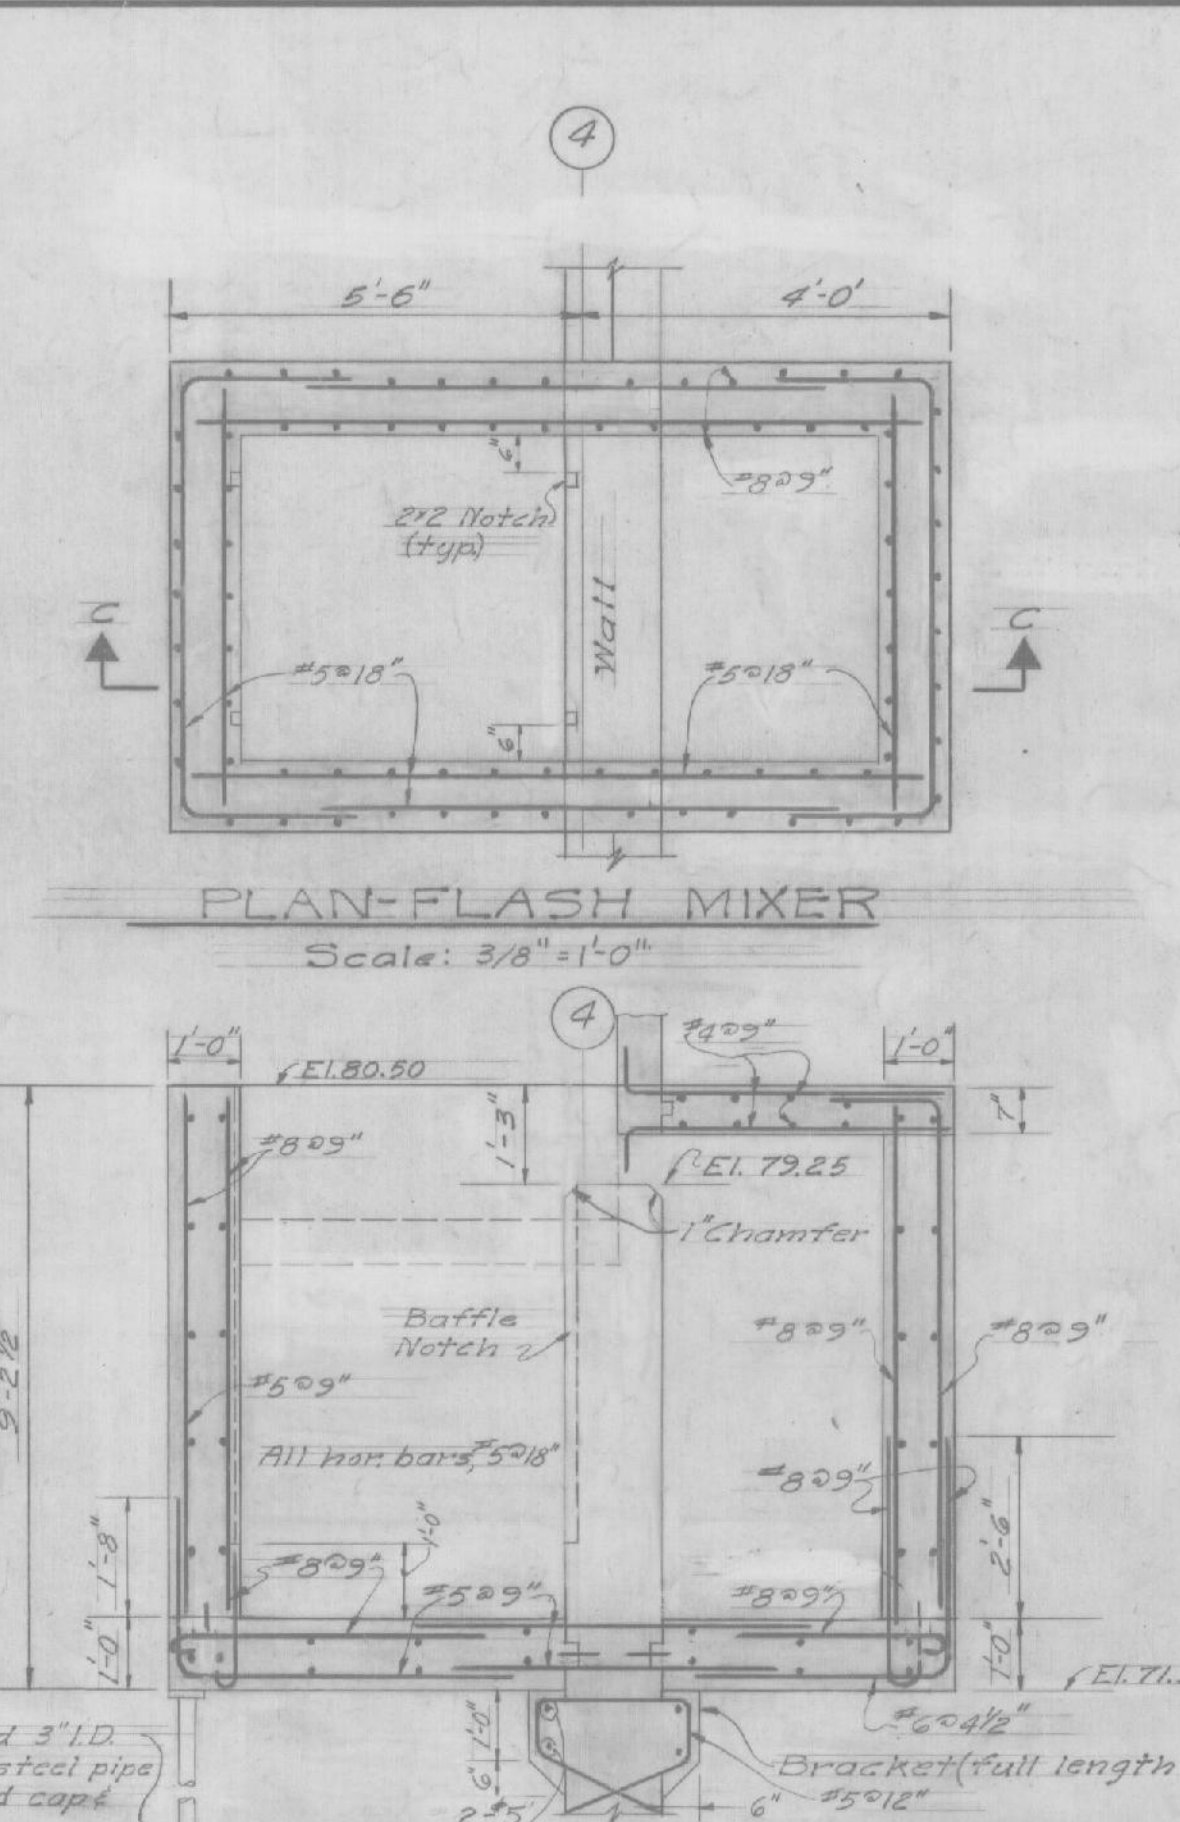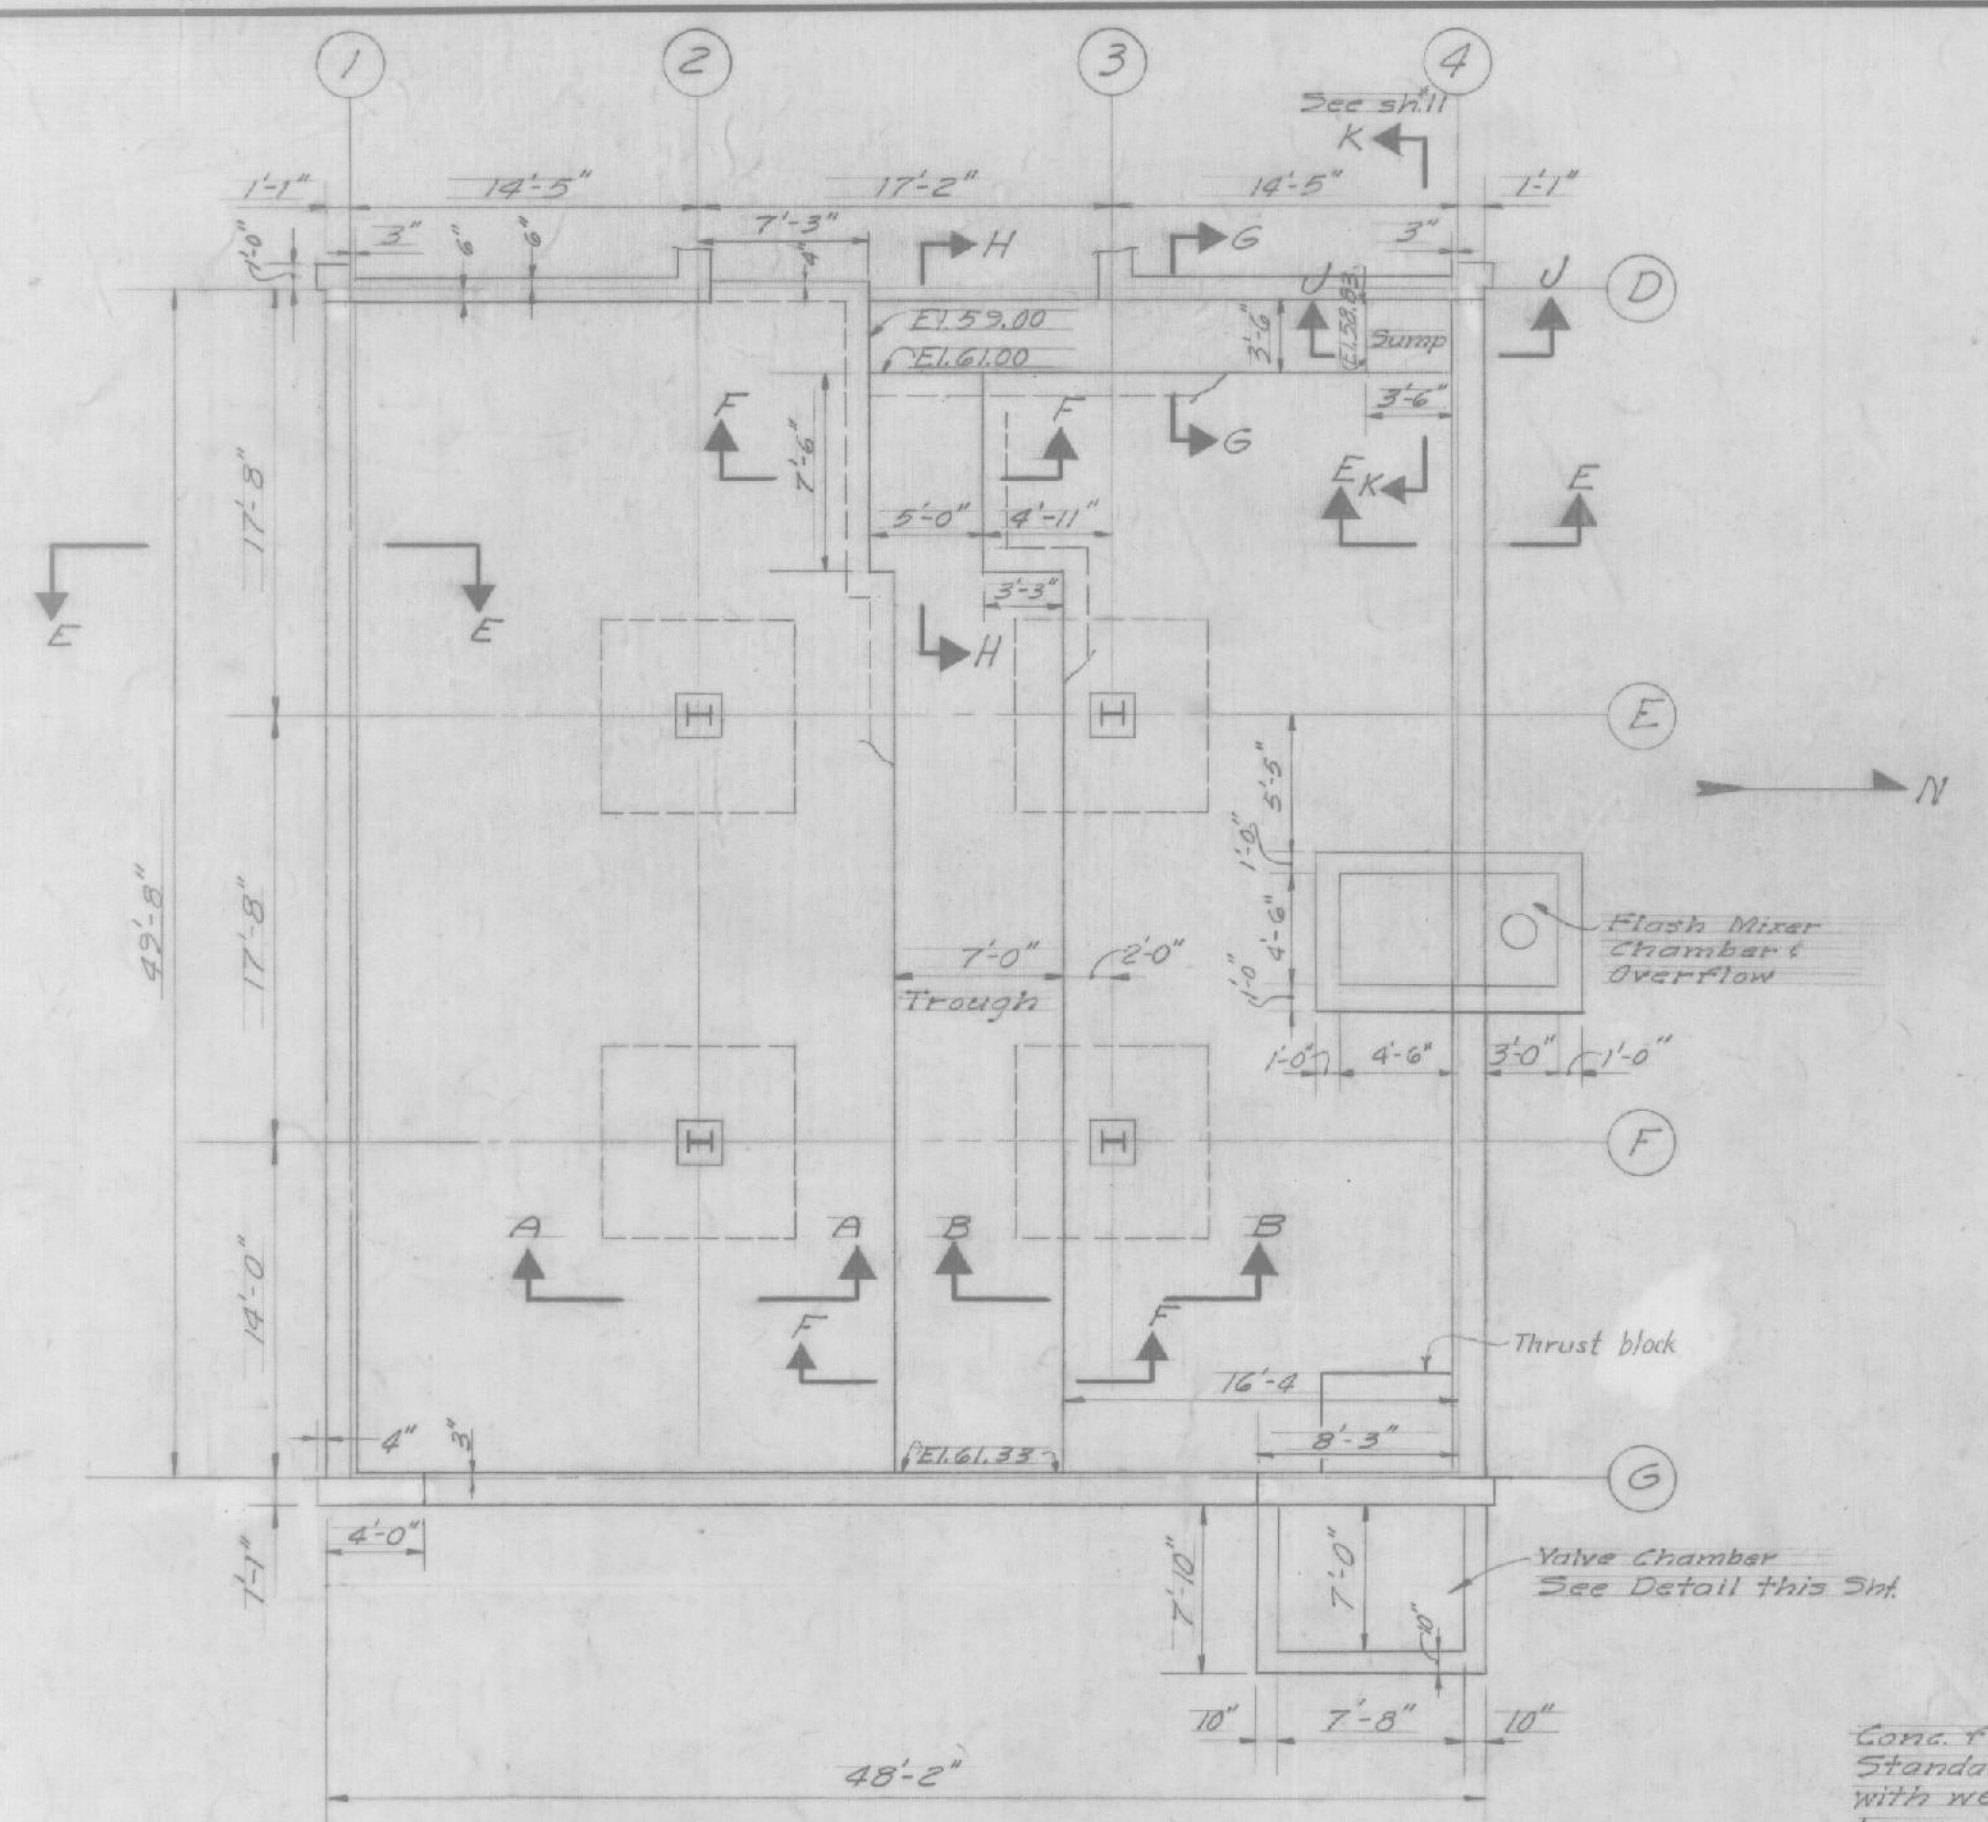

Concrete bases for piping shall be similar, with pipe shoe anchor bolts carried into 12" paving slab. Anchor bolts shall be of proper size to transfer thrust of piping to slab. Contractor shall submit calculations and details for approval.


MEMBER	EXPOSED TO			
	AIR SURFACE	AIR OVER LIQUID	BARTH LIQUIDS	SEA WATER
Bottoms of footings, foundation slabs, foundation beams	-	-	3	3
Walls, slabs, and piers	2	2	2	3
Beam, girders, and columns	1/2	2	2	3
Tops of bottoms of floor slabs	3/4	2	3	3
Tops of bottoms of roof slabs	3/4	2	2	-

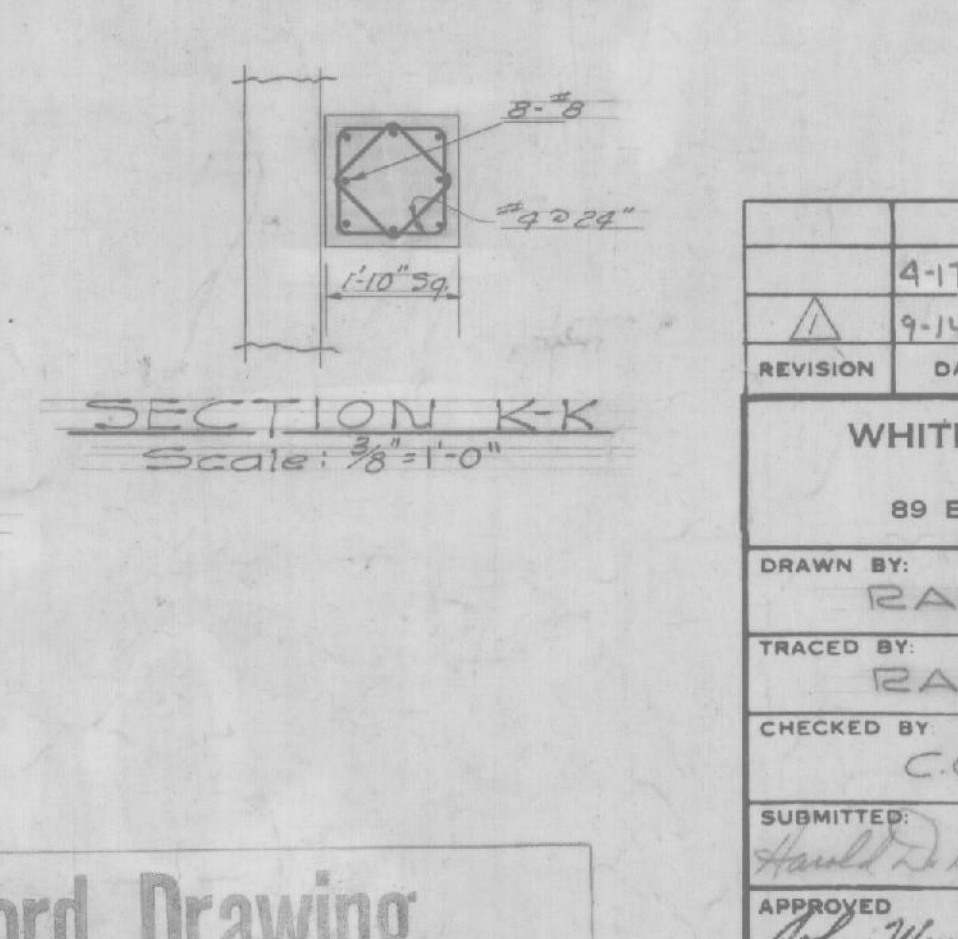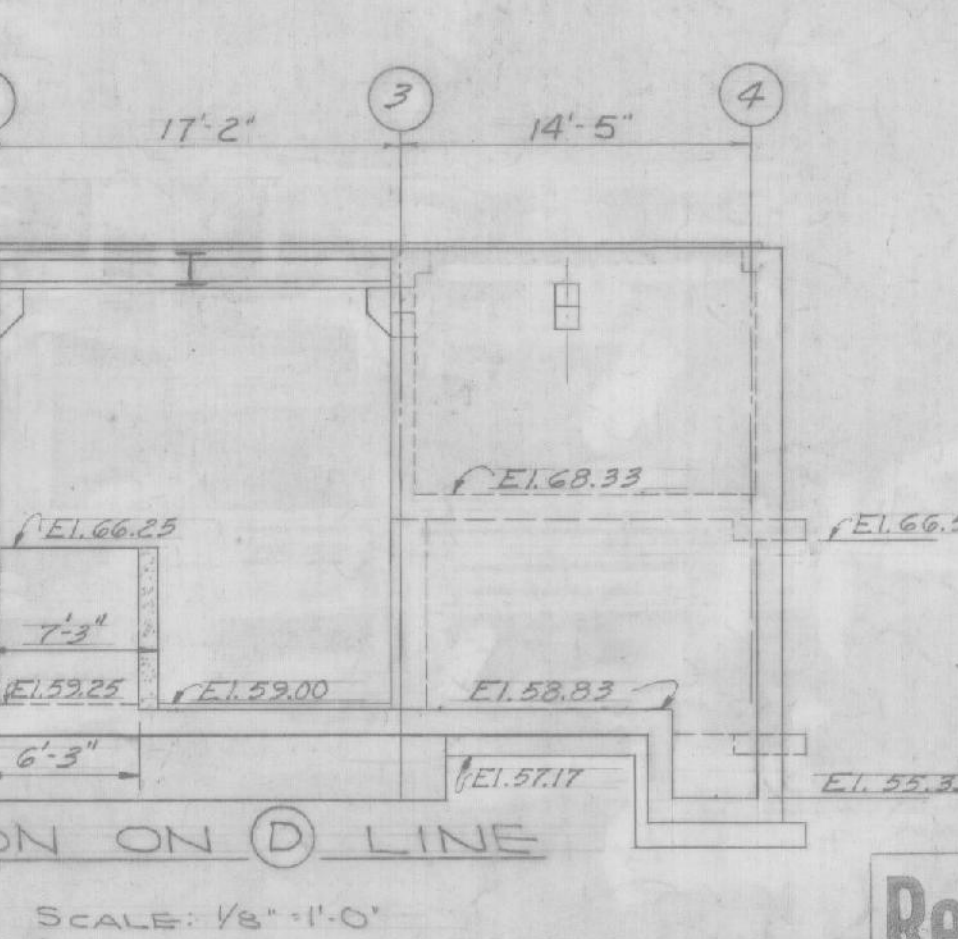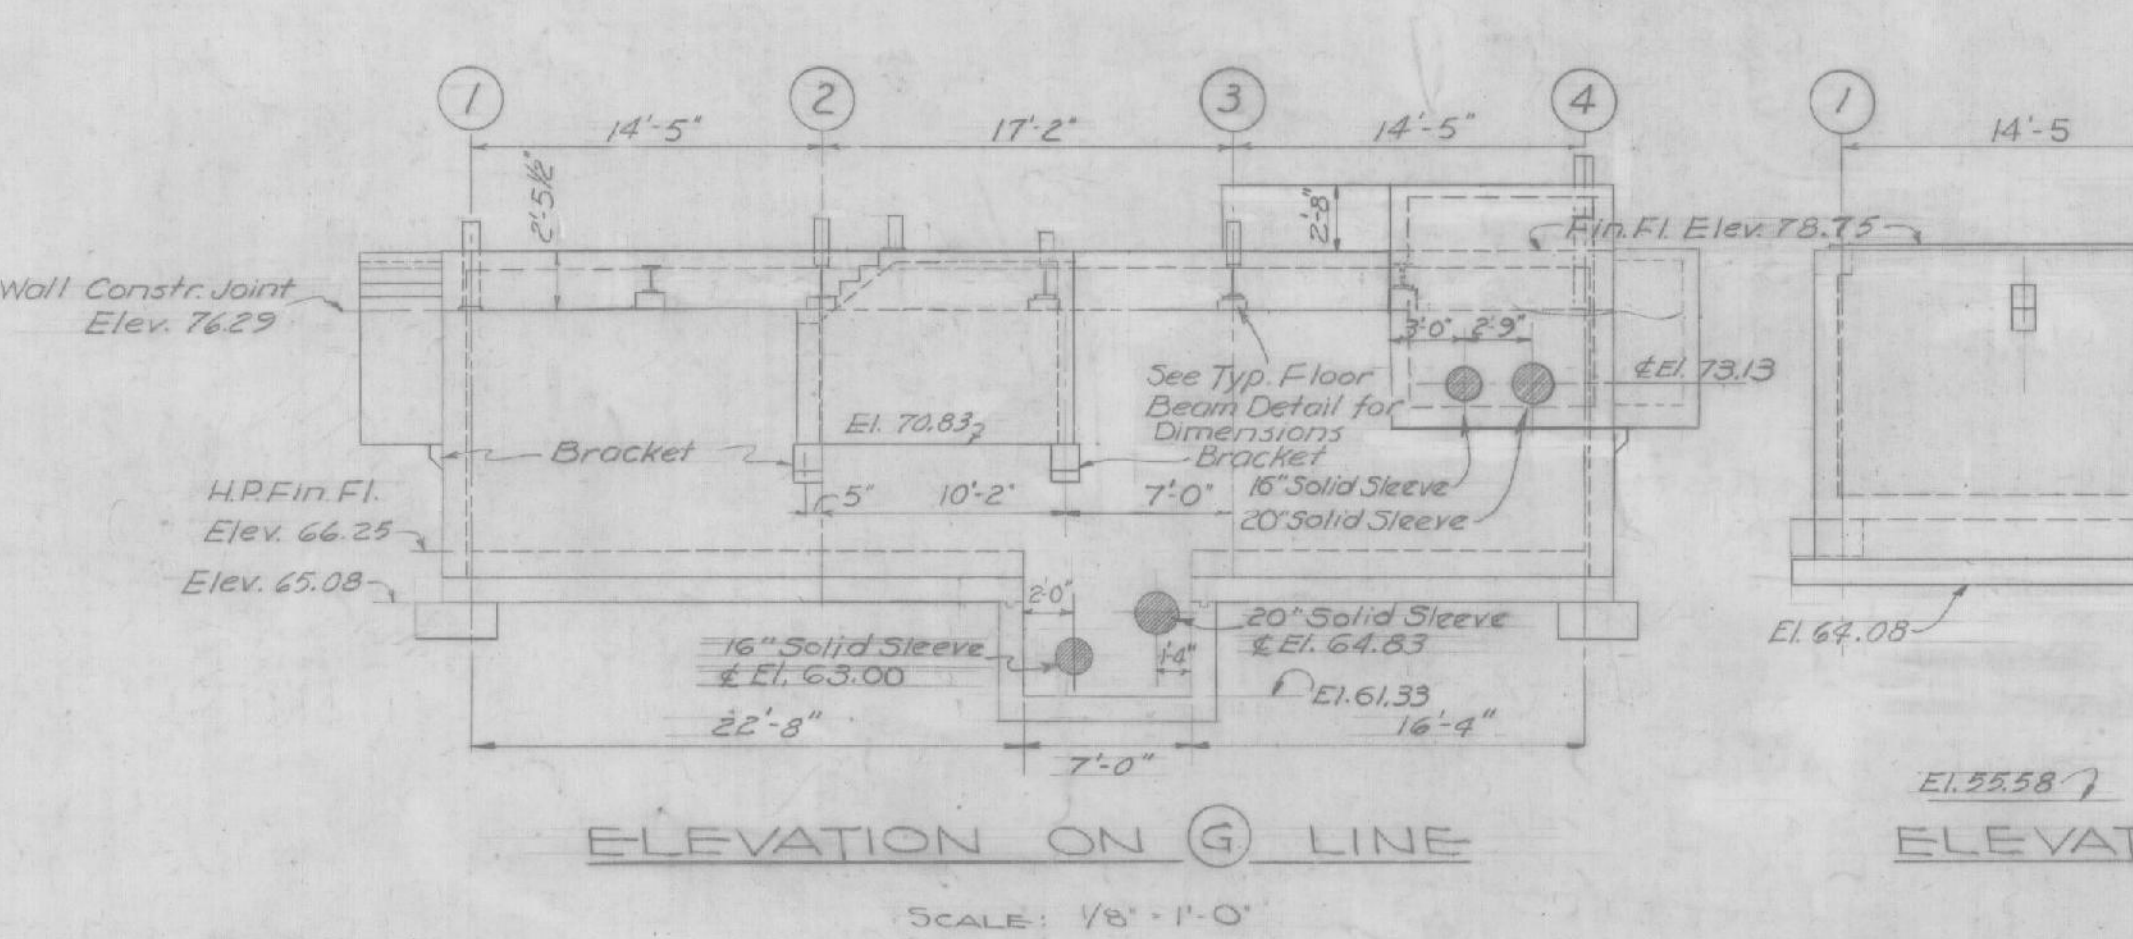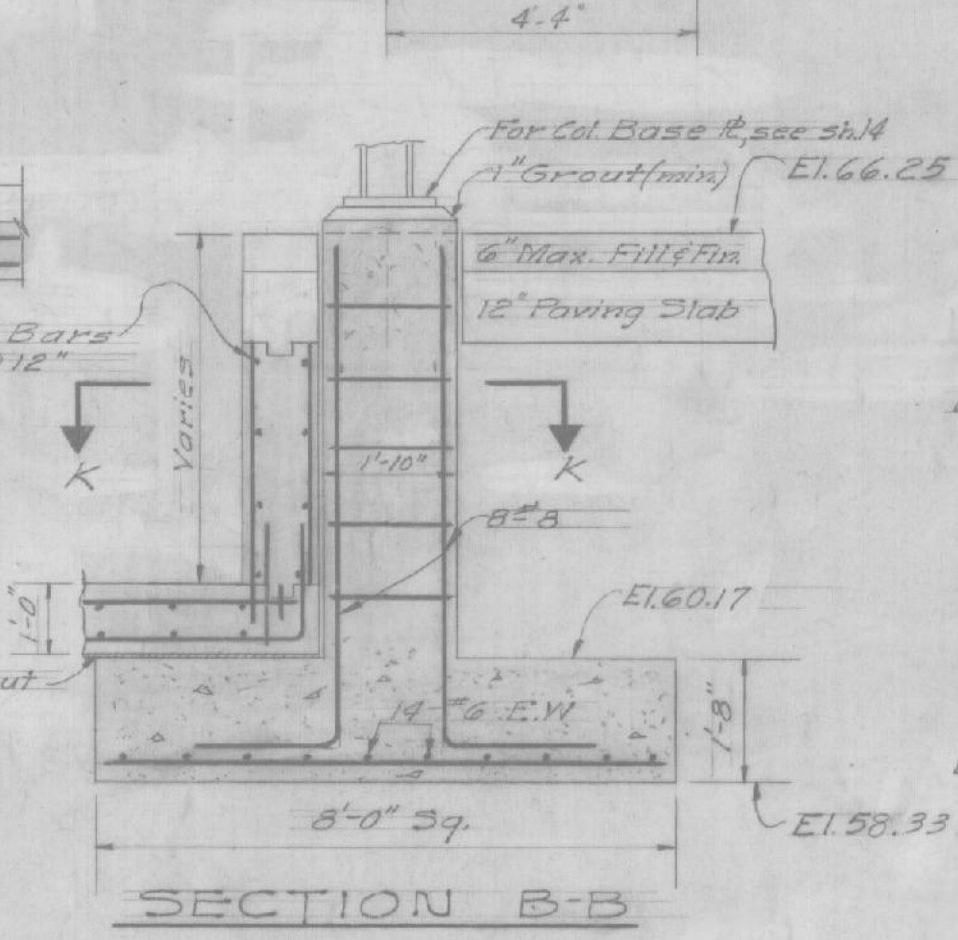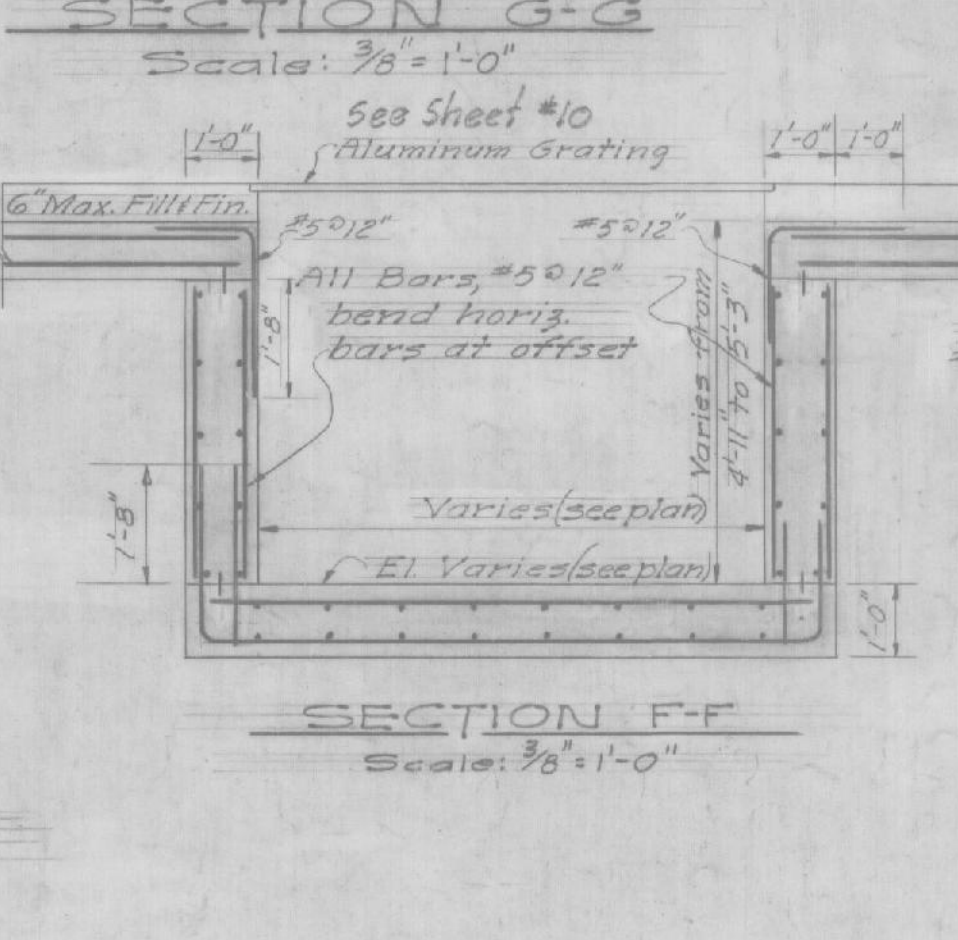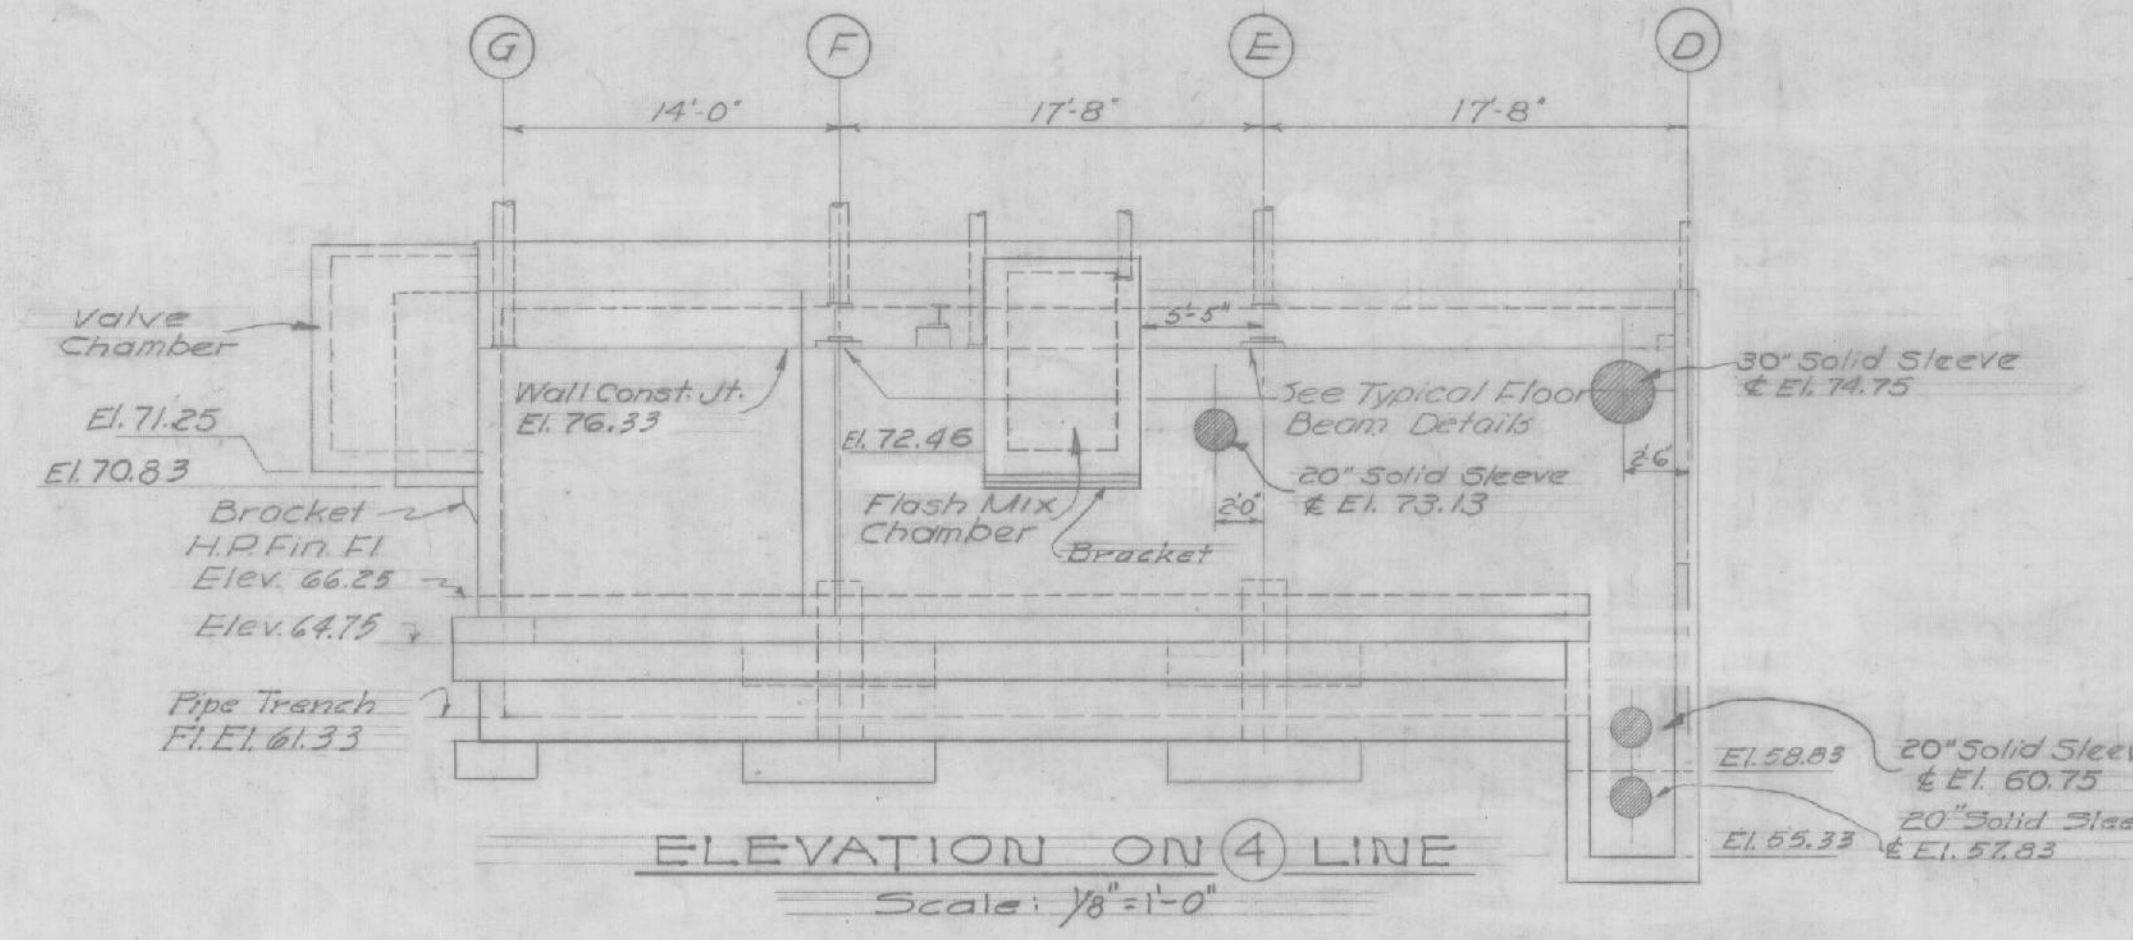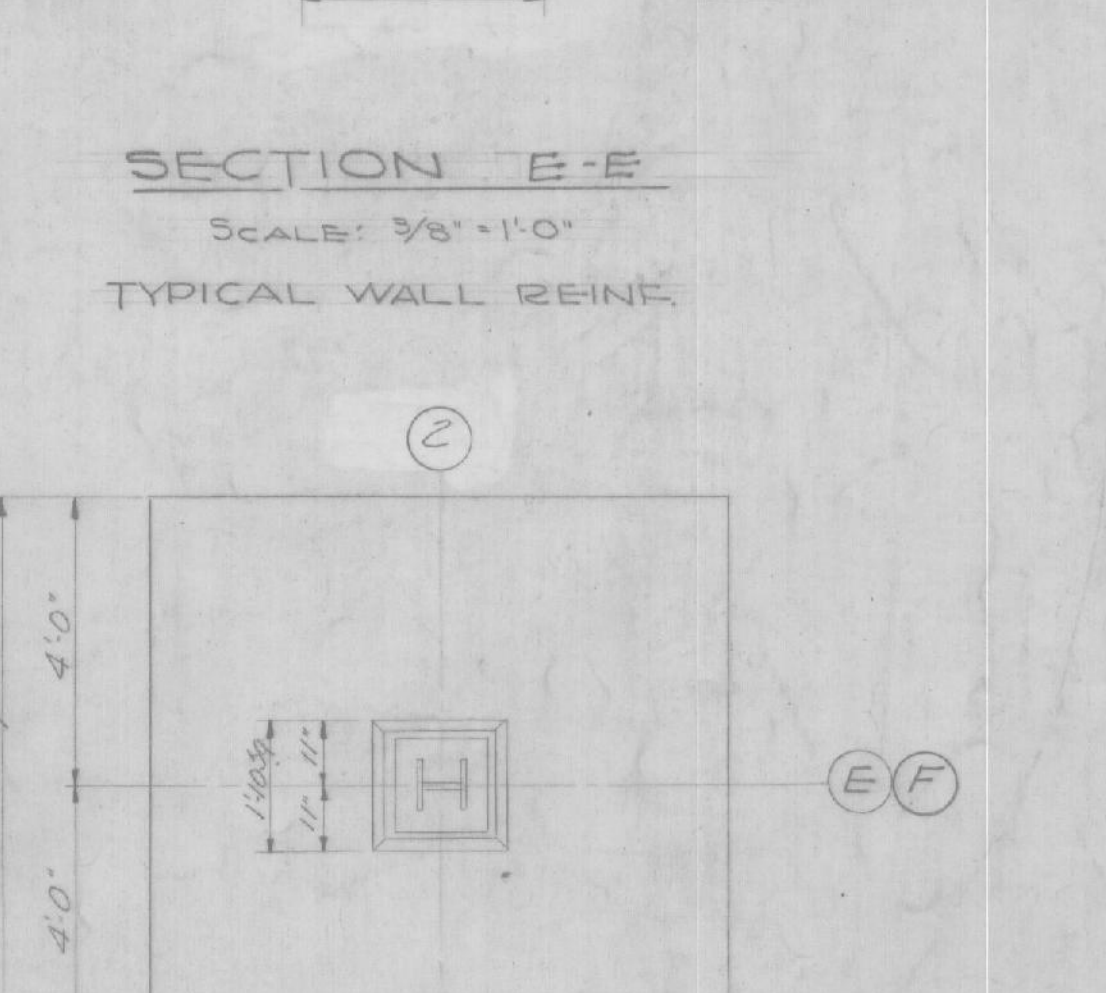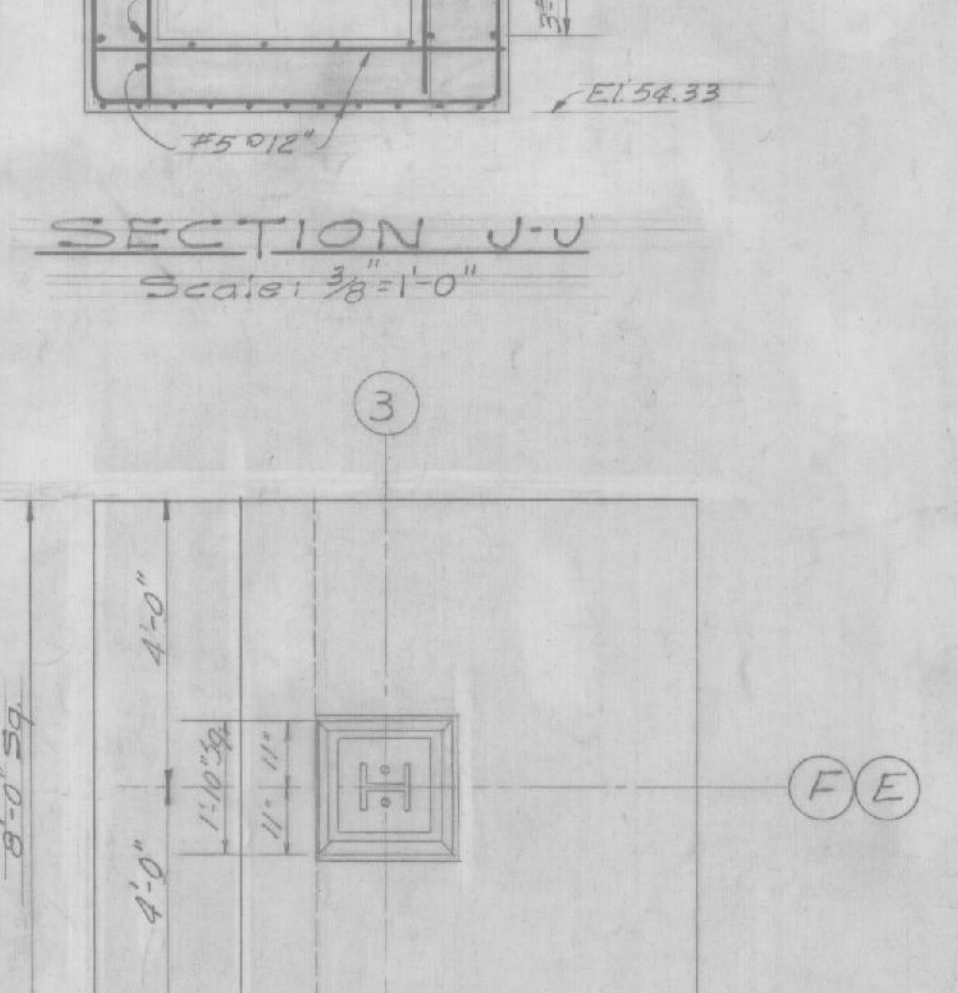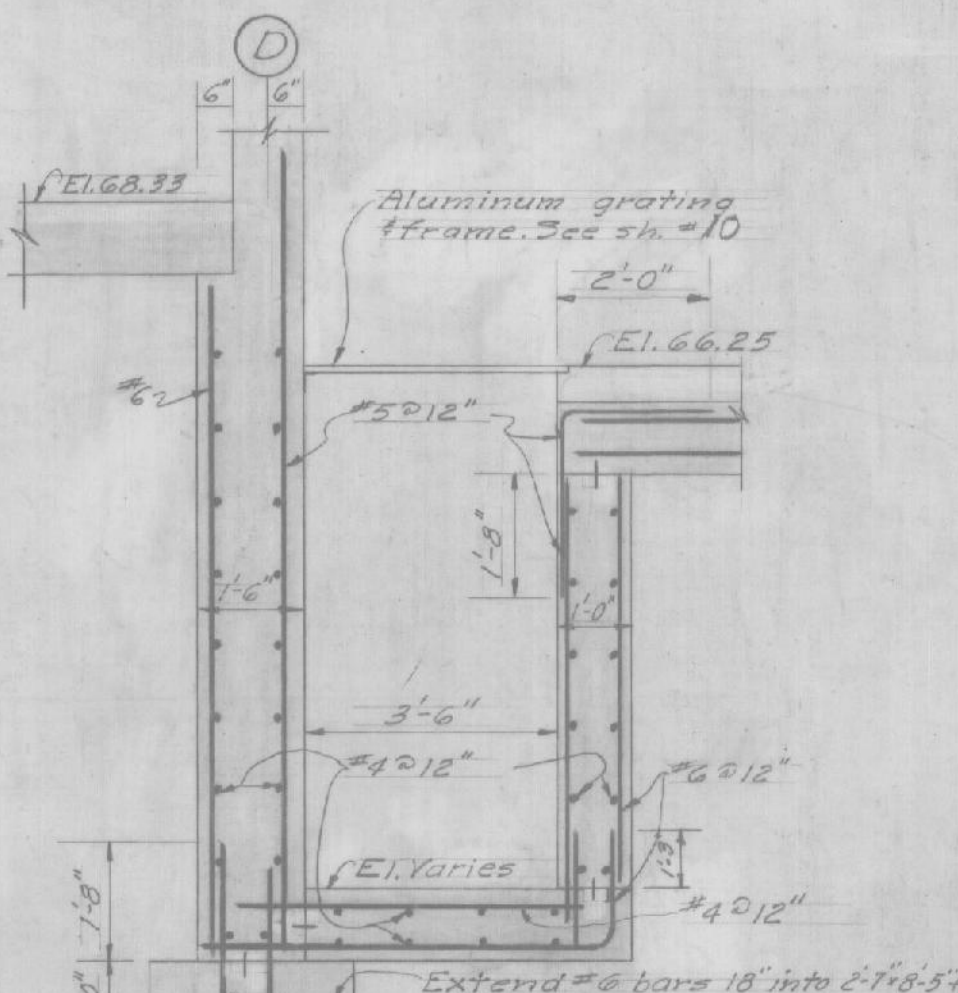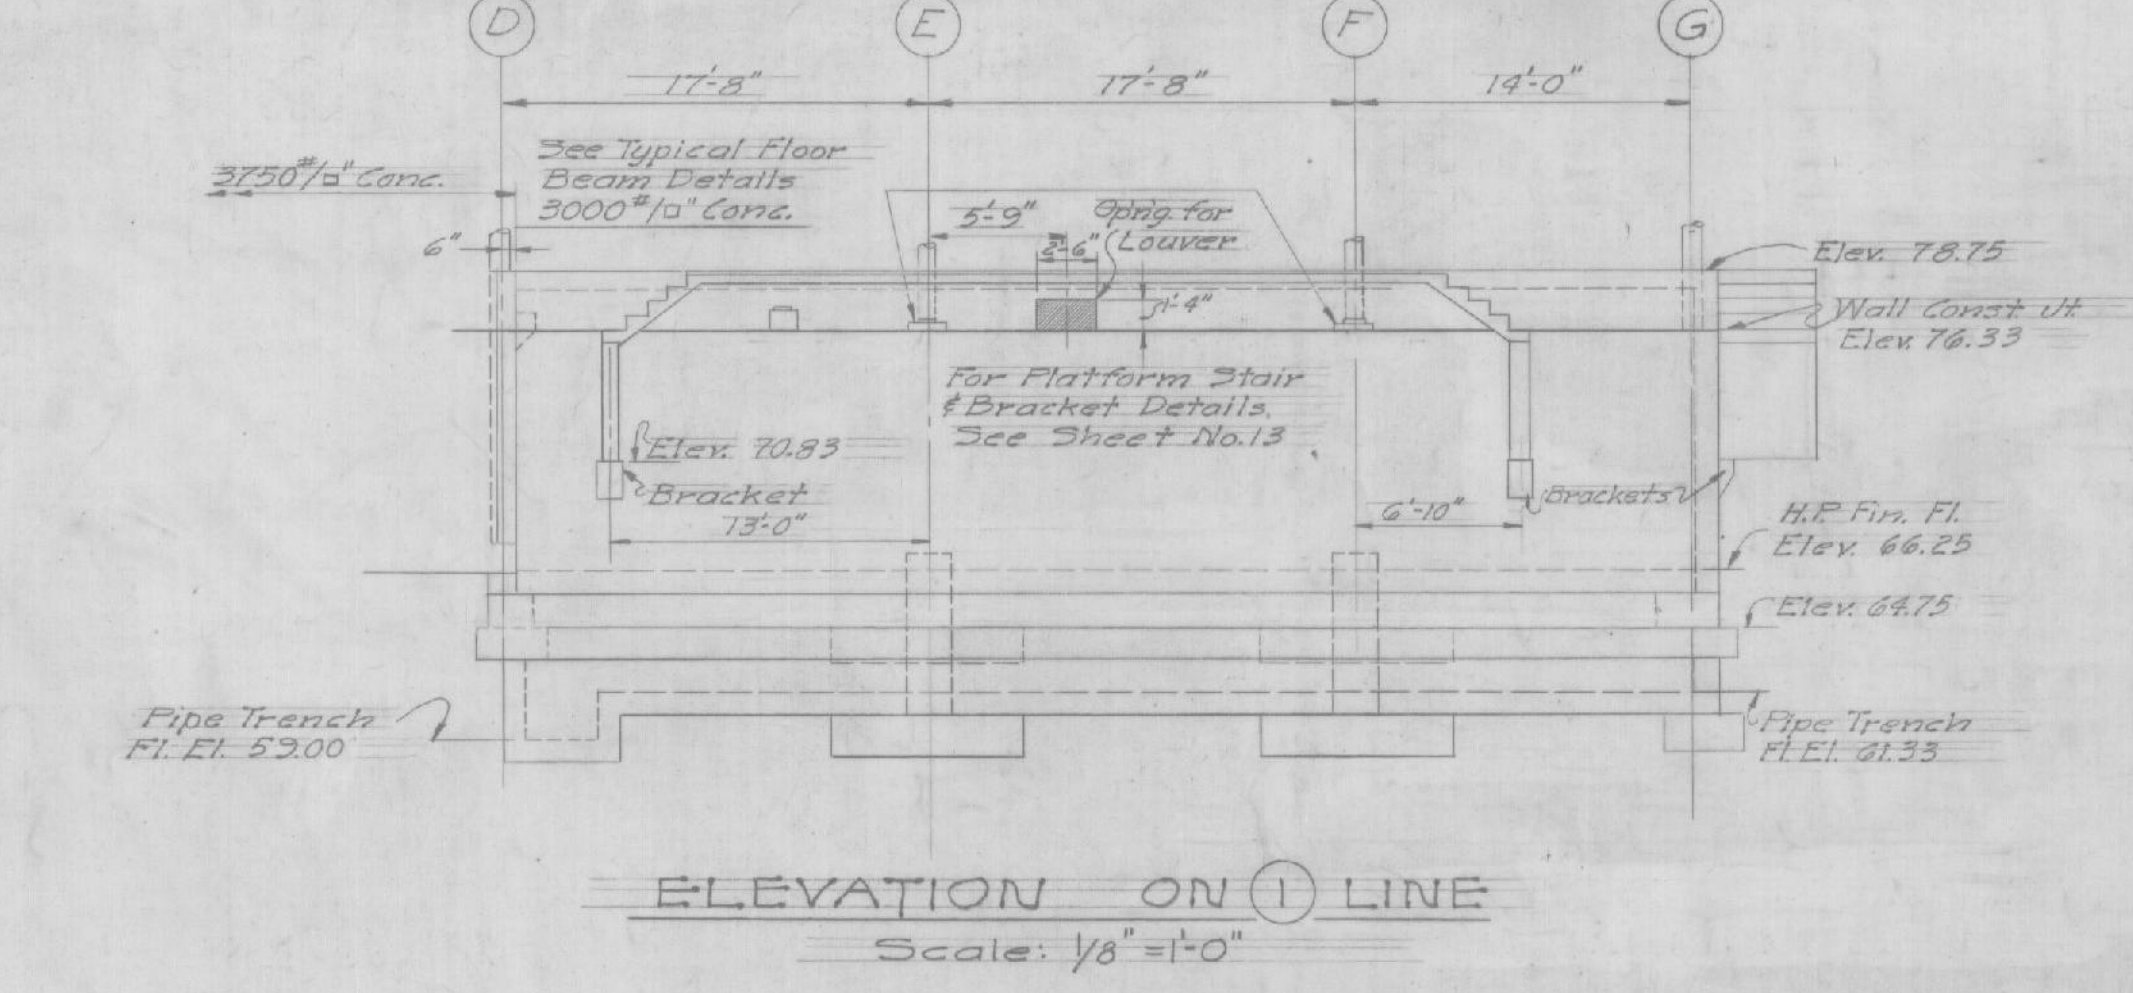


NOTES:
1. All keys in construction joints are deleted.
2. Reinforcing steel shall be depressed where required to avoid water stops.
3. On Layout Plan-Basement Floor and applicable sections for the 6"x7" troughs the aluminum grates shall be 2 1/4" x 3 1/4" in lieu of 1 1/4" x 2 1/4".

Record Drawing
Contract No. DA-19-016-ENG-6199


4-17-62	FINAL FIELD CORRECTIONS		
9-14-51	NOTES ADDED (ADD #3)		09/14/51
REVISION	DATE	DESCRIPTION	
WHITMAN & HOWARD, INC. ENGINEERS 89 BROAD ST., BOSTON, MASS.		CORPS OF ENGINEERS, U. S. ARMY OFFICE OF THE DIVISION ENGINEER NEW ENGLAND DIVISION WALTHAM, MASS.	
DRAWN BY: E.A.R.	PEASE AIR FORCE BASE PORTSMOUTH, NEW HAMPSHIRE SURFACE WATER SUPPLY FILTER BUILDING STRUCTURAL FOUNDATION & CONTROL BUILDING		
TRACED BY: E.A.R.			
CHECKED BY: C.G.M.			
SUBMITTED: <i>Howard S. Howard</i>			
APPROVED: <i>James W. Wallace</i>	APPROVED: <i>Howard S. Howard</i>	DATE	JUNE-1959
CHIEF ENGINEERING DIVISION	COL. C.A. DEPUTY	DIVISION ENGINEER	
SCALE AS NOTED	SPEC. NO.	116-59-123	
DRAWING NUMBER		AW71-05-31	
SHEET 12			

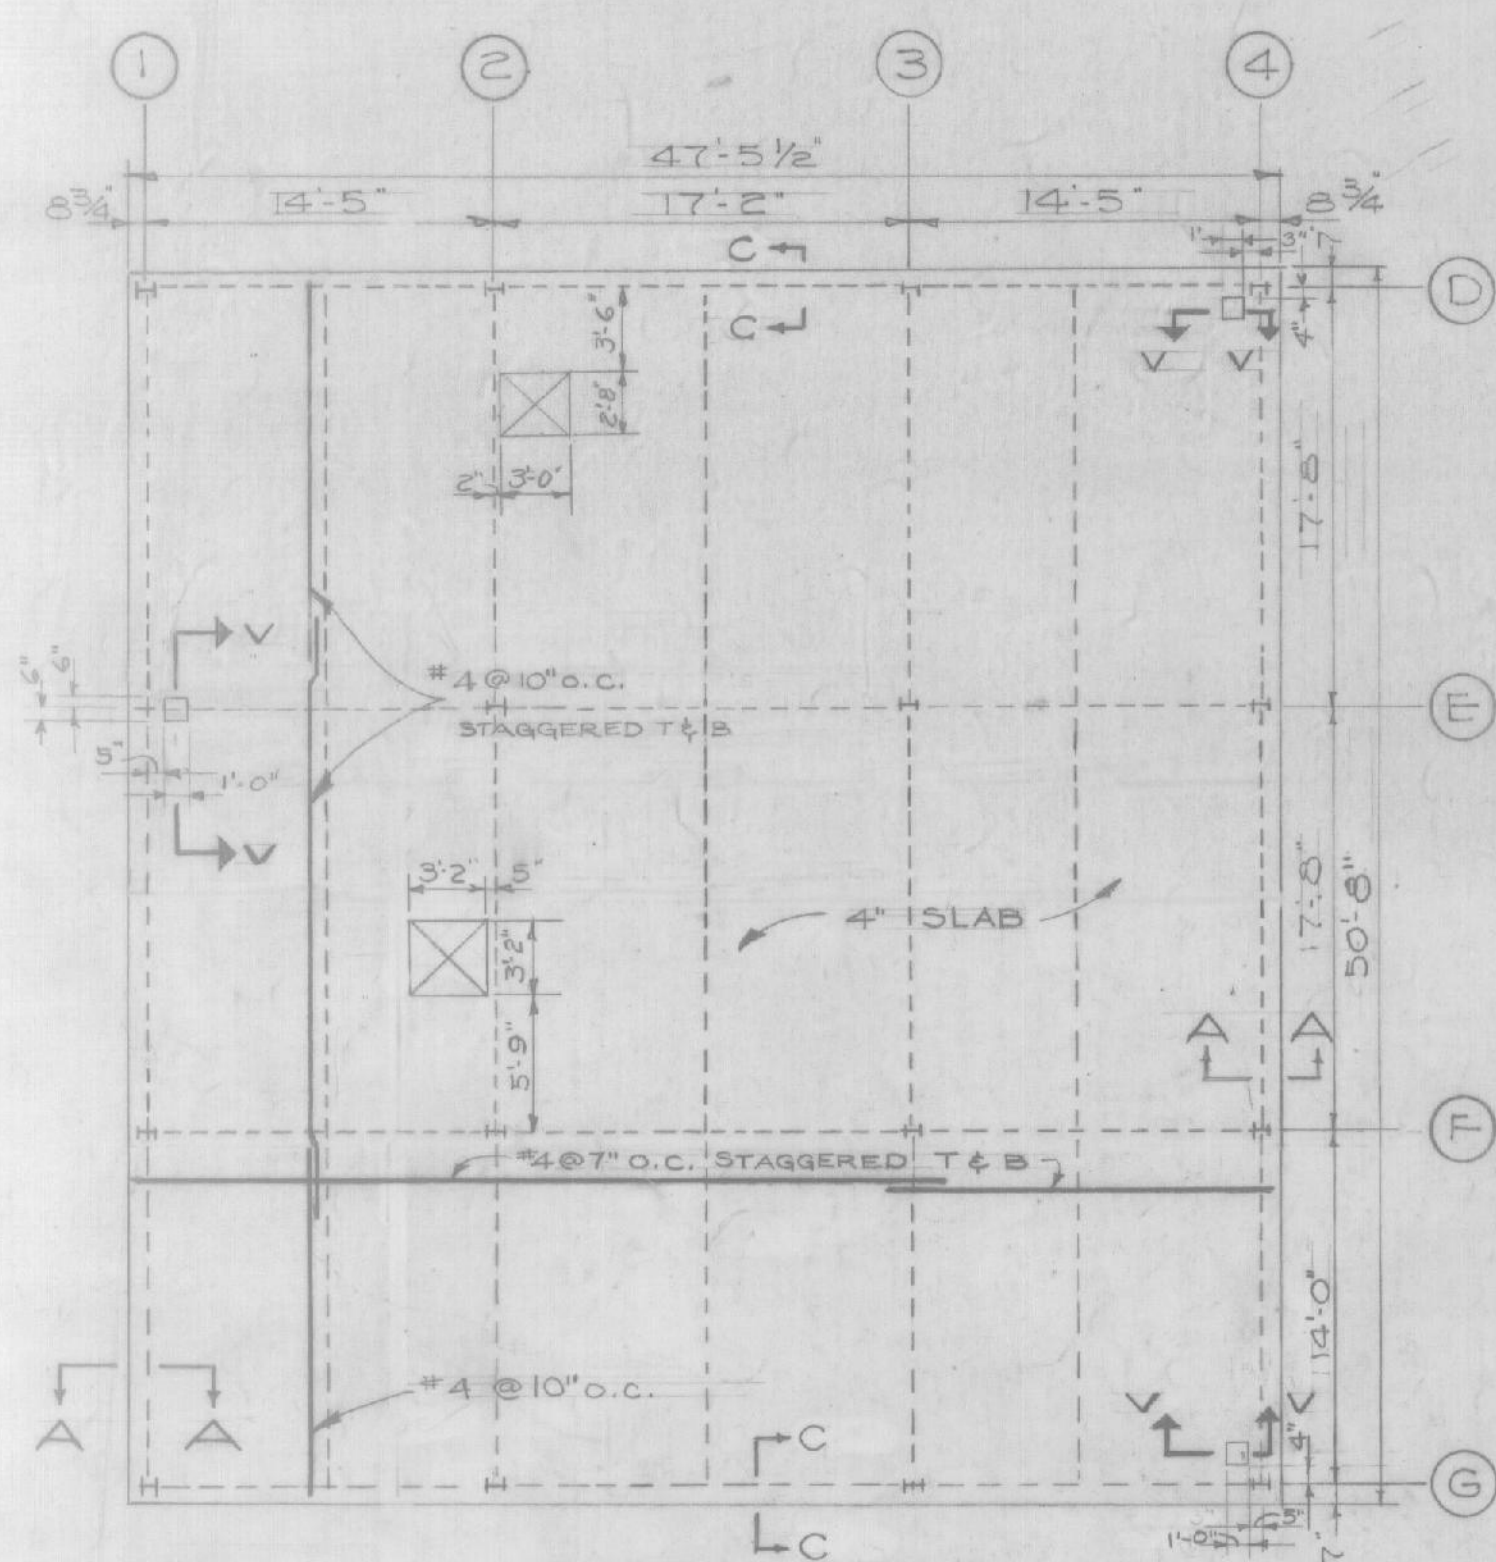


HIGH ROOF SLAB
SCALE: 1/8"=1'-0"

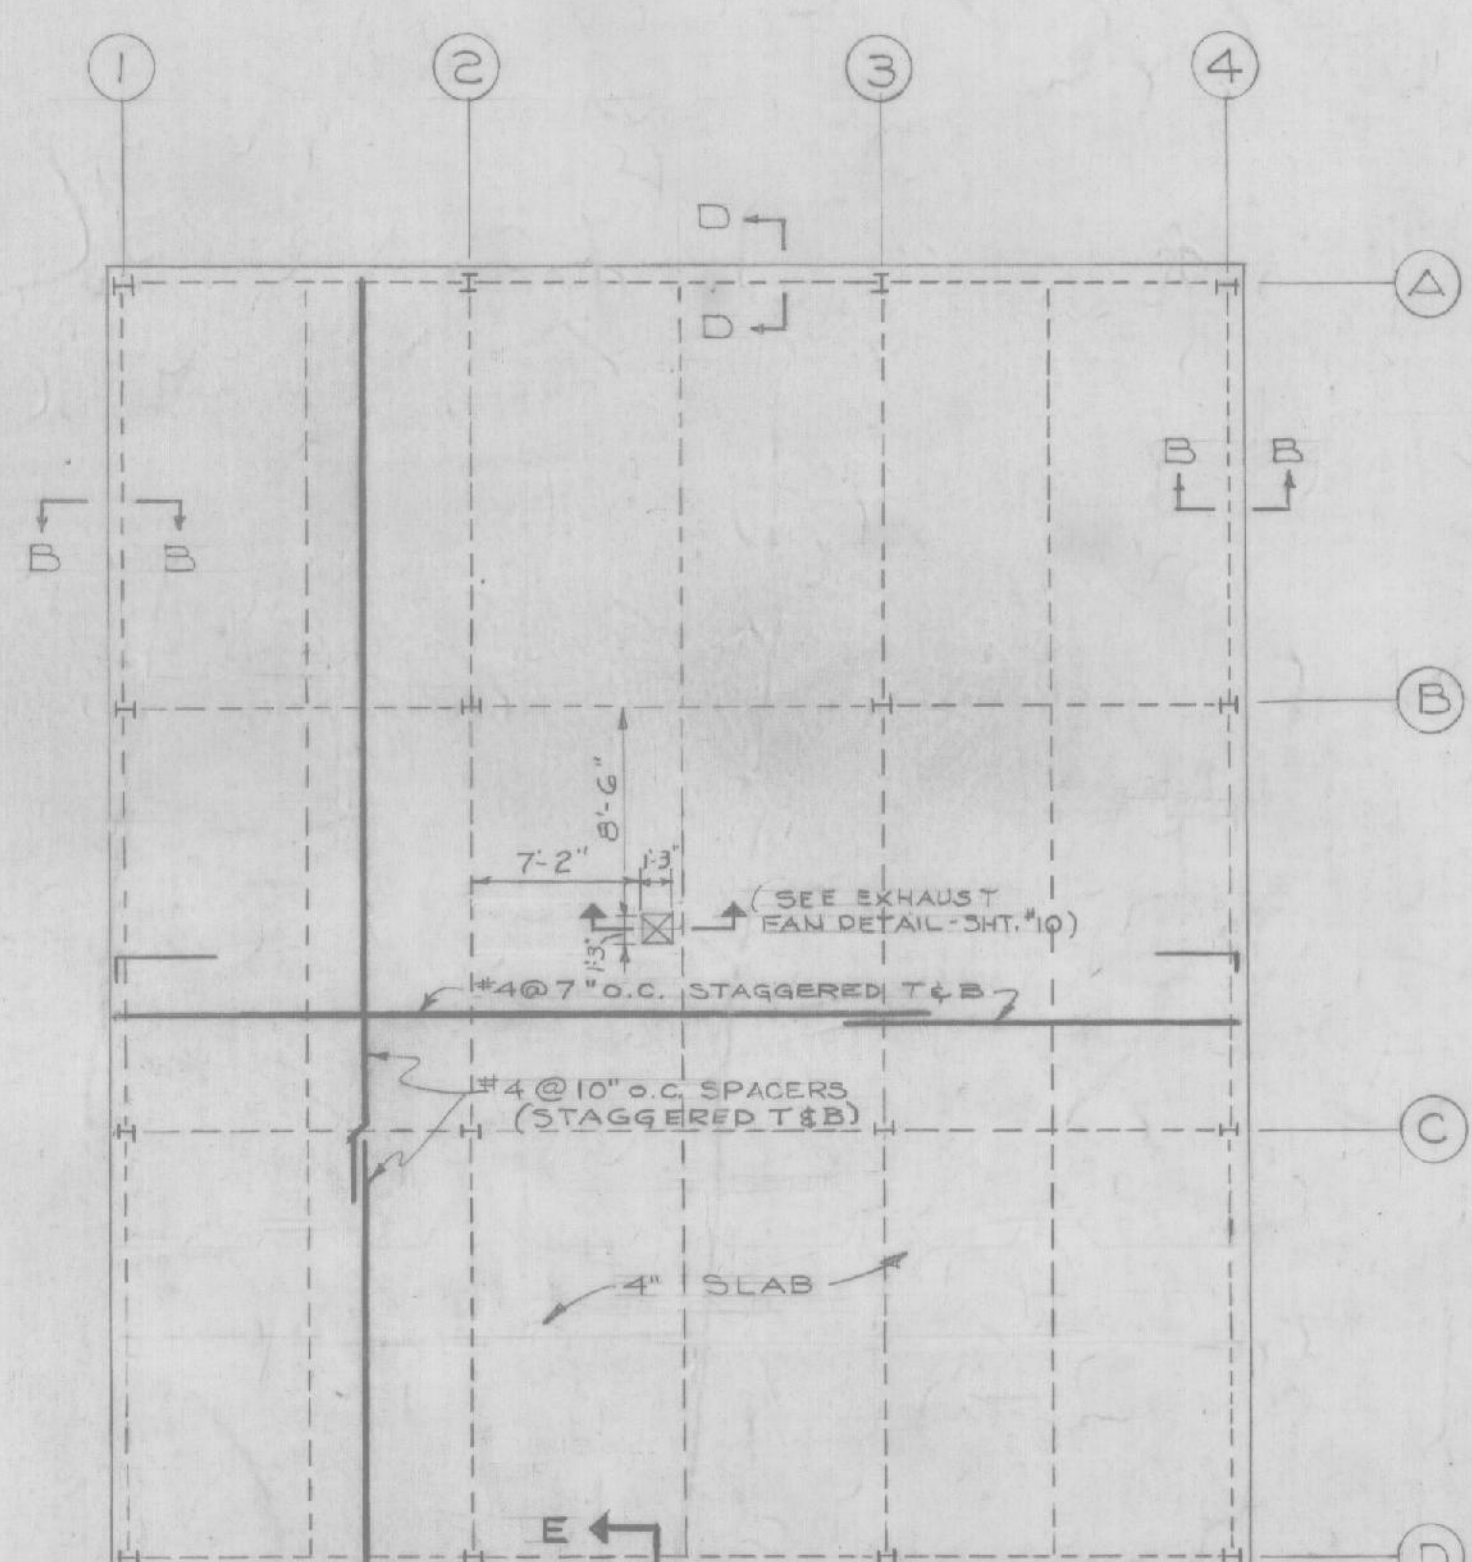


LOW ROOF SLAB
SCALE: 1/8"=1'-0"

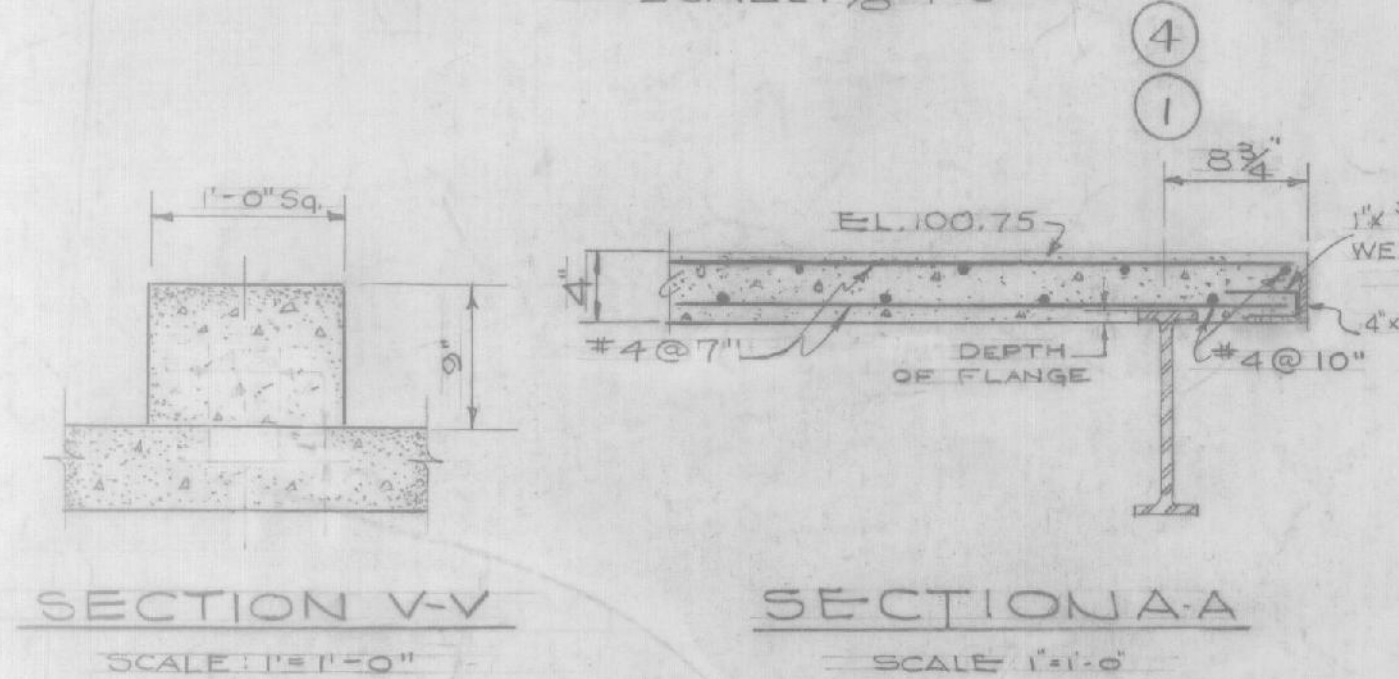


SECTION V-V SCALE: 1"=1'-0"
SECTION A-A SCALE: 1"=1'-0"

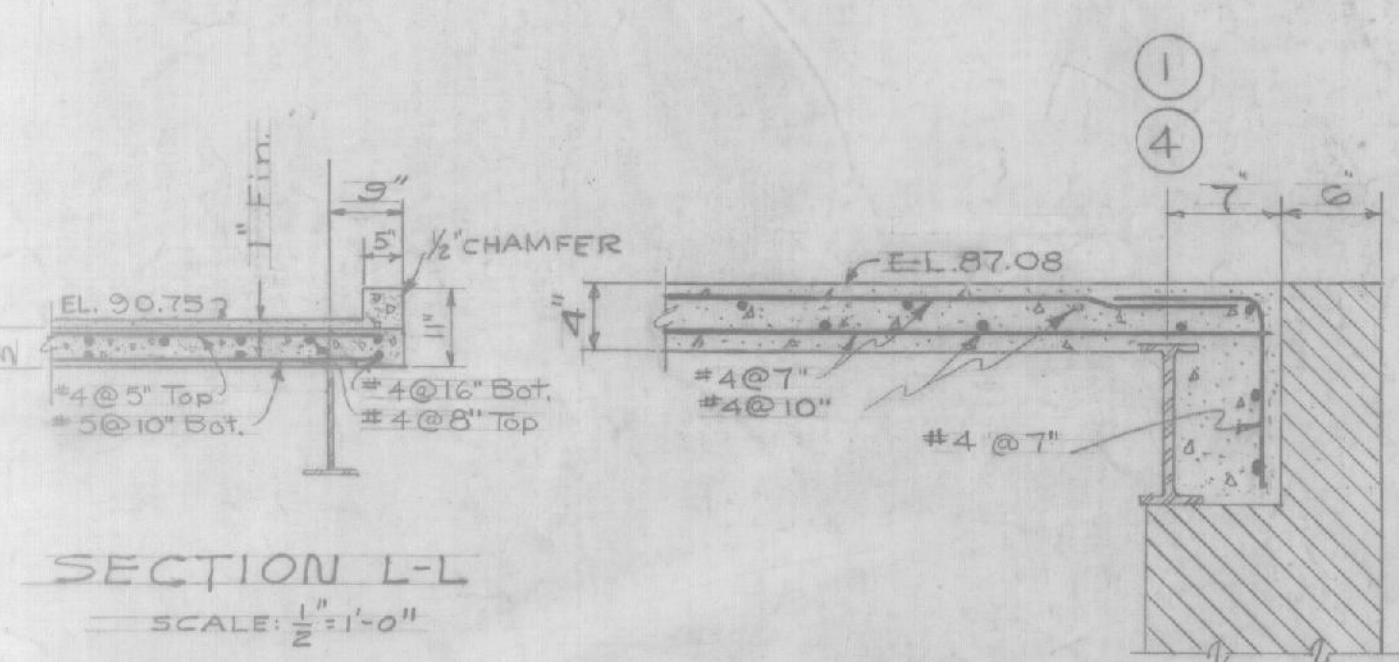


SECTION L-L SCALE: 1/2"=1'-0"
SECTION B-B SCALE: 1"=1'-0"

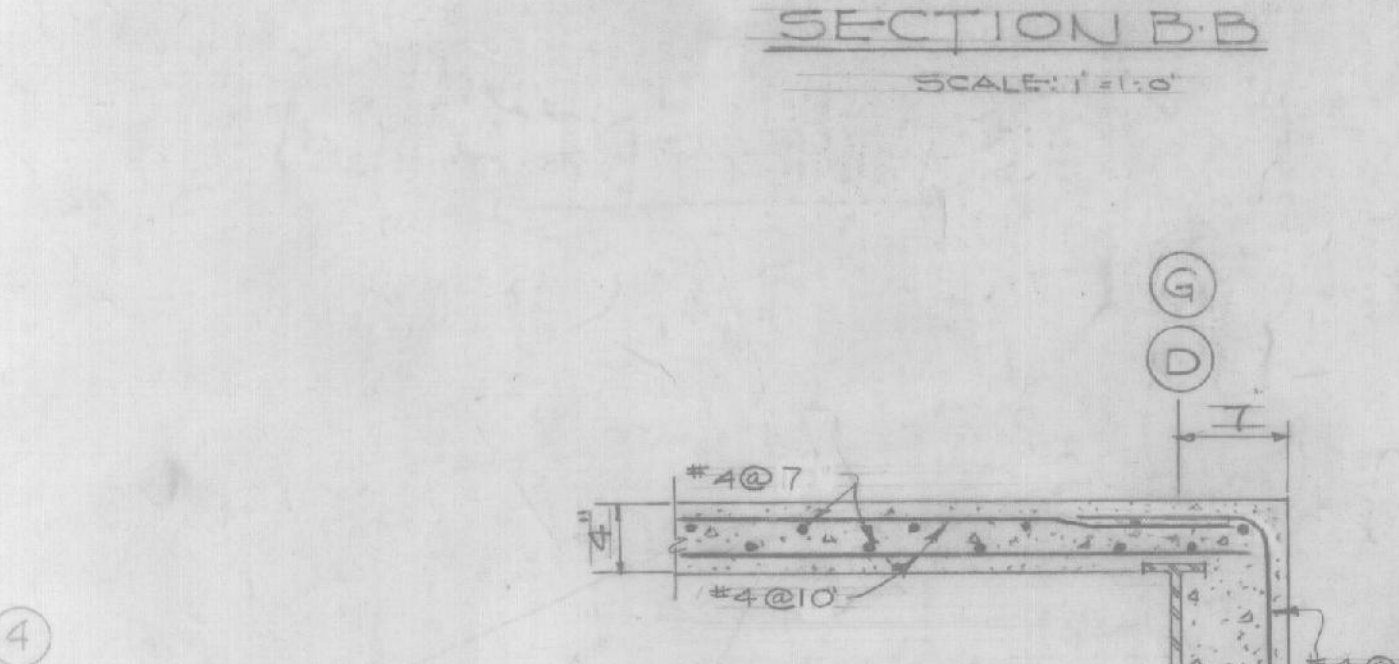


SECTION C-C SCALE: 1"=1'-0"
SECTION T-T SCALE: 1/2"=1'-0"

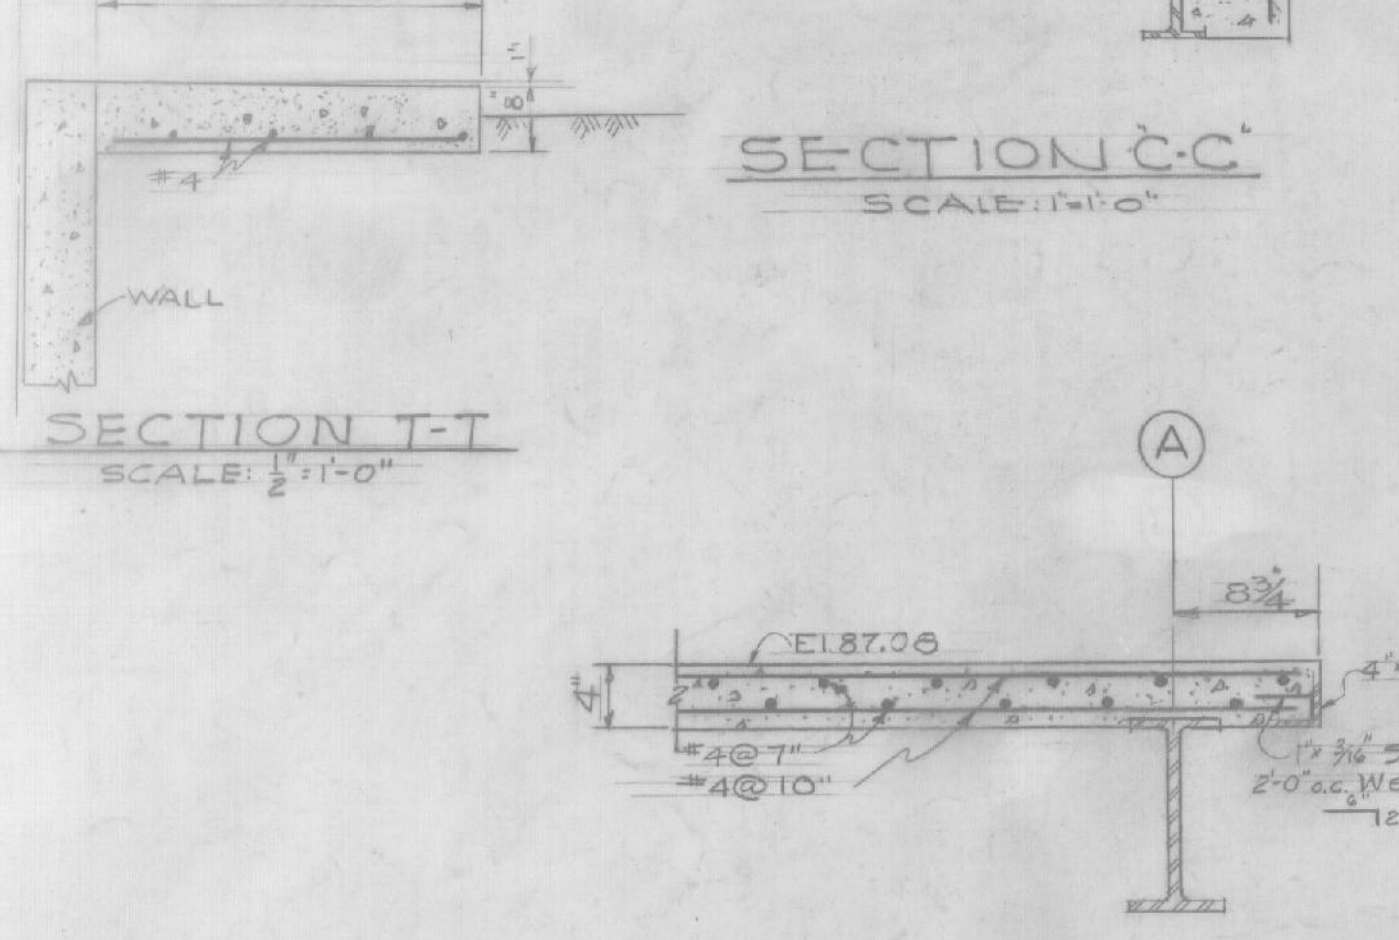


SECTION D-D SCALE: 1"=1'-0"
SECTION U-U SCALE: 1"=1'-0"

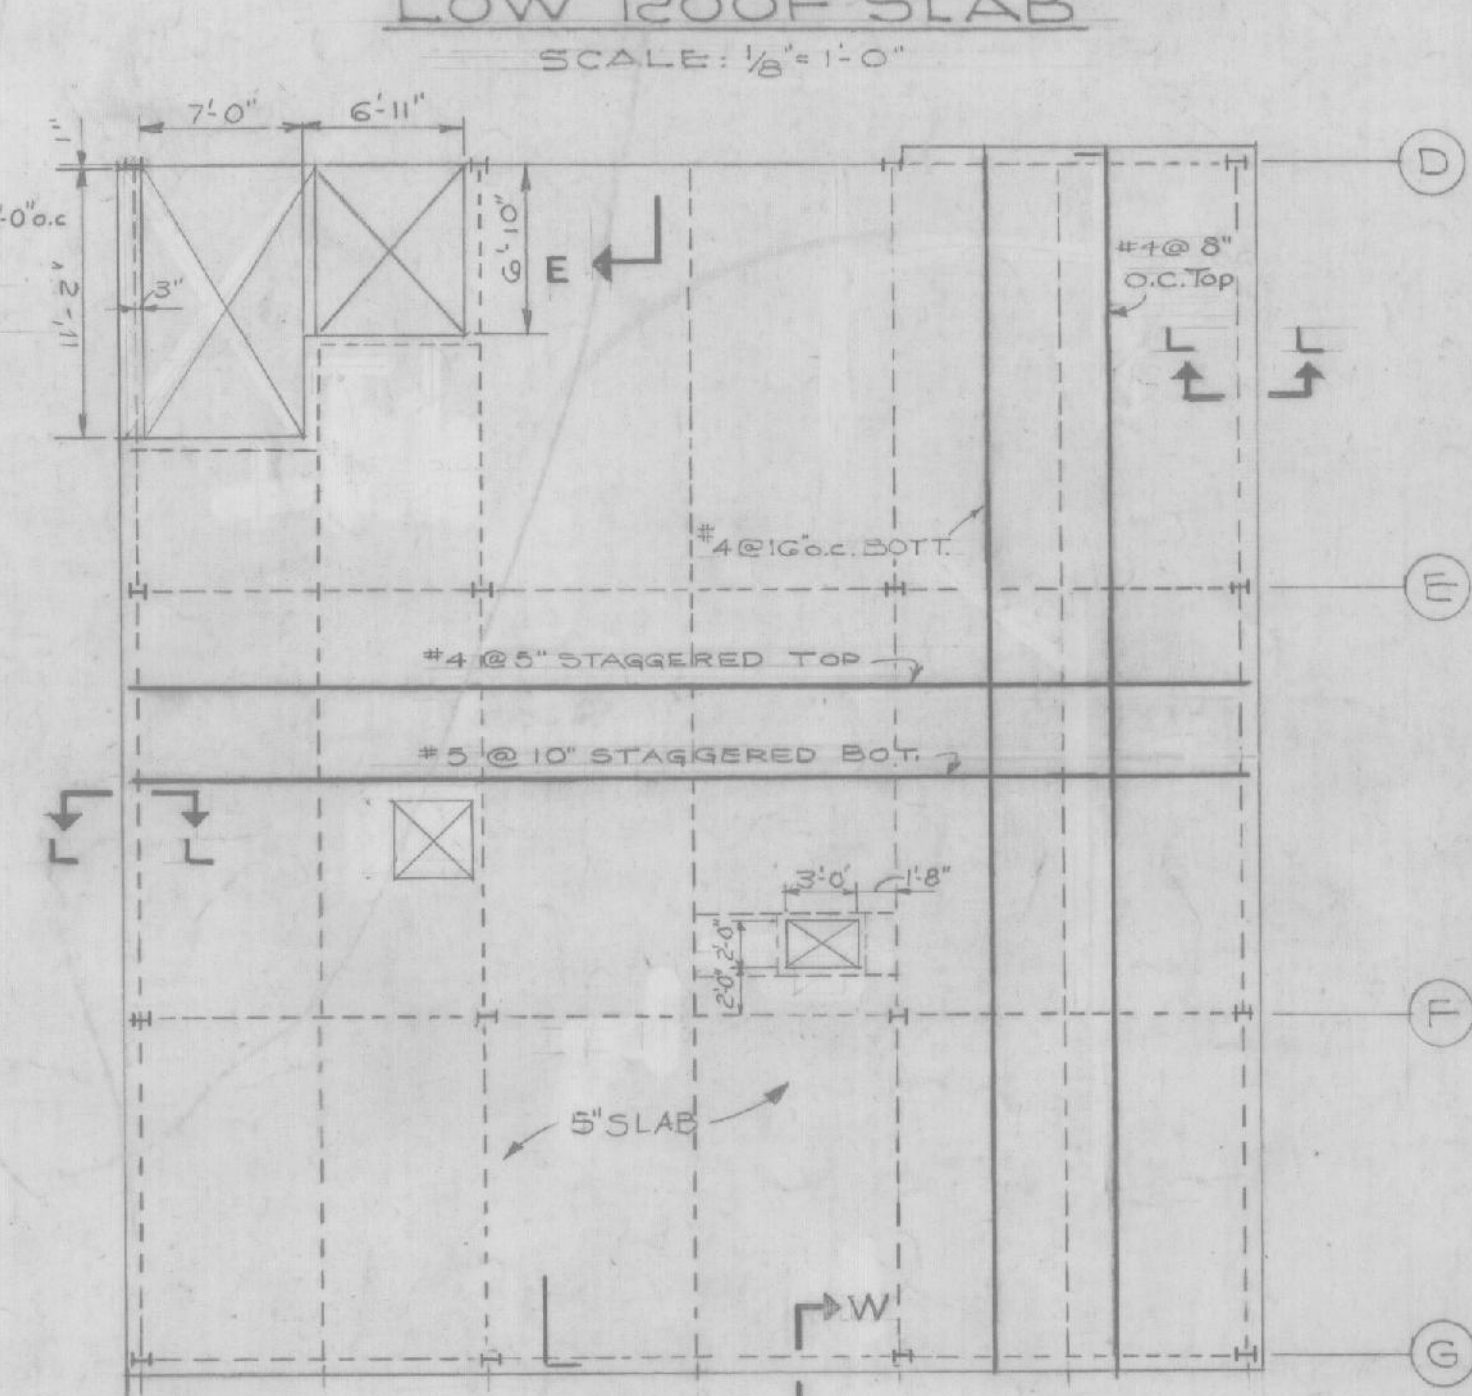


SECOND FLOOR SLAB
SCALE: 1/8"=1'-0"

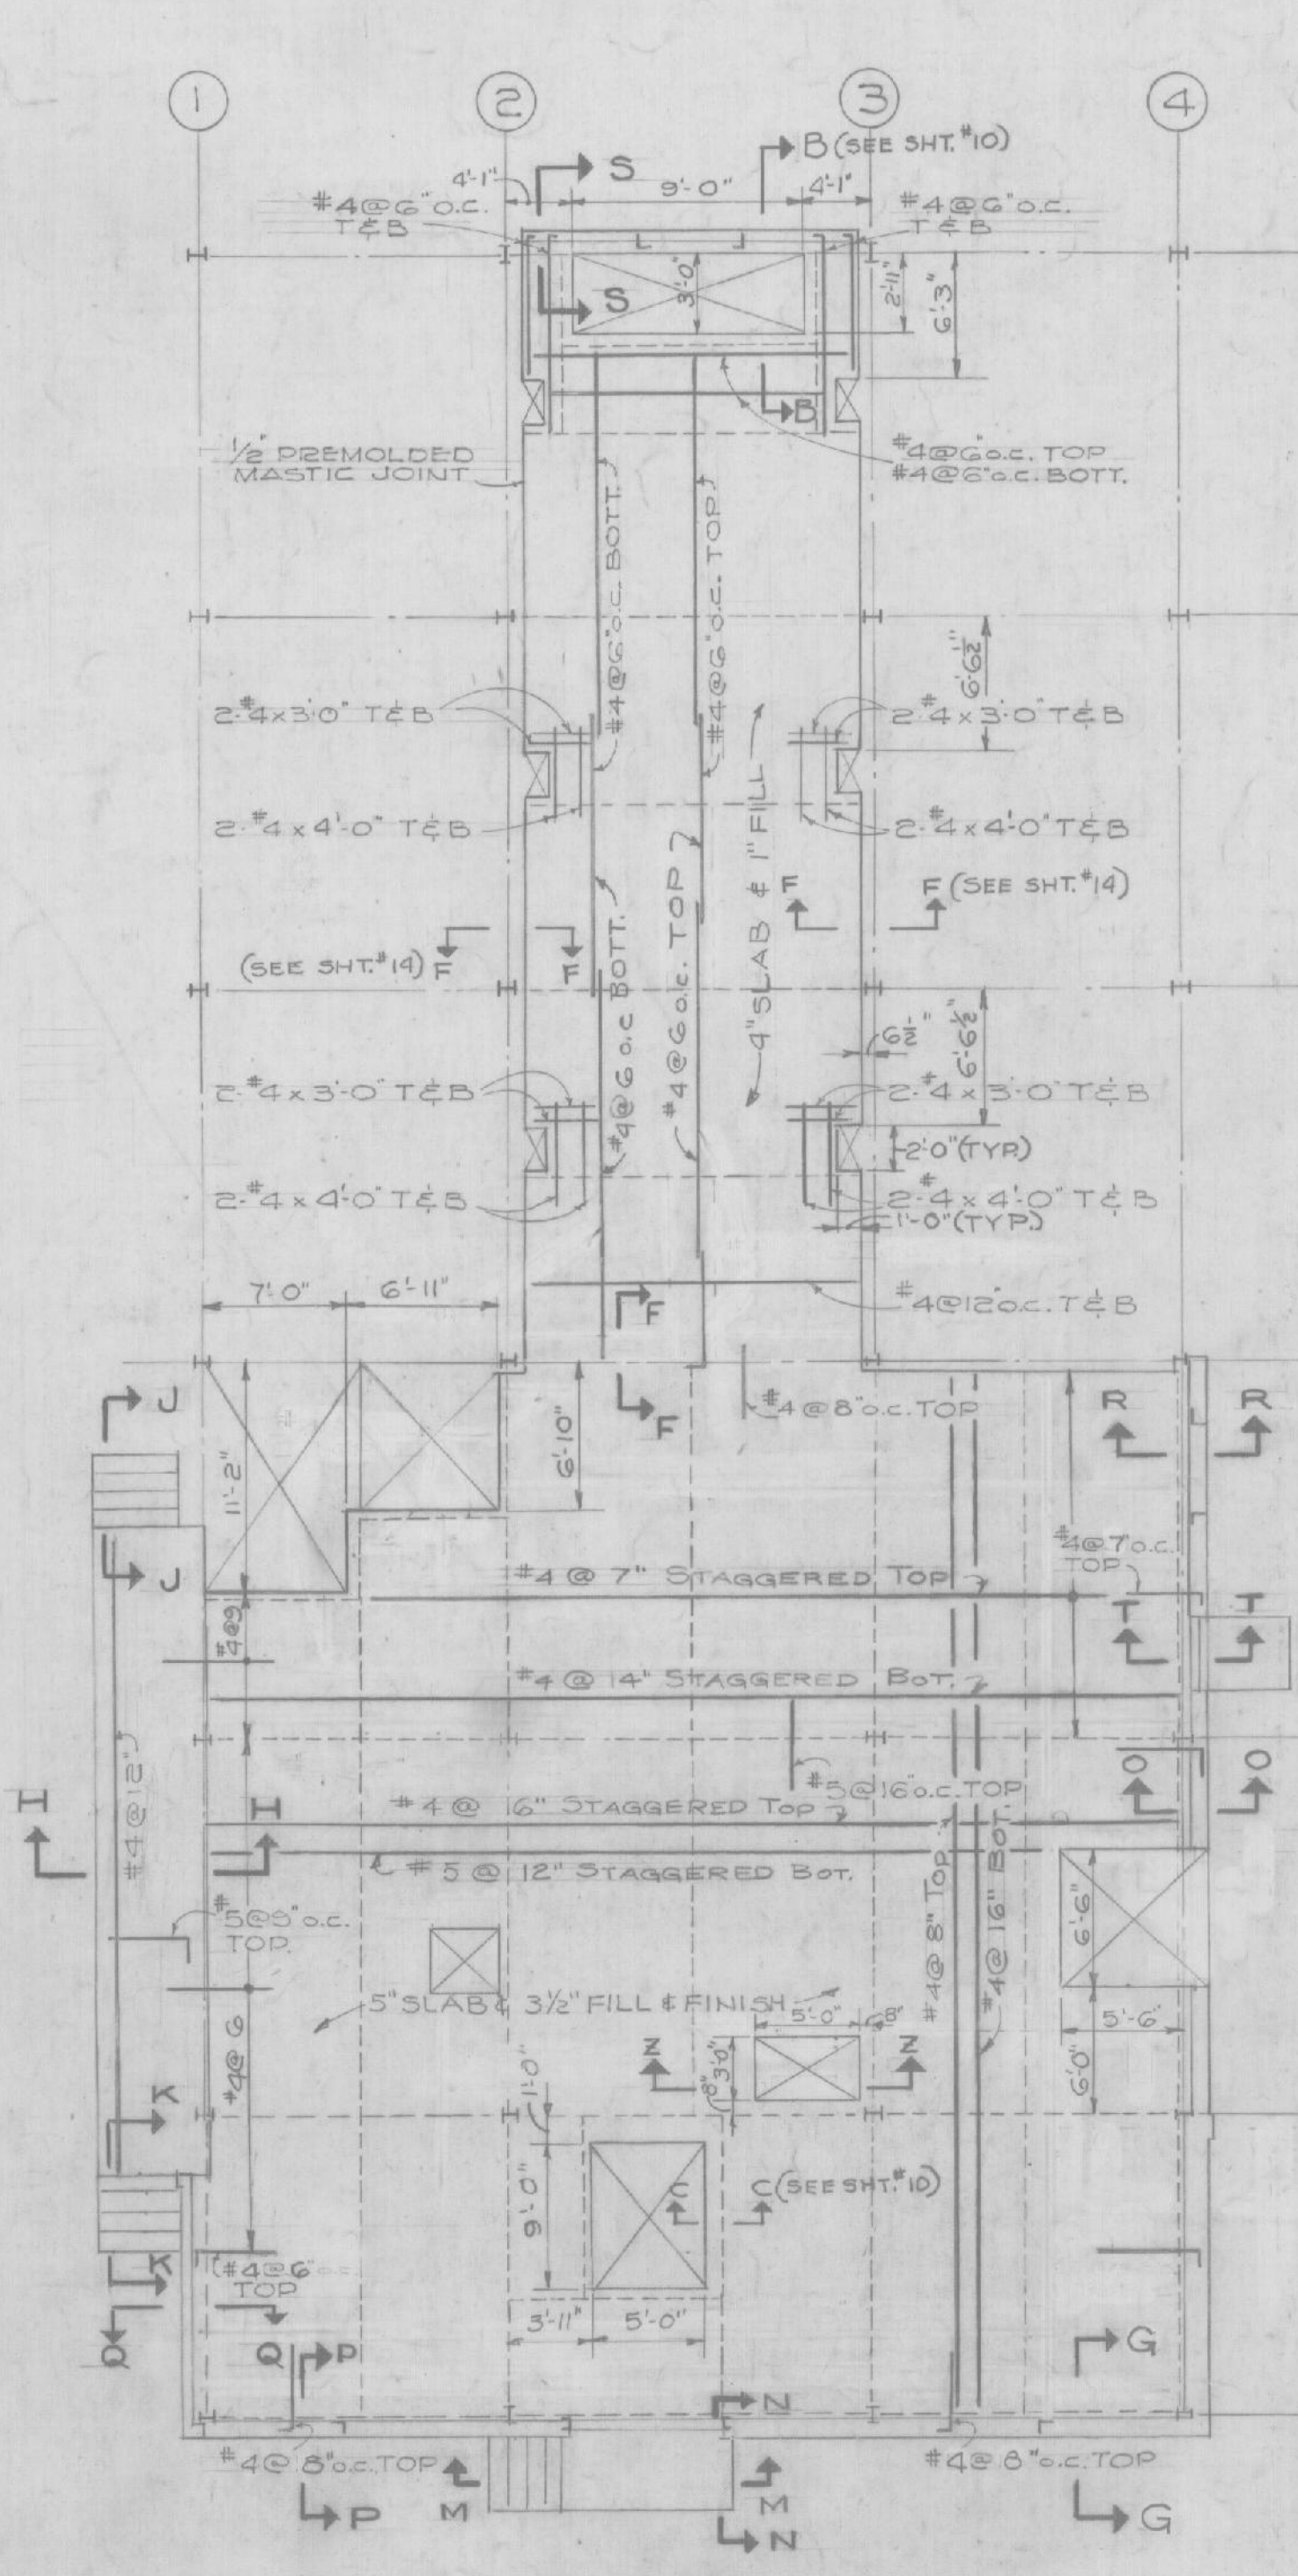

FIRST FLOOR SLAB EL. 78.75
SCALE: 1/8"=1'-0"

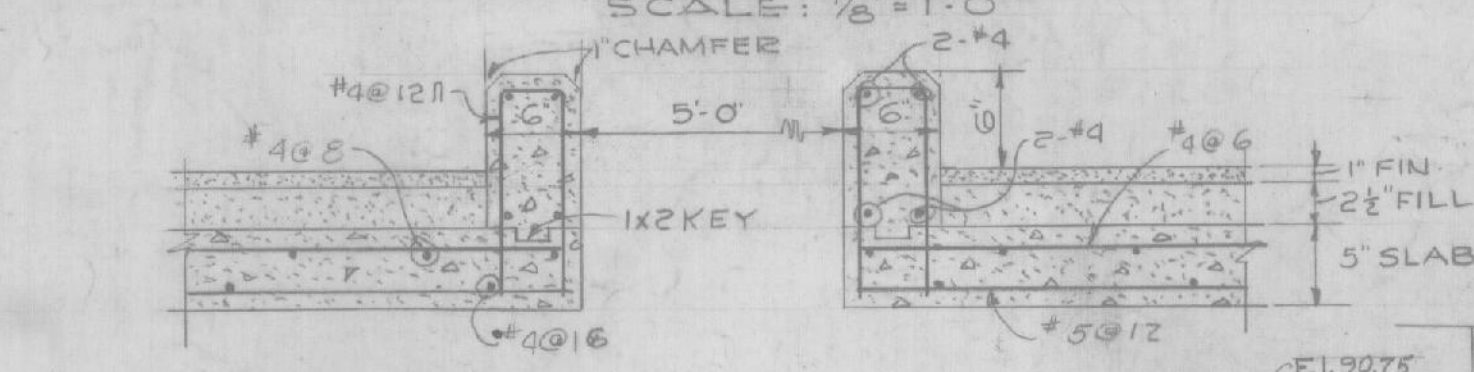


SECTION Z-Z SCALE: 1"=1'-0"

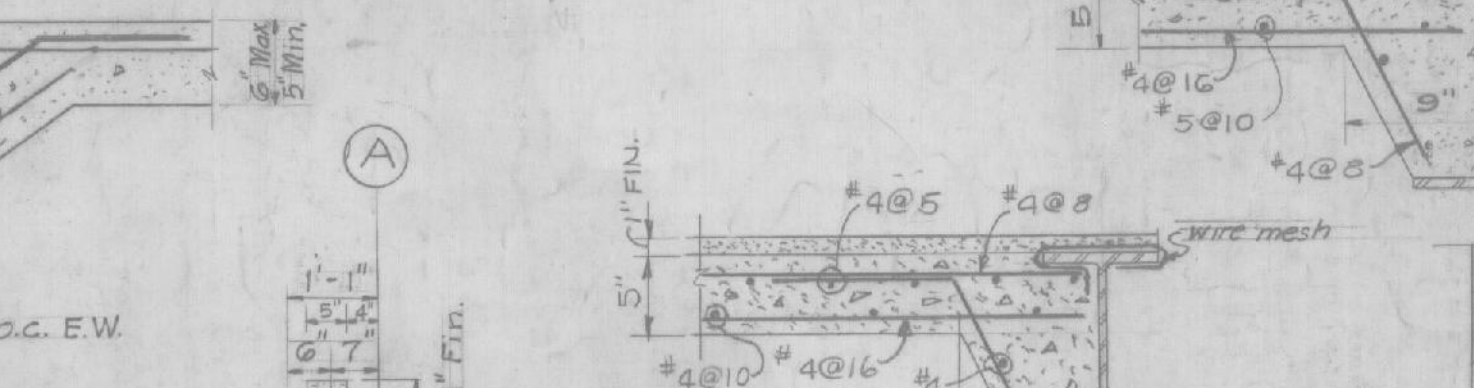


SECTION W-W SCALE: 1"=1'-0"




SECTION E-E SCALE: 1"=1'-0"

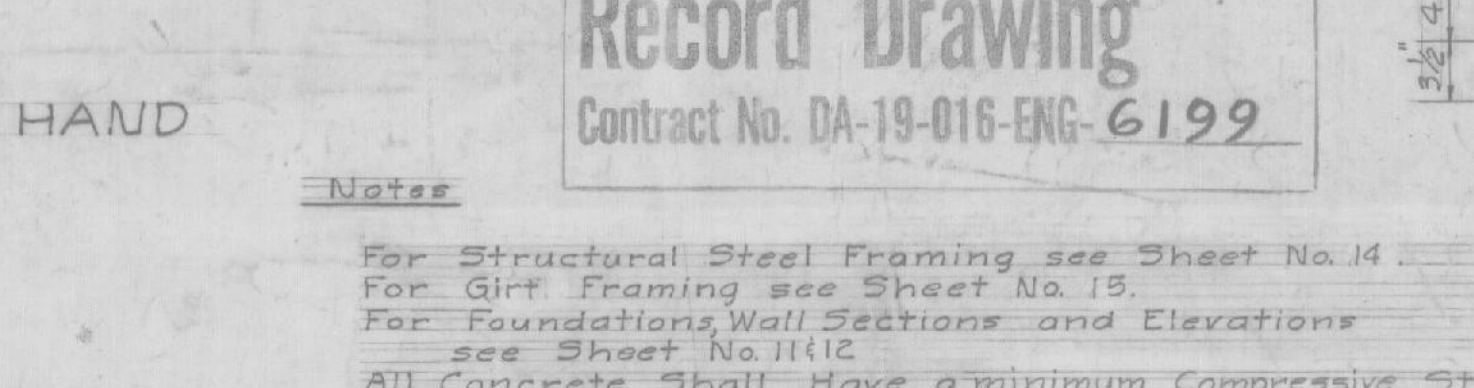


SECTION S-S SCALE: 1/2"=1'-0"

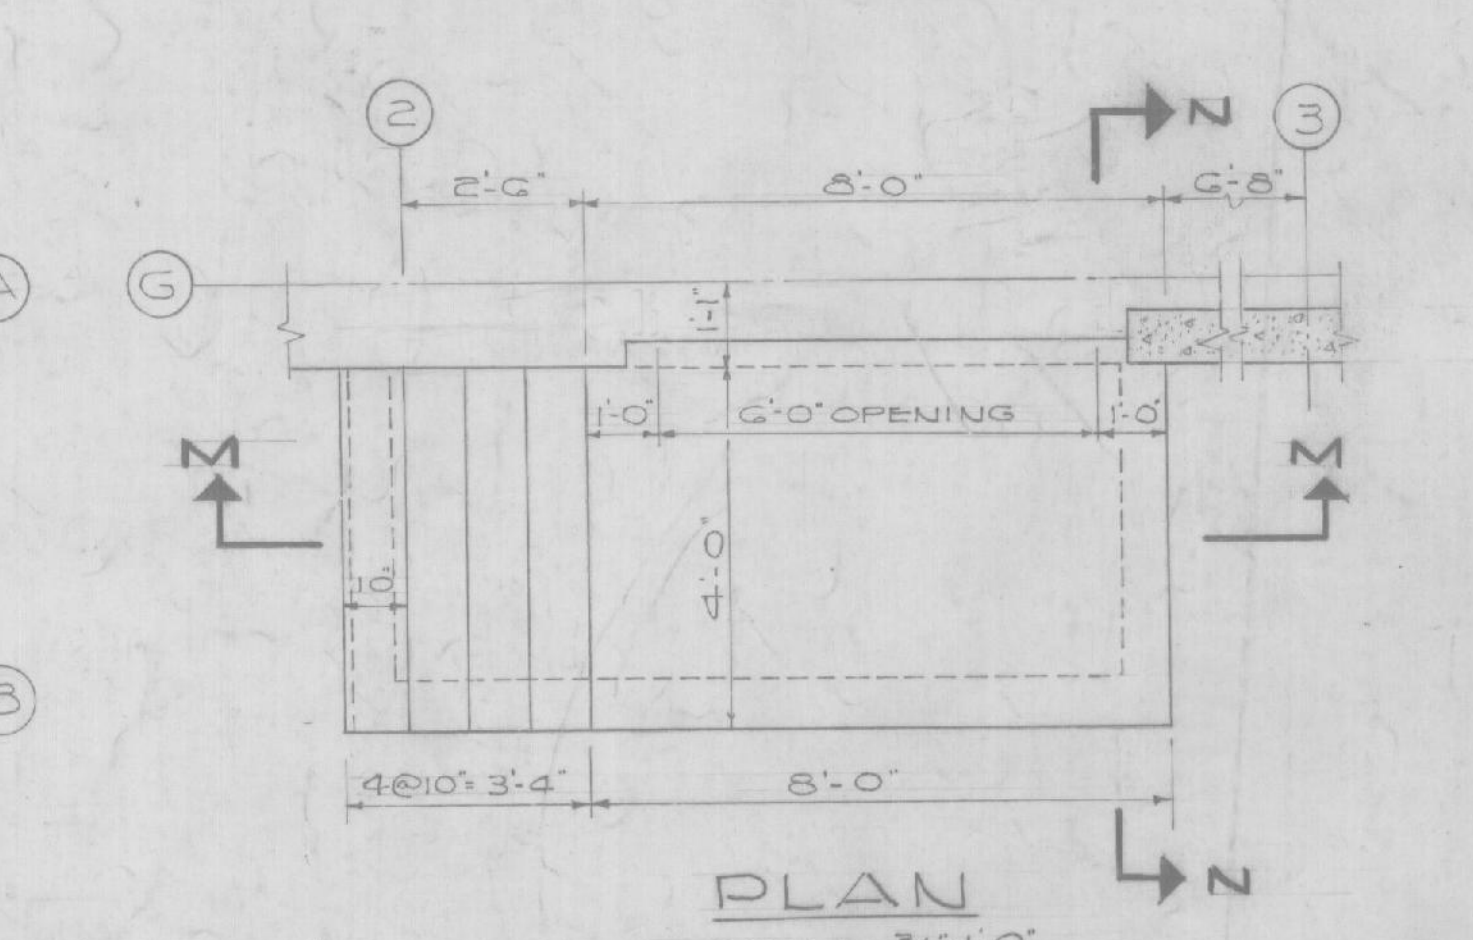


PLAN SCALE: 3/8"=1'-0"

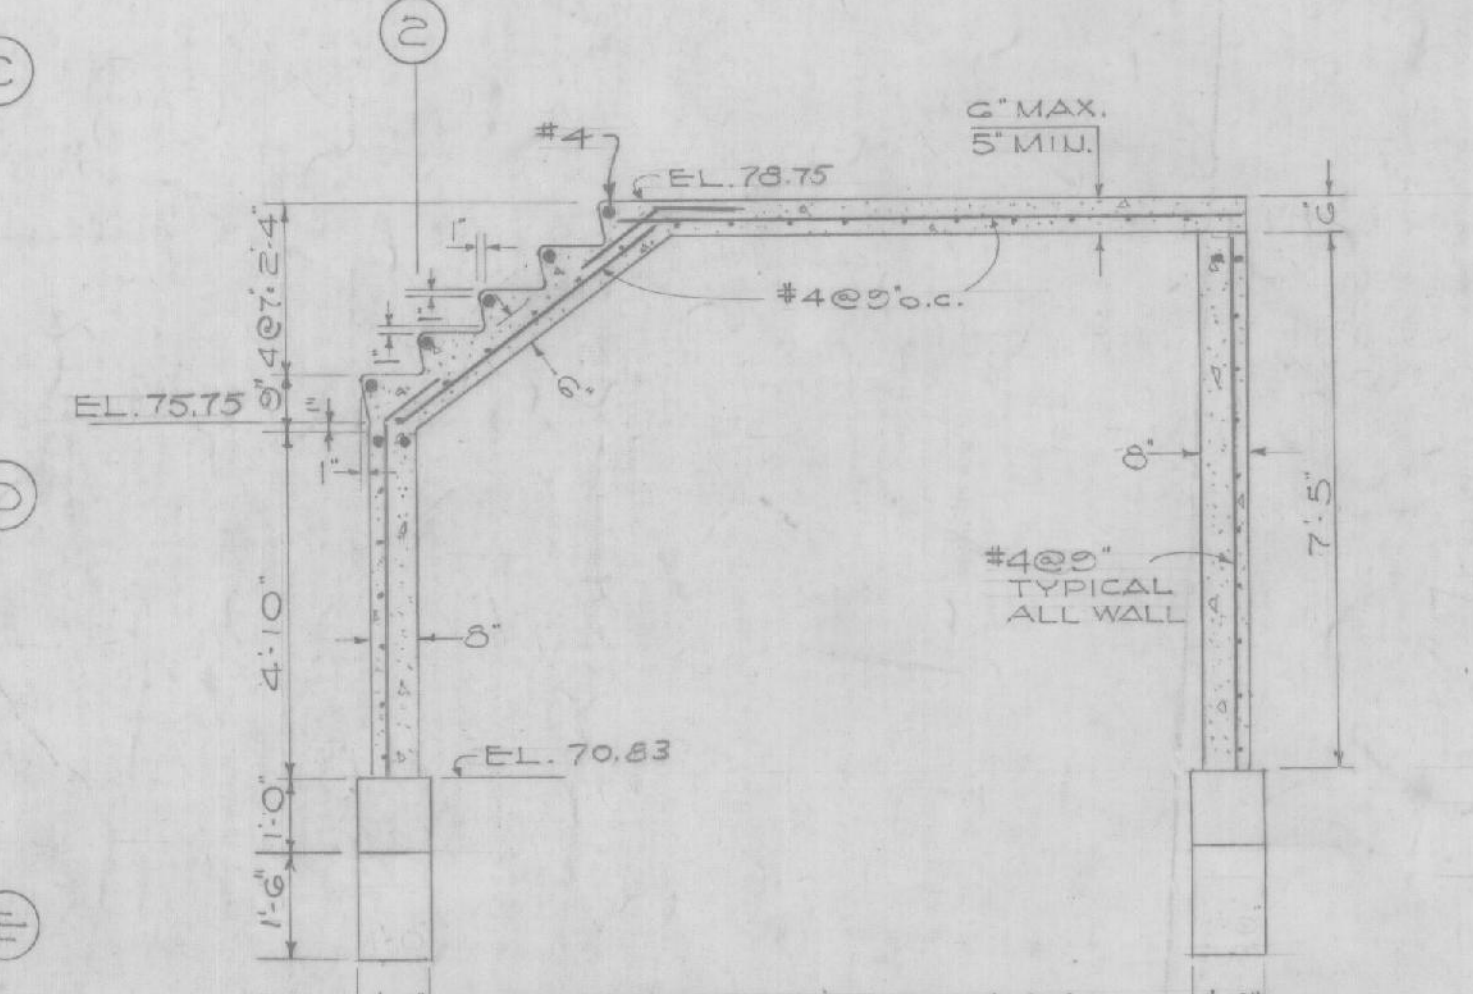


SECTION M-M SCALE: 3/8"=1'-0"

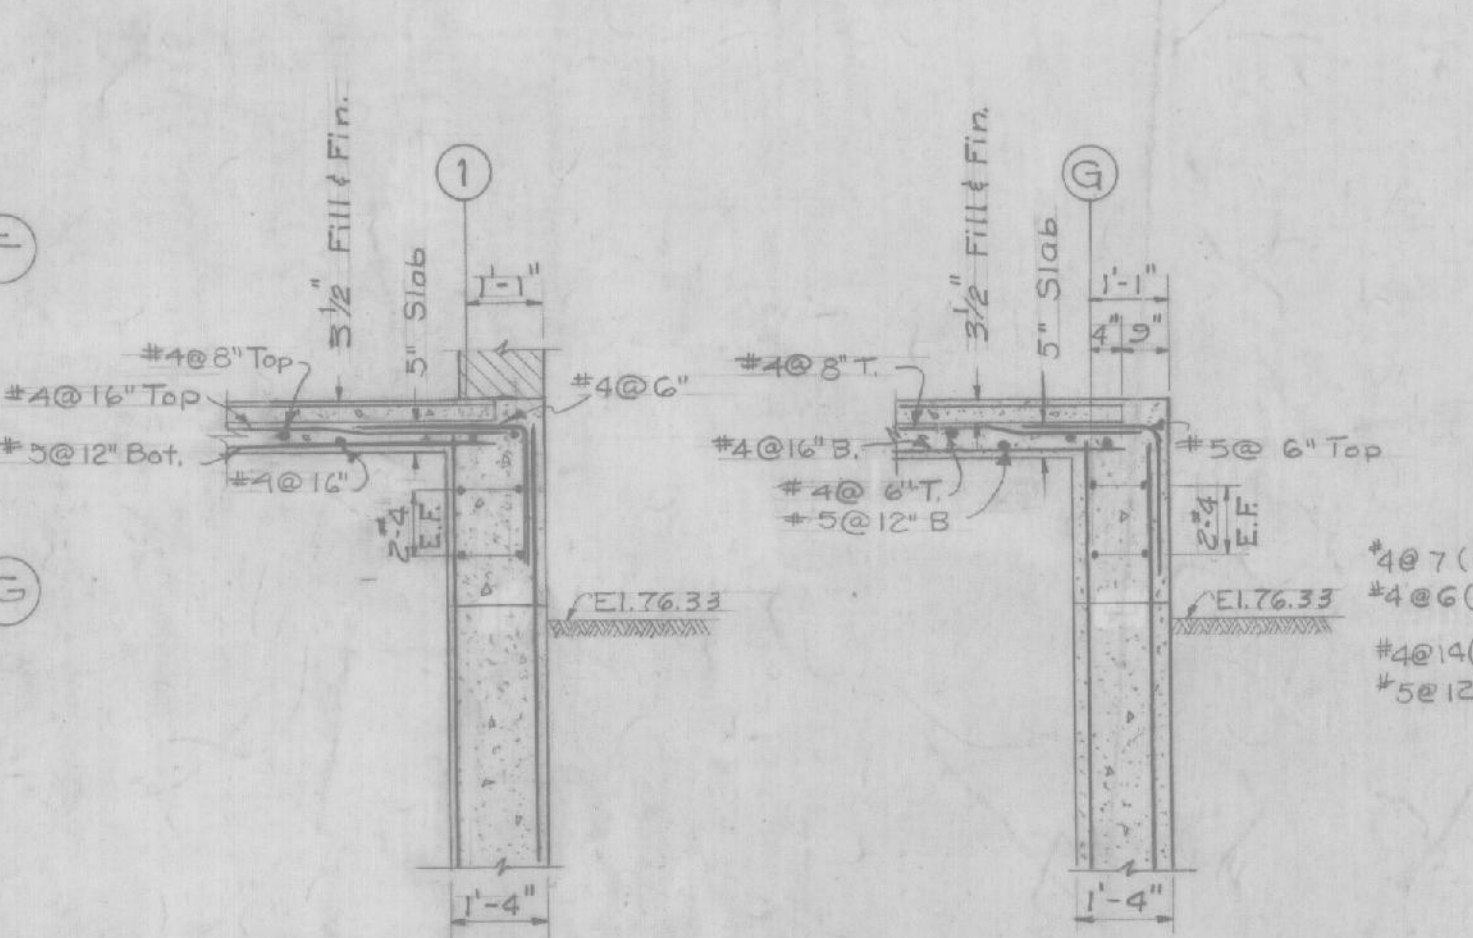


SECTION Q-Q SCALE: 3/8"=1'-0"

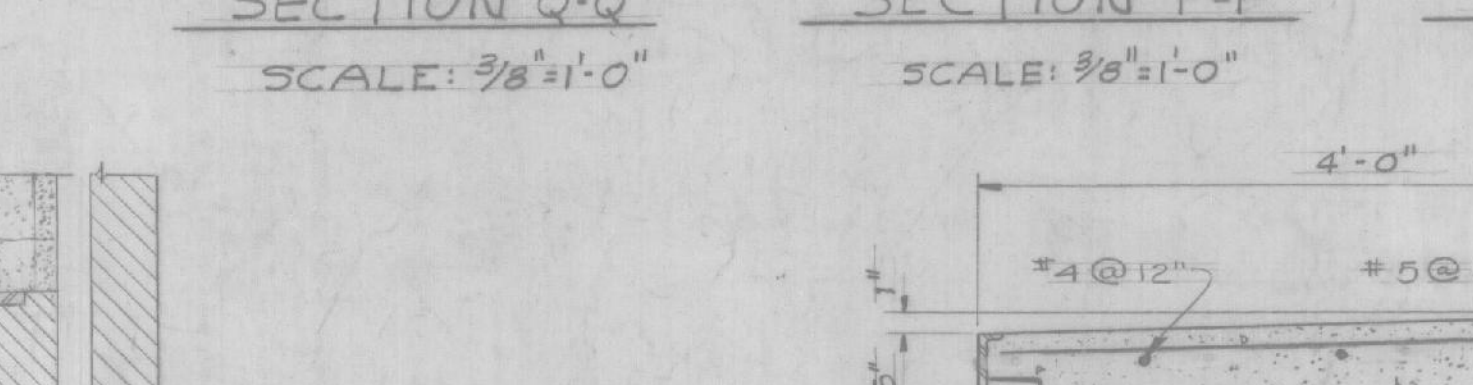


SECTION P-P SCALE: 3/8"=1'-0"

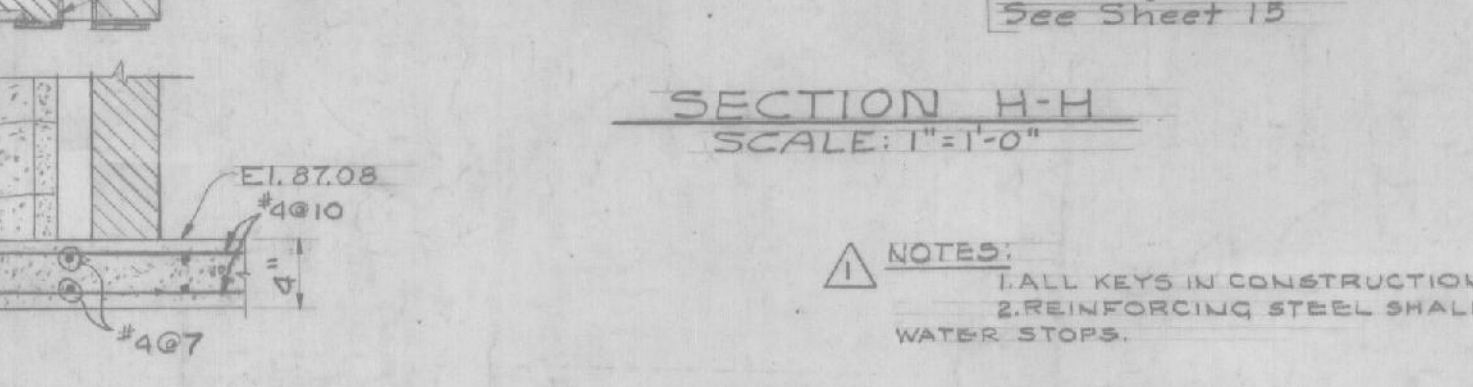


SECTION H-H SCALE: 1"=1'-0"

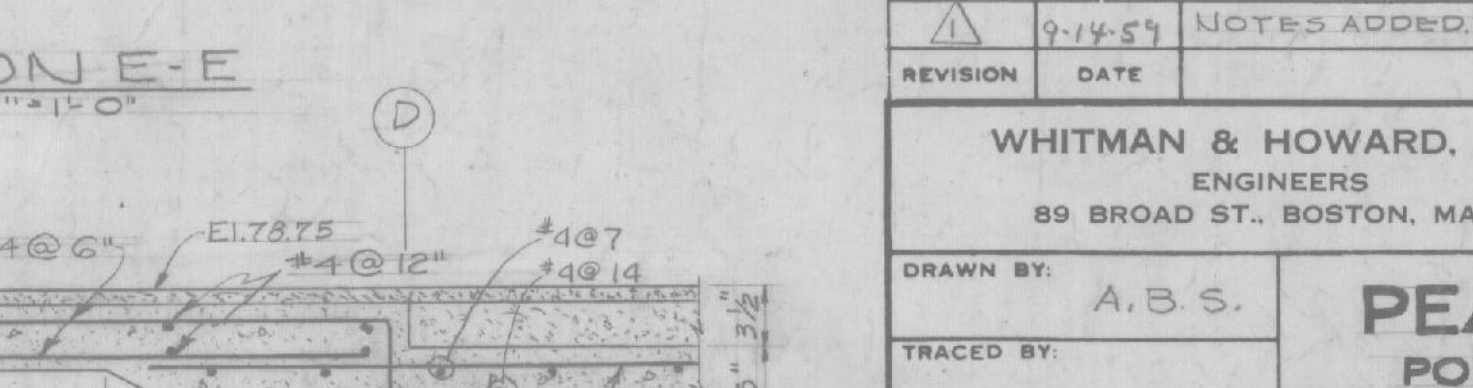


SECTION O-O & R-R SCALE: 3/8"=1'-0"

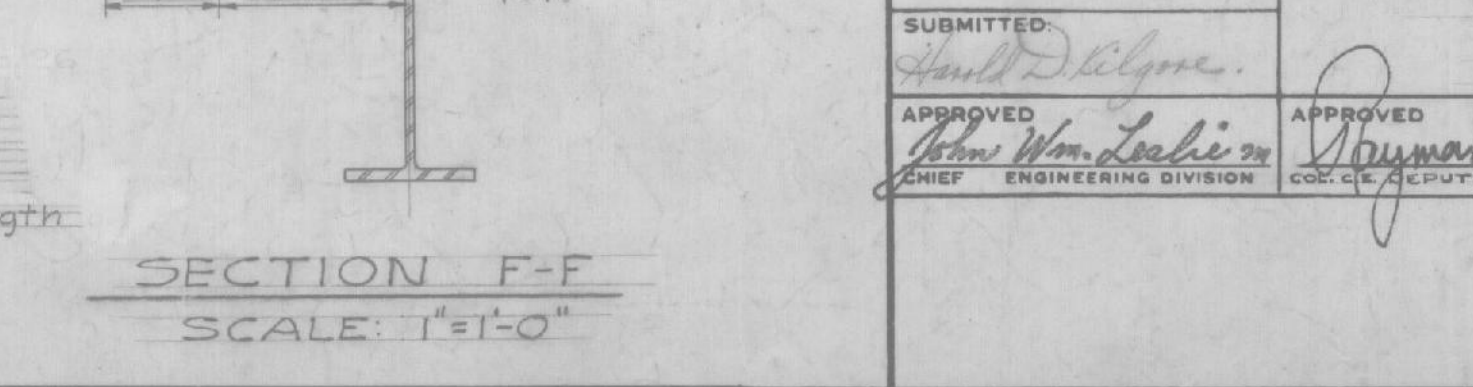


SECTION F-F SCALE: 1"=1'-0"

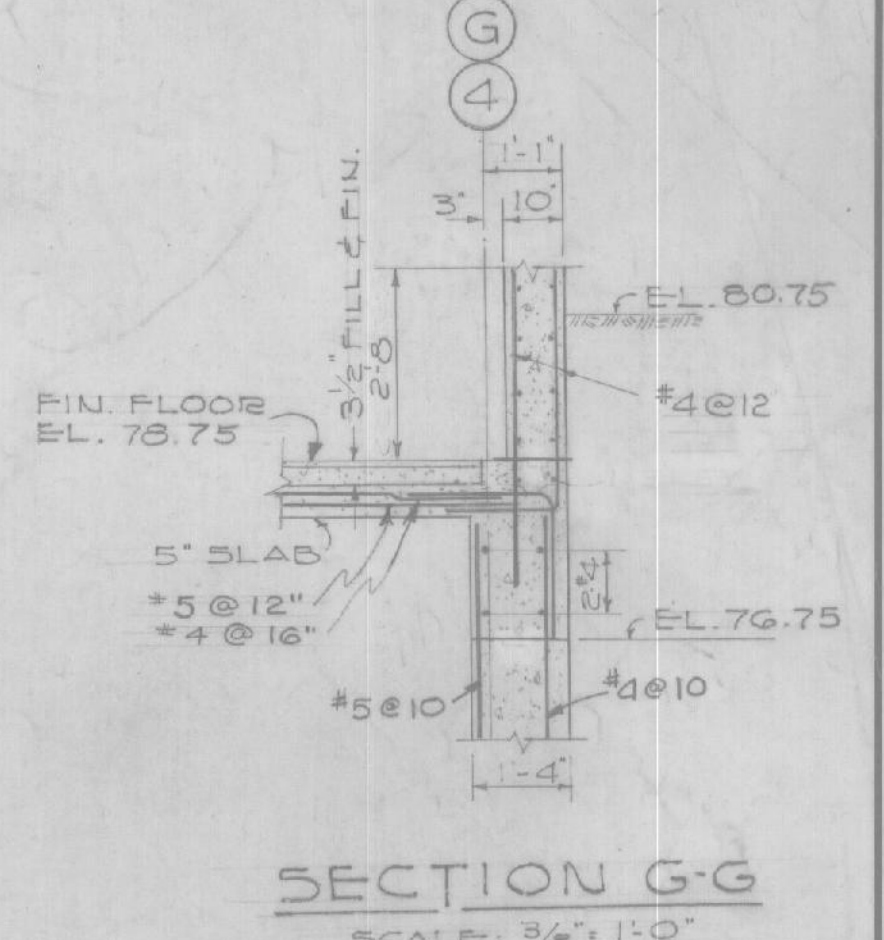


SECTION G-G SCALE: 3/8"=1'-0"

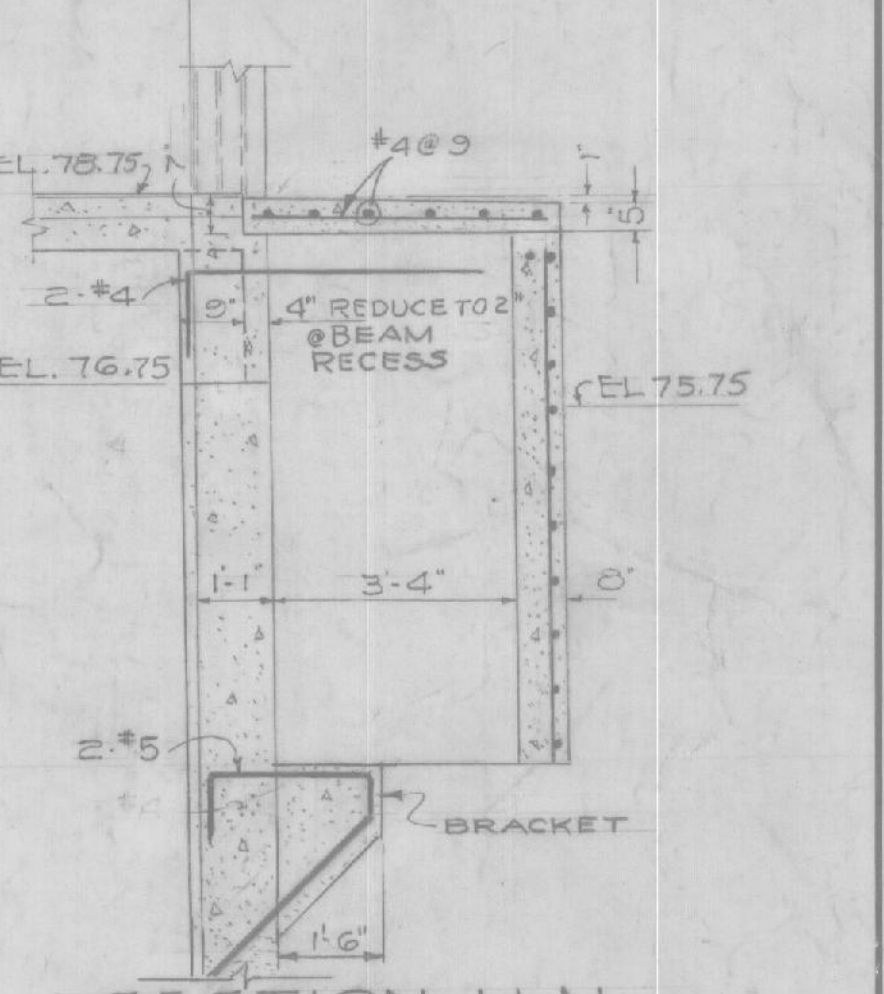


SECTION N-N SCALE: 3/8"=1'-0"

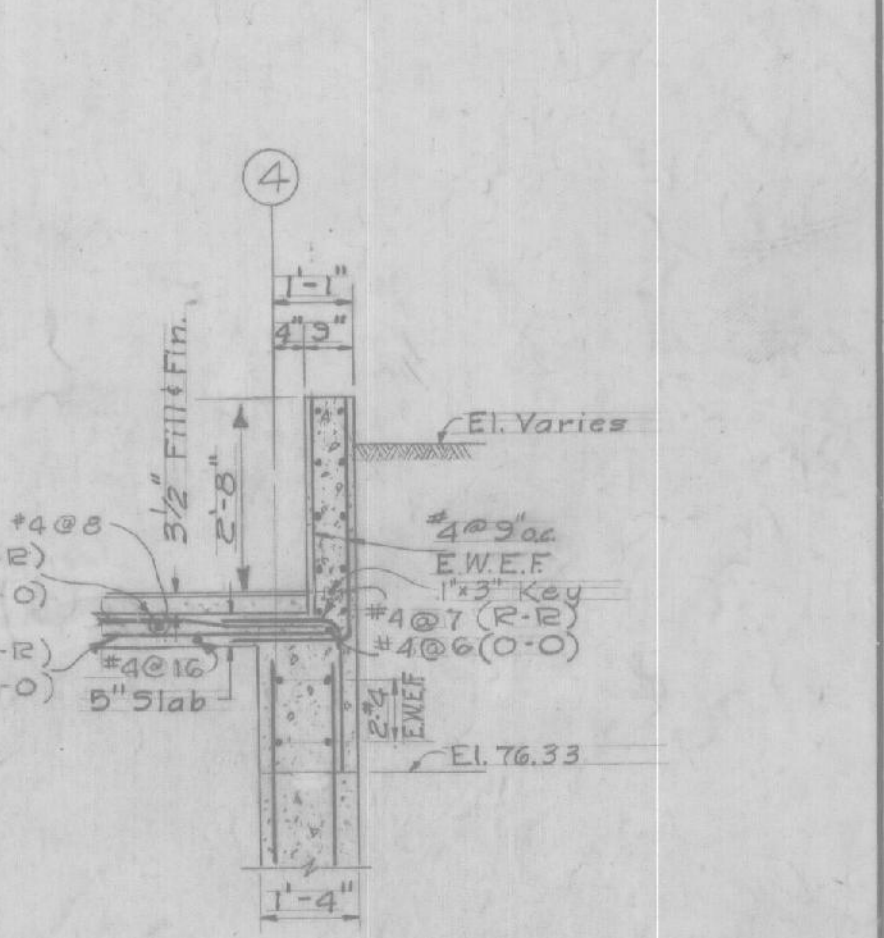


SECTION O-O & R-R SCALE: 3/8"=1'-0"

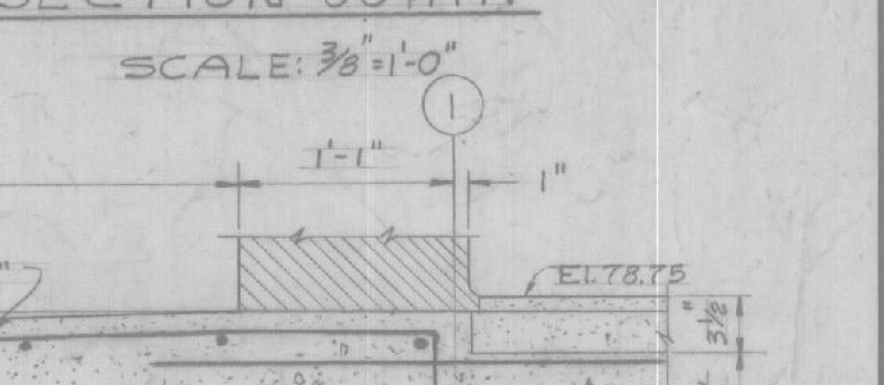


SECTION P-P SCALE: 3/8"=1'-0"

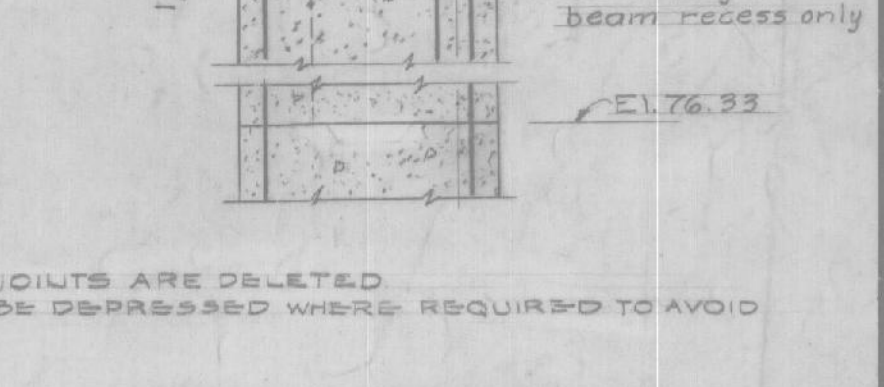

SECTION H-H SCALE: 1"=1'-0"

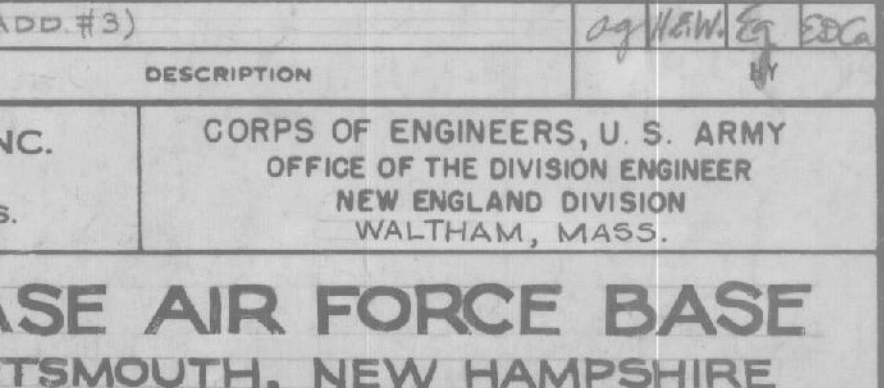

SECTION O-O & R-R SCALE: 3/8"=1'-0"

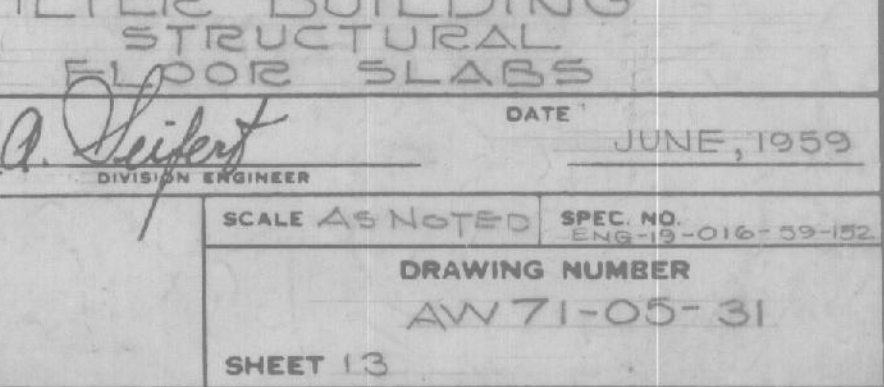

SECTION F-F SCALE: 1"=1'-0"

NOTES:
1. ALL KEYS IN CONSTRUCTION JOINTS ARE DELETED.
2. REINFORCING STEEL SHALL BE DEPRESSSED WHERE REQUIRED TO AVOID WATER STOPS.

For Structural Steel Framing see Sheet No. 14
For Girt Framing see Sheet No. 15
For Foundations, Wall Sections and Elevations see Sheet No. 11 & 12
All Concrete Shall Have a minimum Compressive Strength at 28 days of 3000 p.s.i.

Record Drawing
Contract No. DA-19-016-ENG-6199

REVISION	DATE	DESCRIPTION	BY
1	9/14/57	NOTES ADDED (ADD #3)	J. W. HOWARD

WHITMAN & HOWARD, INC. ENGINEERS
89 BROAD ST., BOSTON, MASS.

CORPS OF ENGINEERS, U. S. ARMY
OFFICE OF THE DIVISION ENGINEER
NEW ENGLAND DIVISION
WALTHAM, MASS.












PEASE AIR FORCE BASE
PORTSMOUTH, NEW HAMPSHIRE
SURFACE WATER SUPPLY
FILTER BUILDING
STRUCTURAL FLOOR SLABS

DRAWN BY: A.B.S.
CHECKED BY: C.G.M.
APPROVED: [Signature]
DATE: JUNE, 1959

SCALE AS NOTED
DRAWING NUMBER: AW 71-05-31
SHEET 13

COLUMN SCHEDULE		COLUMN									
COLUMN	ELEVATION	A ₁ to A ₄	D ₁	D ₂	E ₁	E ₂	F ₁	F ₂	G ₁	G ₂	
High Roof Slab	El. 100.75	B ₁ to B ₄	C ₁	C ₂	C ₃	C ₄	C ₅	C ₆	C ₇	C ₈	C ₉
Fin. 2nd Fl.	El. 90.75										
Low Roof Slab	El. 87.00										
Fin. 1st Fl.	El. 78.75										
Basement	El. 66.25										
BASE PLATES		W	9'	9'	11'	7 1/2'	18'	7 1/2'	18'	9'	9'
		L	9'	9'	11'	9'	18'	9'	18'	9'	9'
		T	7/8"	3/4"	1 1/2"	1/2"	2"	1/2"	2"	1/2"	3/4"
		G	5 1/2"	5 1/2"	5 1/2"	3 1/2"	5 1/2"	3 1/2"	5 1/2"	5 1/2"	3 1/2"








NOTE: Dimensions given are to ends of column shaft, and do not include base plates.

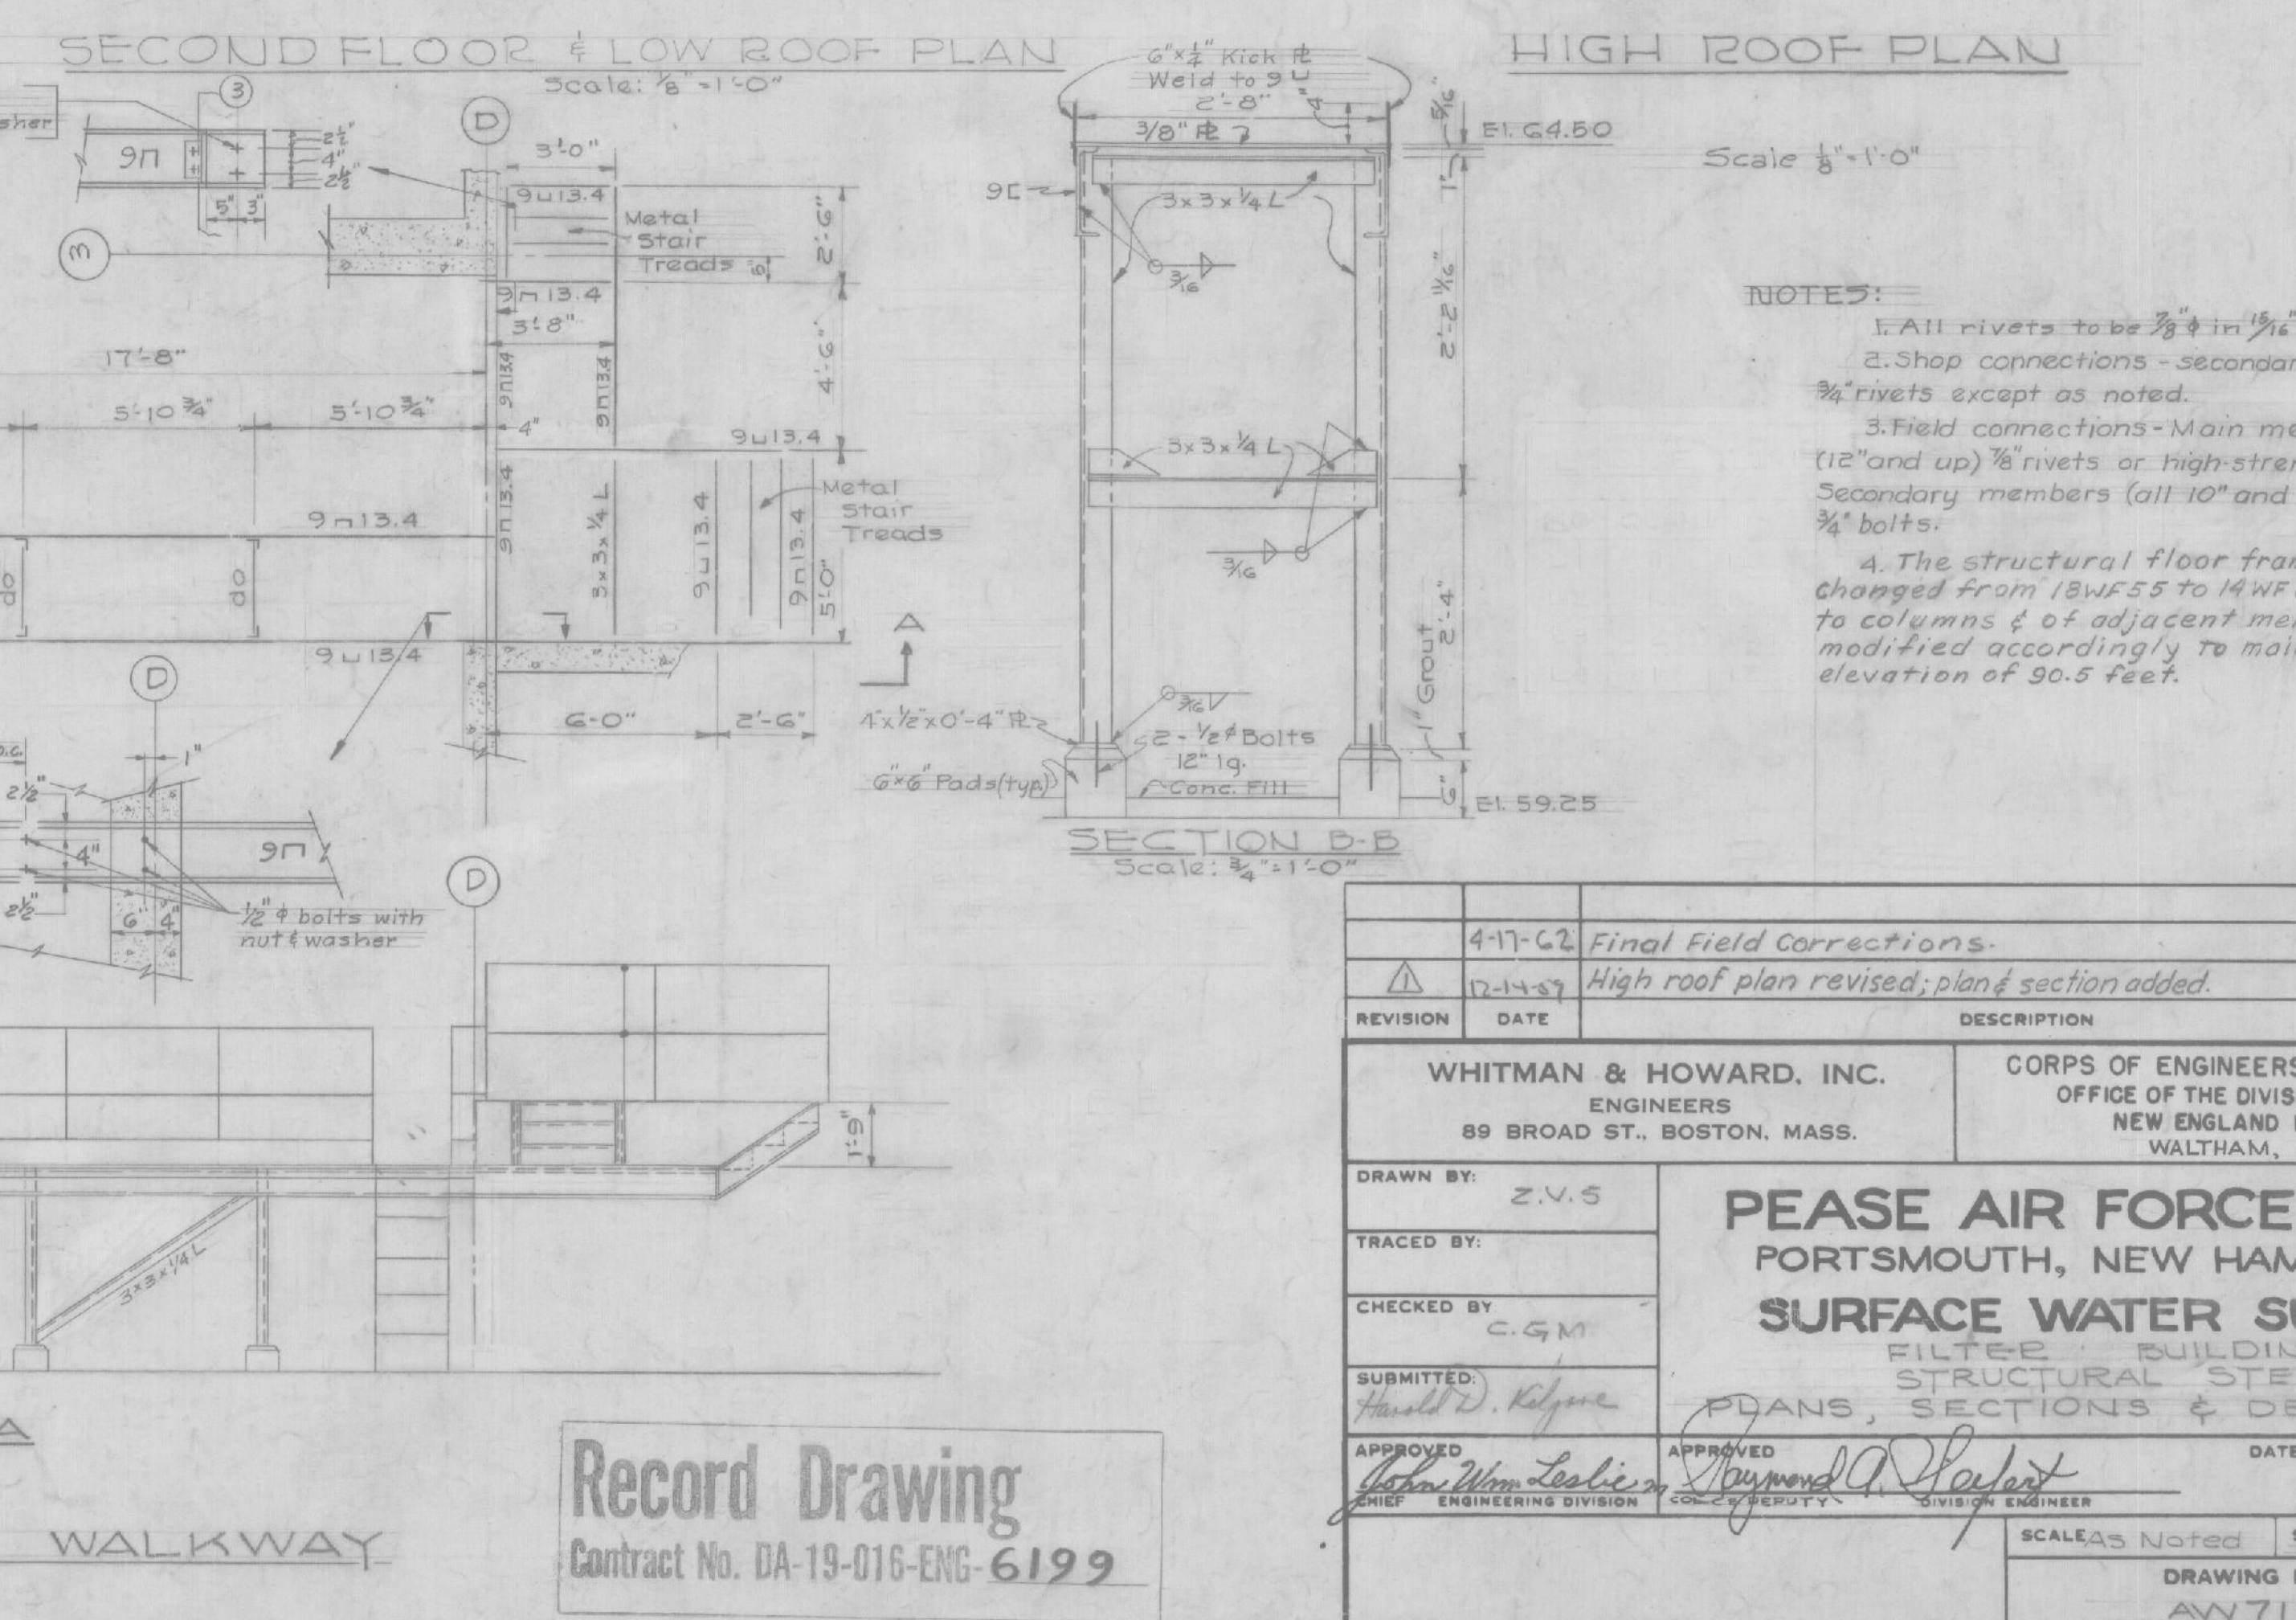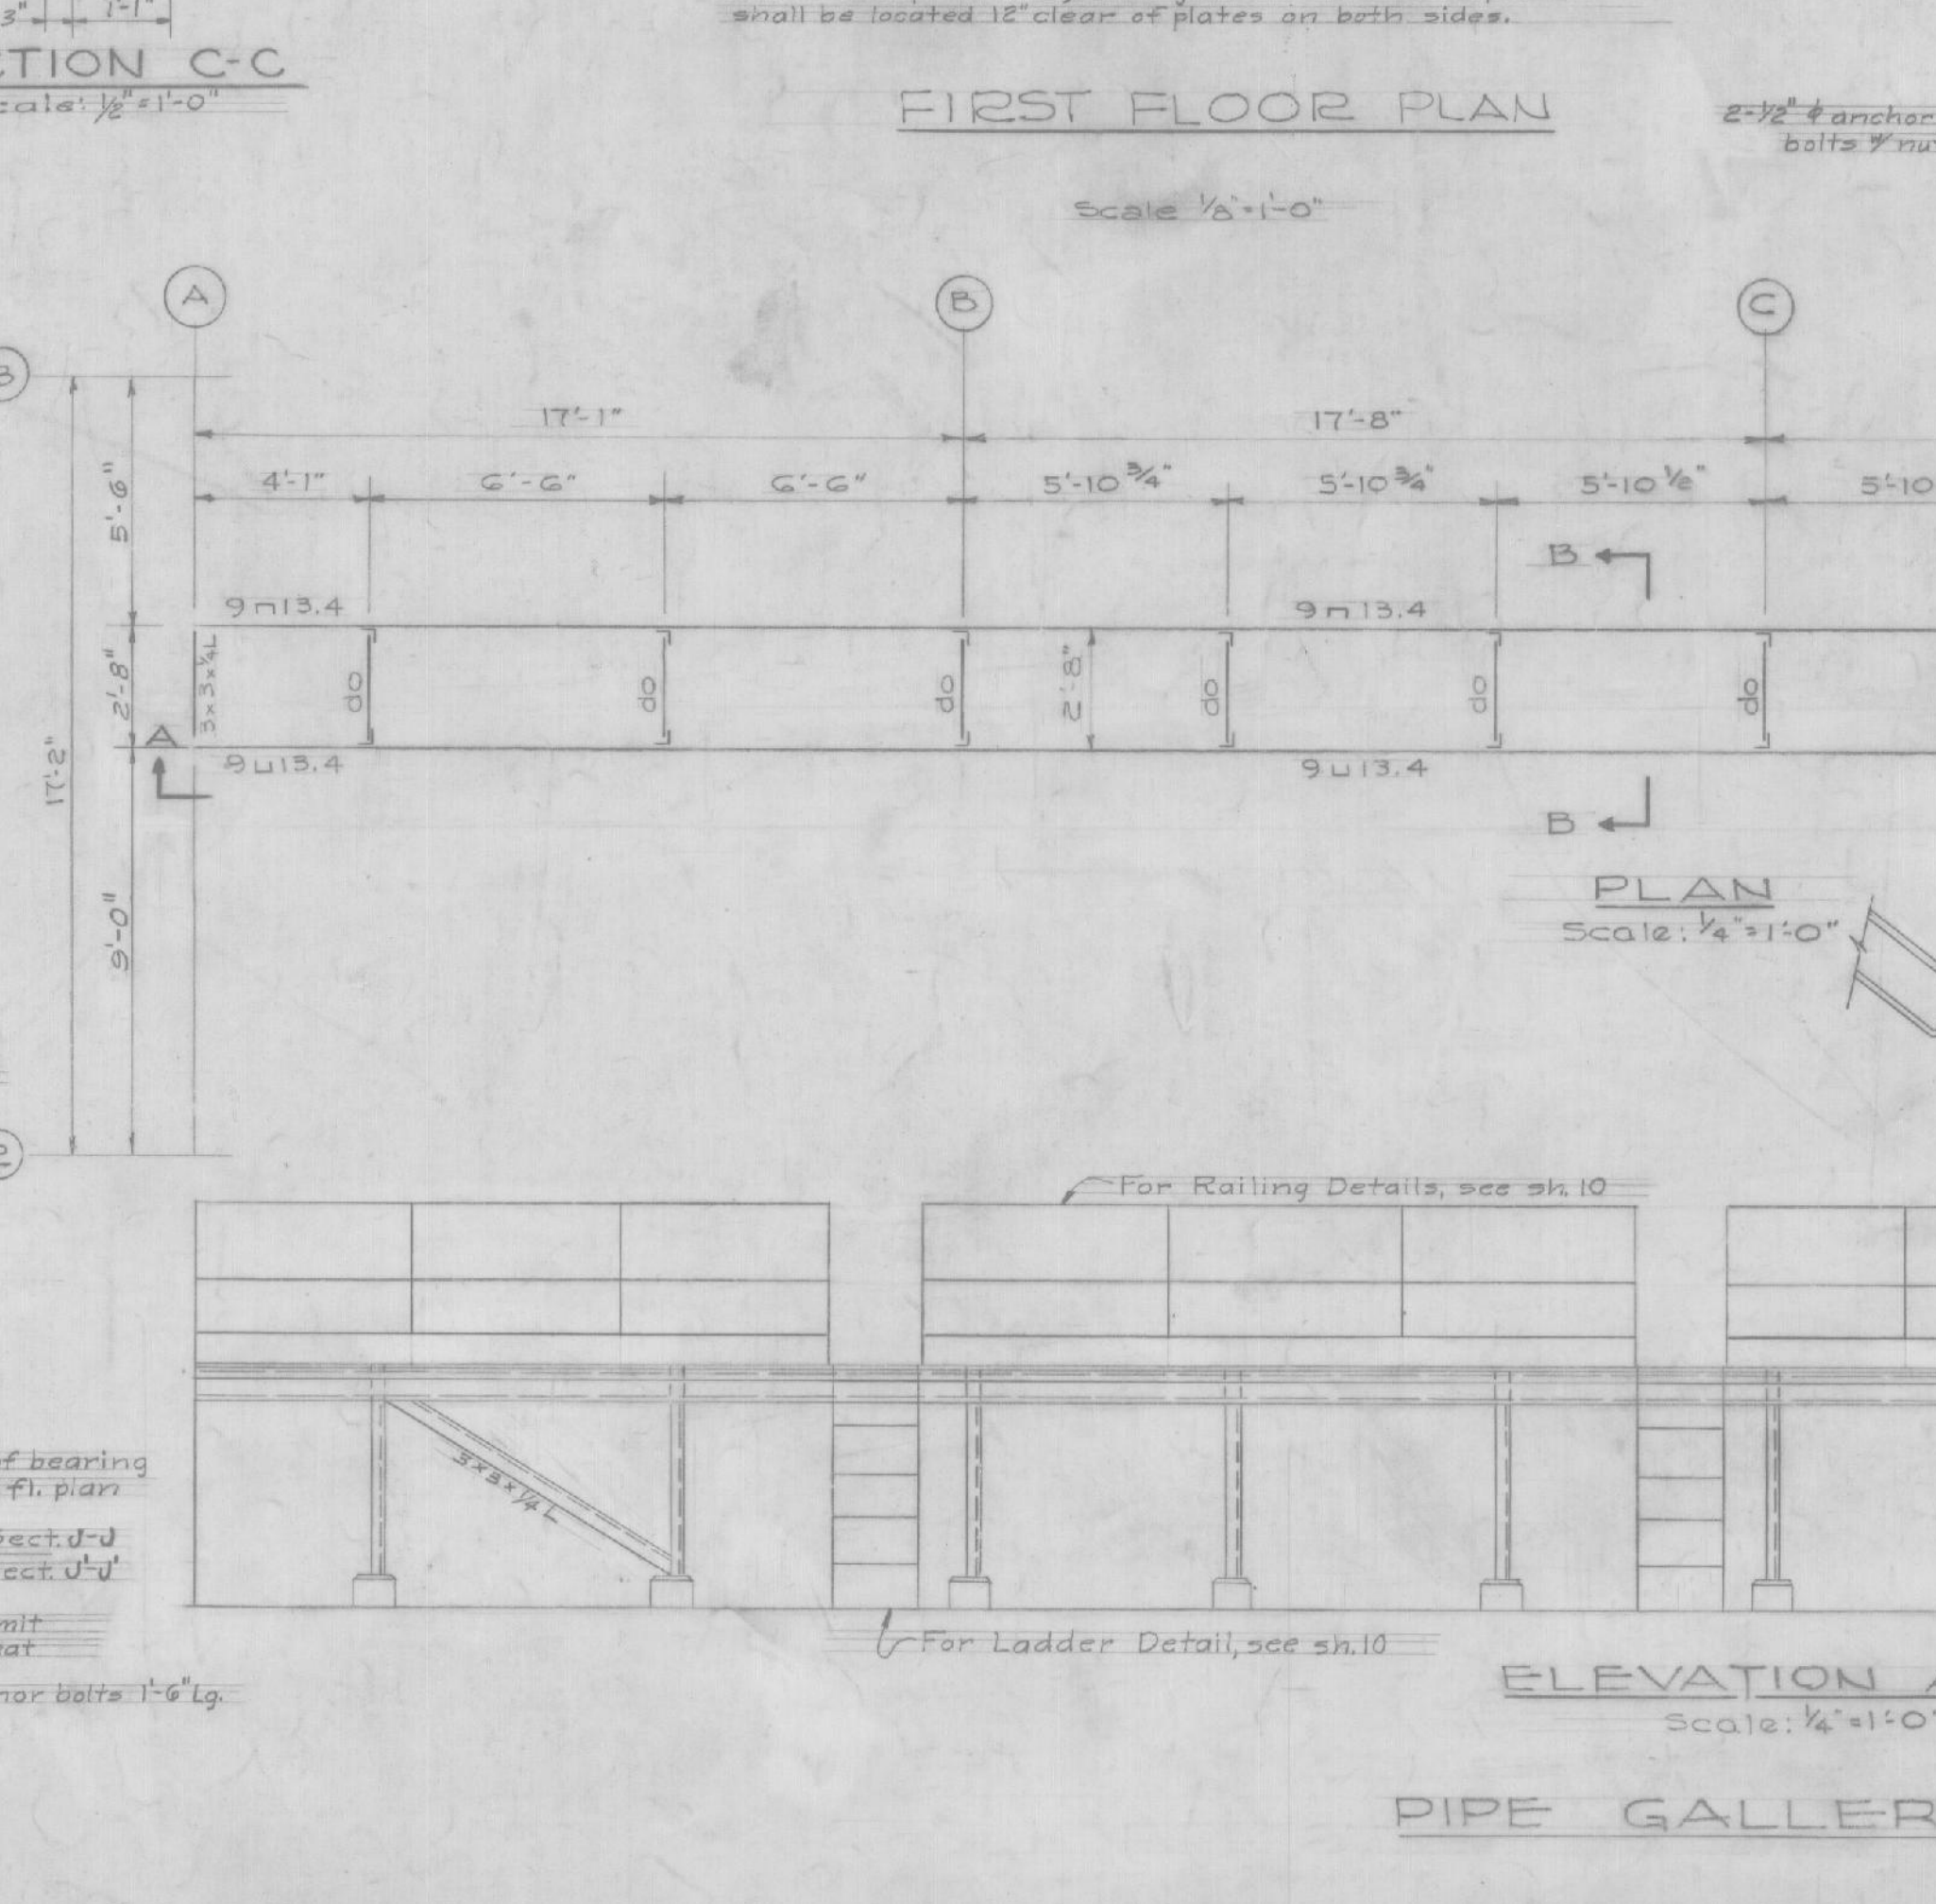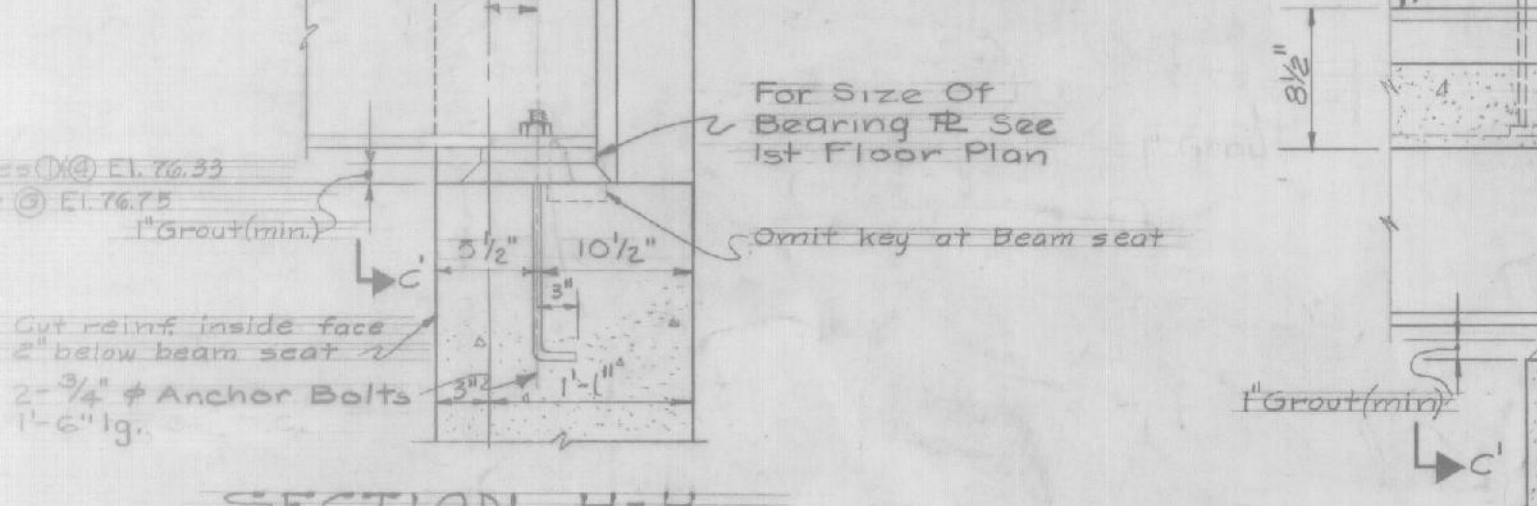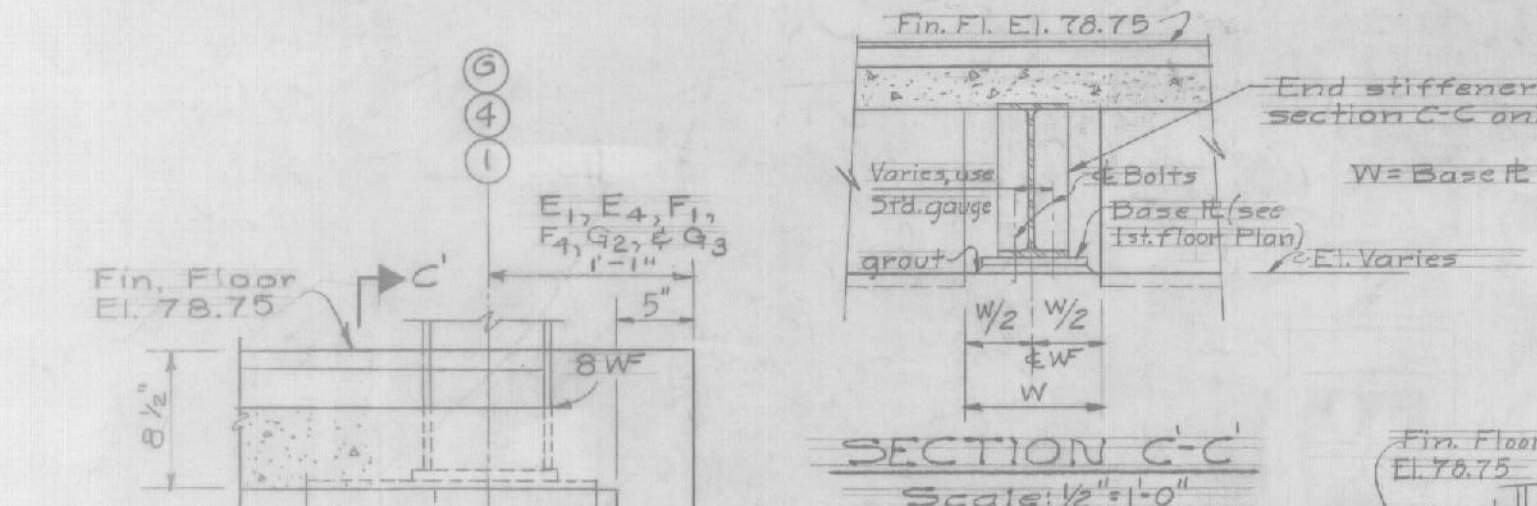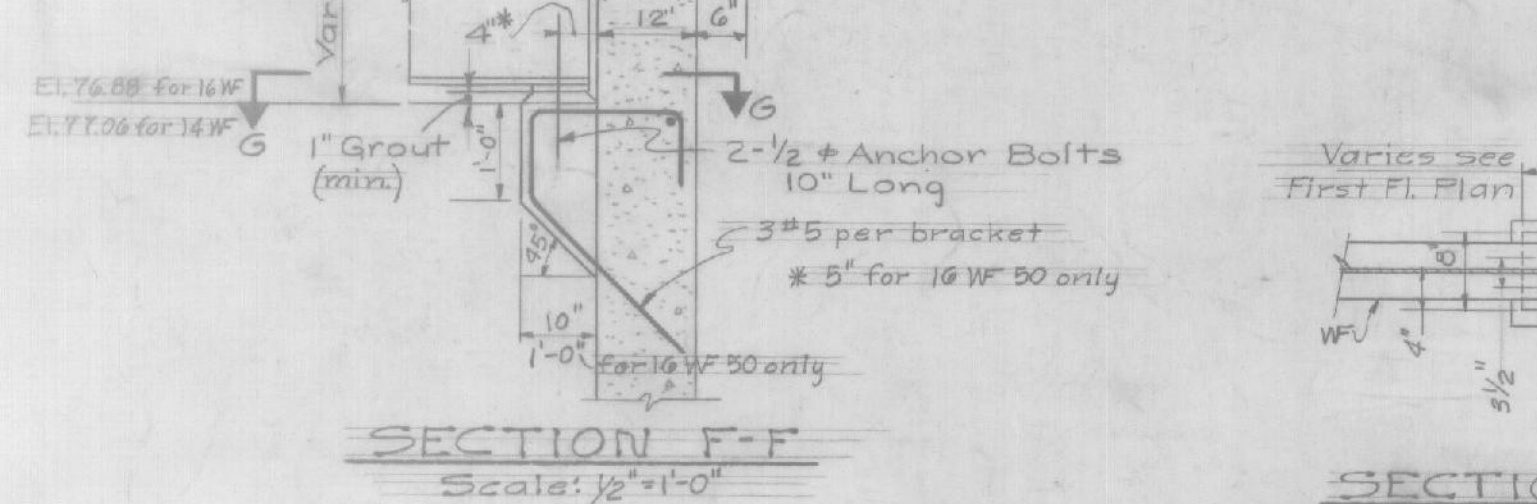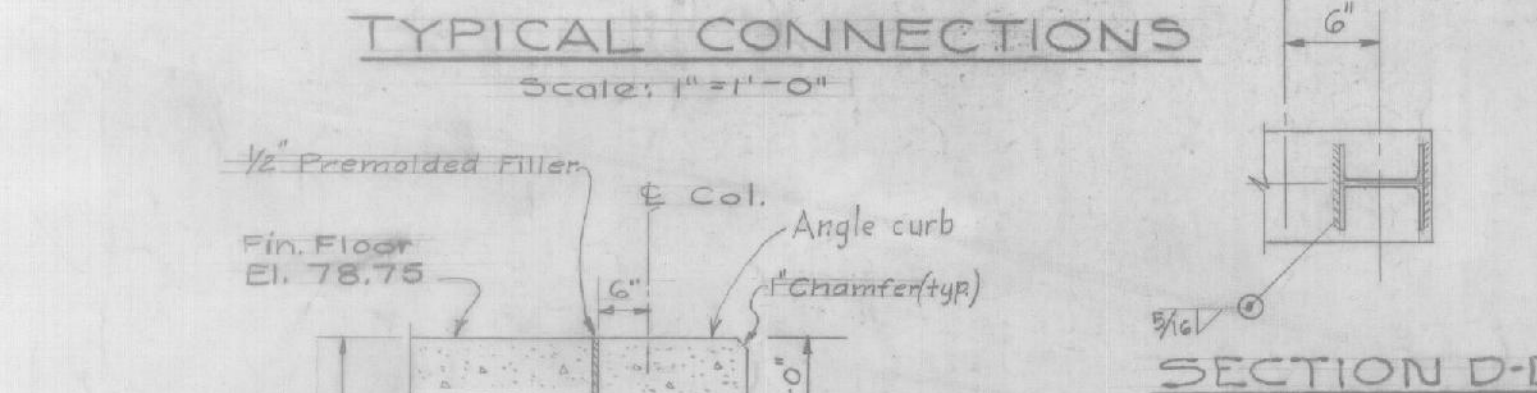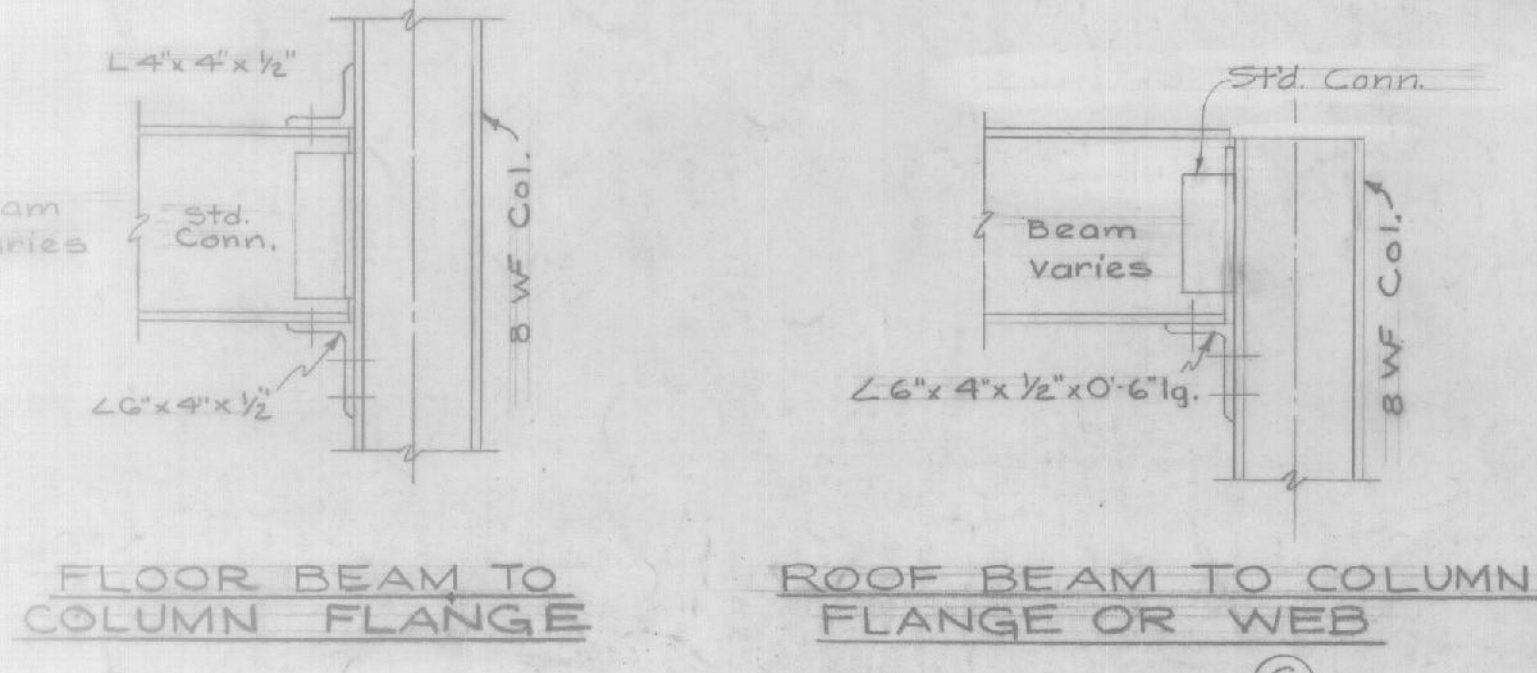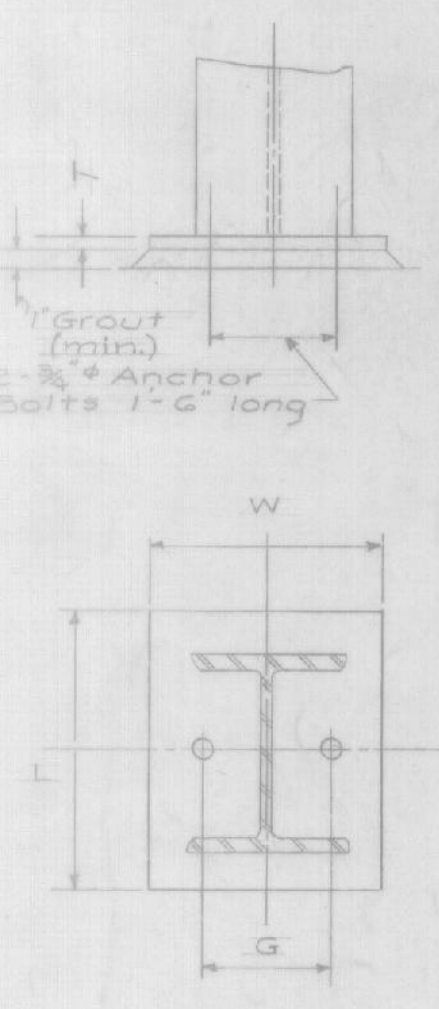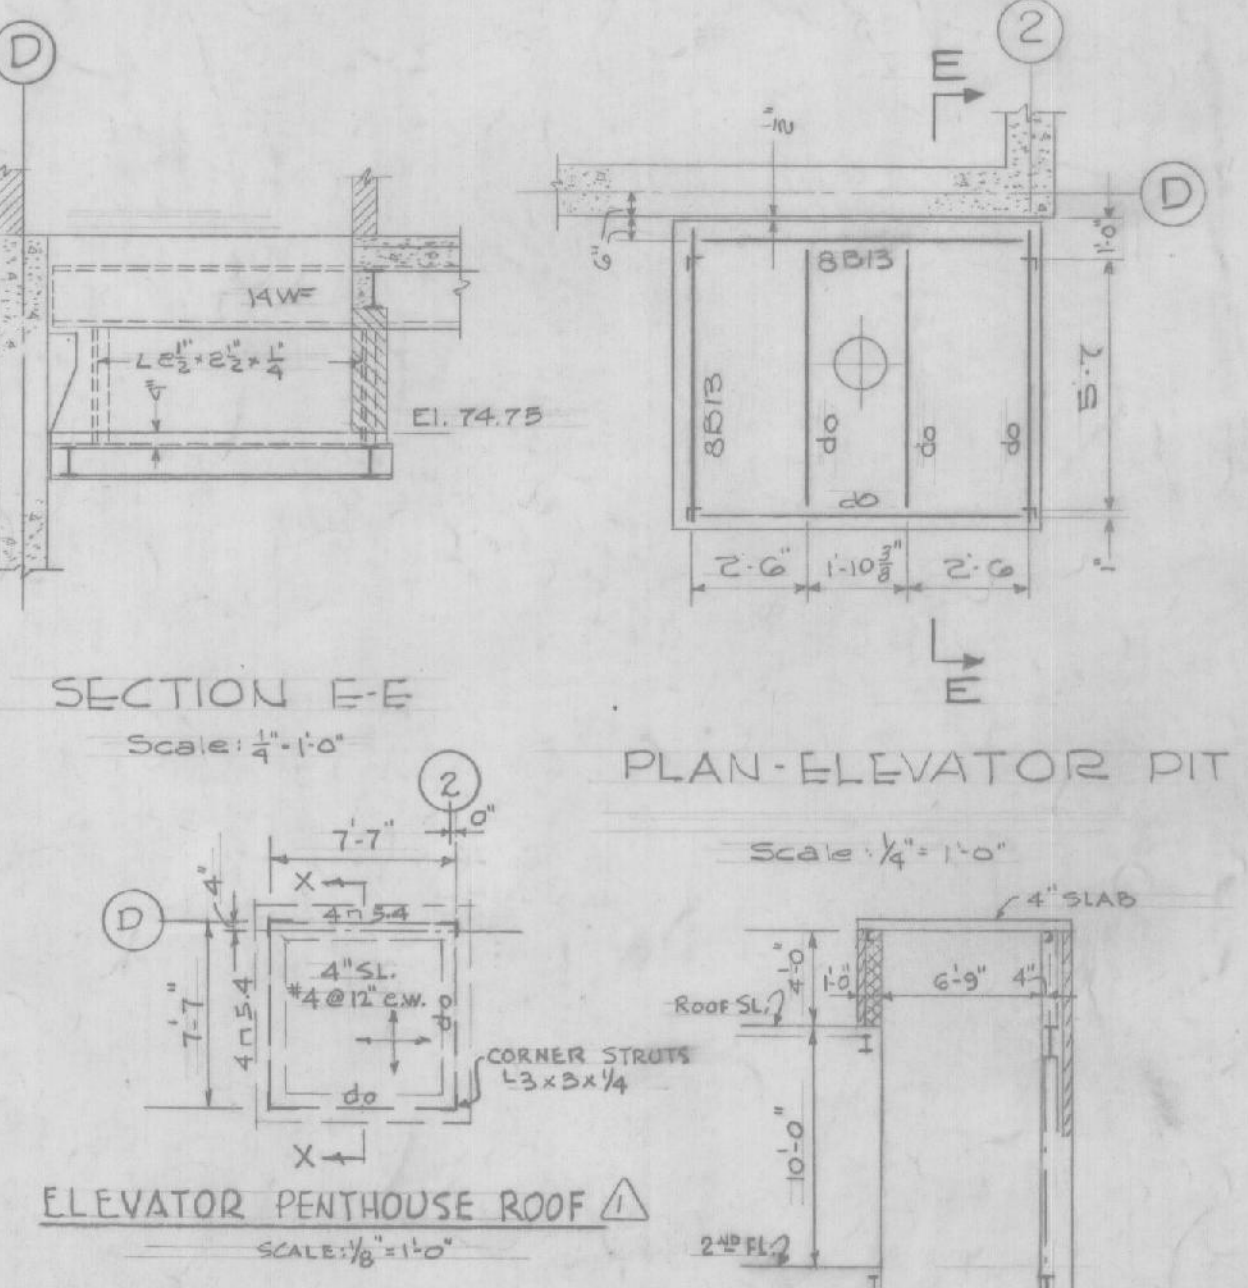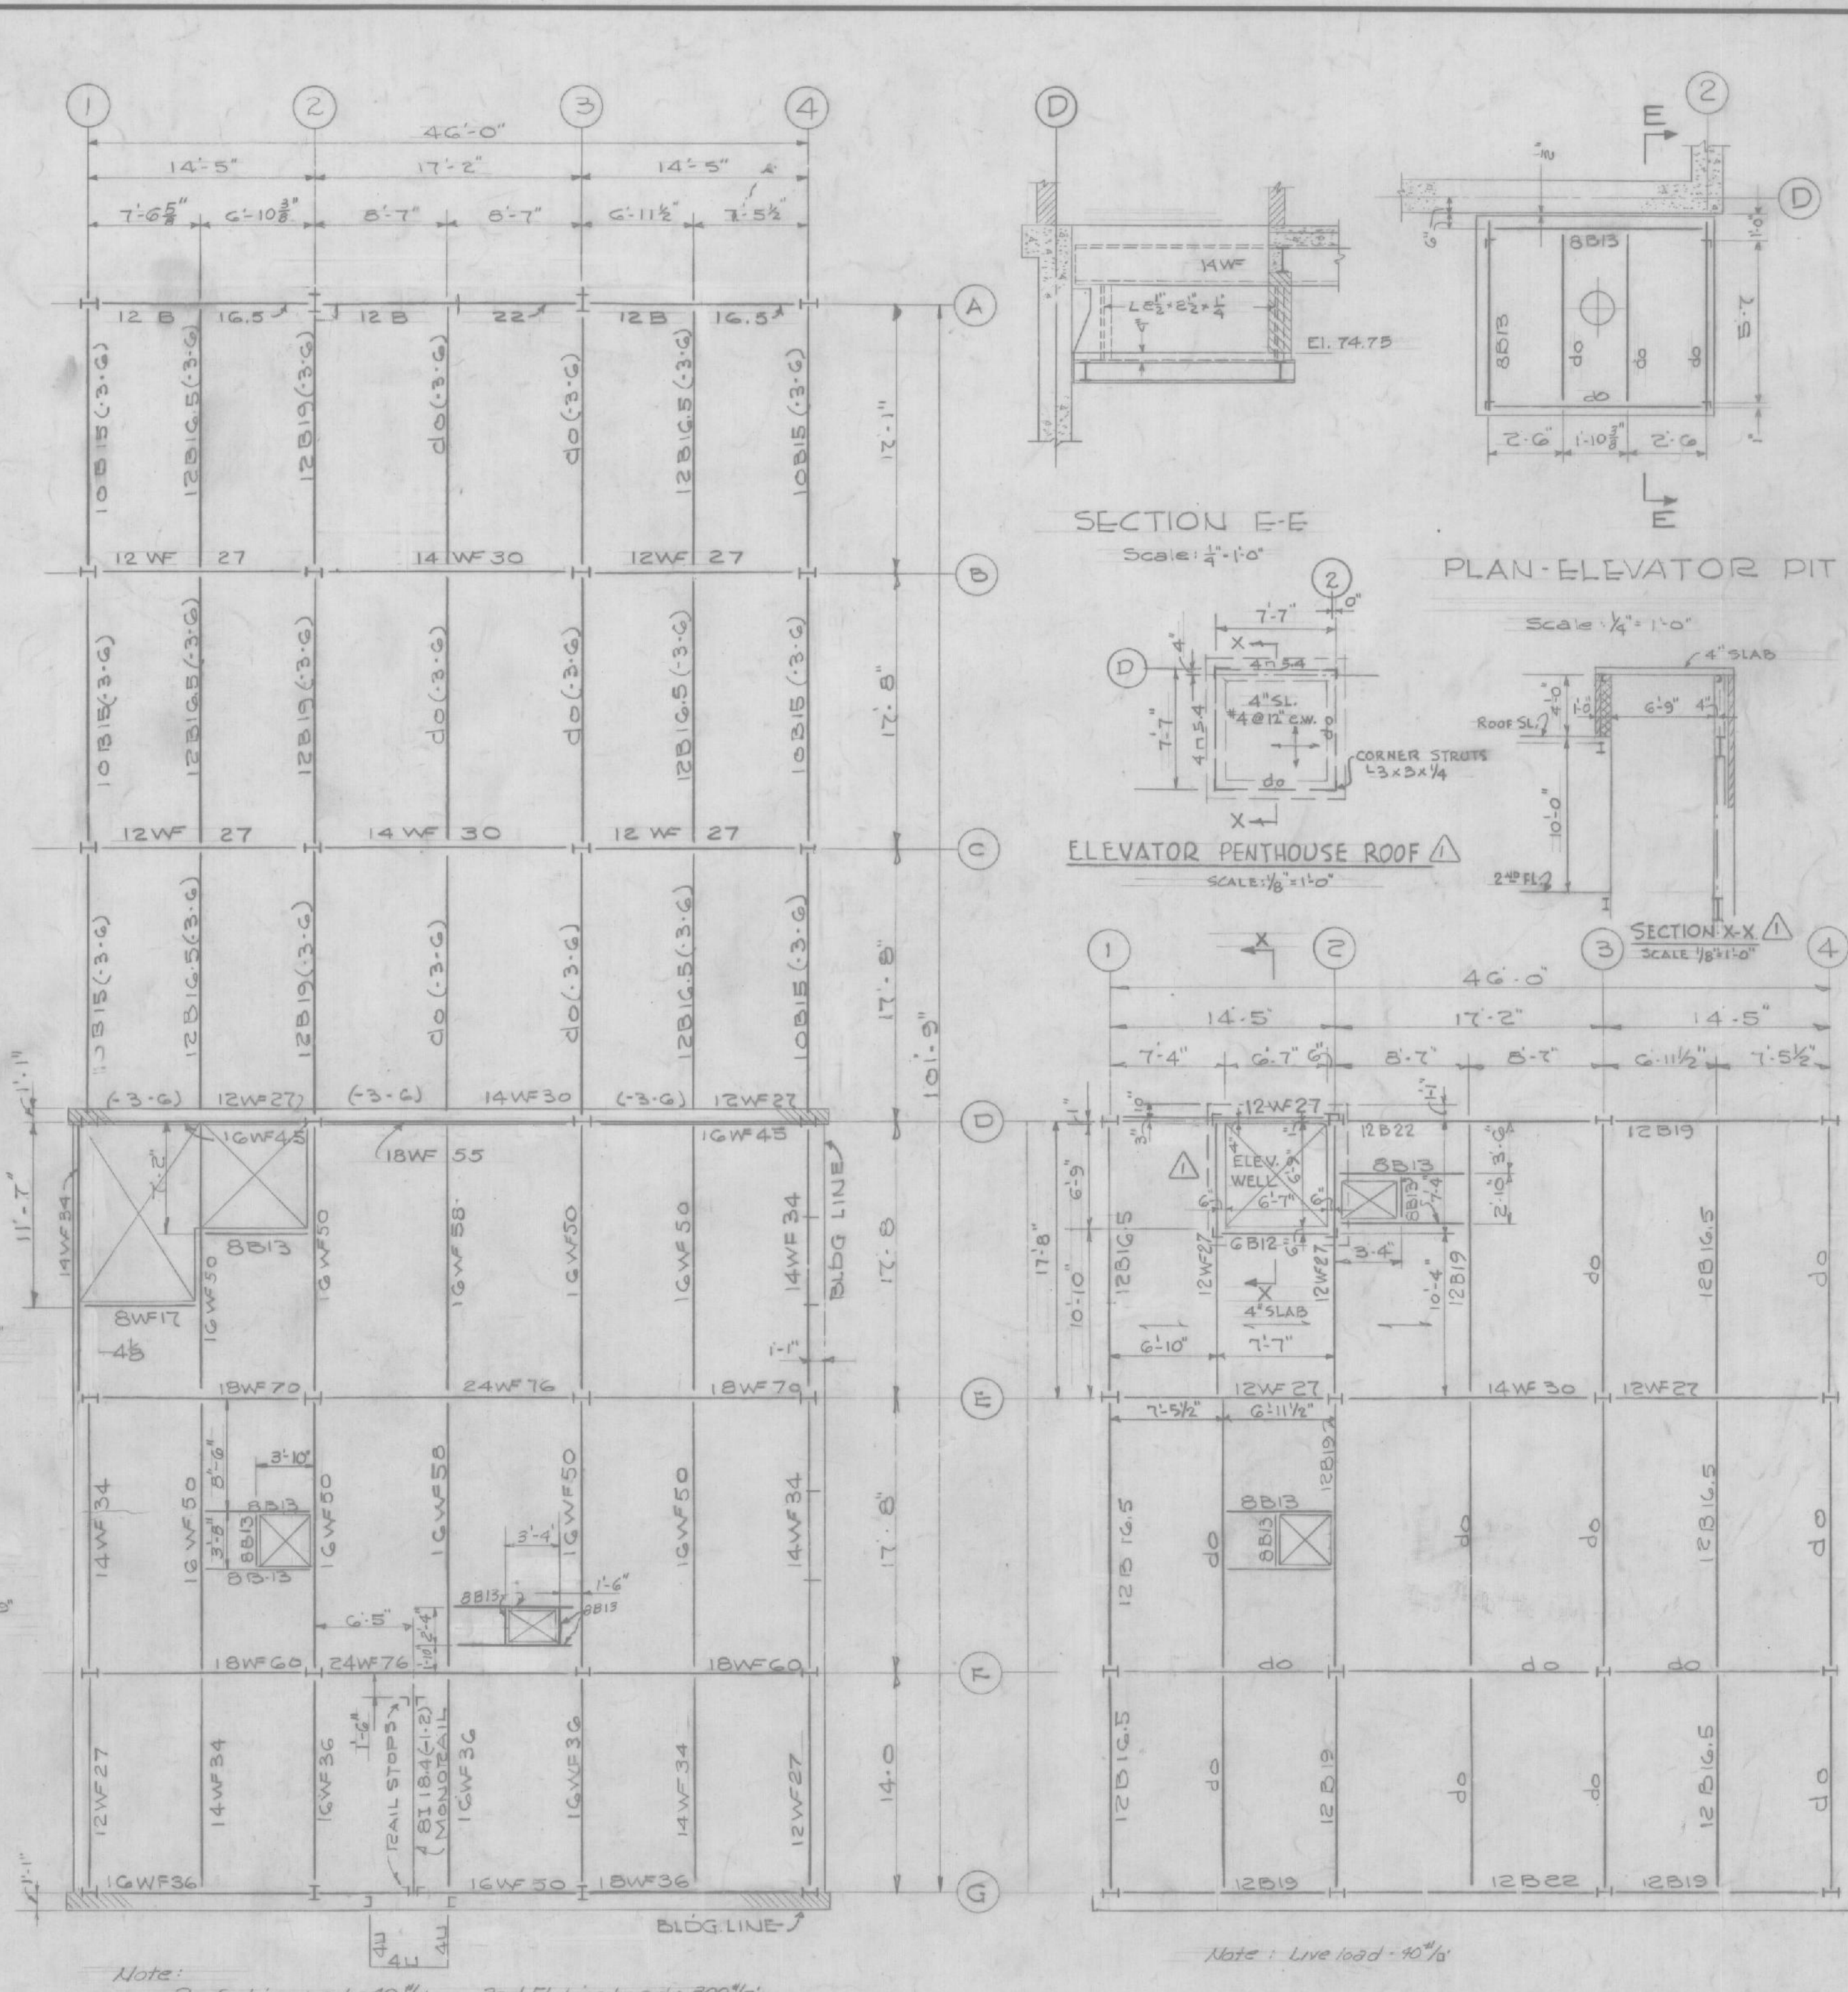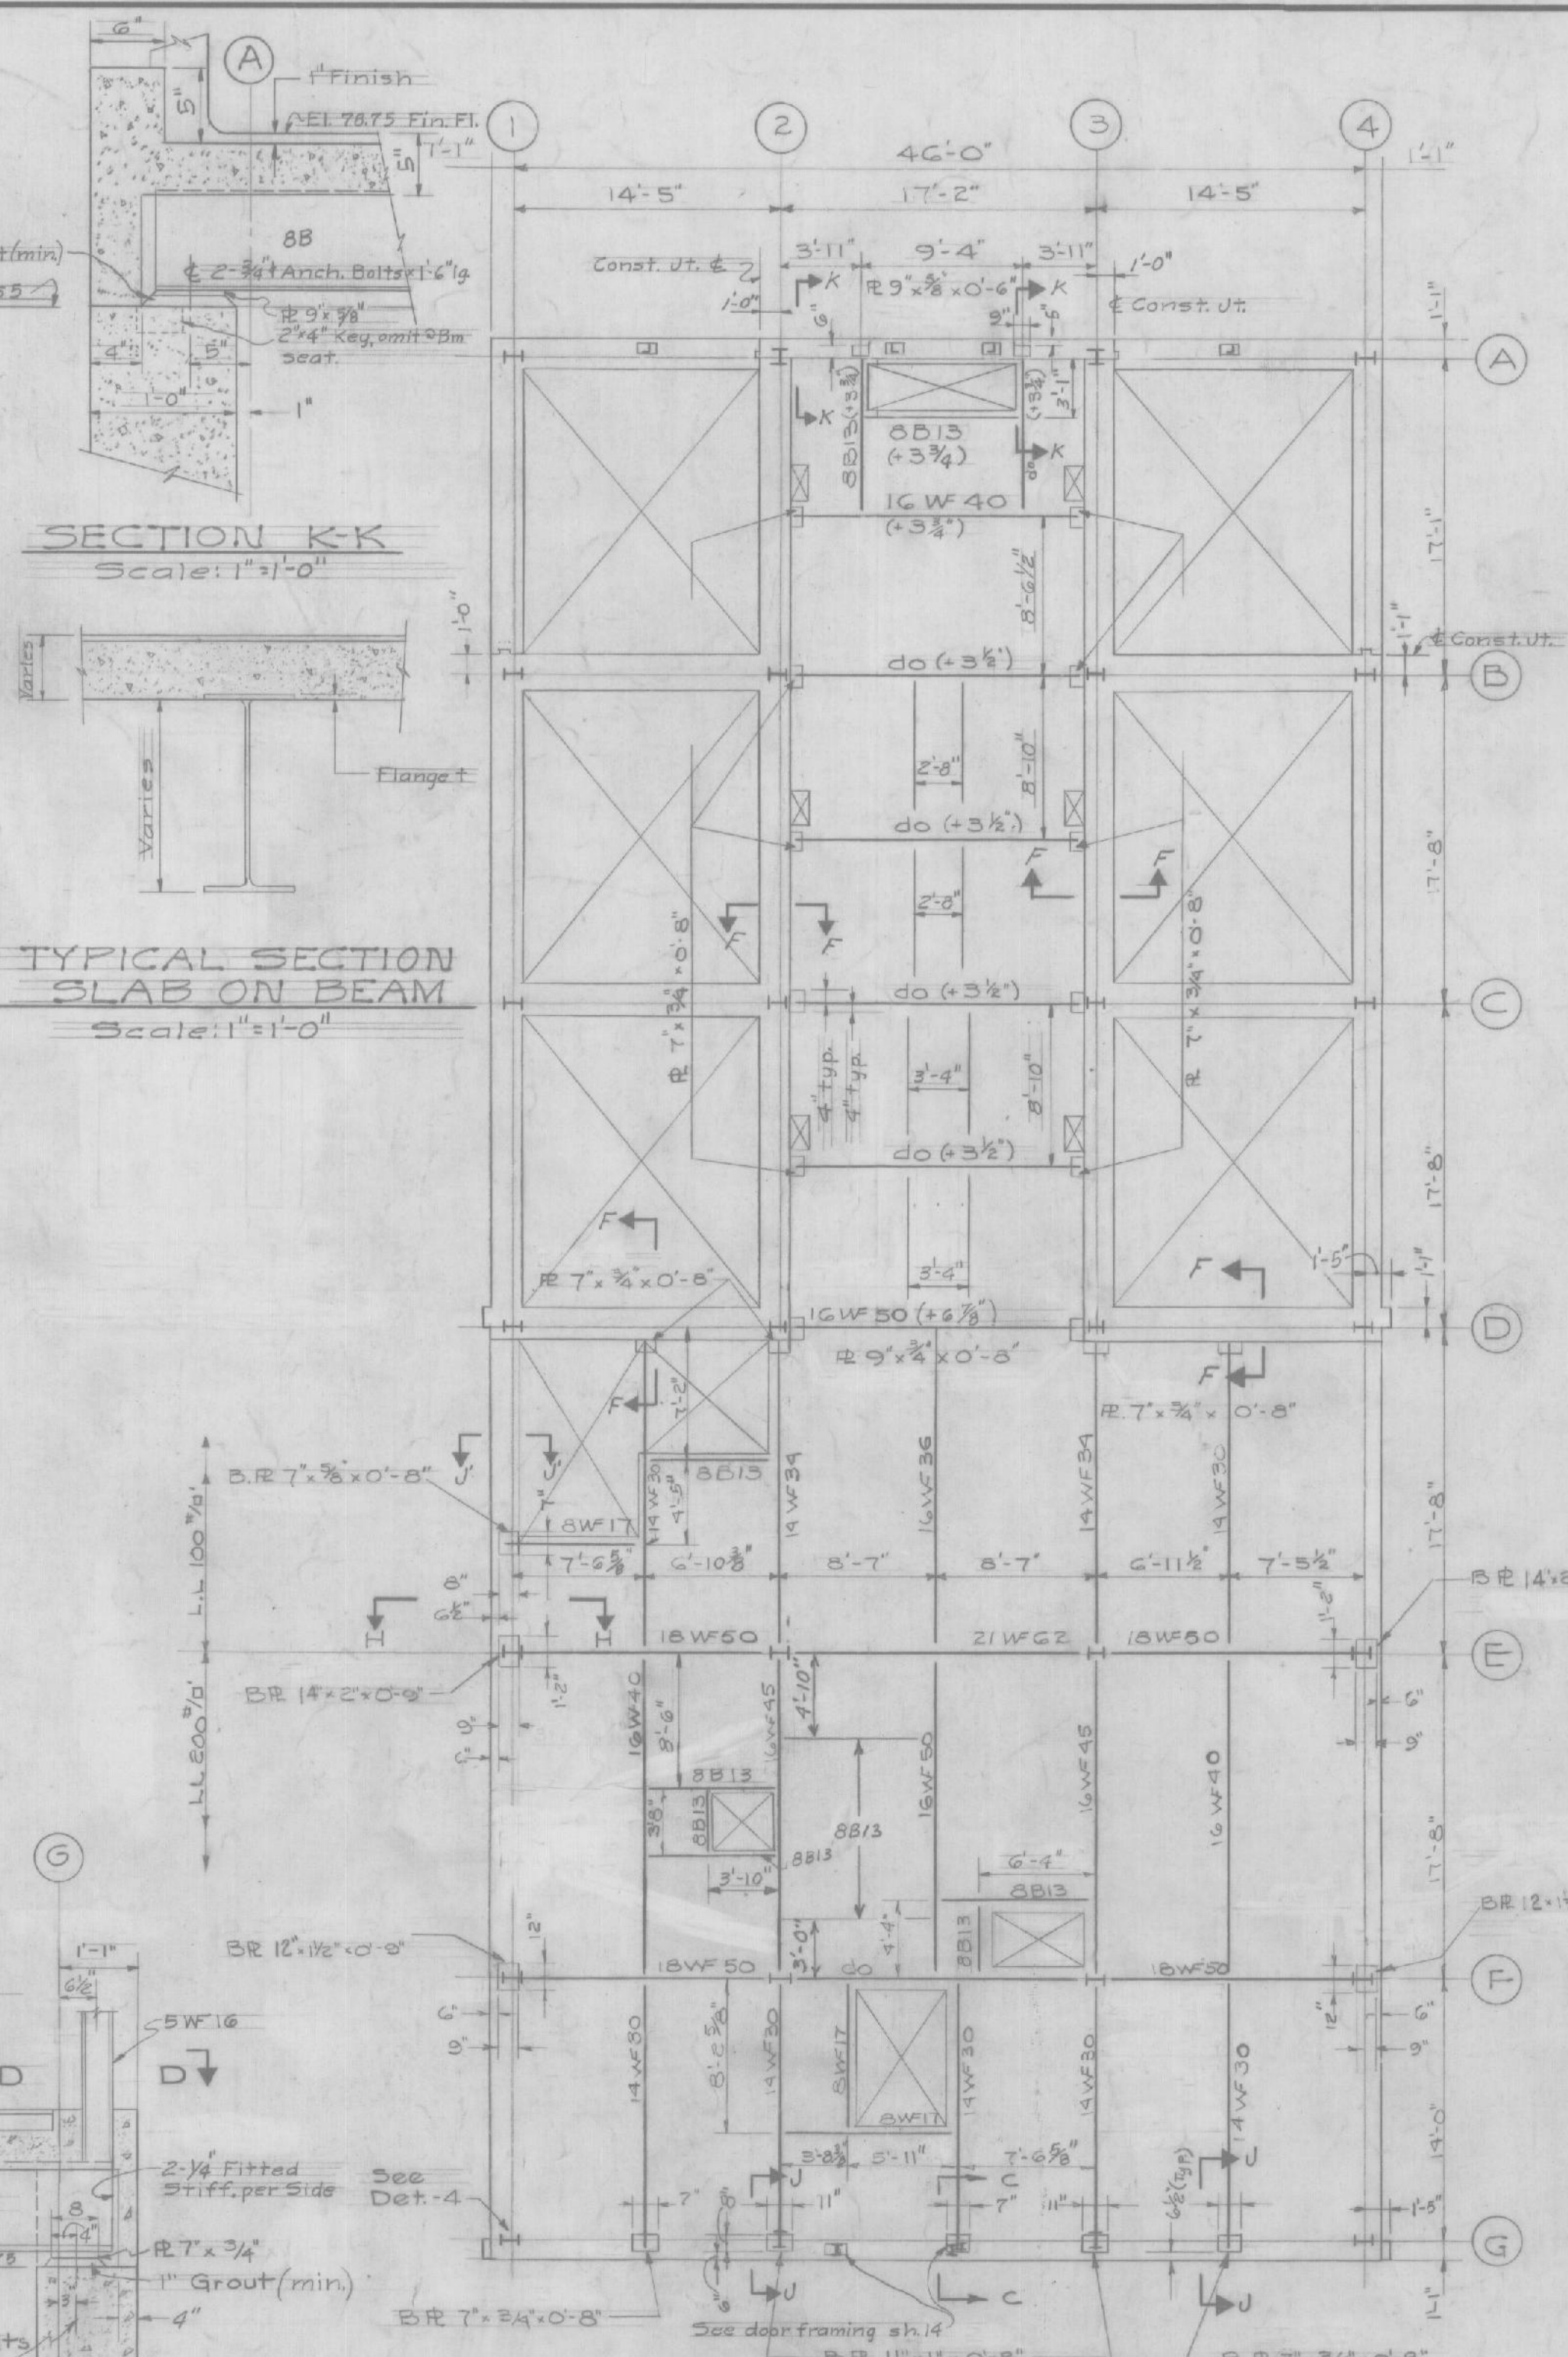




- NOTES:
- All rivets to be 3/8" x 1 1/4" H.H.S.
 - Shop connections - secondary framing, 3/8" rivets except as noted.
 - Field connections - Main members (12" and up) 3/8" rivets or high-strength bolts; Secondary members (all 10" and smaller) 3/4" bolts.
 - The structural floor framing will be changed from 18WF55 to 14WF45. Connections to columns & of adjacent members will be modified accordingly to maintain the top elevation of 90.5 feet.

4-17-62	Final Field Corrections		
4-14-62	High roof plan revised; plan & section added.		
REVISION	DATE	DESCRIPTION	BY
WHITMAN & HOWARD, INC. ENGINEERS 89 BROAD ST., BOSTON, MASS.		CORPS OF ENGINEERS, U. S. ARMY OFFICE OF THE DIVISION ENGINEER NEW ENGLAND DIVISION WALTHAM, MASS.	
DRAWN BY:	Z.V.S.	PEASE AIR FORCE BASE PORTSMOUTH, NEW HAMPSHIRE SURFACE WATER SUPPLY FILTER BUILDING STRUCTURAL STEEL PLANS, SECTIONS & DETAILS	
TRACED BY:		DATE: JUNE, 1959	
CHECKED BY:	C.G.M.	DRAWING NUMBER: AN71-05-31	
SUBMITTED:	Harold D. Kilgus	SHEET 14	
APPROVED:	John W. Leslie	SCALE: As Noted	
APPROVED:	Raymond A. Pease	SPEC. NO. 100-100-100	
ENGINEERING DIVISION	CONSTRUCTION DIVISION	DRAWING NUMBER	

Record Drawing
Contract No. DA-19-016-ENG-6199

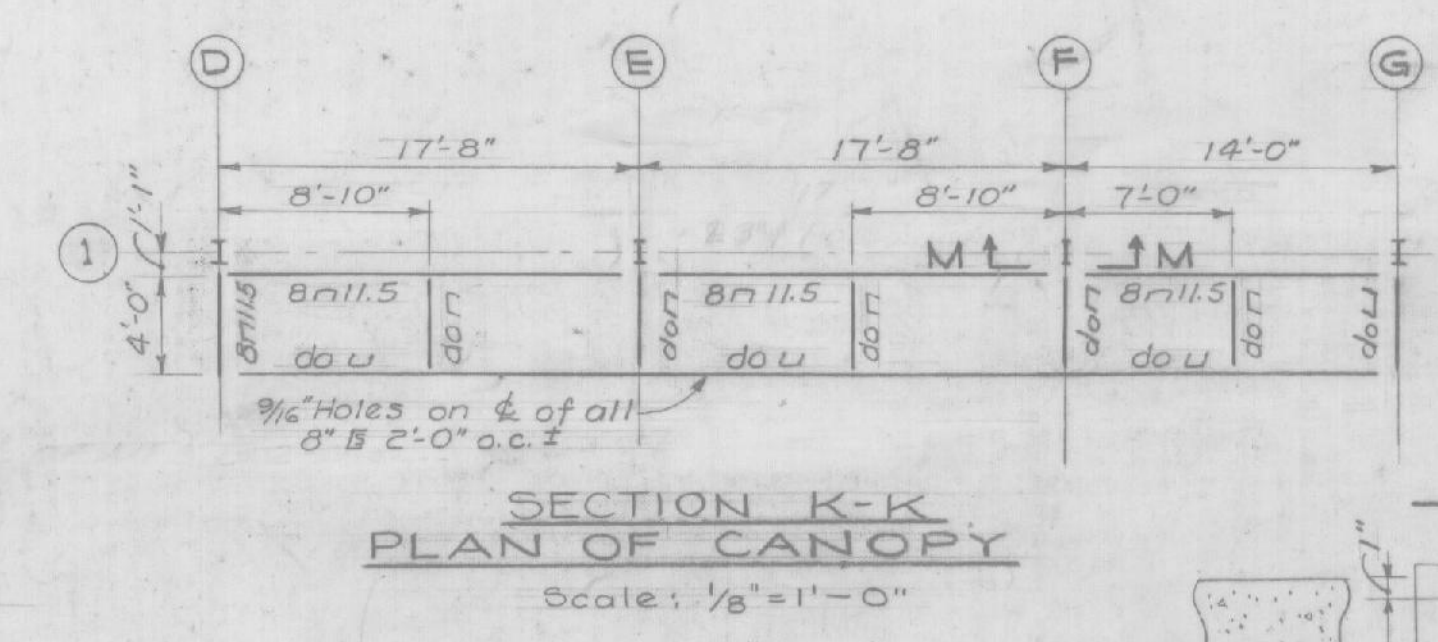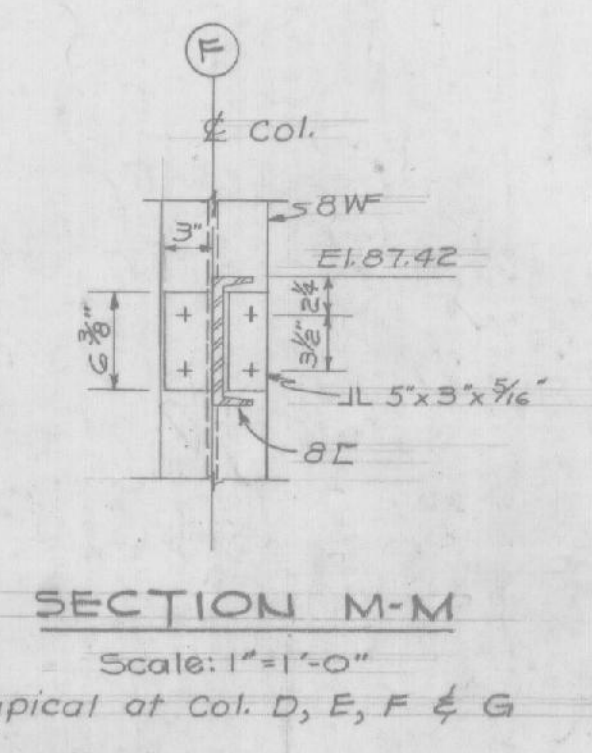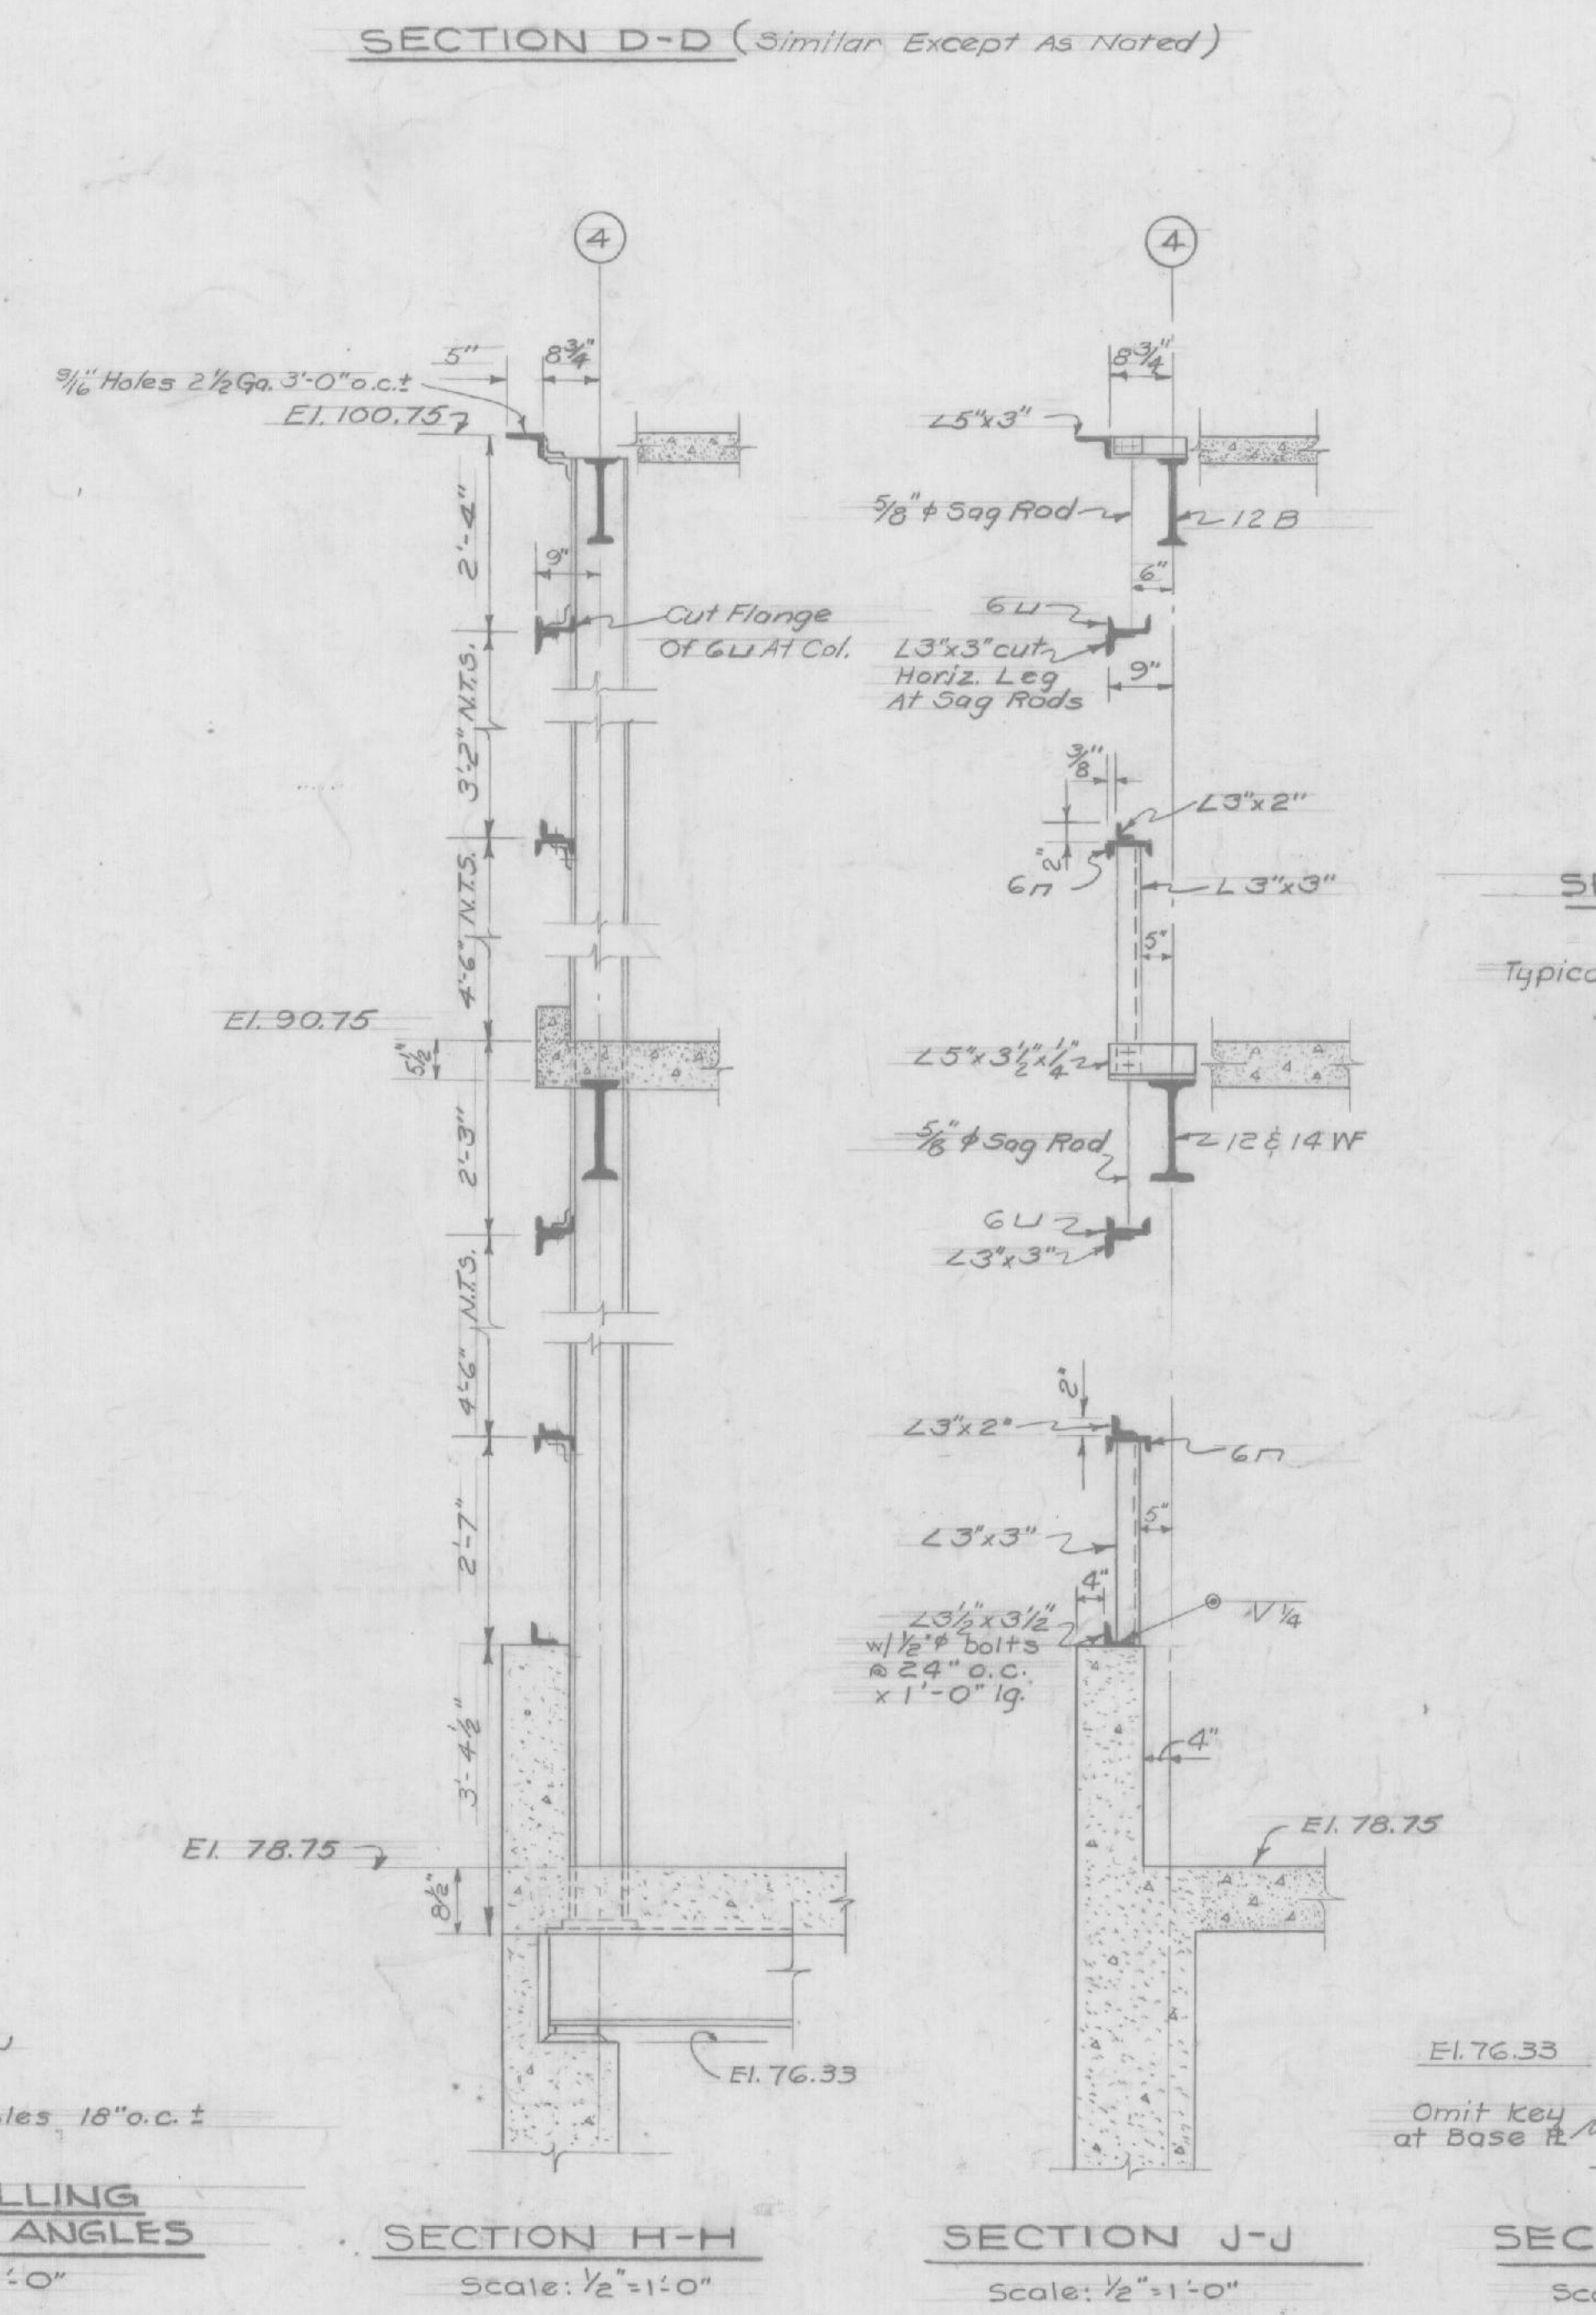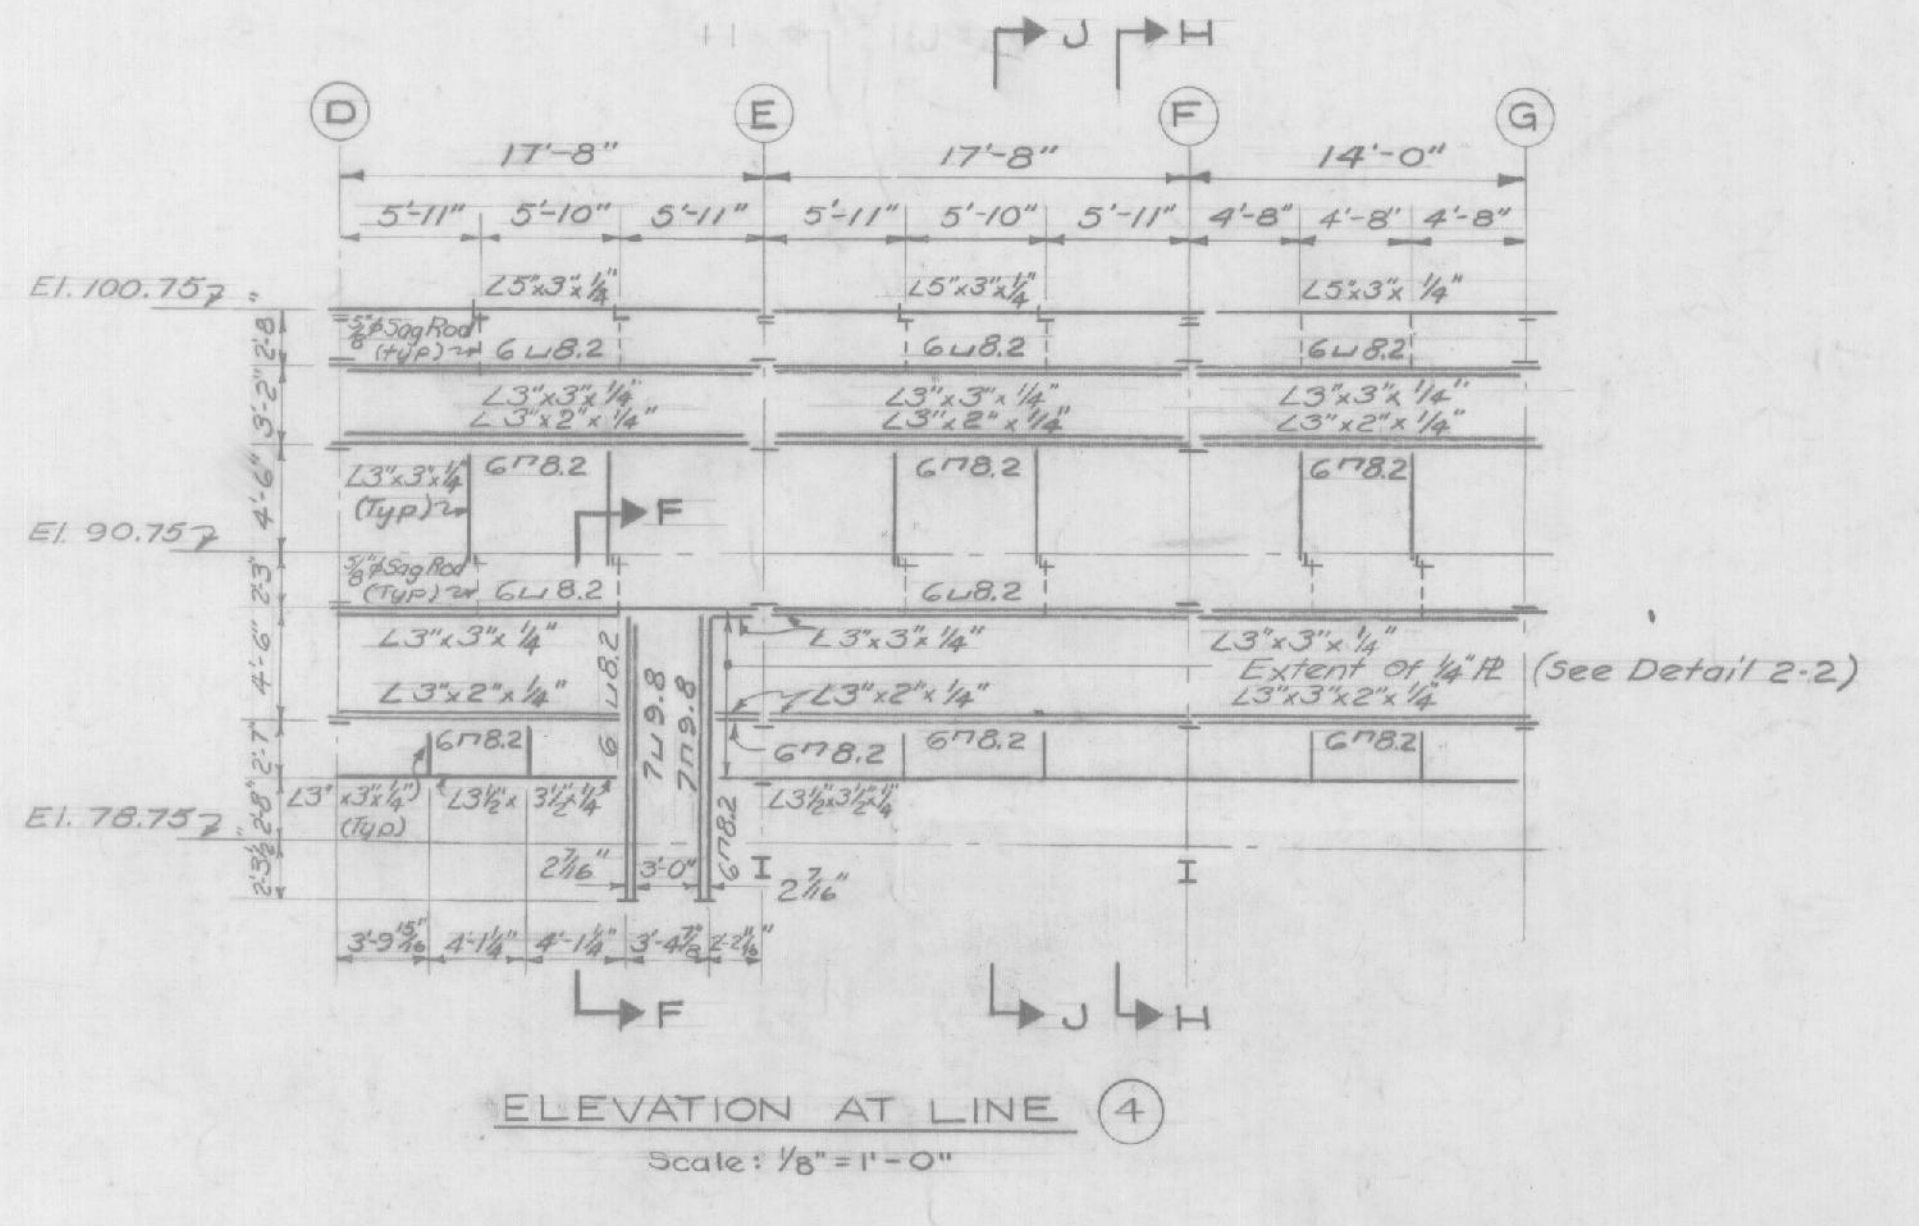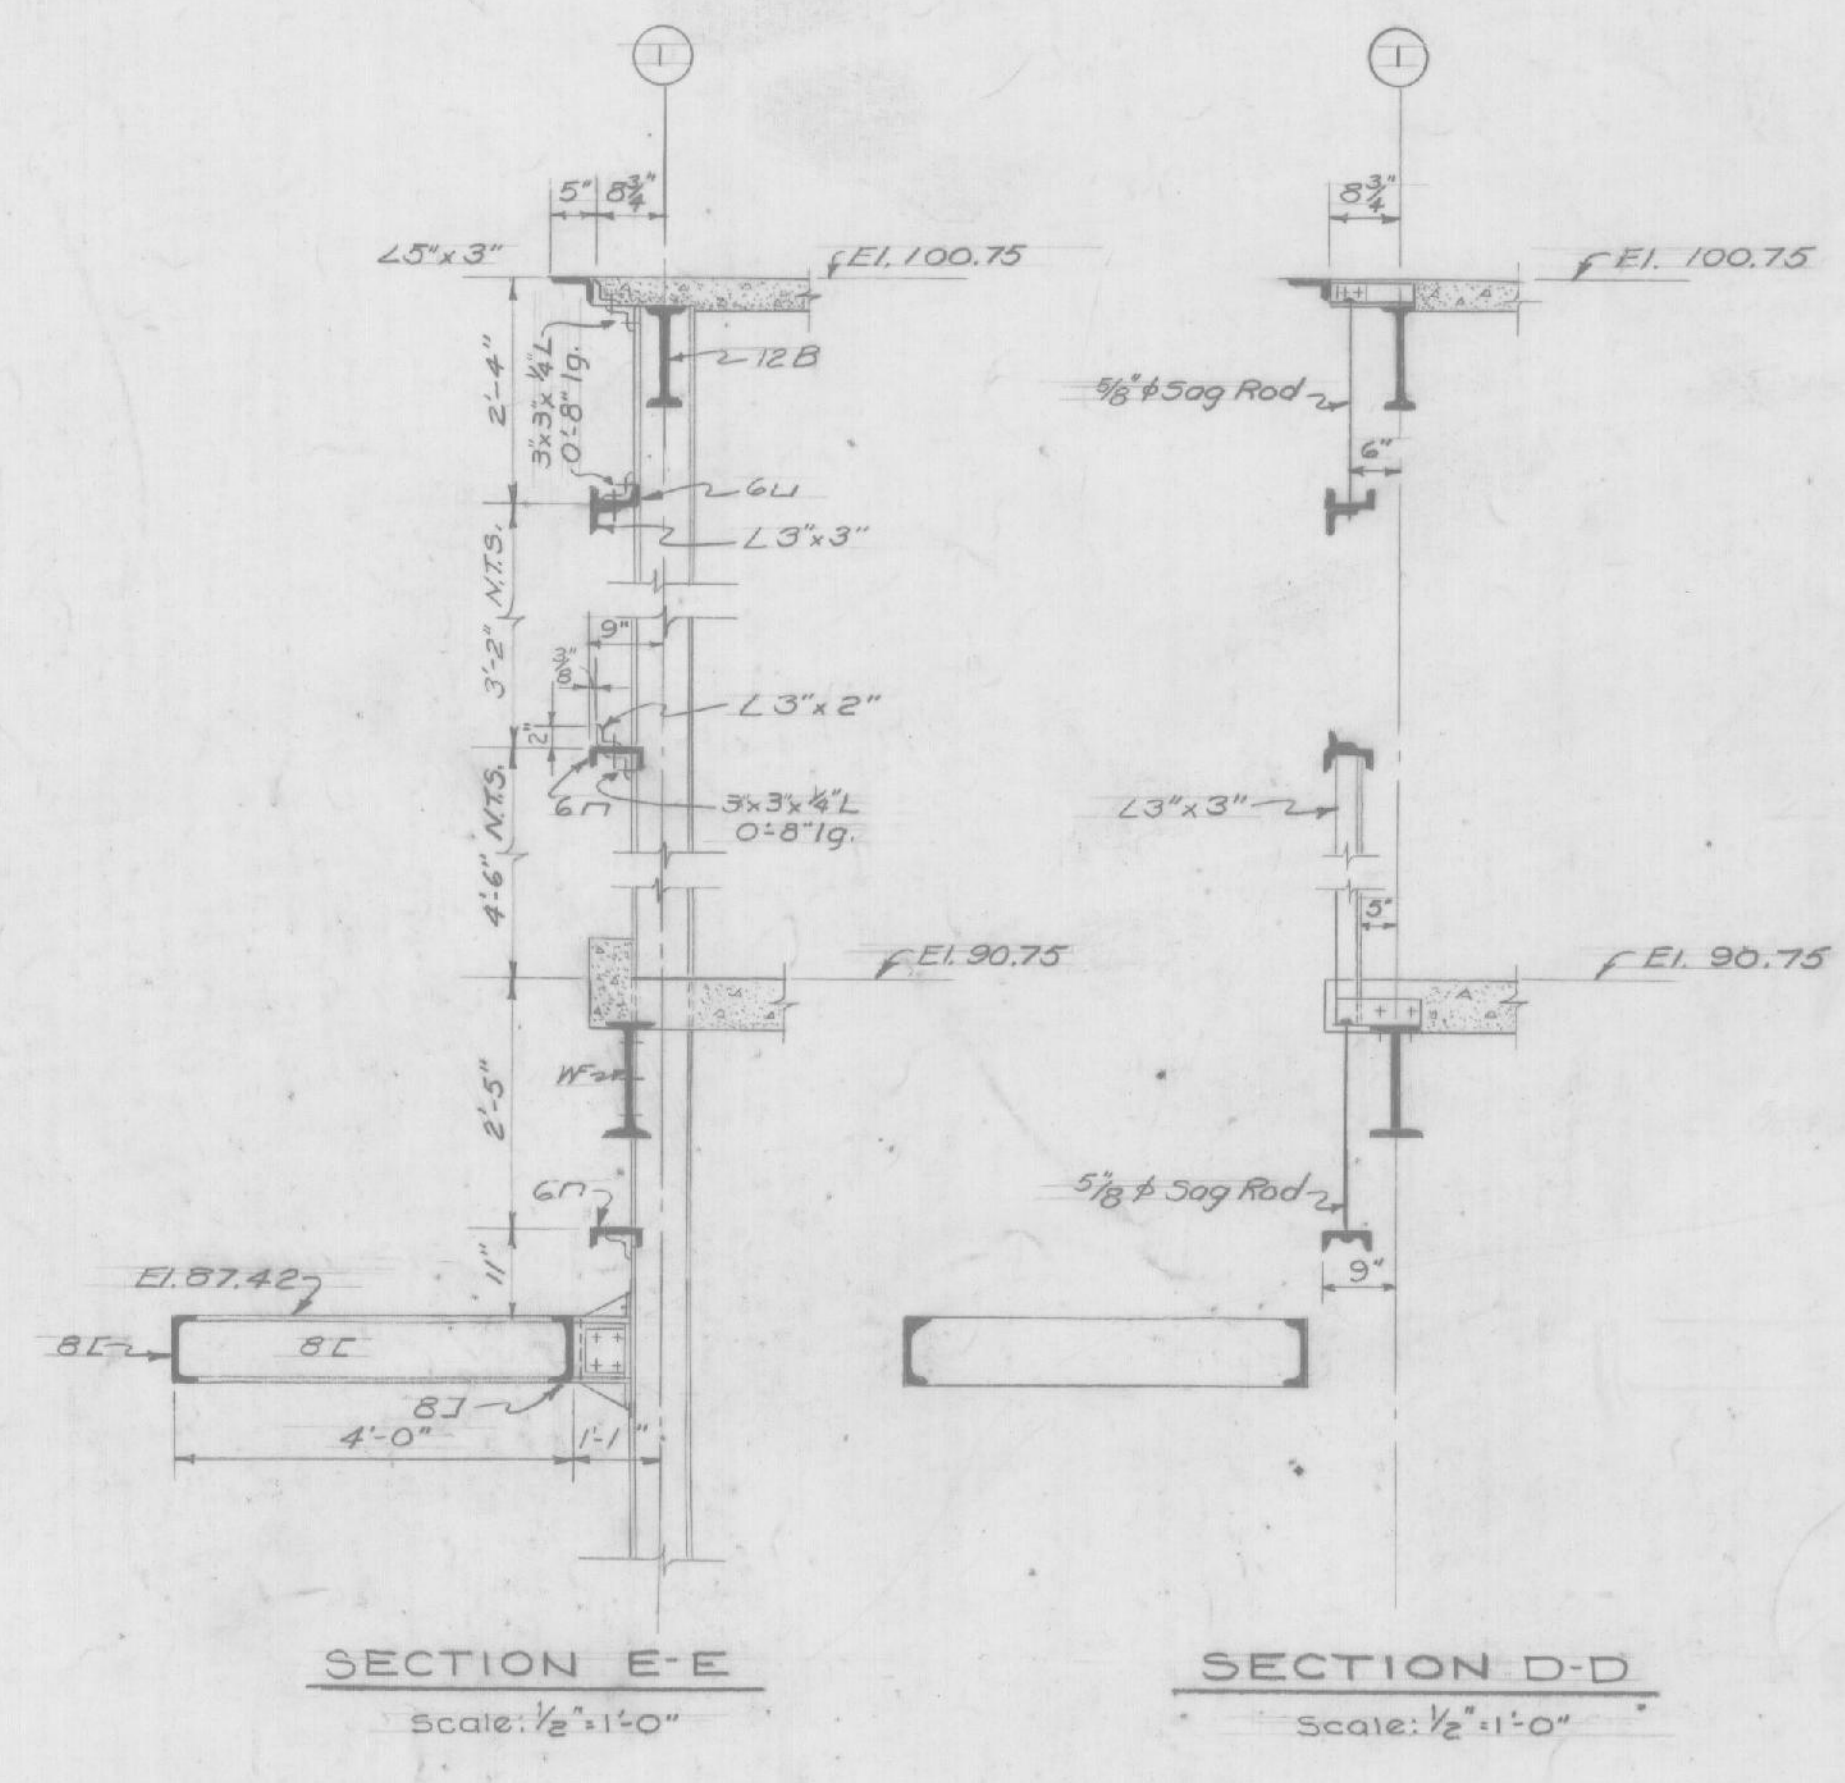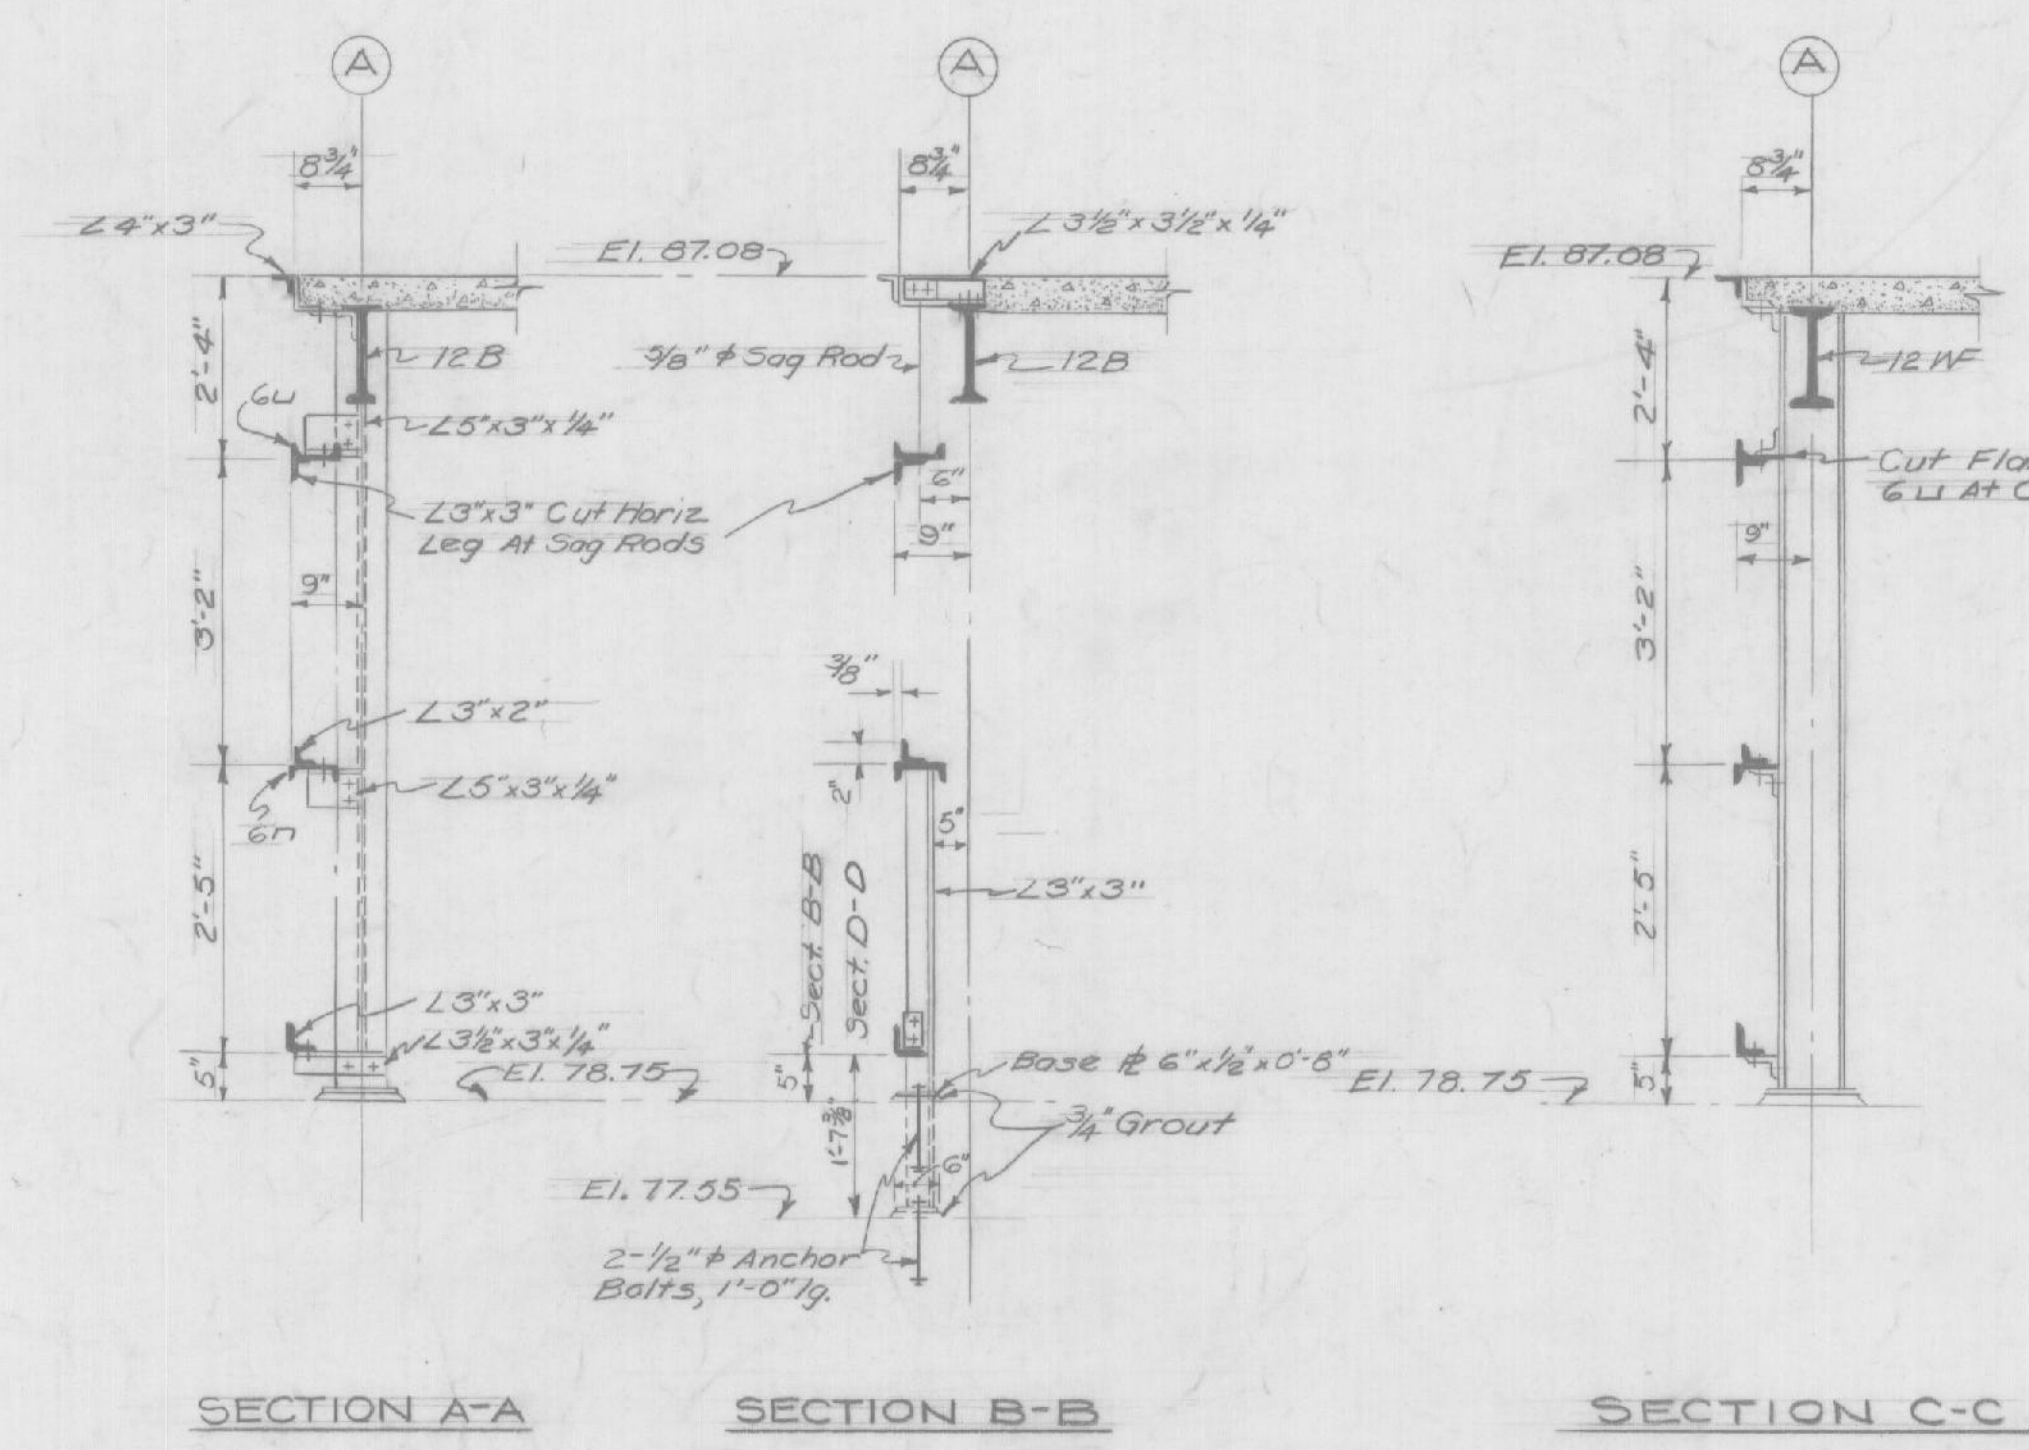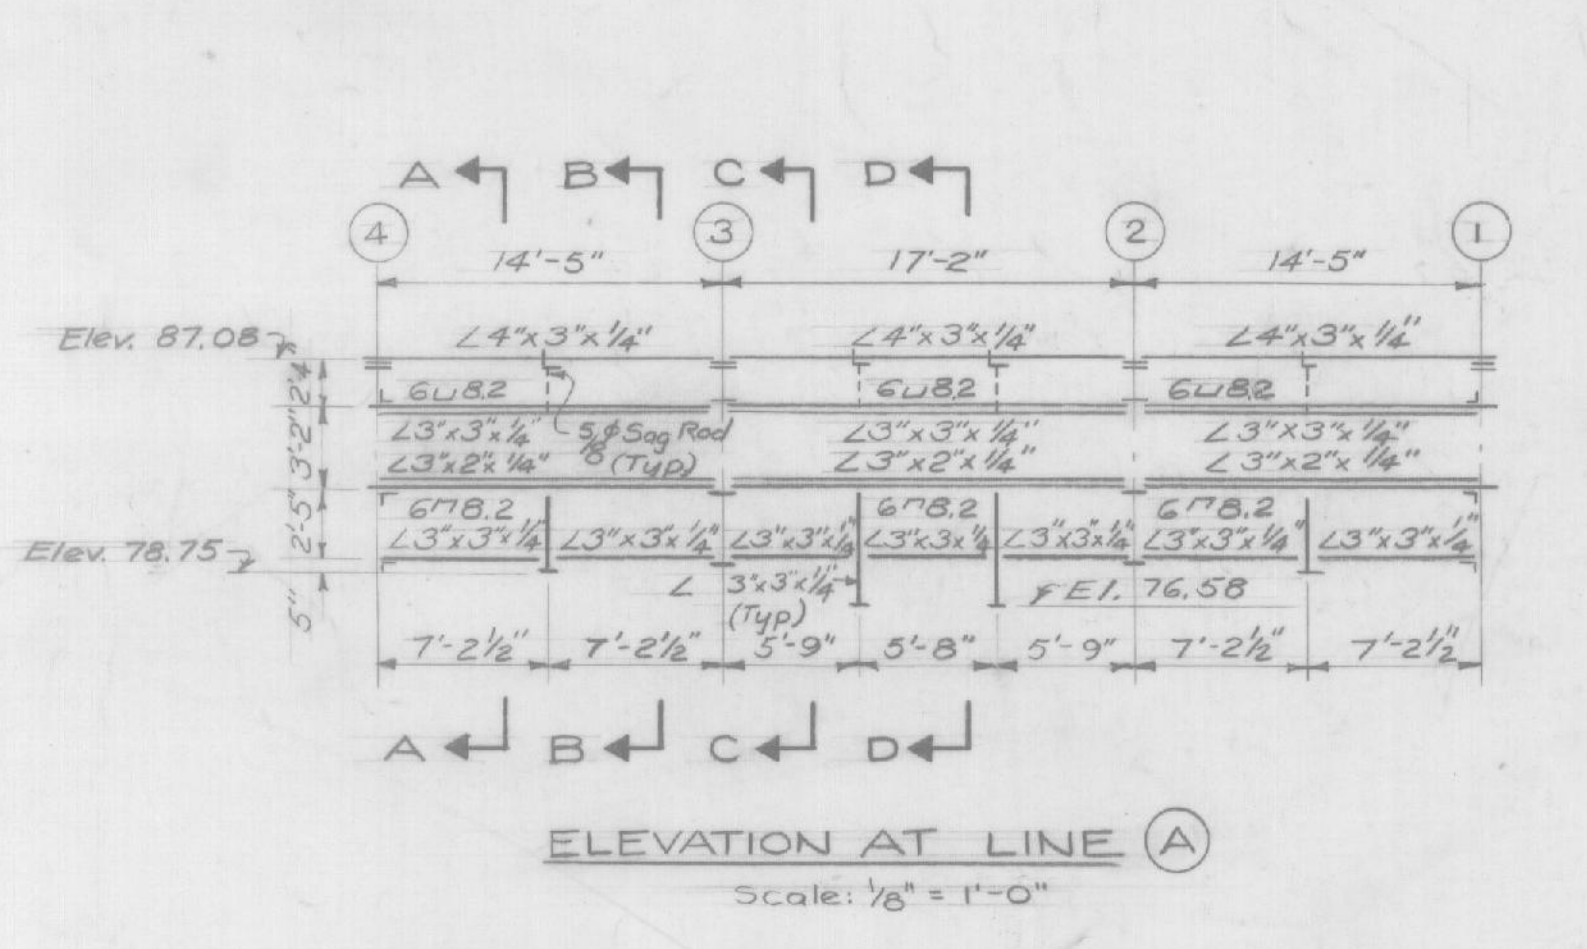

Record Drawing
Contract No. DA-19-016-ENG-6199

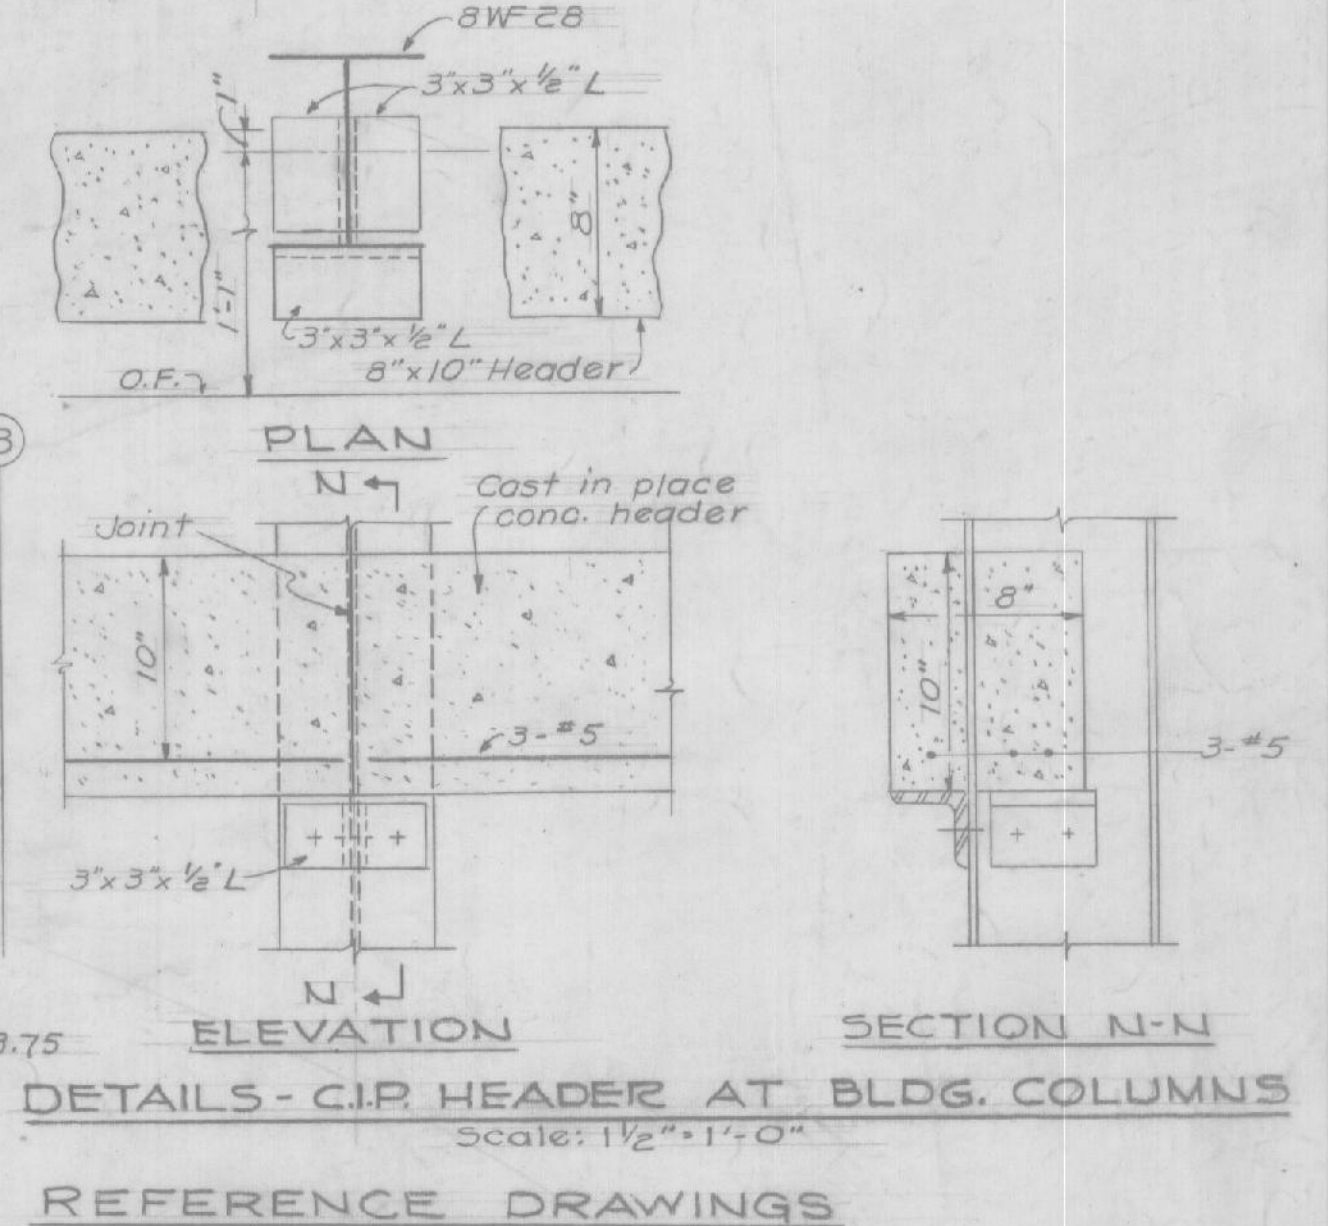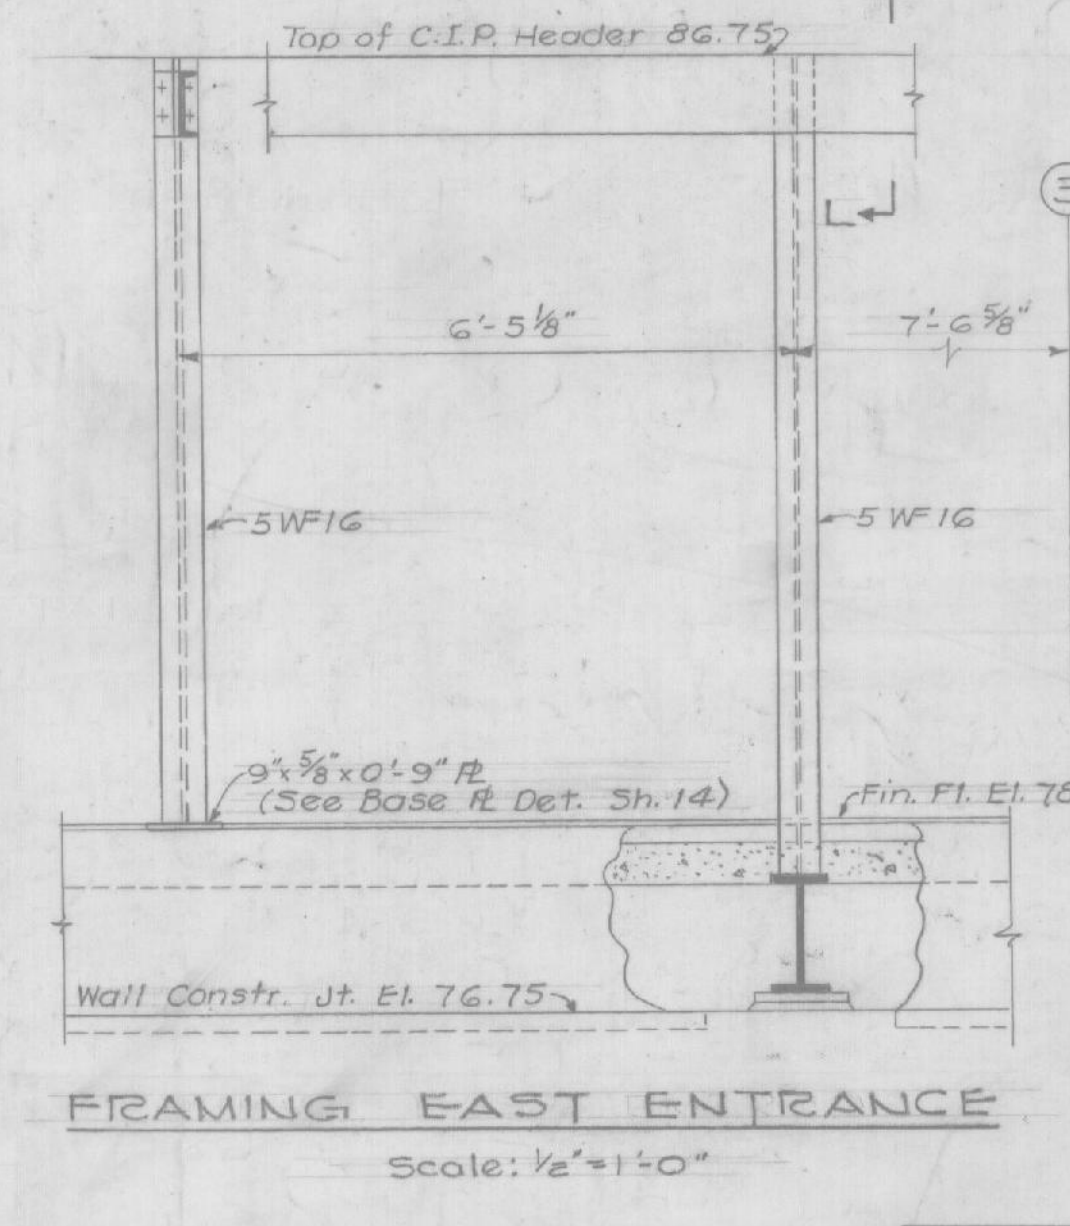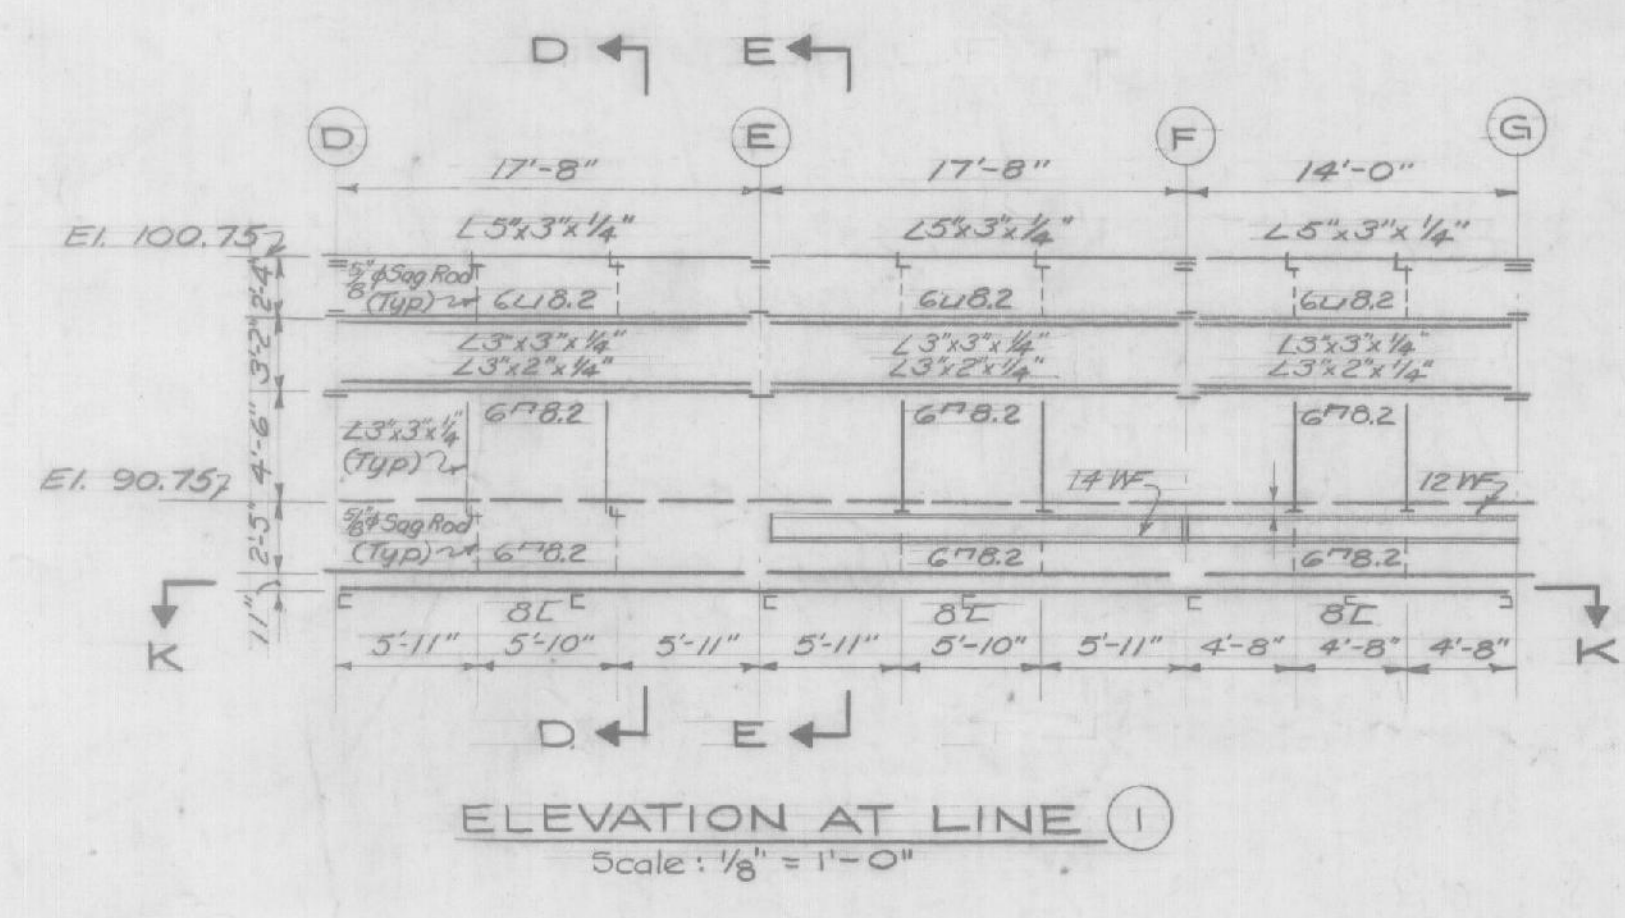

NOTE
The contractor shall furnish & install 2-12"-30lb channels 17'-9 1/4" & 22'-1 3/8" long for window lintels at East Side of the filter Bldg. Connections shall be bent plate 8"x 1/4"x 1'-3" for end columns T-shape 8" long for intermediate columns and direct attachment for the door columns.

REVISION	DATE	DESCRIPTION	BY
10-4-61		Final Field Corrections.	
DRAWN BY A.B.S.		WHITMAN & HOWARD, INC. ENGINEERS 89 BROAD ST., BOSTON, MASS.	CORPS OF ENGINEERS, U. S. ARMY OFFICE OF THE DIVISION ENGINEER NEW ENGLAND DIVISION WALTHAM, MASS.
TRACED BY A.B.S.		PEASE AIR FORCE BASE PORTSMOUTH, NEW HAMPSHIRE SURFACE WATER SUPPLY FILTER BUILDING STRUCTURAL WALL FRAMING	
CHECKED BY C.G.M.			
SUBMITTED: [Signature]		APPROVED: [Signature]	DATE JUNE, 1959
CHIEF ENGINEERING DIVISION		SCALE As Noted SPEC. NO. [Blank]	
		DRAWING NUMBER AW71-05-31	
		SHEET 15	