


- HUNTER PGP
- HUNTER PS
- ⊠ 3 HUNTER 1" VALVES WITH VALVEBOX
- ⊗ 2 HUNTER 1" VALVES WITH VALVEBOX
- ⊕ RAIN BIRD 12 STATION CONTROLLER
- ☐ WATER SOURCE

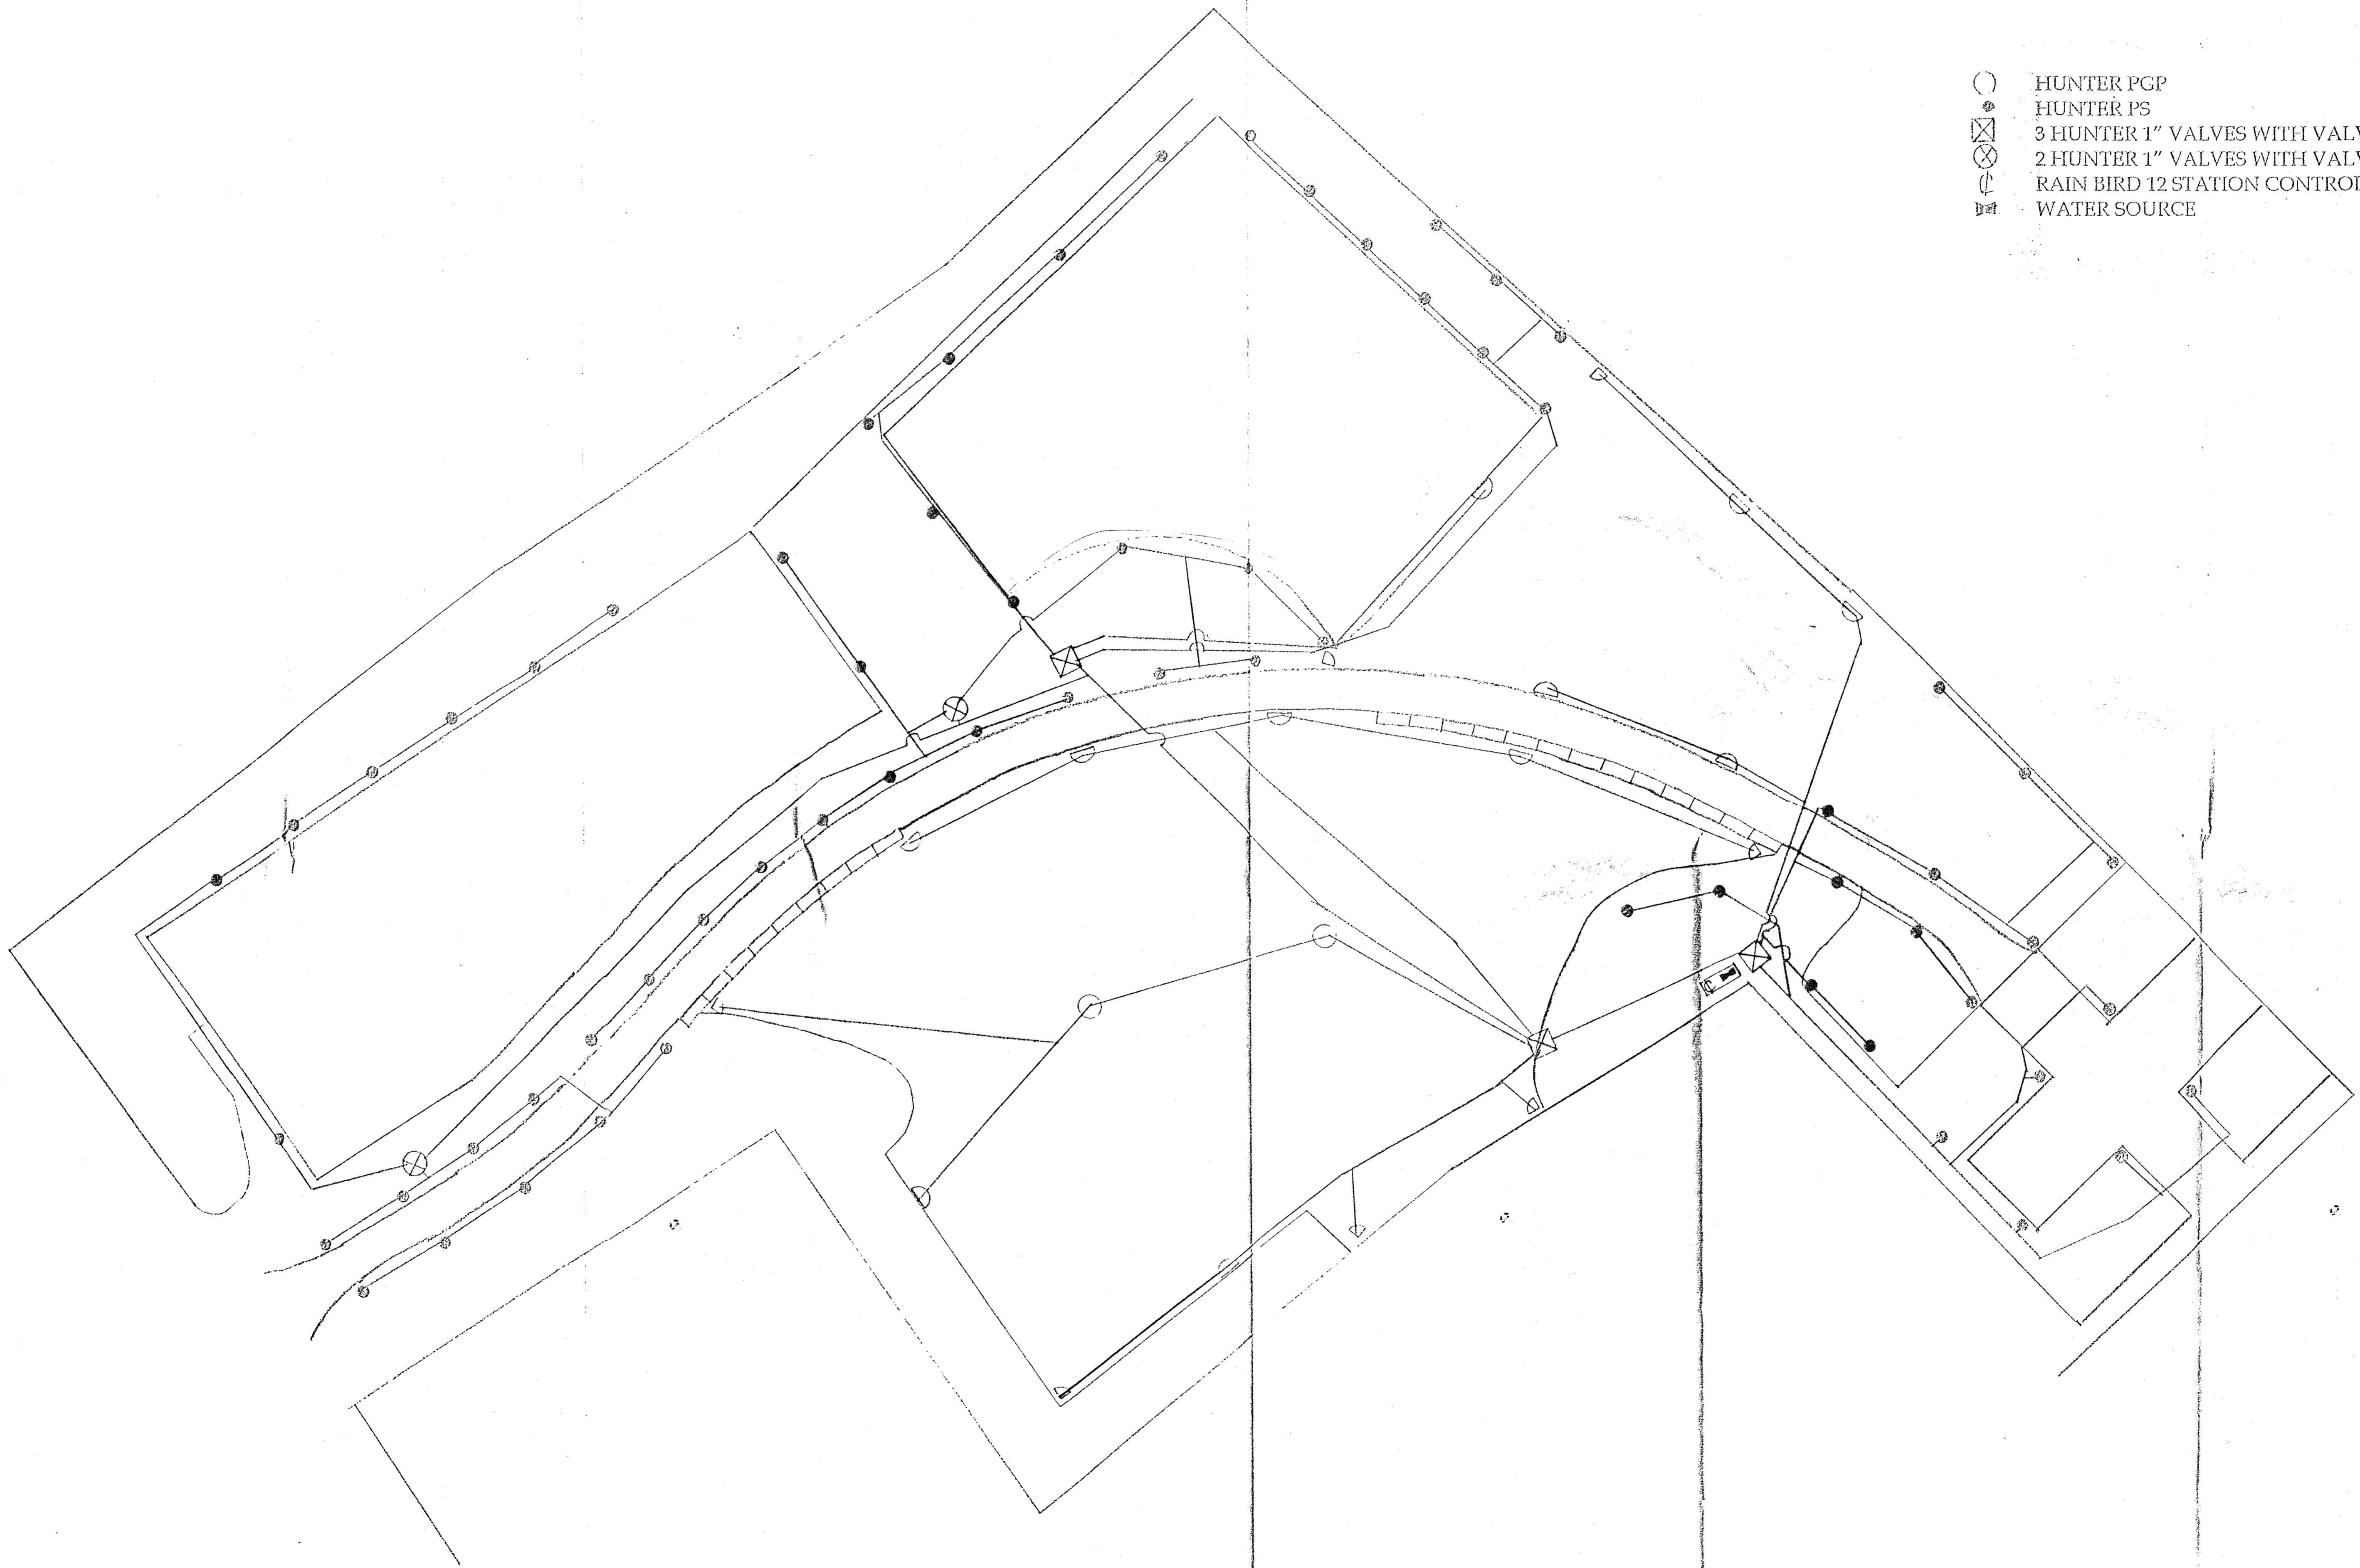

f 54710

ROCK STREET PARK		
SCALE	APPROVED BY	DRAWN BY
DATE 12/22/98		REVISED
		DRAWING NUMBER