
CITY OF PORTSMOUTH, NEW HAMPSHIRE 95 MECHANIC STREET SEAWALL & WHARF REPLACEMENT BID NO: 31-21 APRIL 29, 2021

LIST OF DRAWINGS				
SHEET NO.	SHEET TITLE			
G-001	COVER, INDEX OF DRAWINGS, LOCATION AND VICINITY MAPS			
G-002	LEGEND AND ABBREVATIONS			
G-003	GENERAL NOTES - 1			
G-004	GENERAL NOTES - 2			
C-001	OVERALL SITE PLAN			
C-002	EXISTING CONDITIONS PLAN			
C-100	OVERALL IMPROVEMENTS PLAN			
C-101	SEAWALL PLAN			
C-301	SEAWALL ELEVATION			
C-302	SEAWALL SECTIONS			
C-303	SEAWALL DETAILS - 1			
C-304	SEAWALL DETAILS - 2			
C-401	WHARF PILE PLAN (ADD ALTERNATE)			
C-402	WHARF FRAMING PLAN (ADD ALTERNATE)			
C-403	WHARF SECTIONS AND DETAILS - 1 (ADD ALTERNATE)			
C-404	WHARF SECTIONS AND DETAILS - 2 (ADD ALTERNATE)			
C-501	EROSION AND SEDIMENT CONTROL DETAILS			
C-900	HISTORICAL BORING AND LOGS			

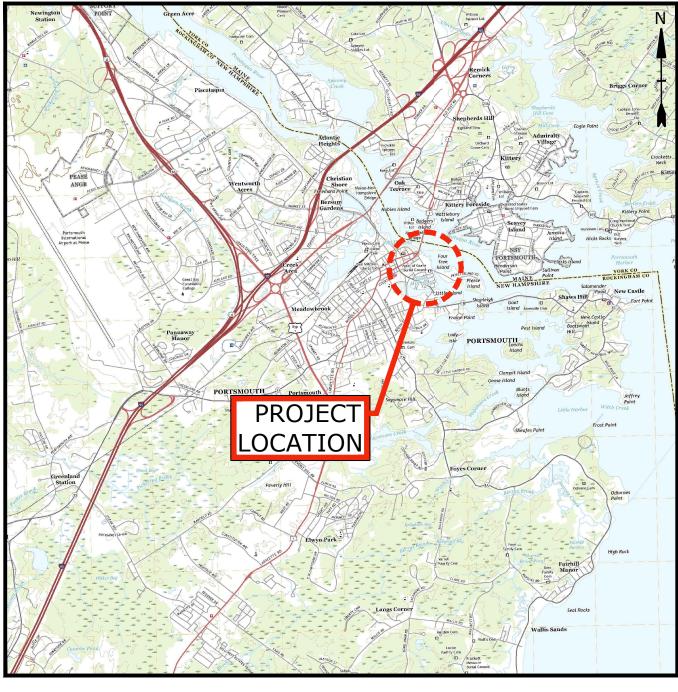

ISSUED FOR BIDDING

PROJEC LOCATION

SITE VICINITY MAP SCALE: 1" = 2,000'

SITE LOCATION MAP SCALE: 1" = 50'








DAVID A. MURPHY, PE

PREPARED FOR: CITY OF PORTSMOUTH DEPARTMENT OF PUBLIC WORKS 680 PEVERLY HILL ROAD PORTSMOUTH, NH 03801



COMPLETE SET 18 SHEETS

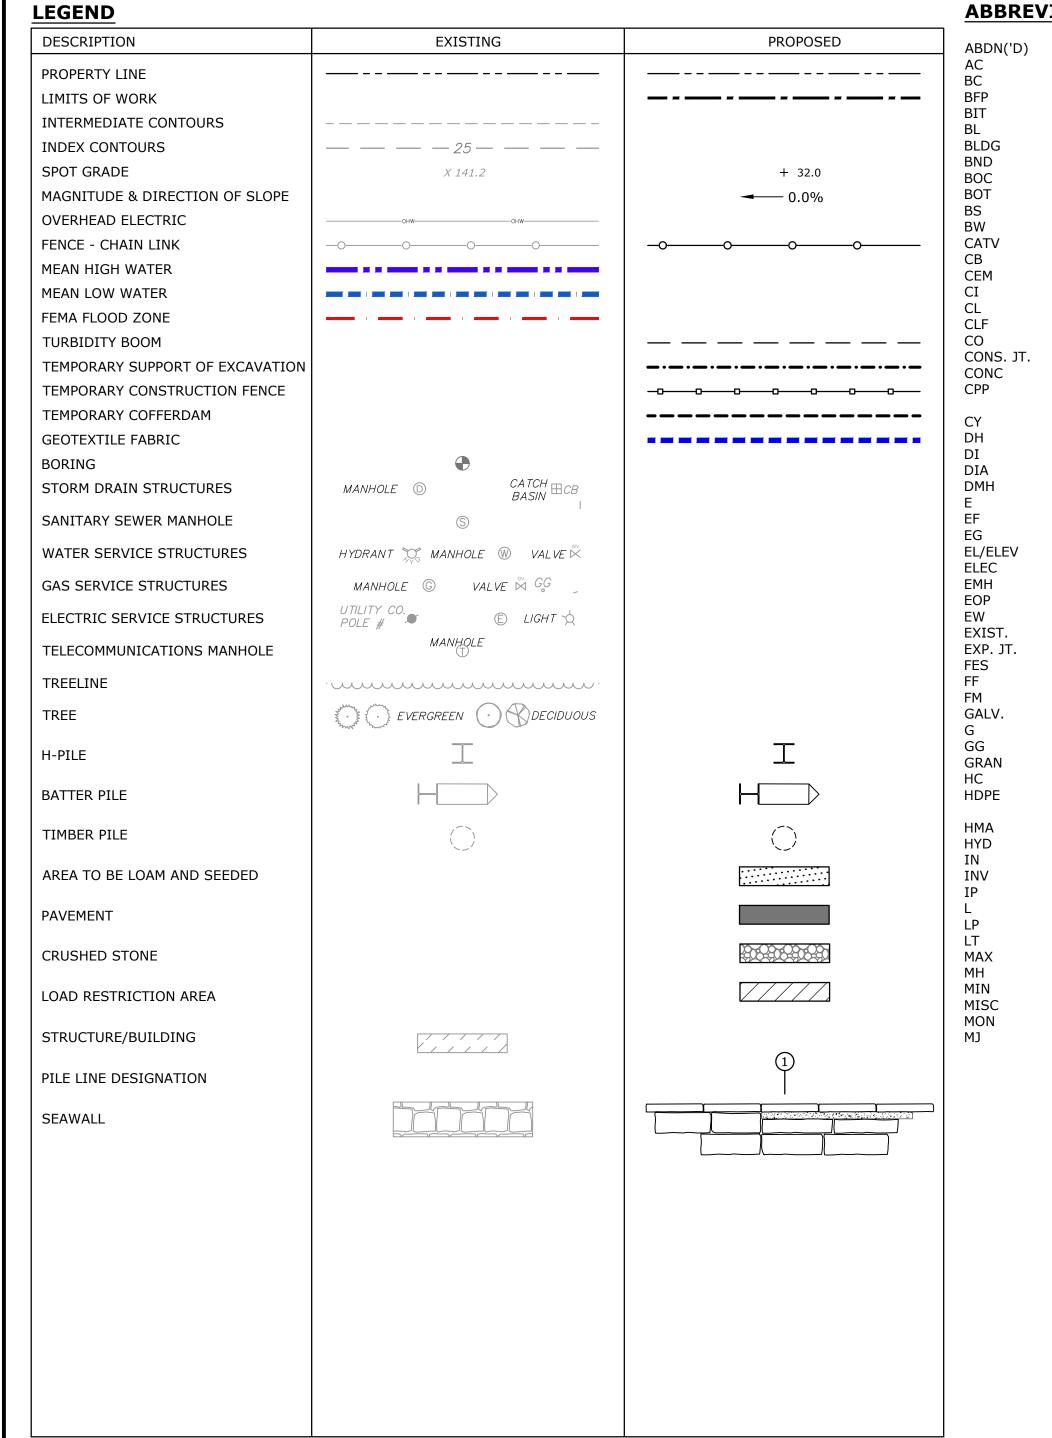

0n:Apr 29, 2021-12:05pm By: DGM & Bond:J:\P\P0714 City of Portsmouth\003-95 Mechanic Street\Drawings_Figures\AutoCAD\Sheet\20210312 Revised Drawings\General Notes.dw

Last Saved: 4/29/2021 Plotted On: Apr 29, 202:


ABBREVIATIONS

ABBREVIATIONS CONT'D

ABANDON(ED) ASBESTOS CEMENT PIPE BITUMINOUS CURB BACK FLOW PREVENTOR BITUMINOUS BASELINE BUILDING BOUND BOTTOM OF CURB BOTTOM BOTTOM OF STEP BOTTOM OF STEP BOTTOM OF WALL CABLE TELEVISION	N NITC NTS N/A N/F OC OCS OH PB PC PCC PCPP
CABLE TELEVISION CATCH BASIN CEMENT CAST IRON PIPE CENTERLINE CHAIN LINK FENCE CLEAN OUT CONSTRUCTION JOINT CONSTRUCTION JOINT CONCRETE CORRUGATED POLYETHYLENE PIPE CUBIC YARD DRILL HOLE DUCTILE IRON PIPE DIAMETER DRAIN MANHOLE EAST EACH FACE EXISTING GRADE ELEVATION ELECTRIC ELECTRIC MANHOLE EDGE OF PAVEMENT EACH WAY EXISTING EXPANSION JOINT FLARED END SECTION FINISH FLOOR FORCE MAIN GALVANIZED GAS GAS GATE GRANITE HANDICAP HIGH DENSITY POLYETHYLENE HOT MIX ASPHALT HYDRANT INCHES INVERT IRON PIN LENGTH OF CURB LIGHT POLE LIGHT POLE	PCPP PERF PI PRC PSF PSI PVC PVMT RCP RD REV ROW REV ROW REV ROW RSS SAN SCH SS STA STL STRM SYP TC TEL TP TS TW TYP. UP UNO W WG WV XFMR
MAXIMUM MANHOLE MINIMUM MISCELLANEOUS MONUMENT MECHANICAL JOINT	

TEL-DATA TEST PIT TOP OF STEP TOP OF WALL TYPICAL UTILITY POLE UNLESS NOTED OTHERWISE WATER WATER GATE WATER VALVE
WATER VALVE TRANSFORMER



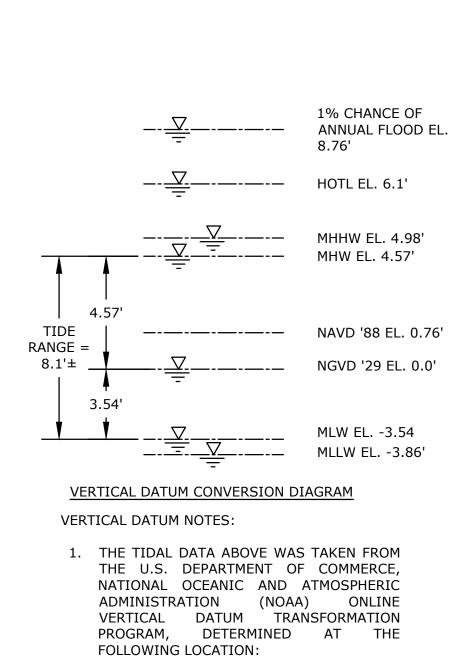

STATION ID: 8419870 PID: NONE LOCATION: Seavey Island, ME LATITUDE: 43.08 N LONGITUDE: 70.758 W

GENE	RAL NOTES
	THE SITE IS LOCATED IN PORTSMOUTH, NEW HAMPSHIRE.
2.	STANDARD SPECIFICATIONS, WHEN REFERENCED IN THESE DRAWINGS, SHALL MEAN THE NEW HAMPSHIRE DEPARTMENT OF TRANSPORTATION STANDARD SPECIFICATIONS FOR ROAD AND BRIDGE CONSTRUCTION (CURRENT ED). PARTS OF THE STANDARD SPECIFICATIONS THAT ARE SPECIFICALLY REFERENCED SHALL BECOME PART OF THESE DRAWINGS AS THOUGH STATED HEREIN IN FULL. IN CASE OF A DISCREPANCY BETWEEN THE STANDARD SPECIFICATIONS AND THE REQUIREMENTS STATED WITHIN THE DRAWINGS, THE REQUIREMENTS STATED WITHIN THE DRAWINGS SHALL PREVAIL.
3.	THIS PROJECT IS OWNED AND FUNDED BY THE CITY OF PORTSMOUTH, NH. THEREFORE, SOME OF THE REFERENCES AND TERMINOLOGY OF THE STANDARD SPECIFICATIONS MAY SEEM OUT OF PLACE. THE ENGINEER FOR THIS PROJECT IS TIGHE & BOND. THE NEW HAMPSHIRE DEPARTMENT OF TRANSPORTATION IS NOT A PARTY TO THE PROJECT.
4.	THE CONTRACTOR SHALL BE SOLELY AND COMPLETELY RESPONSIBLE FOR THE CONDITIONS OF THE JOB SITE, INCLUDING THE SAFETY OF ALL PERSONS AND PROPERTY DURING THE PERFORMANCE OF THE WORK. SAFETY PROVISIONS SHALL COMPLY WITH LOCAL, STATE, AND FEDERAL LAWS AND REGULATIONS. THESE REQUIREMENTS SHALL APPLY CONTINUOUSLY AND SHALL NOT BE LIMITED TO NORMAL WORKING HOURS.
5.	THE CONTRACTOR SHALL VERIFY ALL EXISTING CONDITIONS AND DIMENSIONS IN THE FIELD BEFORE ORDERING ANY MATERIALS, COMMENCING ANY FABRICATION, OR PERFORMING ANY WORK. THE CONTRACTOR SHALL NOTIFY THE ENGINEER, IN WRITING, OF ANY CONDITIONS OR DIMENSIONS WHICH VARY FROM THOSE SHOWN IN THE DRAWINGS AND INCORPORATE SUCH VARIATIONS IN THE CONSTRUCTION AS APPROVED BY THE ENGINEER.
6.	THE CONTRACTOR SHALL NOTIFY DIGSAFE AT 1-888-344-7233 AND OTHER UTILITY OWNERS IN THE AREA NOT ON THE DIGSAFE LIST AT LEAST 3 BUSINESS DAYS PRIOR TO ANY DIGGING, TRENCHING, ROCK REMOVAL, DEMOLITION, BORING, BACKFILLING, GRADING, LANDSCAPING, PILE DRIVING, DRILLING, OR ANY OTHER BELOW GRADE OPERATIONS.
7.	LOCATIONS OF EXISTING UTILITIES ARE APPROXIMATE. IN ADDITION, SOME UTILITIES MAY NOT BE SHOWN. DETERMINE THE EXACT LOCATION OF UTILITIES BY TEST PIT OR OTHER METHODS, AS NECESSARY TO PREVENT DAMAGE TO UTILITIES AND/OR INTERRUPTIONS IN UTILITY SERVICE. PERFORM TEST PIT EXCAVATIONS AND OTHER INVESTIGATIONS TO LOCATE UTILITIES, AND PROVIDE THIS INFORMATION TO THE ENGINEER, PRIOR TO CONSTRUCTING THE PROPOSED IMPROVEMENTS. LOCATE ALL EXISTING UTILITIES TO BE CROSSED BY HAND EXCAVATION.
8.	SHORE UTILITY TRENCHES WHERE FIELD CONDITIONS DICTATE AND/OR WHERE REQUIRED BY LOCAL, STATE AND FEDERAL HEALTH AND SAFETY CODES.
9.	NO OPEN TRENCHES WILL BE ALLOWED OVER NIGHT. THE USE OF ROAD PLATES TO PROTECT THE EXCAVATION WILL BE CONSIDERED UPON REQUEST, BUT BACKFILLING IS PREFERRED.
10.	MAINTAIN EMERGENCY ACCESS TO ALL PROPERTIES WITHIN THE PROJECT AREA AT ALL TIMES DURING CONSTRUCTION.
11.	ALL PROPOSED WORK MAY BE ADJUSTED IN THE FIELD BY THE OWNER'S PROJECT REPRESENTATIVE TO MEET EXISTING CONDITIONS.
12.	ALL WORK SHALL BE PERFORMED IN THE DRY, UTILIZING LOW TIDES AND/OR CONTRACTOR DESIGNED TEMPORARY COFFERDAMS, WHICH MAY ALSO BE UTILIZED AS EROSION AND SEDIMENT CONTROLS. THE EXCAVATION BACK SLOPES SHALL BE PROTECTED BY A CONTRACTOR DESIGNED SUPPORT-OF-EXCAVATION AND THE BOTTOM OF EXCAVATION SHALL HAVE CRUSHED STONE STABILIZATION.
13.	THE SEAWALL TO BE REPLACED FUNCTIONS AS A RETAINING WALL AND IS NOT A DOCKING STRUCTURE.
14.	OBTAIN, PAY FOR AND COMPLY WITH PERMITS, NOTICES AND FEES NECESSARY TO COMPLETE THE WORK. ARRANGE AND PAY FOR NECESSARY INSPECTIONS AND APPROVALS FROM THE JURISDICTIONAL AUTHORITIES.
15.	SEAWALL REPLACEMENT AUTHORIZED UNDER NHDES WETLANDS PBN 2019-02630. TIMBER WHARF REPLACEMENT AUTHORIZED UNDER NHDES WETLANDS PERMIT 2016-02658. REFER TO SPECIFICATION SECTION 01040, COORDINATION AND SITE CONDITIONS FOR THE PERMITS.
16.	BOLD TEXT AND LINES INDICATE PROPOSED WORK. LIGHT TEXT AND LINES INDICATE APPROXIMATE EXISTING CONDITIONS.
17.	TIGHE & BOND ASSUMES NO RESPONSIBILITY FOR ANY ISSUES, LEGAL OR OTHERWISE, RESULTING FROM CHANGES MADE TO THESE DRAWINGS WITHOUT WRITTEN AUTHORIZATION FROM TIGHE & BOND.
EXIS	TING CONDITIONS NOTES
1.	THE PROJECT SITE IS WITHIN THE SPECIAL FLOOD HAZARD AREA ZONE AE, BASE FLOOD ELEVATION (B.F.E) DETERMINED (B.F.E. = 8.0, NAVD88) AS DEPICTED IN FLOOD INSURANCE RATE MAP 3301390278F PANEL 260 OF 681 DATED JANUARY 29, 2021.
2.	THE EXISTING CONDITIONS WERE COMPILED FROM A SURVEY COMPLETED BY DOUCET SURVEY IN MAY 2009 AND WHARF MEASUREMENTS BY TAPE. EXISTING PAVEMENT SPOT ELEVATIONS WERE OBTAINED BY TIGHE & BOND IN 2019 BY AUTO LEVEL.
3.	THE PROPOSED WORK IS WITHIN THE EXISTING WALL FOOTPRINT AND THE ADJACENT RESOURCE AREA HAS NO WETLAND VEGETATION, ENV-WT 301.01 (B).
PRE-C	CONSTRUCTION SURVEYS:
1.	THE CONTRACTOR SHALL COMPLETE A PRE-CONSTRUCTION SURVEY OF THE INTERIOR AND EXTERIOR OF ALL STRUCTURES/UTILITIES WITHIN 100 FEET OF THE PROPOSED WORK PRIOR TO CONSTRUCTION. THE PRE-CONSTRUCTION SURVEYS SHALL BE COMPLETED UNDER THE DIRECTION OF A PROFESSIONAL ENGINEER REGISTERED IN THE STATE OF NEW HAMPSHIRE.
2.	A PRE-CONSTRUCTION SURVEY REPORT SHALL BE PREPARED FOR EACH STRUCTURE/UTILITY AND SHALL DOCUMENT THE EXISTING CONDITION OF THE STRUCTURE/UTILITY VIA A NARRATED COLOR VIDEO THAT IS SUPPLEMENTED WITH STILL COLOR PHOTOGRAPHS AS REQUIRED. EACH PRE-CONSTRUCTION SURVEY REPORT SHALL BE STAMPED BY A PROFESSIONAL ENGINEER REGISTERED IN THE STATE OF NEW HAMPSHIRE.
3.	EACH PRE-CONSTRUCTION SURVEY REPORT SHALL INCLUDE A STRUCTURE/ UTILITY LOCATION MAP AND SHALL DESCRIBE IN DETAIL THE EXISTING CONDITIONS OBSERVED, INCLUDING BUT NOT LIMITED TO THE LOCATION AND EXTENT OF CRACKS, SPALLS, THE OPERATION OF WINDOWS AND DOORS, SETTLEMENT, CORROSION, DETERIORATION, AND OTHER DEFICIENCIES AS APPROPRIATE.
4.	STRUCTURES/UTILITIES THAT SHALL REQUIRE A PRE-CONSTRUCTION SURVEY ARE EXPECTED TO INCLUDE THE FOLLOWING:
	 A. THE MECHANIC STREET PUMP STATION. B. THE PORTION OF THE PEIRCE ISLAND BRIDGE WITHIN 100 FEET OF THE WORK. C. EXISTING RIVERFRONT STRUCTURES INCLUDING BUT NOT LIMITED TO PIERS, DOCKS, AND SEAWALLS WITHIN 100' OF THE WORK. D. MECHANIC STREET SIDEWALK AND PAVEMENT WITHIN 100 FEET OF THE WORK. E. THE ADJACENT STORM WATER OUTFALL (INTERIOR ONLY). F. THE CITY OWNED BUILDING IMMEDIATELY ADJACENT TO THE SEAWALL. G. THE COMMERCIAL PROPERTY LOCATED AT 121 MECHANIC STREET.
	 H. THE PORTION OF THE RESIDENTIAL PROPERTY LOCATED AT 213 GATES STREET. I. ANY OTHER MISC. STRUCTURES AND/OR SITE FEATURES (E.G., SHEDS, RETAINING WALLS, ASPHALT DRIVEWAYS, ETC.) WITHIN 100 FEET OF THE WORK.

BASIS OF DESIGN NOTES

SEAWALL DESIGN CRITERIA:

1. THE PROPOSED SEAWALL WAS DESIGNED UTILIZING APPLICABLE SOIL AND WATER LOADS USING THE LOAD COMBINATIONS SPECIFIED IN ASCE 7-10.

2. THE SOIL BACKFILL WAS ASSUMED TO HAVE AN INTERNAL ANGLE OF FRICTION (Φ) OF 34 DEGREES.

3. A MAXIMUM TIDAL LAG OF 2.5 FEET WAS ASSUMED.

8. ALL HYDRAULIC EQUIPMENT SHALL UTILIZE BIODEGRADEABLE, VEGETABLE BASED, NON-TOXIC AND NON-POLLUTING HYDRAULIC FLUID.

EARTHWORK

LAYOUT

2. THE FINAL SLOPE GEOMETRY AND THE PROTECTION OF EXISTING STRUCTURES AND UTILITIES IS THE CONTRACTOR'S RESPONSIBILITY.

4. A UNIFORM VERTICAL LIVE LOAD SURCHARGE OF 250 PSF WAS ASSUMED

5. THE CONTROLLING CASE WAS DETERMINED TO BE GROUNDWATER AT ABOUT THE MID-HEIGHT ON THE BACKSIDE OF THE SEAWALL AND A TIDE LEVEL OF ABOUT 2.5 FEET BELOW THE GROUNDWATER LEVEL.

6. THE STRUCTURAL DESIGN OF THE SEAWALL WAS PERFORMED IN ACCORDANCE WITH ACI 318-14.

WHARF DESIGN CRITERIA:

1. THE FOLLOWING LOADS WERE UTILIZED TO DESIGN THE TIMBER WHARF:

1.1. DEADLOAD = 20 PSF

1.2. LIVE LOAD = 250 PSF (THE WHARF IS NOT DESIGNED FOR VEHICLE LOADING)

1.3. SNOW LOAD = 50 PSF BASIC GROUND; 38 PSF ADJUSTED

1.4. WIND LOAD = WIND LOADS WERE BASED ON ASCE 7-10, FIGURE 26.5, BASE WIND SPEED OF 130 MPH, BASE WIND PRESSURE OF 43 PSF (ALL K VALUES EQUAL TO 1).

1.5. LATERAL LOAD: THE WHARF HAS BEEN DESIGNED FOR A MAXIMUM WIND INDUCED LATERAL LOAD OF 660 POUNDS PER LINEAR FOOT (ALONG THE LONGITUDINAL OR TRANSVERSE AXIS), INCLUDING A NOMINAL WIND INDUCED OVERTURNING MOMENT, BASED ON AN ASSUMED BUILDING FOOTPRINT AND HEIGHT (SINGLE STORY, FLAT ROOF). THE ESTIMATED LATERAL DEFELECTION UNDER THE ASSUMED WIND LOAD WAS DETERMINED TO BE LESS THAN 1 INCH ALONG THE LONGITUDINAL AXIS OF THE WHARF AND UP TO 2 INCHES ALONG THE TRANSVERSE AXIS OF THE WHARF. ACCORDINGLY, CROSS BRACING WAS INCLUDED BETWEEN BENT NOS. 6 - 11 TO REDUCE THE ESTIMATED LATERAL DEFLECTION TO ABOUT 1 INCH. PRIOR TO CONSTRUCTING ANY BUILDINGS OR STRUCTURES ON THE WHARF, THE CITY SHOULD RETAIN A REGISTERED PROFESSIONAL ENGINEER TO CONFIRM THAT THE WHARF CAN SUPPORT THE ESTIMATED LATERAL LOADS, BASED ON THE ACTUAL BUILDING FOOTPRINT AND HEIGHT PROPOSED. 1.6. ASSUMED BUOYANCY = FULL SUBMERGENCE

1.7. SEISMIC DESIGN CRITERIA: Ss=0.25g; S1=0.1g; Sm1=0.188; Sds=0.417g; Sd1 =0.223g

THE HORIZONTAL CONTROL DATUM FOR THIS PROJECT IS SITE SPECIFIC.

2. THE VERTICAL CONTROL DATUM FOR THIS PROJECT IS THE NATIONAL GEODETIC VERTICAL DATUM OF 1929 (NGVD 29)

3. THE CONTRACTOR SHALL BE RESPONSIBLE FOR PERFORMING ALL LAYOUT WORK FROM THE CONTROL MONUMENTATION PROVIDED.

AVAILABLE SUBSURFACE INFORMATION

1. GEOTECHNICAL INFORMATION UTILIZED TO PREPARE THESE DRAWINGS WAS OBTAINED FROM SOIL BORINGS AND/OR TEST PITS COMPLETED BY OTHERS IN THE COLLECTION OF GENERAL SITE INFORMATION RELATIVE TO SUBSURFACE CONDITIONS. THIS INFORMATION IS INCLUDED ON THE DRAWINGS.

2. IT IS INTENDED THAT THE GEOTECHNICAL INFORMATION BE USED ONLY AS AN INDICATION OF POSSIBLE SUBSURFACE CONDITIONS, AND THAT UPON THE CONTRACTOR'S REVIEW, FURTHER SUBSURFACE EXPLORATIONS MAY BE WARRANTED. SUCH EXPLORATIONS SHALL BE PERFORMED AT THE CONTRACTOR'S EXPENSE.

3. THE CONTRACTOR SHALL USE THE GEOTECHNICAL INFORMATION PROVIDED ON THE DRAWINGS AT ITS OWN RISK AND SHALL COMPLETELY HOLD HARMLESS THE CITY OF PORTSMOUTH AND TIGHE & BOND FROM ALL CONSEQUENCES AND/OR FAULT ARISING FROM ITS USE.

MOBILIZATION AND DEMOBILIZATION NOTES

1. COORDINATE WITH THESE DRAWINGS AND SECTION 02005, MOBILIZATION/DEMOBILIZATION.

DEMOLITION AND REMOVAL

1. COORDINATE WITH THESE DRAWINGS AND SECTION 02050, DEMOLITION AND REMOVAL

1. COORDINATE WITH THESE DRAWINGS AND SECTION 02200, EARTHWORK.

STOCKPILE MANAGEMENT

1. THE CONTRACTOR SHALL MAINTAIN STOCKPILES AND THE AREAS AROUND THEM GRADED TO DRAIN AND TAKE ALL NECESSARY PRECAUTIONS TO MINIMIZE EROSION FROM THE STOCKPILES, INCLUDING BUT NOT LIMITED TO THE INSTALLATION OF HAY BALES OR SILT FENCE.

2. SOIL MATERIAL THAT MEETS THE SPECIFIED GRADATION REQUIREMENTS UNDER SECTION 02200, EARTHWORK AS DETERMINED IN ACCORDANCE WITH SECTION 01400, QUALITY CONTROL, MAY BE STOCKPILED ADJACENT TO THE WORK AREA FOR REUSE.

2 3. EXCESS SOIL MATERIAL THAT DOES NOT MEET THE SPECIFIED GRADATION REQUIREMENTS AND/OR EXCAVATED MATERIAL IN EXCESS OF THAT REQUIRED FOR COMPLETING THIS PROJECT MAY BE TRANSPORTED TO THE CITY OF PORTSMOUTH'S DEPARTMENT OF PUBLIC WORKS YARD FOR TEMPORARY STOCKPILING, BUT SHALL ULTIMATELY BE DISPOSED OF OFF SITE BY THE CONTRACTOR IN ACCORDANCE WITH ALL APPLICABLE LOCAL, STATE, AND FEDERAL REGULATIONS.

EROSION & SEDIMENT CONTROL AND RESOURCE AREA PROTECTION NOTES

COORDINATE WITH THESE DRAWINGS AND SECTION 02270, EROSION AND SEDIMENT CONTROLS.

2. PROVIDE ALL EROSION AND SEDIMENT CONTROL MEASURES SHOWN, SPECIFIED, REQUIRED BY PERMIT, AND/OR REQUIRED BY THE ENGINEER PRIOR TO ANY CONSTRUCTION OR IMMEDIATELY UPON REQUEST. MAINTAIN SUCH CONTROL MEASURES UNTIL FINAL SURFACE TREATMENTS ARE IN PLACE AND/OR UNTIL PERMANENT VEGETATION IS ESTABLISHED. INSPECT AFTER EACH RAINSTORM AND DURING MAJOR STORM EVENTS TO CONFIRM THAT ALL SEDIMENTATION AND EROSION CONTROL MEASURES REQUIRED ARE IN PLACE AND EFFECTIVE.

3. PRIOR TO STARTING WORK, CLEARLY MARK WORK LIMITS. DO NOT DISTURB THE AREA BEYOND THE PROPOSED LIMITS. COORDINATE WITH THE ENGINEER FOR LOCATIONS OF TEMPORARY STOCKPILING OF TOPSOIL DURING CONSTRUCTION.

4. INSTALL SILT SACKS OR OTHER APPROVED SEDIMENTATION BARRIERS IN/AT ALL CATCH BASINS IN THE PROJECT AREA.

5. COMPACT, STABILIZE, AND LOAM AND SEED SIDE SLOPES, SHOULDER AREAS AND DISTURBED VEGETATED AREAS IN ACCORDANCE WITH THE CONTRACT DOCUMENTS AND AS REQUIRED BY PERMITS. GRADE SIDE SLOPES, SHOULDER AREAS AND DISTURBED VEGETATED AREAS TO A MAXIMUM SLOPE OF 3 HORIZONTAL TO 1 VERTICAL (3H:1V), WHERE POSSIBLE. PROVIDE BIODEGRADABLE EROSION CONTROL BLANKETS TO PREVENT EROSION WHERE SLOPES ARE STEEPER THAN 3H:1V.

6. REMOVE AND PROPERLY DISPOSE OF SILT TRAPPED AT BARRIERS IN UPLAND AREAS OUTSIDE BUFFER ZONES. REMOVE MATERIALS DEPOSITED IN ANY TEMPORARY SETTLING BASINS AT THE COMPLETION OF THE PROJECT. RESTORE ALL DISTURBED AREAS TO THEIR PRECONSTRUCTION CONDITION.

7. SWEEP, COLLECT, REMOVE AND DISPOSE OF ANY SEDIMENT TRACKED ONTO PUBLIC RIGHT-OF-WAYS AT THE END OF EACH DAY.

- LOCKED AND COVERED AREA DURING NON-WORK HOURS.
- MUNICIPALITY WHERE THE WORK IS OCCURRING.

STEEL H-PILES

CONCRETE SEAWAL

- 1. COORDINATE WITH THESE DRAWINGS AND SECTION 02301, STEEL H-PILES.
- COMPLETED BY THE CONTRACTOR AT TWO INDICATOR PILE LOCATIONS
- LOCATIONS.
- ENGINEER.
- PILES BASED ON THE INITIAL AND RESTRIKE DRIVE PDA TESTING.
- 6. THESE H-PILES SHALL BE DRIVEN WITH DRIVING SHOES AS SHOWN ON THE DRAWINGS.
- SPECIFIED DRIVING TOLERANCES.

- 10. THESE H-PILES SHALL BE UNCOATED.

WHARF

- 1. COORDINATE WITH THESE DRAWINGS AND SECTION 02301, STEEL H-PILES.
- BE VERIFIED VIA A WEAP TO BE COMPLETED BY THE ENGINEER.
- CONSTRAINTS AND WITH DRIVING SHOES AS SHOWN ON THE DRAWINGS.
- ENGINEER.
- SPECIFIED DRIVING TOLERANCES.

- 8. THESE H-PILES SHALL BE COATED, COLOR BLACK, AS SPECIFIED IN SECTION 09900, COATINGS.

STEEL SHEET PILES

- 1. COORDINATE WITH THESE DRAWINGS AND SECTION 023671, STEEL SHEET PILES.
- ADJUSTED BASED ON THE FINAL SHEET PILE SELECTED BY THE CONTRACTOR.
- MADE FOR THE USE OF AN ALTERNATE SHEET PILE TYPE.
- SPLICES.
- SPLICED DUE TO OVERHEAD UTILITY LINE CLEARANCE CONSTRAINTS.
- SPECIFIED DRIVING TOLERANCES.
- A VIBRATORY HAMMER MAY BE UTILIZED FOR THE INSTALLATION.
- 9. THE STEEL SHEET PILES SHALL BE UNCOATED.

9. STORE FUEL, OIL, PAINT, OR OTHER HAZARDOUS MATERIALS IN A SECONDARY CONTAINER AND REMOVE TO A SECURE

10. PROVIDE A SUPPLY OF ABSORBENT SPILL RESPONSE MATERIALS SUCH AS BOOMS, BLANKETS, AND OIL ABSORBENT MATERIALS AT THE CONSTRICTION SITE AT ALL TIMES TO CLEAN UP POTENTIAL SPILLS OF HAZARDOUS MATERIALS IMMEDIATELY REPORT SPILLS OF HAZARDOUS MATERIALS TO THE STATE ENVIRONMENTAL AGENCY AND THE

2. THE SPECIFIED VERTICAL ULTIMATE CAPACITY FOR THESE STEEL H-PILES IS 293 KIPS (130 KIPS ALLOWABLE X 2.25), WHICH WILL BE VERIFIED VIA A WEAP TO BE COMPLETED BY THE ENGINEER AND PDA TESTING THAT SHALL BE

3. THE SPECIFIED VERTICAL UPLIFT CAPACITY FOR THESE STEEL H-PILES IS 28 KIPS (12.5 KIPS ALLOWABLE X 2.25) WHICH SHALL BE VERIFIED BY PDA TESTING THAT SHALL BE COMPLETED BY THE CONTRACTOR AT TWO INDICATOR PILE

4. THE CONTRACTOR SHALL INSTALL THESE H-PILES TO THEIR SPECIFIED ULTIMATE CAPACITY, OR THE SPECIFIED TIP ELEVATION, WHICHEVER RESULTS IN THE GREATEST EMBEDMENT DEPTH, UNLESS OTHERWISE DIRECTED BY THE

5. THE ENGINEER WILL BE RESPONSIBLE FOR ESTABLISHING PILE DRIVING CRITERIA FOR THE REMAINING PRODUCTION

7. IT IS RECOMMENDED THAT A DRIVING TEMPLATE BE USED TO INSTALL THESE H-PILES IN ORDER TO MEET THE

🔥 8. A VIBRATORY HAMMER MAY BE UTILIZED FOR THE INITIAL INSTALLATION, BUT AN IMPACT HAMMER SHALL BE UTILIZED FOR THE LAST 10 FEET OF DRIVING TO "PROOF" THESE PILES TO THEIR SPECIFIED ULTIMATE CAPACITY.

9. ALL SPLICES SHALL BE FARBICATED AND TESTED AS SPECIFIED AND SHOWN IN THE CONTRACT DOCUMENTS.

2. THE SPECIFIED ULTIMATE CAPACITY FOR THESE STEEL H-PILES IS 110 KIPS (40 KIPS ALLOWABLE X 2.75), WHICH WILL

3. THESE H-PILES ARE EXPECTED TO BE DRIVEN IN SEGMENTS AND SPLICED DUE TO OVERHEAD UTILITY LINE CLEARANCE

A. THE CONTRACTOR SHALL INSTALL THESE H-PILES TO THEIR SPECIFIED ULTIMATE CAPACITY, OR THE SPECIFIED TIP ELEVATION, WHICHEVER RESULTS IN THE GREATEST EMBEDMENT DEPTH, UNLESS OTHERWISE DIRECTED BY THE

5. IT IS RECOMMENDED THAT A DRIVING TEMPLATE BE USED TO INSTALL THESE H-PILES IN ORDER TO MEET THE

6. A VIBRATORY HAMMER MAY BE UTILIZED FOR THE INITIAL INSTALLATION, BUT AN IMPACT HAMMER SHALL BE UTILIZED FOR THE LAST 10 FEET OF DRIVING TO "PROOF" THESE H-PILES TO THEIR SPECIFIED ULTIMATE CAPACITY.

7. ALL SPLICES SHALL BE FABRICATED AND TESTED AS SPECIFIED AND SHOWN IN THE CONTRACT DOCUMENTS.

2. THE ALIGNMENT SHOWN FOR LAYOUT SHALL BE TAKEN AS THE INSIDE FACE OF THE STEEL SHEET PILES. LAYOUT IS BASED ON ARBED AZ 17-700 SHEET PILES. THE LAYOUT IS FOR GENERAL LOCATION. THE FINAL LAYOUT SHALL BE

3. SHOULD THE CONTRACTOR PROPOSE, AND THE ENGINEER APPROVE AN ALTERNATE SHEET PILE TYPE FROM THAT SHOWN ON THESE PLANS, THE CONTRACTOR SHALL BE RESPONSIBLE FOR ADJUSTING THE ALIGNMENT AND CONCRETE CAP AS REQUIRED TO ACCOMMODATE THE ALTERNATE SHEET PILE TYPE. NO ADJUSTMENT TO THE CONTRACT PRICE WILL BE New Hampshire

4. STEEL SHEET PILES BETWEEN ABOUT STATION 0+70 AND 1+065 ARE EXPECTED TO BE DRIVEN FULL LENGTH WITHOUT

5. STEEL SHEET PILES BETWEEN ABOUT STATION 1+065 AND 1+30 ARE EXPECTED TO BE DRIVEN IN SEGMENTS AND

6. IT IS RECOMMENDED THAT A DRIVING TEMPLATE BE USED TO INSTALL THE SHEET PILES IN ORDER TO MEET THE

8. ALL SPLICES SHALL BE FARBICATED AND TESTED AS SPECIFIED AND SHOWN IN THE CONTRACT DOCUMENTS.



G

Ζ

 \mathbf{m}

2

Ш

U

U

95 Mechanic Street Seawall & Wharf Replacement

DAVID

MURPH

No. 13933

City of Portsmouth



Portsmouth,

	4/29/2021	ADDENDUM 2			
MARK	DATE	DESCRIPTION			
PROJEC	CT NO:	P-0714-003			
DATE:		MARCH 24, 2021			
FILE:	(General Notes.dwg			
DRAWN	NBY:	JAK			
CHECK	CHECKED: GC				
APPROVED: DAM					
GENERAL NOTES - 1					
SCALE: AS SHOWN					
G-003					

I		ER PILES		HAVE A GALVANIZ COMPLY W
•		COORDINATE WITH THESE DRAWINGS AND SECTION 02368, TIMBER PILES.	2.	RAILS, PAI
	2.	THE SPECIFIED ULTIMATE CAPACITY FOR THE TIMBER PILES IS 110 KIPS (40 KIPS ALLOWABLE X 2.75), WHICH WILL BE VERIFIED VIA A WEAP TO BE COMPLETED BY THE ENGINEER.		IBC 2009 / DIP GALVA
	3.	IT IS RECOMMENDED THAT A DRIVING TEMPLATE BE USED TO INSTALL THE TIMBER PILES IN ORDER TO MEET THE SPECIFIED DRIVING TOLERANCES.	3.	PROVIDE F COMPLY W TOLERANC EDGES O
	4.	THE CONTRACTOR SHALL INSTALL THESE TIMBER PILES TO THEIR SPECIFIED ULTIMATE CAPACITY, OR THE SPECIFIED TIP ELEVATION, WHICHEVER RESULTS IN THE GREATEST EMBEDMENT DEPTH, UNLESS OTHERWISE DIRECTED BY THE ENGINEER.	4.	THE CONT
	5.	A VIBRATORY HAMMER MAY BE UTILIZED FOR THE INITIAL INSTALLATION, BUT AN IMPACT HAMMER SHALL BE UTILIZED FOR THE LAST 10 FEET OF DRIVING TO "PROOF" THE TIMBER PILES TO THEIR SPECIFIED ULTIMATE CAPACITY.		4.1. RAIL
D	EWA	TERING, CONTROL, AND DIVERSION OF WATER	<u>STRU</u>	CTURAL LU
	1.	COORDINATE WITH THESE DRAWINGS AND SECTION 02400, DEWATERING, CONTROL, AND DIVERSION OF WATER.	1.	DECKING BOARDS S
	2.	WATER ELEVATIONS AT THE SITE ARE TIDAL AND ARE EXPECTED TO VARY. TEMPORARY EARTH RETAINING SYSTEMS AND TEMPORARY COFFERDAMS WITH SUMPS AND PUMPS ARE EXPECTED TO BE ADEQUATE TO CONTROL INFLOWS AND/OR THE ACCUMULATION OF PONDED WATER DUE TO SURFACE WATER RUN OFF.		
	3.	THE CONTRACTOR SHALL ROUTE ALL PUMPED WATER TO DEWATERING BASINS OR OTHER SUITABLE DEVICES (E.G., DEWATERING BAGS) PRIOR TO ALLOWING THE PUMPED WATER TO FLOW OVER LAND.		СС
D	YNA	MIC PILE TESTING		WHA
	1.	COORDINATE WITH THESE DRAWINGS AND SECTION 02457, DYNAMIC PILE TESTING.		STRIN
<u>B</u>	ITUN	IINOUS CONCRETE PAVEMENT		C
	1.	COORDINATE WITH THESE DRAWINGS AND SECTION 02512, BITUMINOUS CONCRETE PAVEMENT.		
<u>C</u>				
		COORDINATE WITH THESE DRAWINGS, SECTION 03200, REINFORCING STEEL, AND SECTION 03310, CONCRETE.	2.	ALL TIMBE
M	1 1	COORDINATE WITH THESE DRAWINGS AND SECTION 04400, STONE MASONRY.	3.	ALL TIMBE
ſ		INGS		TIMBER IN
<u> </u>		COORDINATE WITH THESE DRAWINGS AND SECTION 09900, COATINGS.	4.	ALL PRESS
<u>c</u>		I LINK FENCE	5.	ALL HORI
	1.	ALL FENCE MATERIALS SHALL BE NEW AND OF RECOGNIZABLE AND REPUTABLE MANUFACTURERS.	-	OVERHANG
	2.	FENCING MATERIALS SHALL MEET THE REQUIREMENTS OF NHDOT STANDARD SPECIFICATIONS.		ELLANEOU
	3.	CHAIN LINK FENCE FABRIC SHALL BE BLACK VINYL COATED NO. 9-GAUGE WIRE WOVEN IN A 2-INCH DIAMOND-MESH PATTERN, AND SELVAGES TWISTED AND BARBED.		ALL BOLTS
	4.	TENSION WIRE, IF REQUIRED, SHALL BE BLACK VINYL COATED SPRING STEEL WIRE NOT LESS THAN NO. 7 GAUGE (0.177 INCH DIAMETER). PROVIDE TIE CLIPS OF MANUFACTURER'S STANDARD AS APPROVED FOR ATTACHING THE WIRE TO THE FABRIC, AT INTERVALS NOT EXCEEDING 24 INCHES.		ALL WASH
	5.	END, CORNER, ANGLE, AND PULL POSTS SHALL BE 2.875-INCH-DIAMETER (O.D.) SCHEDULE 40 STEEL PIPE, WEIGHT 5.80 POUNDS PER LINEAR FOOT, MEETING THE REQUIREMENTS OF ASTM F1043, GROUP 1A - HIGH STRENGTH (MINIMUM Fy = 83,000 PSI).		ALL MISC. ALL HOT-D
	6.	TOP RAIL SHALL BE 1.875-INCH OUTSIDE DIAMETER, WEIGHT 2.72 POUNDS PER LINEAR FOOT, MEETING THE	6.	ALL WELD EDITION. I
		REQUIREMENTS OF ASTM F1043 GROUP 1A - REGULAR STRENGTH (MINIMUM Fy = 30,000 PSI). COUPLINGS SHALL BE OUTSIDE-SLEEVE TYPE AND AT LEAST 6 INCHES LONG. PROVIDE SPRINGS AT ONE COUPLING IN FIVE TO PERMIT EXPANSION IN RAIL AS RECOMMENDED BY THE MANUFACTURER. TOP RAIL TO EXTEND THROUGH LINE POST TOPS TO FORM CONTINUOUS BRACE FROM END-TO-END OF EACH STRETCH OF FENCE.	7.	ALL HOLES THE FIELD BEEN APPL
	7.	BRACE PIPE SHALL BE OF THE SAME MATERIAL AND TYPE AS THE TOP RAIL, AND SHALL BE INSTALLED MIDWAY BETWEEN THE TOP RAIL AND EXTEND FROM THE TERMINAL POST TO THE FIRST ADJACENT LINE POST. BRACES SHALL BE SECURELY FASTENED TO THE POSTS BY HEAVY-PRESSED STEEL AND MALLEABLE FITTINGS.	<u>GENE</u>	RAL EXECU
	8.	FITTINGS SHALL BE MALLEABLE STEEL, CAST IRON, OR PRESSED STEEL. FITTINGS TO INCLUDE EXTENSION ARMS FOR BARBED WIRE, STRETCHER BARS AND CLAMPS, CLIPS, TENSION RODS, BRACE RODS, HARDWARE, FABRIC BANDS,	1.	IT SHALL LOGICAL S OR VIBRAT
	9.	FASTENINGS, AND ALL ACCESSORIES. ALL FENCE POSTS, RAILS, FITTINGS AND HARDWARE SHALL BE GALVANIZED AND POWDER COATED, COLOR BLACK.	2.	THE CONT
		THE CONTRACTOR SHALL PROVIDE MANUFACTURER'S CUT SHEETS FOR ALL FENCING MATERIALS FOR REVIEW/APPROVAL	3.	ALL WORK
		BY THE ENGINEER.	4.	THE CONT OPERATE.
	11.	FENCE POSTS INSTALLED IN SOIL SHALL BE INSTALLED A MINIMUM OF 48" BELOW GRADE WITH A 12" DIAMETER CONCRETE FOUNDATION.	5.	THE CONT LIMITED T
~	RNA	MENTAL RAILING	6.	THE CONT
<u>u</u>		THE ORNAMENTAL RAILING SYSTEM SHALL BE 42" HIGH INDUSTRIAL GRADE, SURFACE MOUNTED, HOT DIPPED		OF EACH F

HDG COMPATIBLE BLACK FINISH COATING, WHICH SHALL BE THE COLORGALV15 SYSTEM BY DUNCAN ING OF EVERETT MA, OR APPROVED EQUAL (WITH EQUIVALENT WARRANTY). THE SELECTED SYSTEM SHALL VITH THE IBC 2009 PEDESTRIAN GUARD CODE AND ADA RAIL GUIDELINES

NELS, POSTS, AND BASE PLATES SHALL BE FABRICATED TO WITHSTAND AT A MINIMUM THE LOADS SPECIFIED IN AT OR BELOW THE ALLOWABLE STRESSES. RAIL POST MOUNTING ON TIMBER SHALL BE AS SHOWN, USING HOT ANIZED LAG BOLTS AND WASHERS.

RAILING SYSTEM IN ACCORDANCE AS SPECIFIED WITH CONNECTIONS, INCLUDING POST BASE ANCHORAGE, TO WITH IBC 2009 PEDESTRIAN GUARD CODE. POSTS AND PANELS SHALL BE PLUMB TO WITHIN 1/8" IN 2 FEET CE. ALL JOINTS SHALL BE TRUE AND SMOOTH, WITH NO INCORRECT FIT GAPS AND WITH NO BURRS, SHARP DR PROTRUDING FASTENERS. REPAIR ANY COATING DAMAGE IN ACCORDANCE WITH THE COATING TURER'S RECOMMENDATIONS SUCH THAT IT MATCHES AND IS CONSISTENT WITH THE ADJACENT COATING.

FRACTOR SHALL SUBMIT THE FOLLOWING SUBMITTALS FOR REVIEW AND APPROVAL BY THE ENGINEER:

LING SYSTEM SHOP DRAWINGS, COATING SYSTEM, ANCHORING SYSTEM, AND SHIMMING PROCEDURE.

<u>UMBER</u>

SHALL BE SOUTHERN YELLOW PINE, GRADE NO. 2; AND ALL CAP BEAMS, STRINGERS, BRACES, AND FASCIA SHALL BE SOUTHERN YELLOW PINE, GRADE NO. 1. THIS LUMBER SHALL CONFORM TO THE FOLLOWING MINIMUM LE STRESSES IN ACCORDANCE WITH NDS.

ALLOWABLE STRESSES					
COMPONENT	BENDING Fb (psi)	HORIZONTAL SHEAR Fv (psi)	COMPRESSION PERPENDICULAR TO GRAIN Fcl (psi)	COMPRESSION PARALLEL TO GRAIN Fc (psi)	
WHARF DECKING	925	175	565	1,350	
TRINGERS/FASCIA BOARDS	1,350	165	375	825	
CAP BEAMS	1,350	165	375	825	
BRACES	925	175	565	1,350	

ER DIMENSIONS SHOWN ARE NOMINAL AND ALL LUMBER SHALL BE SURFACED ON ALL FOUR SIDES (S4S).

ER PILES AND TIMBER CROSS-BRACING THAT IS IMMERSED IN SALTWATER SHALL BE TREATED TO 2.5 PCF CCA; N THE SLASH ZONE SHALL BE TREATED TO 0.60 PCF CCA AS SPECIFIED; AND THE TIMBER DECKING SHALL BE TO 0.6 PCF ACQ FOR HUMAN CONTACT.

SURE TREATED TIMBER THAT HAS BEEN FIELD CUT, DRESSED, AND/OR DRILLED SHALL BE COATED WITH TWO (2) F COPPER NAPTHENATE PRESERVATIVE, INCLUDING THE ENDS OF ANY SPLICED SEGMENTS.

IZONTAL SURFACES BETWEEN TIMBER COMPONENTS SHALL BE COVERED WITH 30# TAR PAPER WITH A 1" G ON ALL SIDES. TAR PAPER SHALL BE OVERLAPPED A MIN. OF 6-INCHES AT SEEMS.

<u>IS METALS</u>

S, THREADED ROD, AND DRIFT PINS USED IN TIMBER CONSTRUCTION SHALL BE HOT-DIPPED GALVANIZED, ASTM

HERS SHALL BE HOT-DIPPED GALVANIZED, ASTM F436 OVERSIZED WASHERS.

L PILE CAP PLATES AND MISCELLANEOUS PLATE STEEL SHALL CONFORM TO ASTM A572, GR. 50 (f_v = 50 KSI MIN.).

. STEEL HARDWARE USED IN TIMBER CONSTRUCTION SHALL BE HOT-DIPPED GALVANIZED A36 STEEL (MIN).

DIP GALVANIZING SHALL BE PERFORMED IN ACCORDANCE WITH ASTM A123.

DING SHALL BE PERFORMED BY CERTIFIED WELDERS AND SHALL MEET AWS SPECIFICATION D1.1, LATEST ELECTRODES SHALL BE E70XX LOW-HYDROGEN OR APPROVED EQUAL.

S AND/OR SLOTS SPECIFIED IN STEEL PLATES AND SHAPES SHALL BE FACTORY DRILLED/CUT OR MAG-DRILLED IN . NO BURNING SHALL BE ALLOWED. ANY CUTTING OR DRILLING PREFORMED AFTER THE FACTORY COATING HAS LIED SHALL BE TOUCH-UP COATED WITH THE MANUFACTURER'S COATING FIELD TOUCH-UP KITS.

UTION NOTES

BE THE CONTRACTOR'S RESPONSIBILITY TO ENSURE THAT CONSTRUCTION ACTIVITIES PROCEED IN A SMOOTH SEQUENCE AND IN A MANNER THAT WILL NOT CAUSE ANY DAMAGE TO OR CREATE EXCESSIVE STRESS, LOADS, TIONS ON EXISTING OR PROPOSED STRUCTURES UTILITIES.

TRACTOR SHALL PROVIDE ADEQUATE FENCING, BARRICADES, AND SIGNS TO ENSURE SAFETY.

SHALL BE PERFORMED IN ACCORDANCE WITH THE LATEST OSHA REGULATIONS.

TRACTOR SHALL BE RESPONSIBLE FOR PROVIDING A LEVEL AND STABLE SURFACE ON WHICH EQUIPMENT WILL

TRACTOR SHALL BE RESPONSIBLE FOR DEVELOPING ITS OWN PICK/LIFT PROCEDURES INCLUDING, BUT NOT TO SAFE PICKING RADII, LIFTING DEVICES, AND SLINGS.

TRACTOR SHALL BE RESPONSIBLE FOR VERIFYING THE WEIGHT OF EACH PICK AND FOR ENSURING THE STABILITY PICK DURING ALL PHASES OF WORK.

UTILITIES SHALL BE LOCATED AND MARKED IN ACCORDANCE WITH OSHA STANDARDS.

SURFACE RESTORATION NOTES

- DOCUMENTS.
- APPROPRIATE.
- EQUAL OR BETTER IN QUALITY AND CONDITION TO THE ITEMS REMOVED.
- THE NEW HAMPSHIRE AT NO ADDITIONAL COST TO THE OWNER.
- THE CONSTRUCTION SEASON AND PRIOR TO FINISHED PAVING.
- 6. TRANSFER ALL TEMPORARY BENCHMARKS, AS NECESSARY.
- ADDITIONAL COST TO THE OWNER.
- INDICATED ON THE DRAWINGS.

7. THE CONTRACTOR SHALL TAKE ALL NECESSARY PRECAUTIONS TO LOCATE AND PROTECT EXISTING UTILITIES IN THE AREA AS REQUIRED. OVERHEAD POWER LINES ADJACENT TO WORK AREAS ARE TO BE SHUT DOWN DURING OPERATIONS WHEN THE CONTRACTOR BELIEVES THEY MAY INTERFERE, OR ARE TOO CLOSE TO THE WORK. WHEN POWER LINES IN THE WORK AREA CAN NOT BE DEENERGIZED, THE CONTRACTOR SHALL MAINTAIN A SAFE DISTANCE AS DETERMINED BY OSHA. ALL

1. ALL PAVEMENT DAMAGED BY THE CONTRACTOR'S OPERATIONS SHALL BE REPLACED IN ACCORDANCE WITH THE CONTRACT

PROTECT PROJECT FEATURES (E.G., WALLS, FENCES, MAIL BOXES, SIGNS, SIDEWALKS, CURBING, STAIRS, WALKWAYS, TREES, ETC.) FROM DAMAGE DURING CONSTRUCTION, INCLUDING PROVIDING TEMPORARY SUPPORTS, WHEN

3. IF REMOVAL OF PROJECT FEATURES IS REQUIRED IN ORDER TO PERFORM THE PROPOSED WORK, REMOVE THOSE SITE FEATURES ONLY UPON APPROVAL OF THE ENGINEER. REPLACE ALL REMOVED PROJECT FEATURES; NEW ITEMS SHALL BE

4. EXISTING SURVEY MONUMENTS DISTURBED BY THE CONTRACTOR SHALL BE REPLACED BY A LAND SURVEYOR LICENSED IN

5. COORDINATE THE ADJUSTMENT OF EXISTING UTILITY STRUCTURES WITH EACH RESPONSIBLE UTILITY OWNER PRIOR TO RECONSTRUCTION AND/OR PAVING OPERATIONS. RAISE ALL STRUCTURES TO FINISHED GRADES PRIOR TO THE END OF

7. RESTORE ALL AREAS DISTURBED BY THE CONTRACTOR BEYOND THE PAYLINE LIMITS TO ORIGINAL CONDITIONS AT NO

8. REGRADE ALL UNPAVED AREAS DISTURBED BY THE WORK AS REQUIRED. REPAIR/REPLACE PAVED SURFACES DISTURBED BY THE WORK IN-KIND, UNLESS OTHERWISE NOTED. RESTORE SURFACES TO EXISTING OR PROPOSED CONDITIONS AS



U $\mathbf{\Omega}$ Ŷ O LL U

U



95 Mechanic **Street Seawall** & Wharf Replacement


City of Portsmouth





Portsmouth, New Hampshire


	4/29/2021	ADDENDUM 2			
MARK	DATE	DESCRIPTION			
PROJEC	CT NO:	P-0714-003			
DATE:		MARCH 24, 2021			
FILE:		General Notes.dwg			
DRAWN BY: JAK					
CHECKED: GC					
APPROVED: DAM					
GENERAL NOTES - 2					
SCAL	SCALE: AS SHOWN				
G-004					




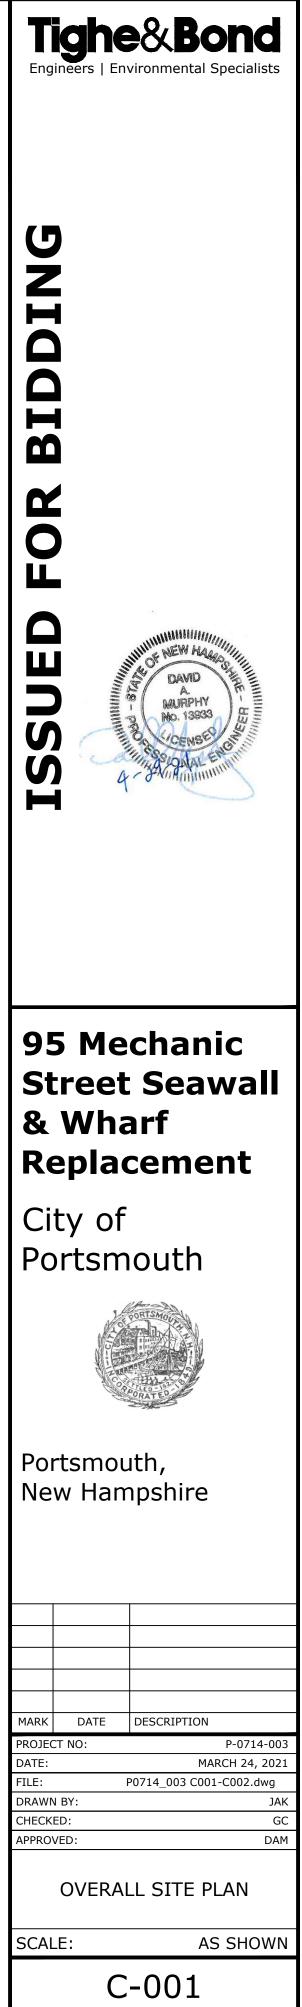


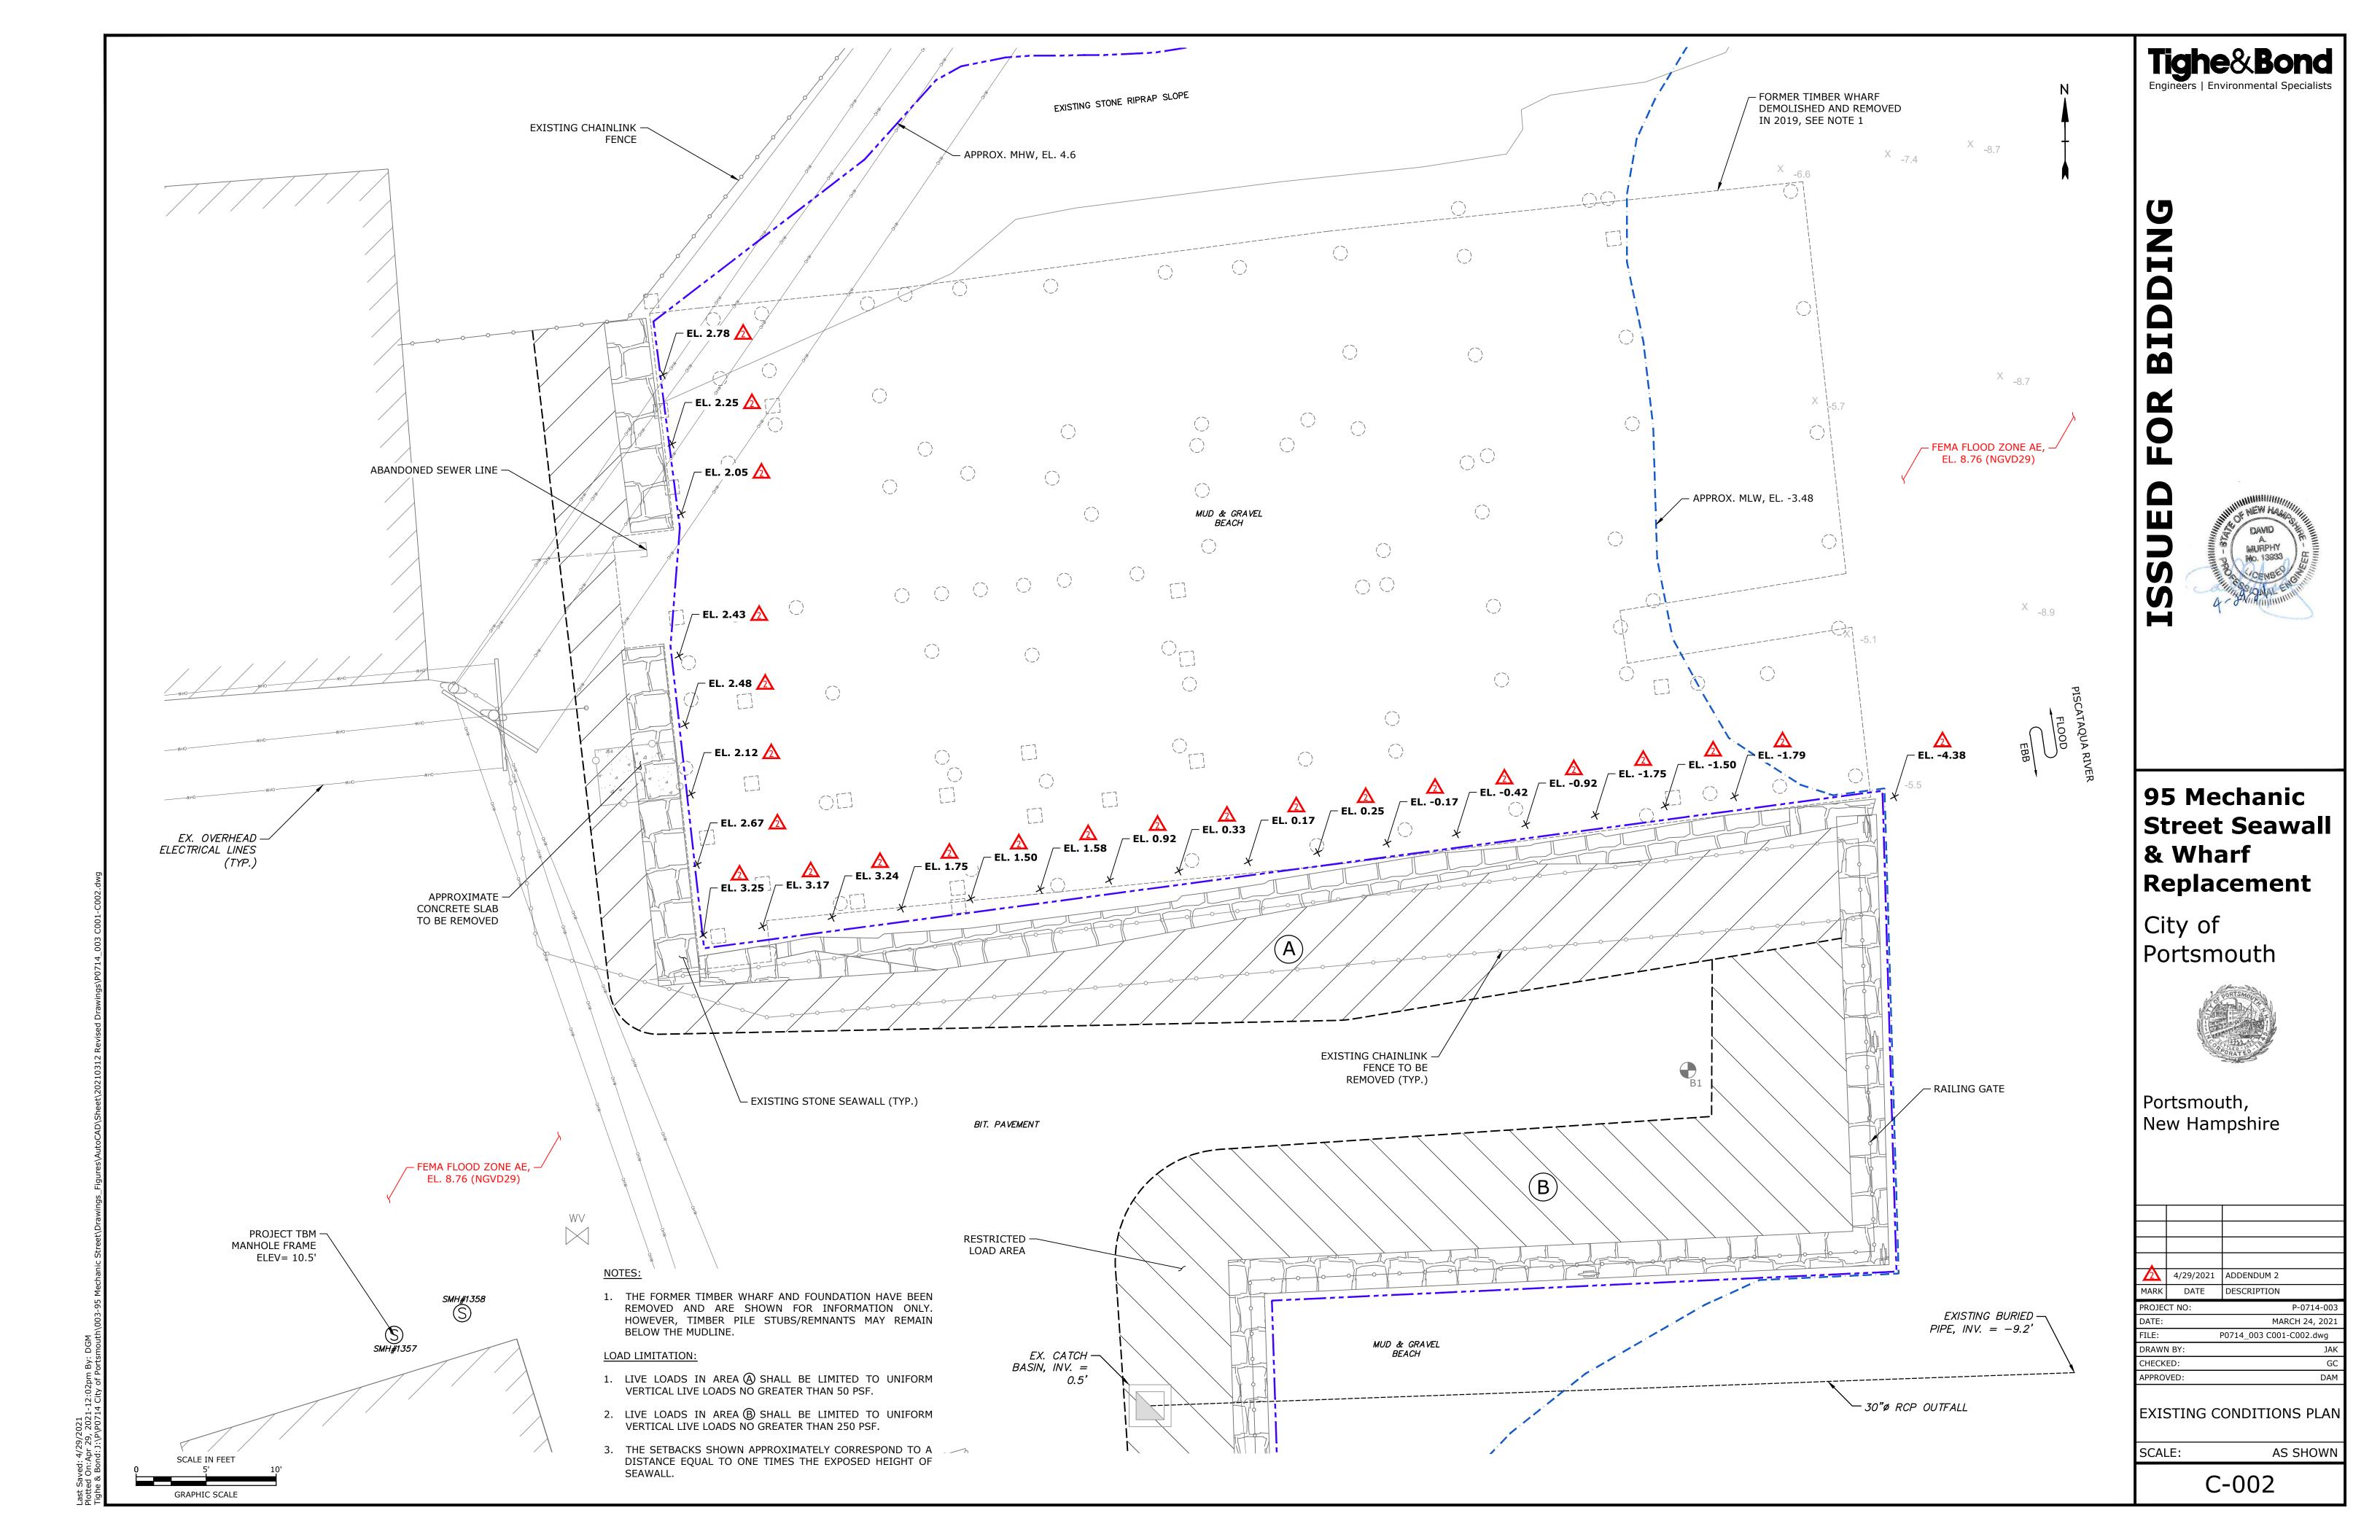


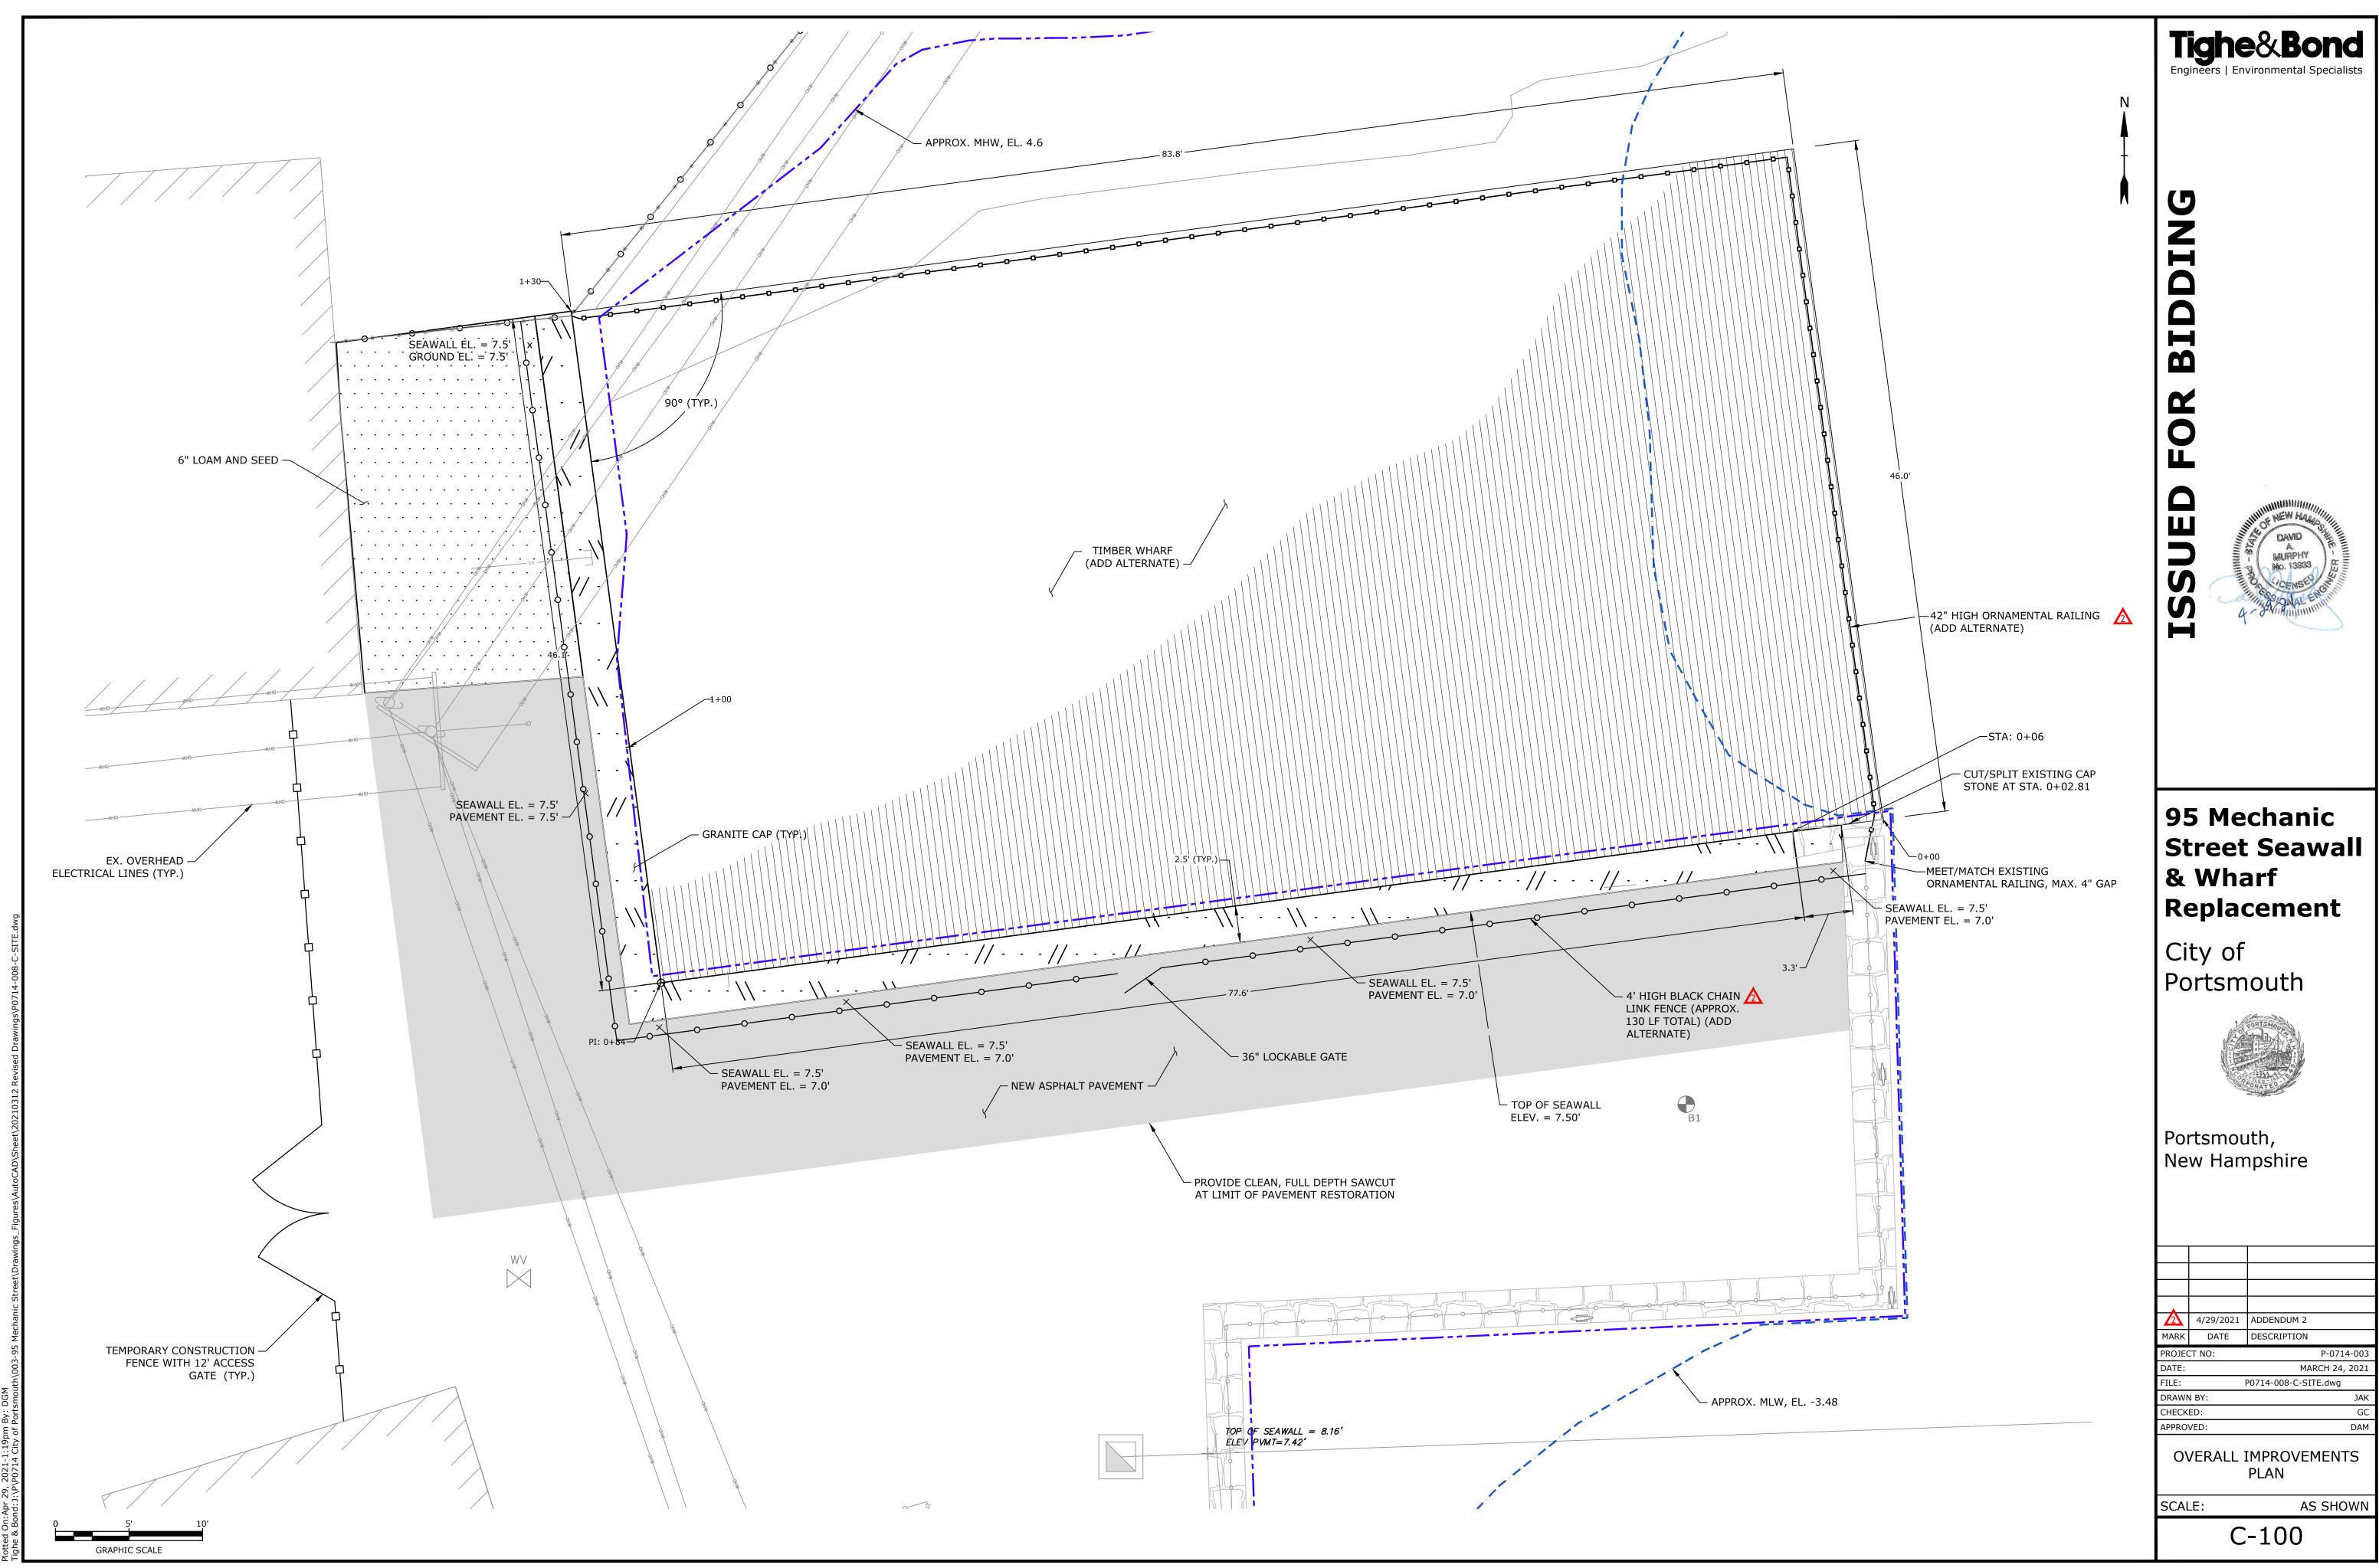


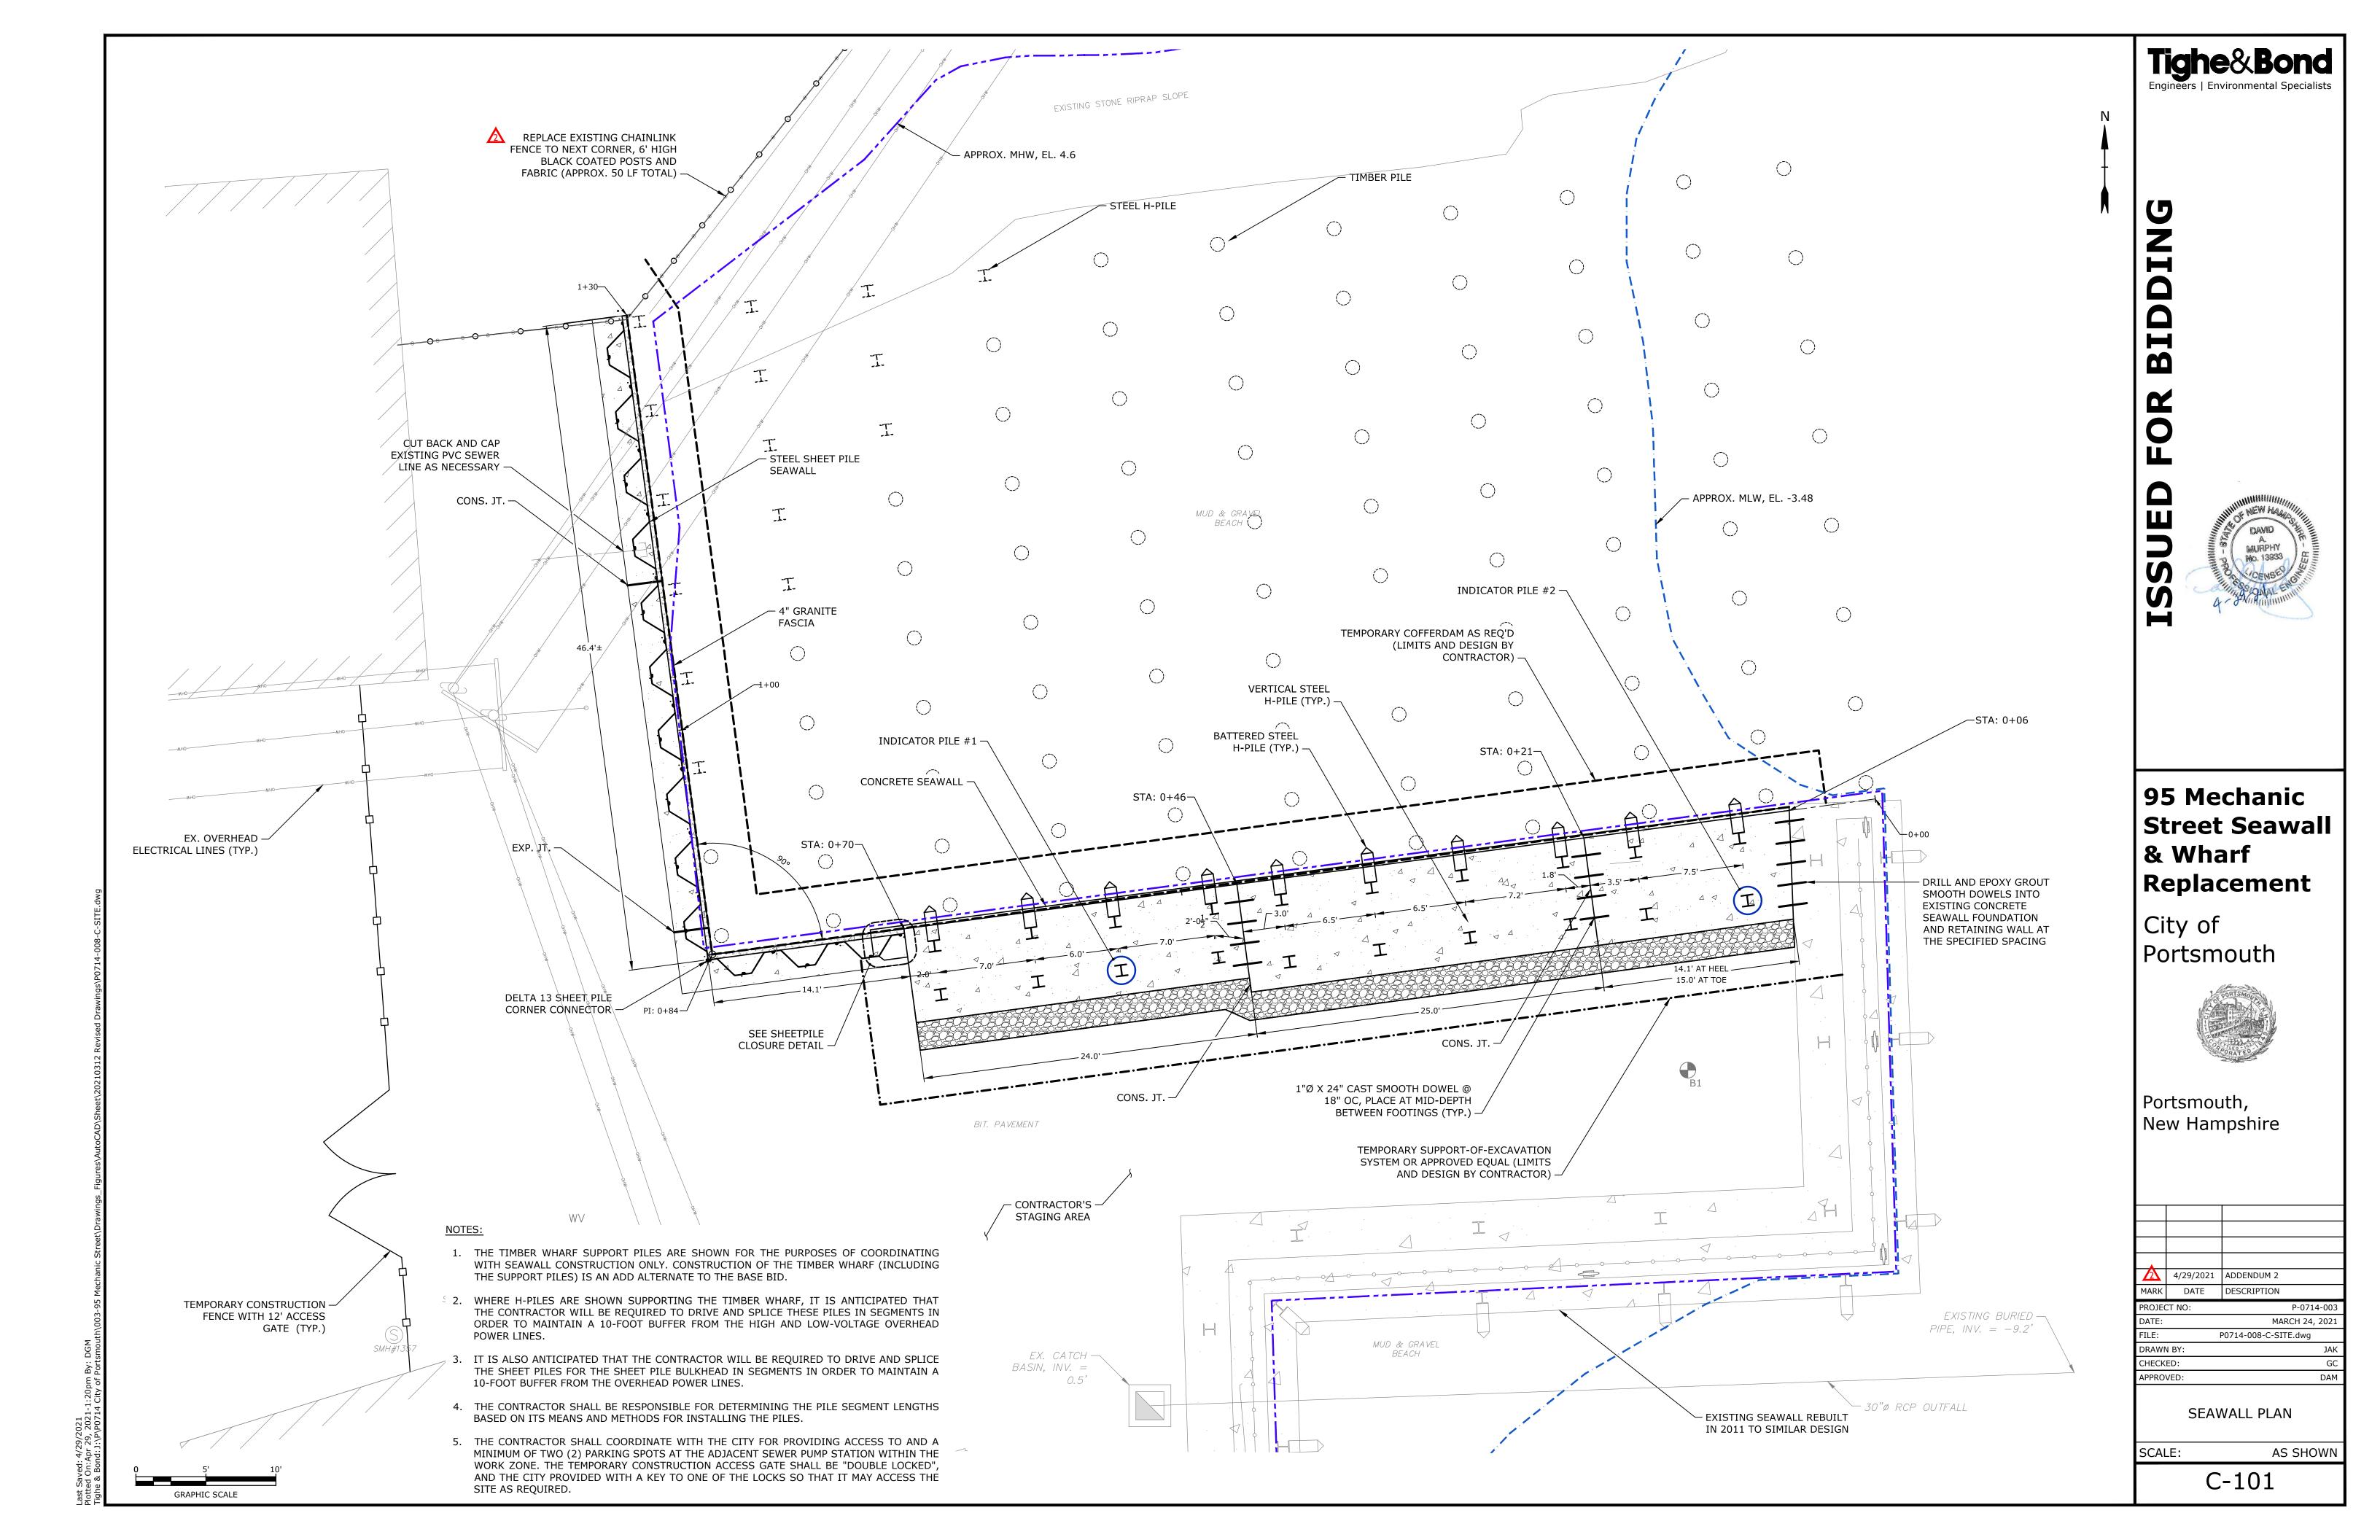


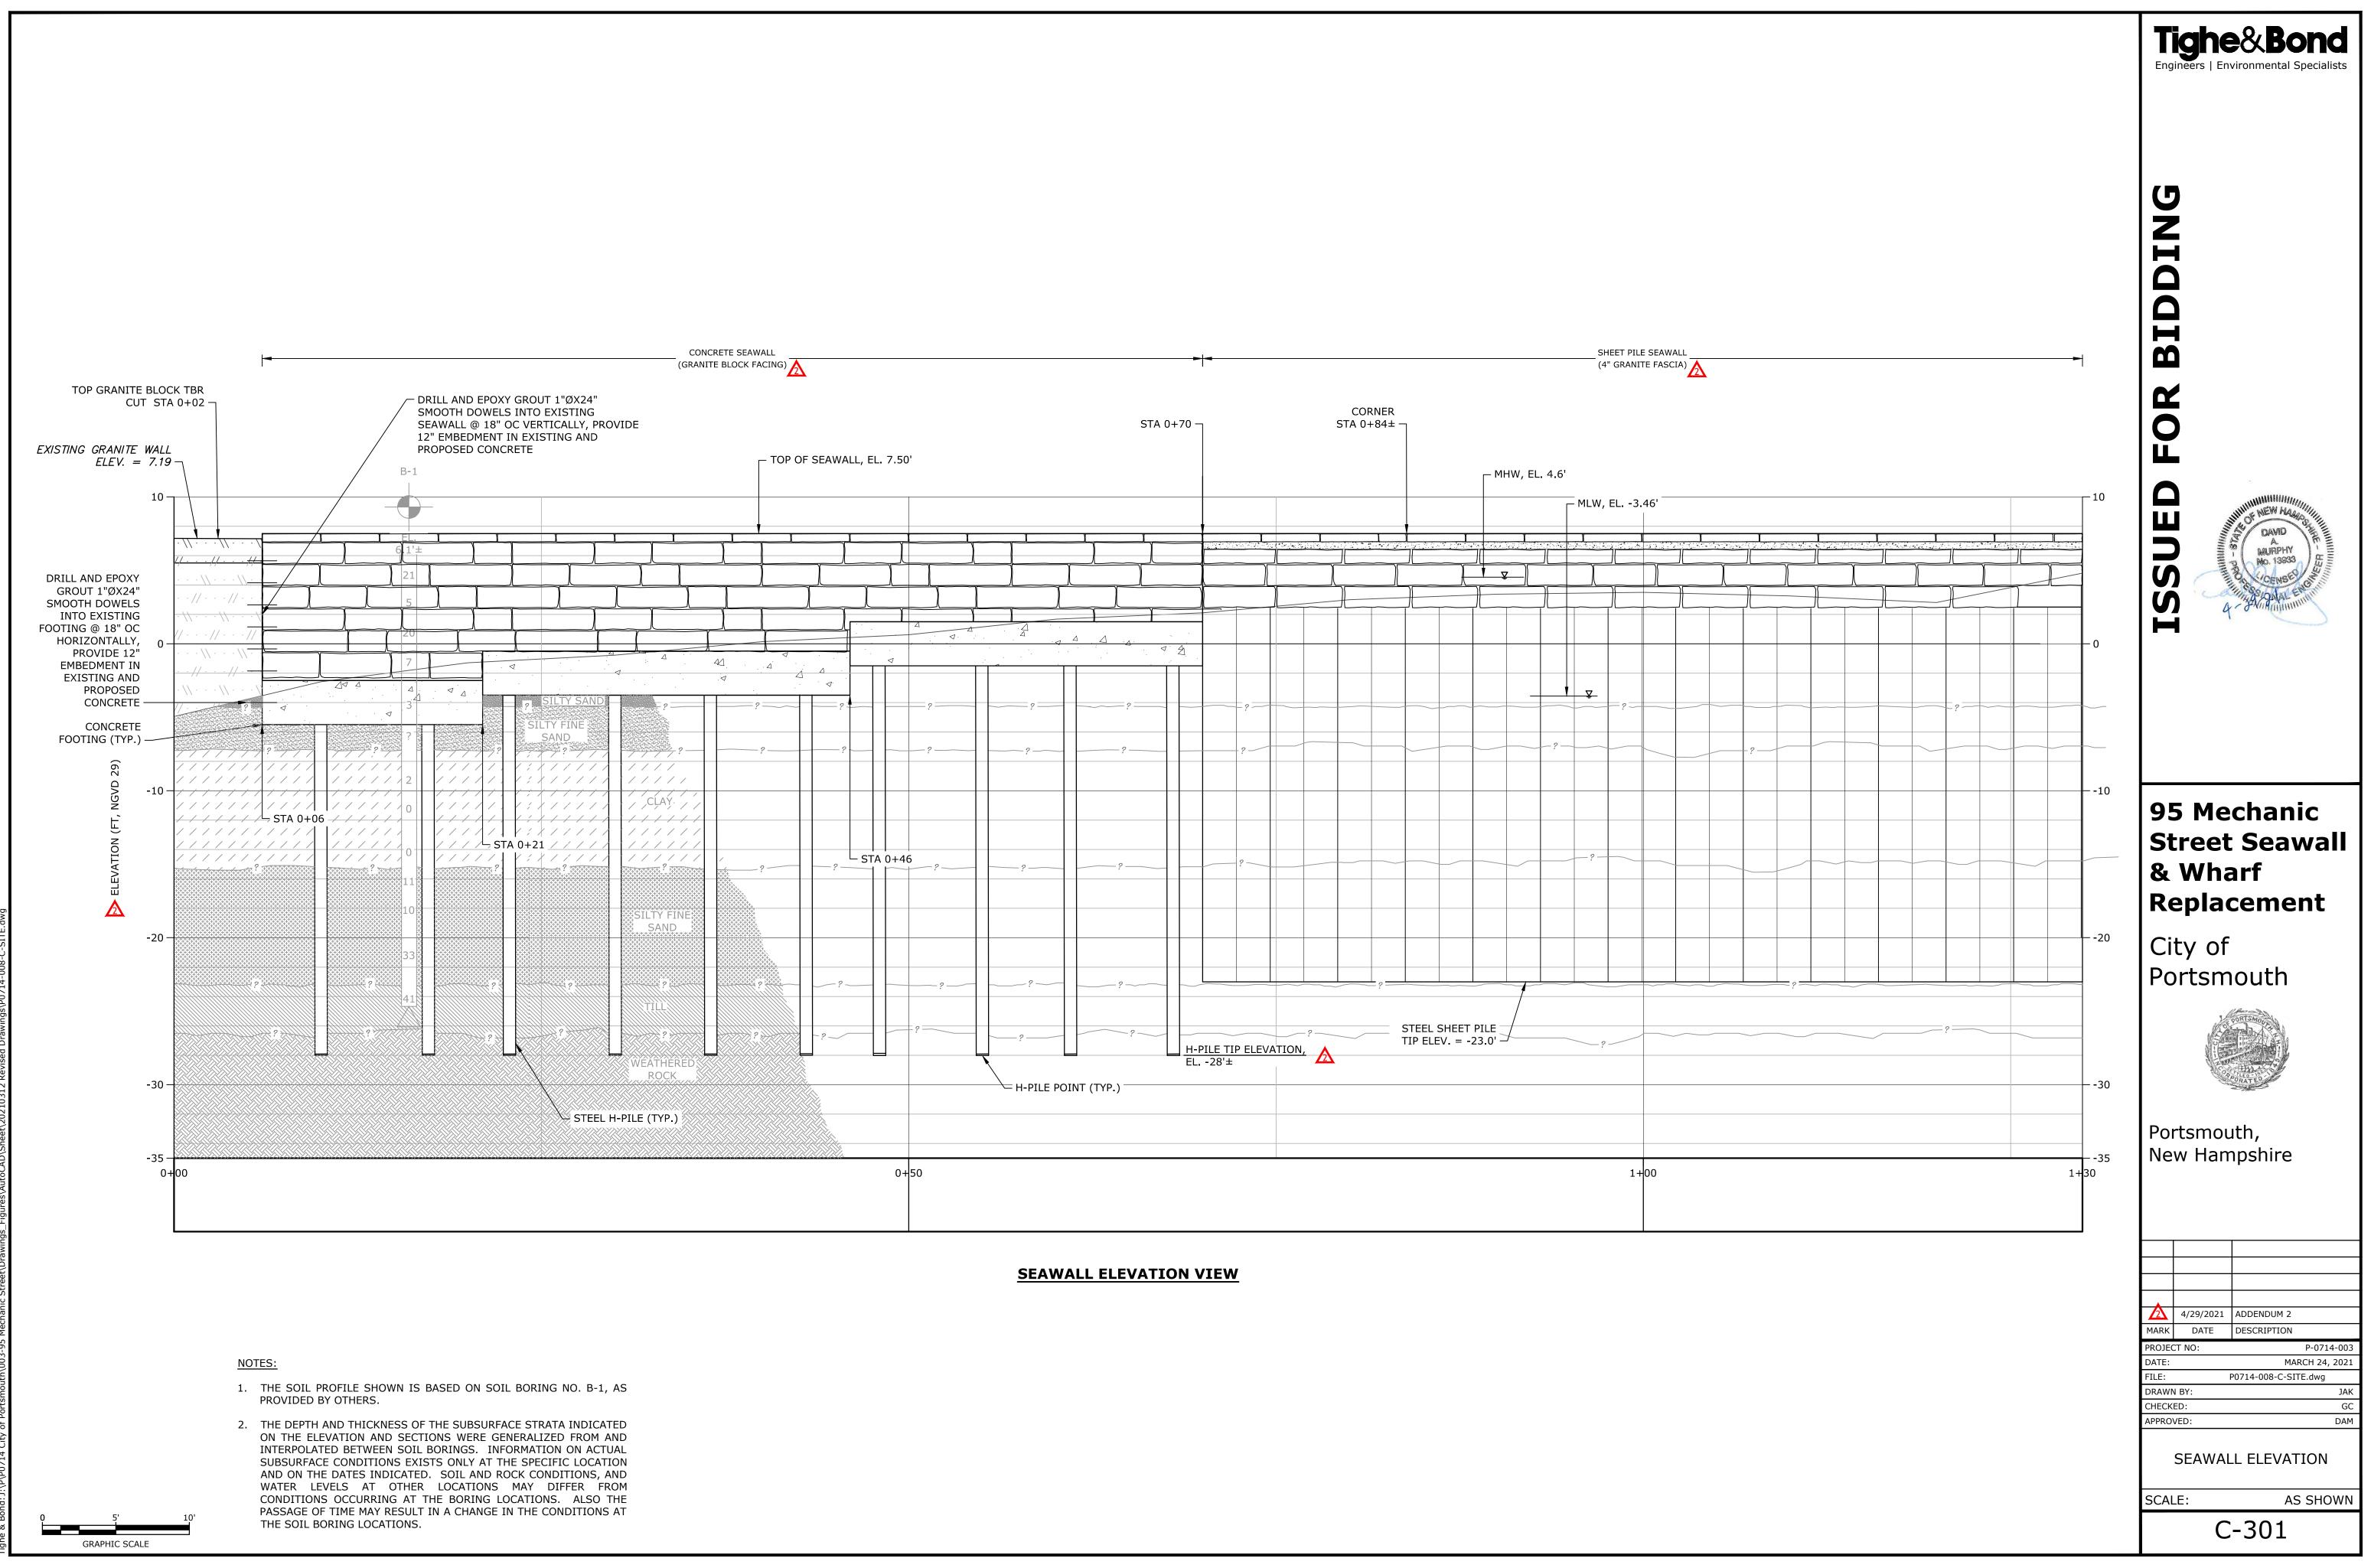


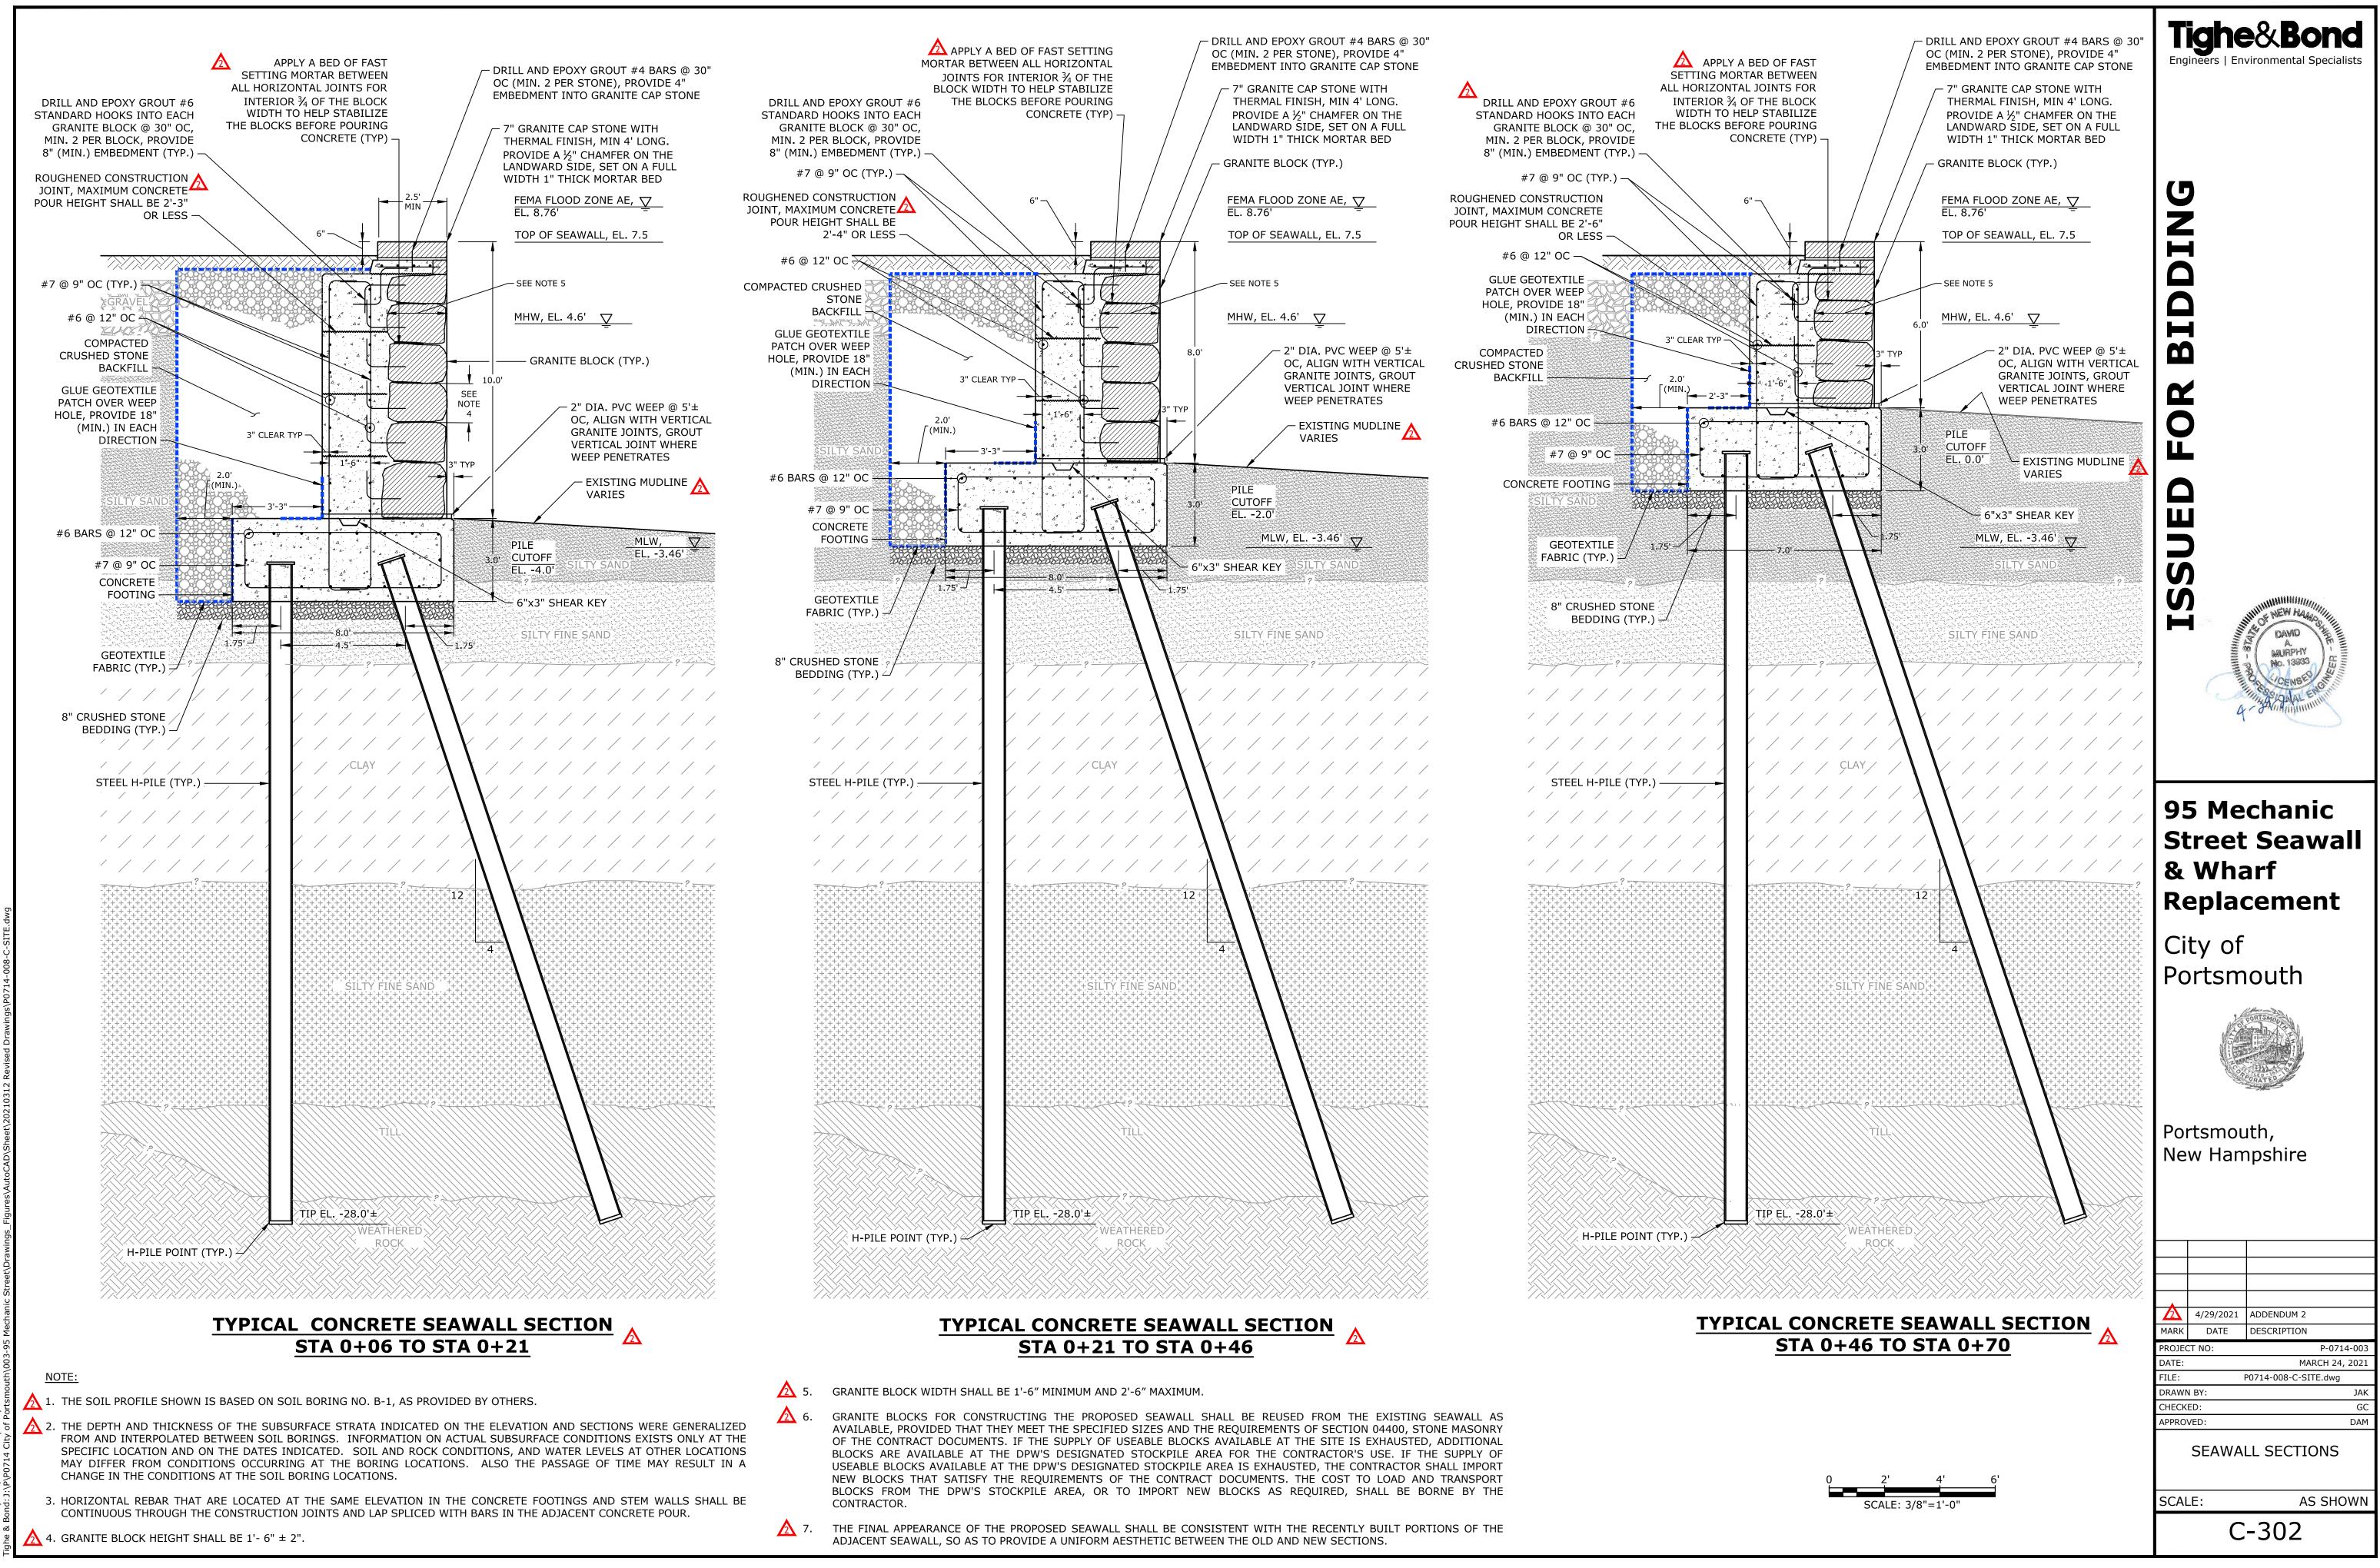


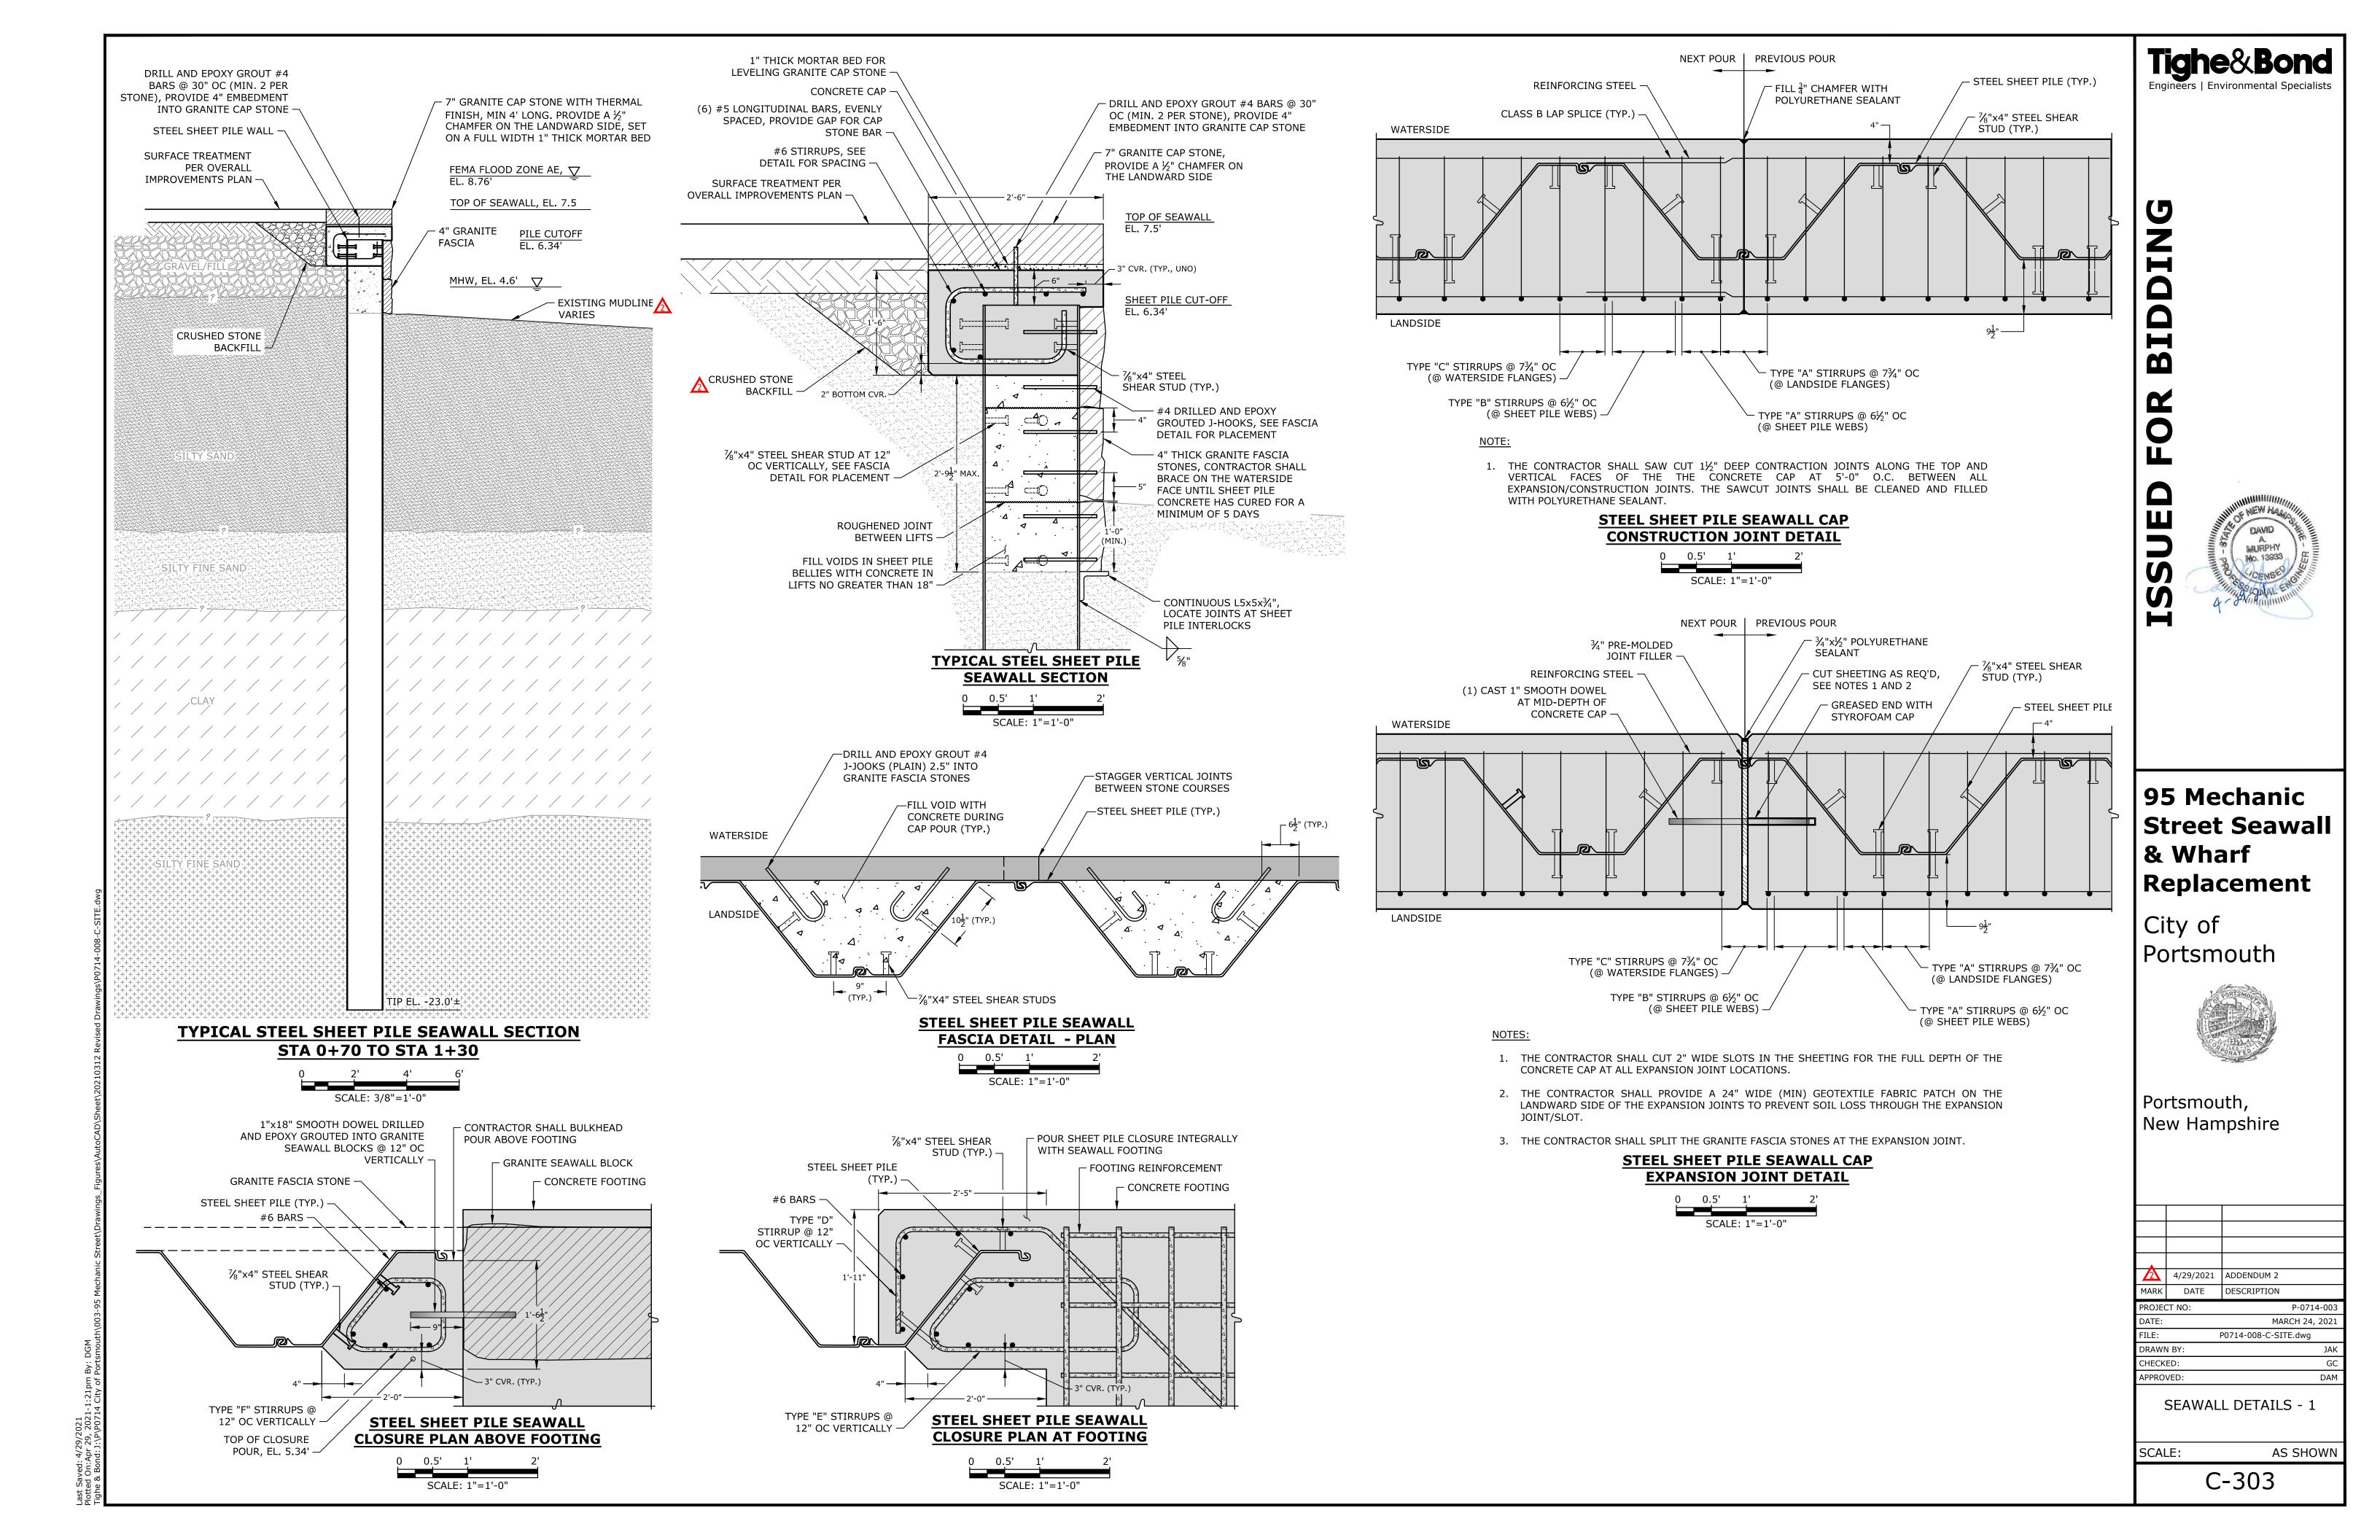

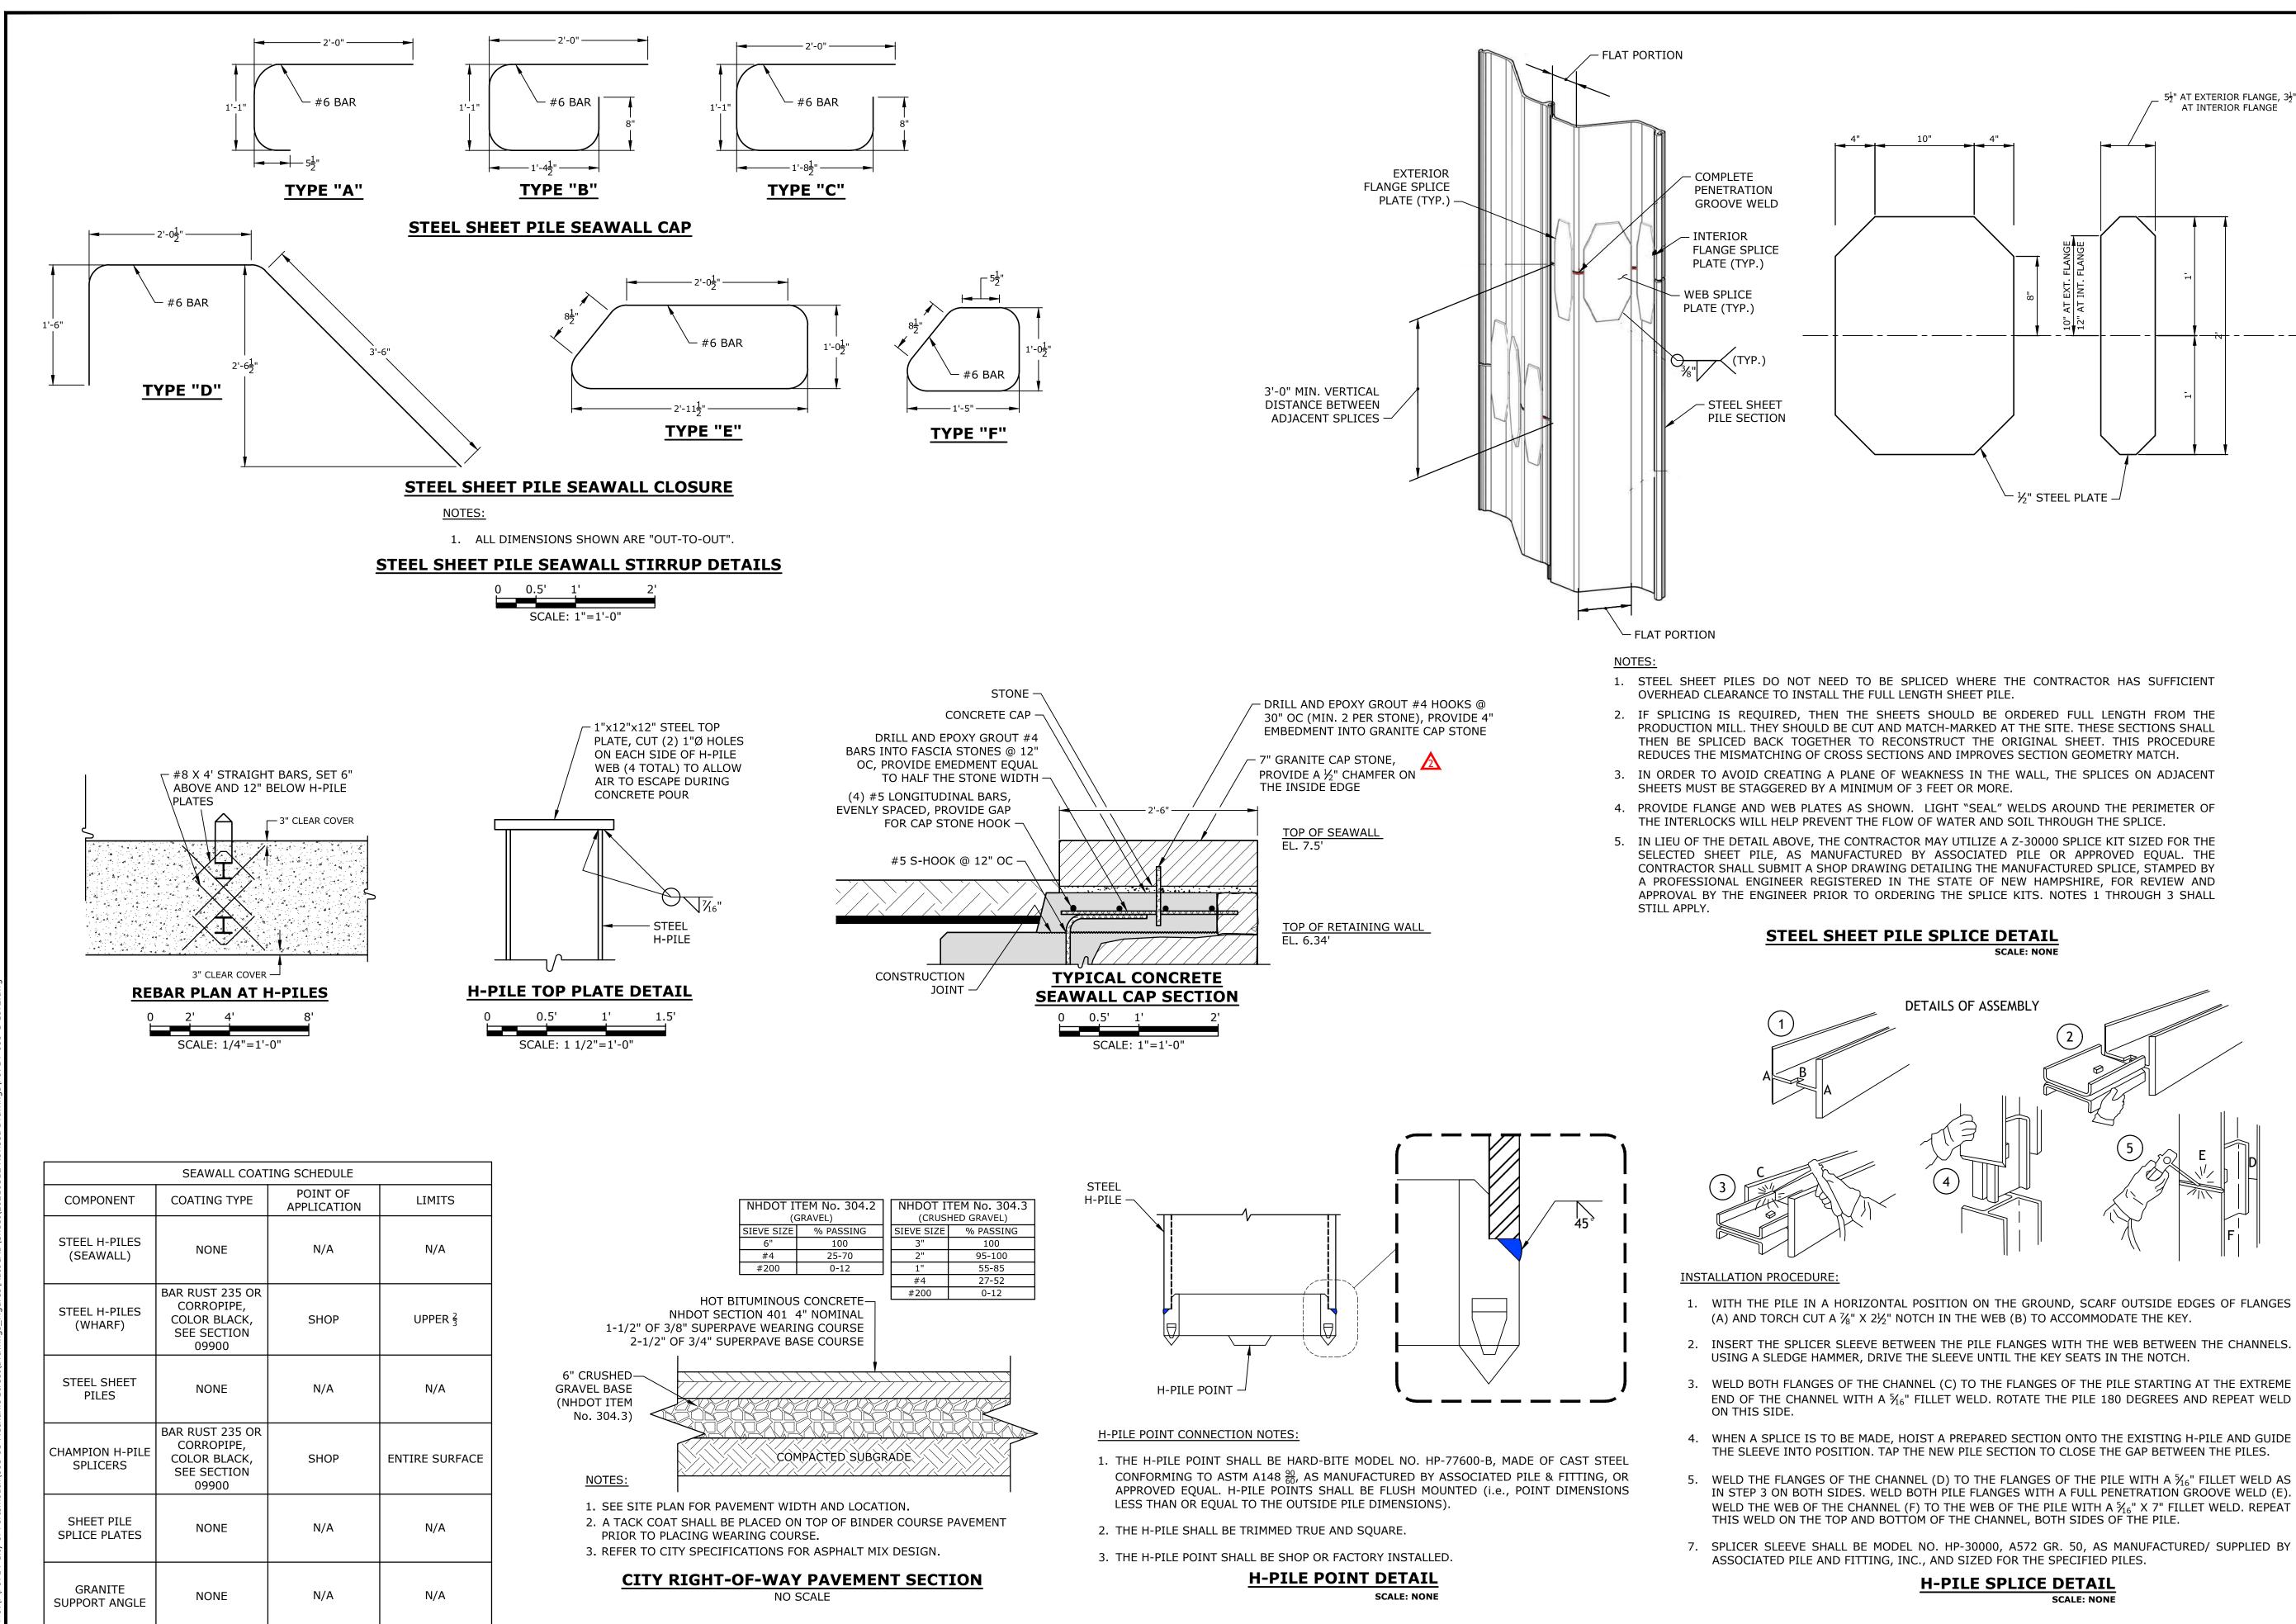


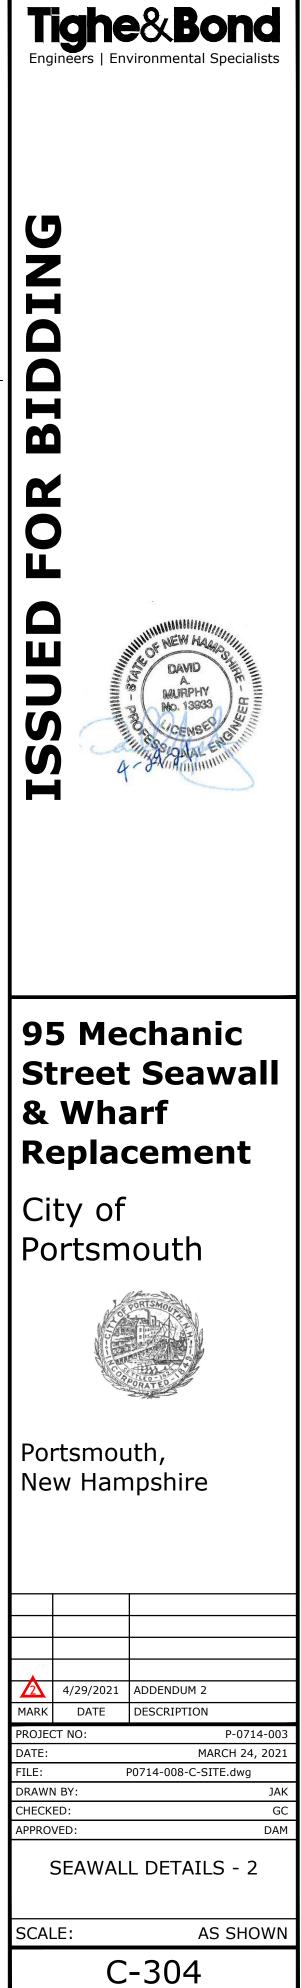


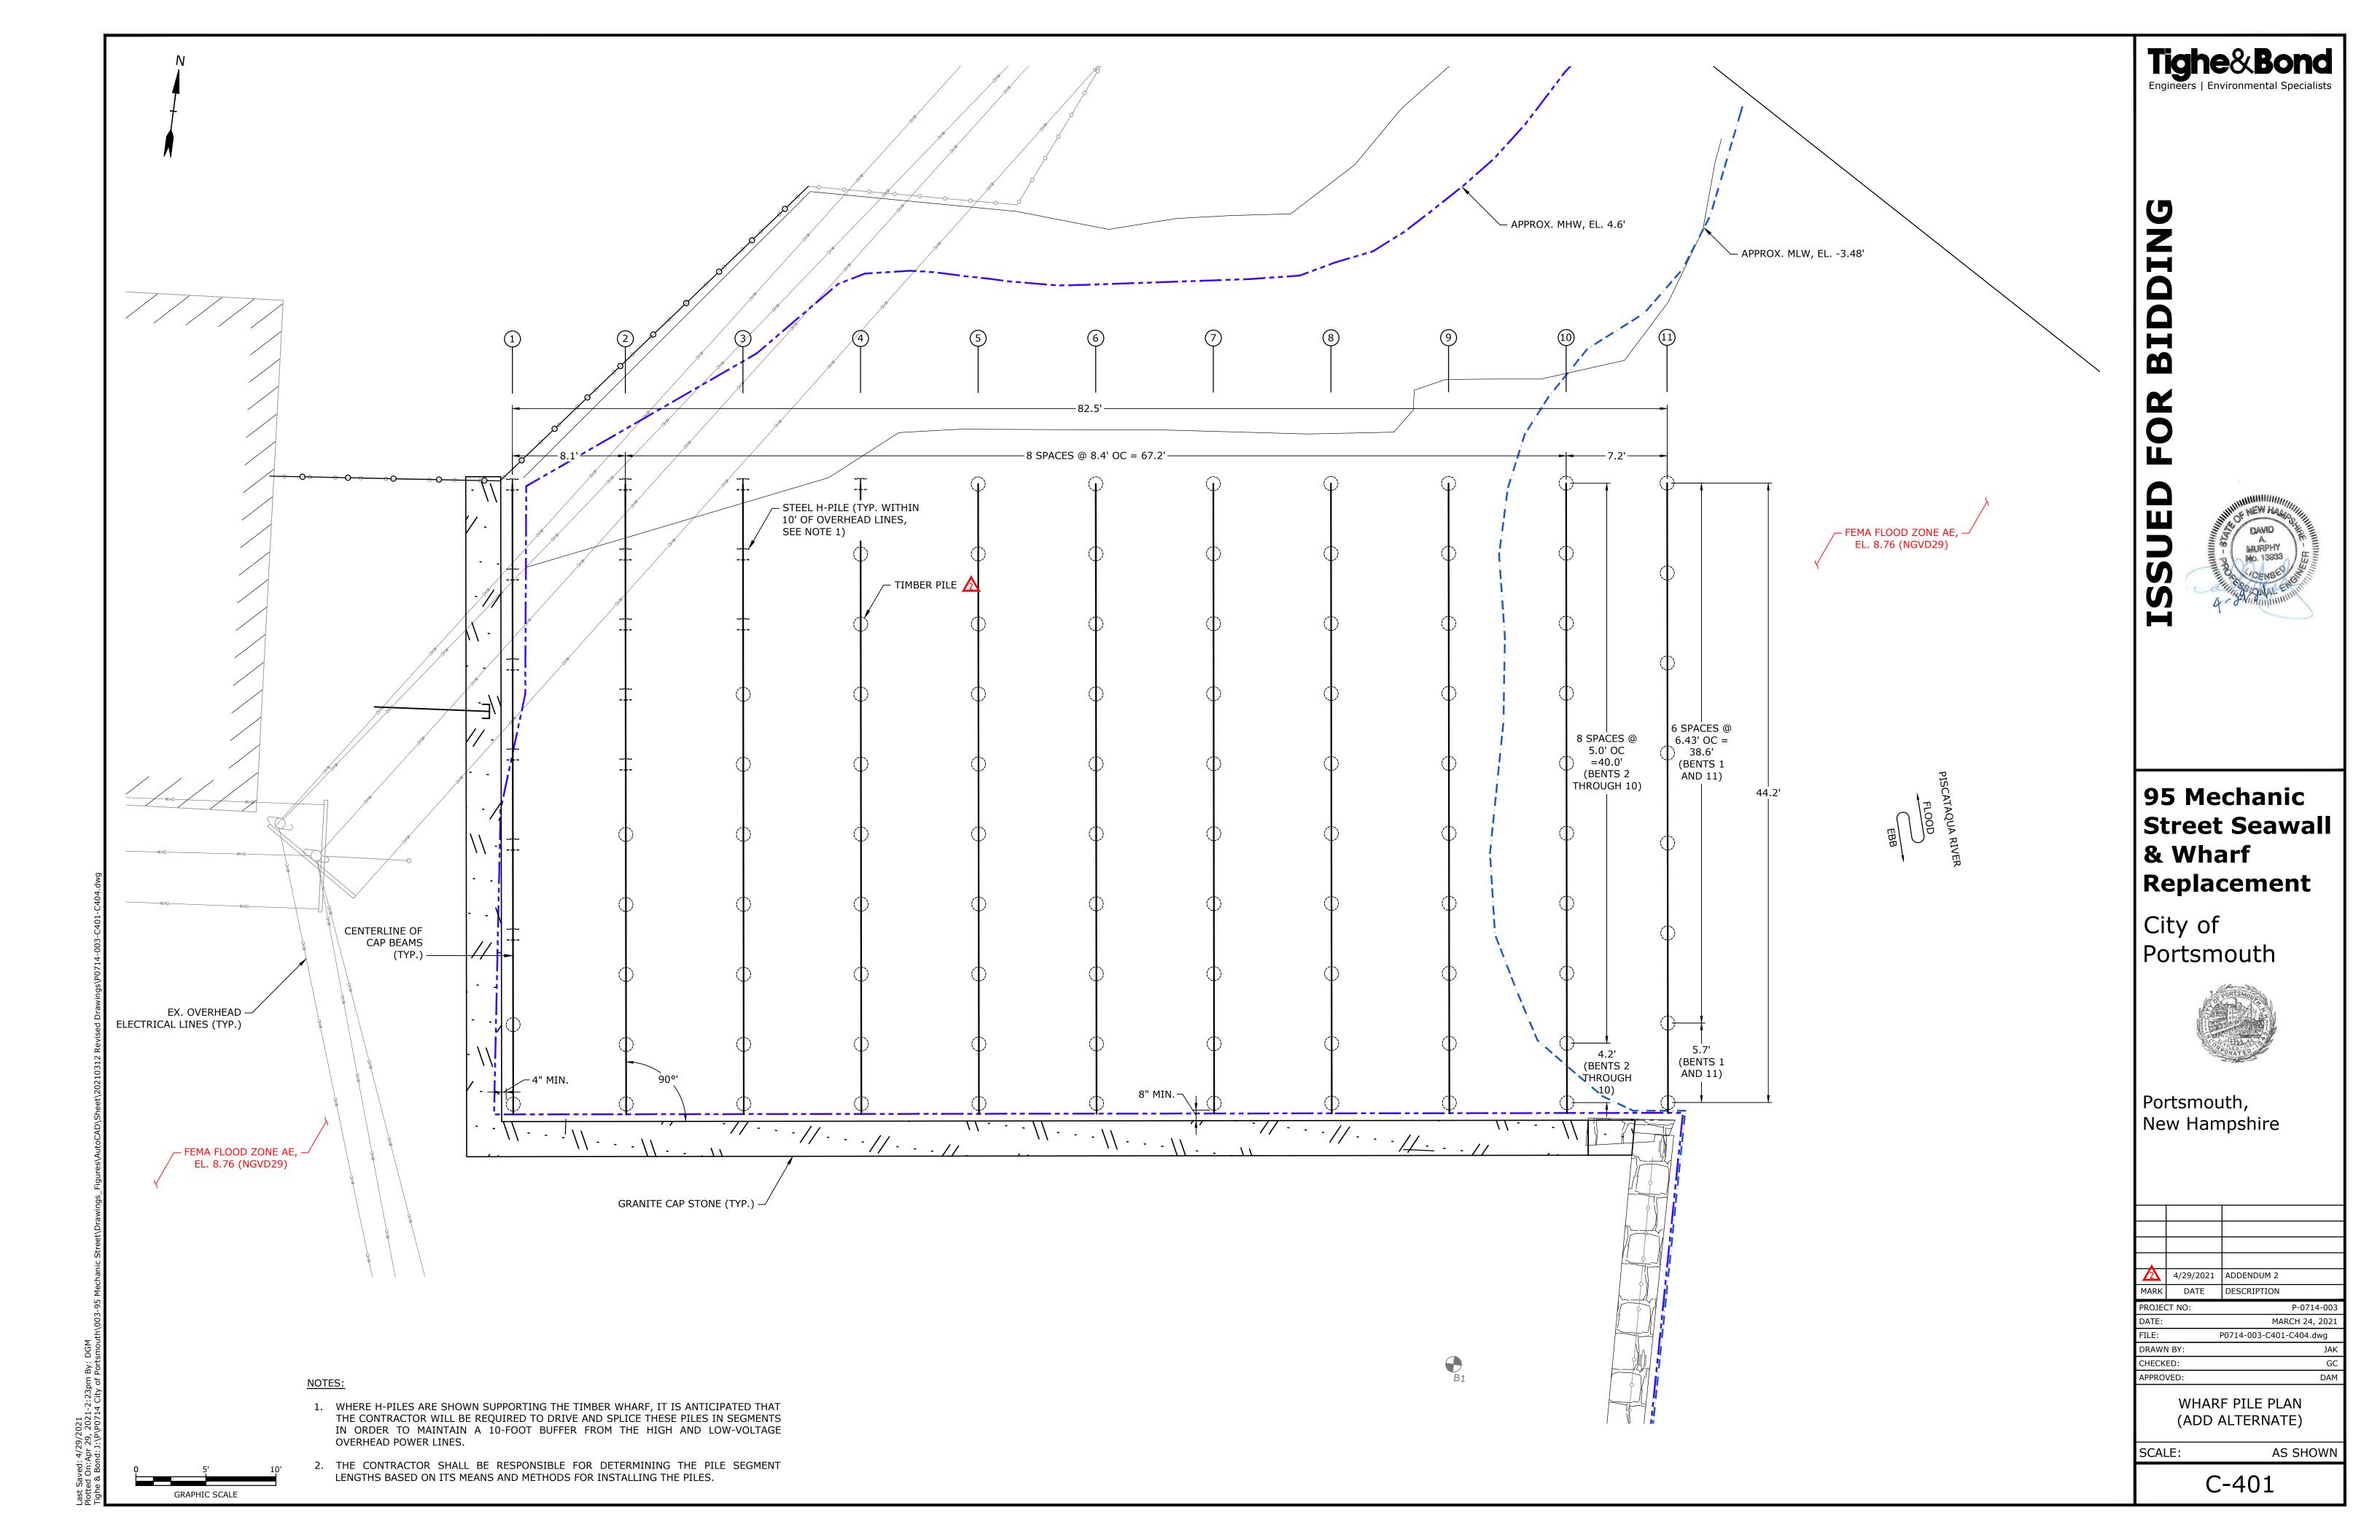


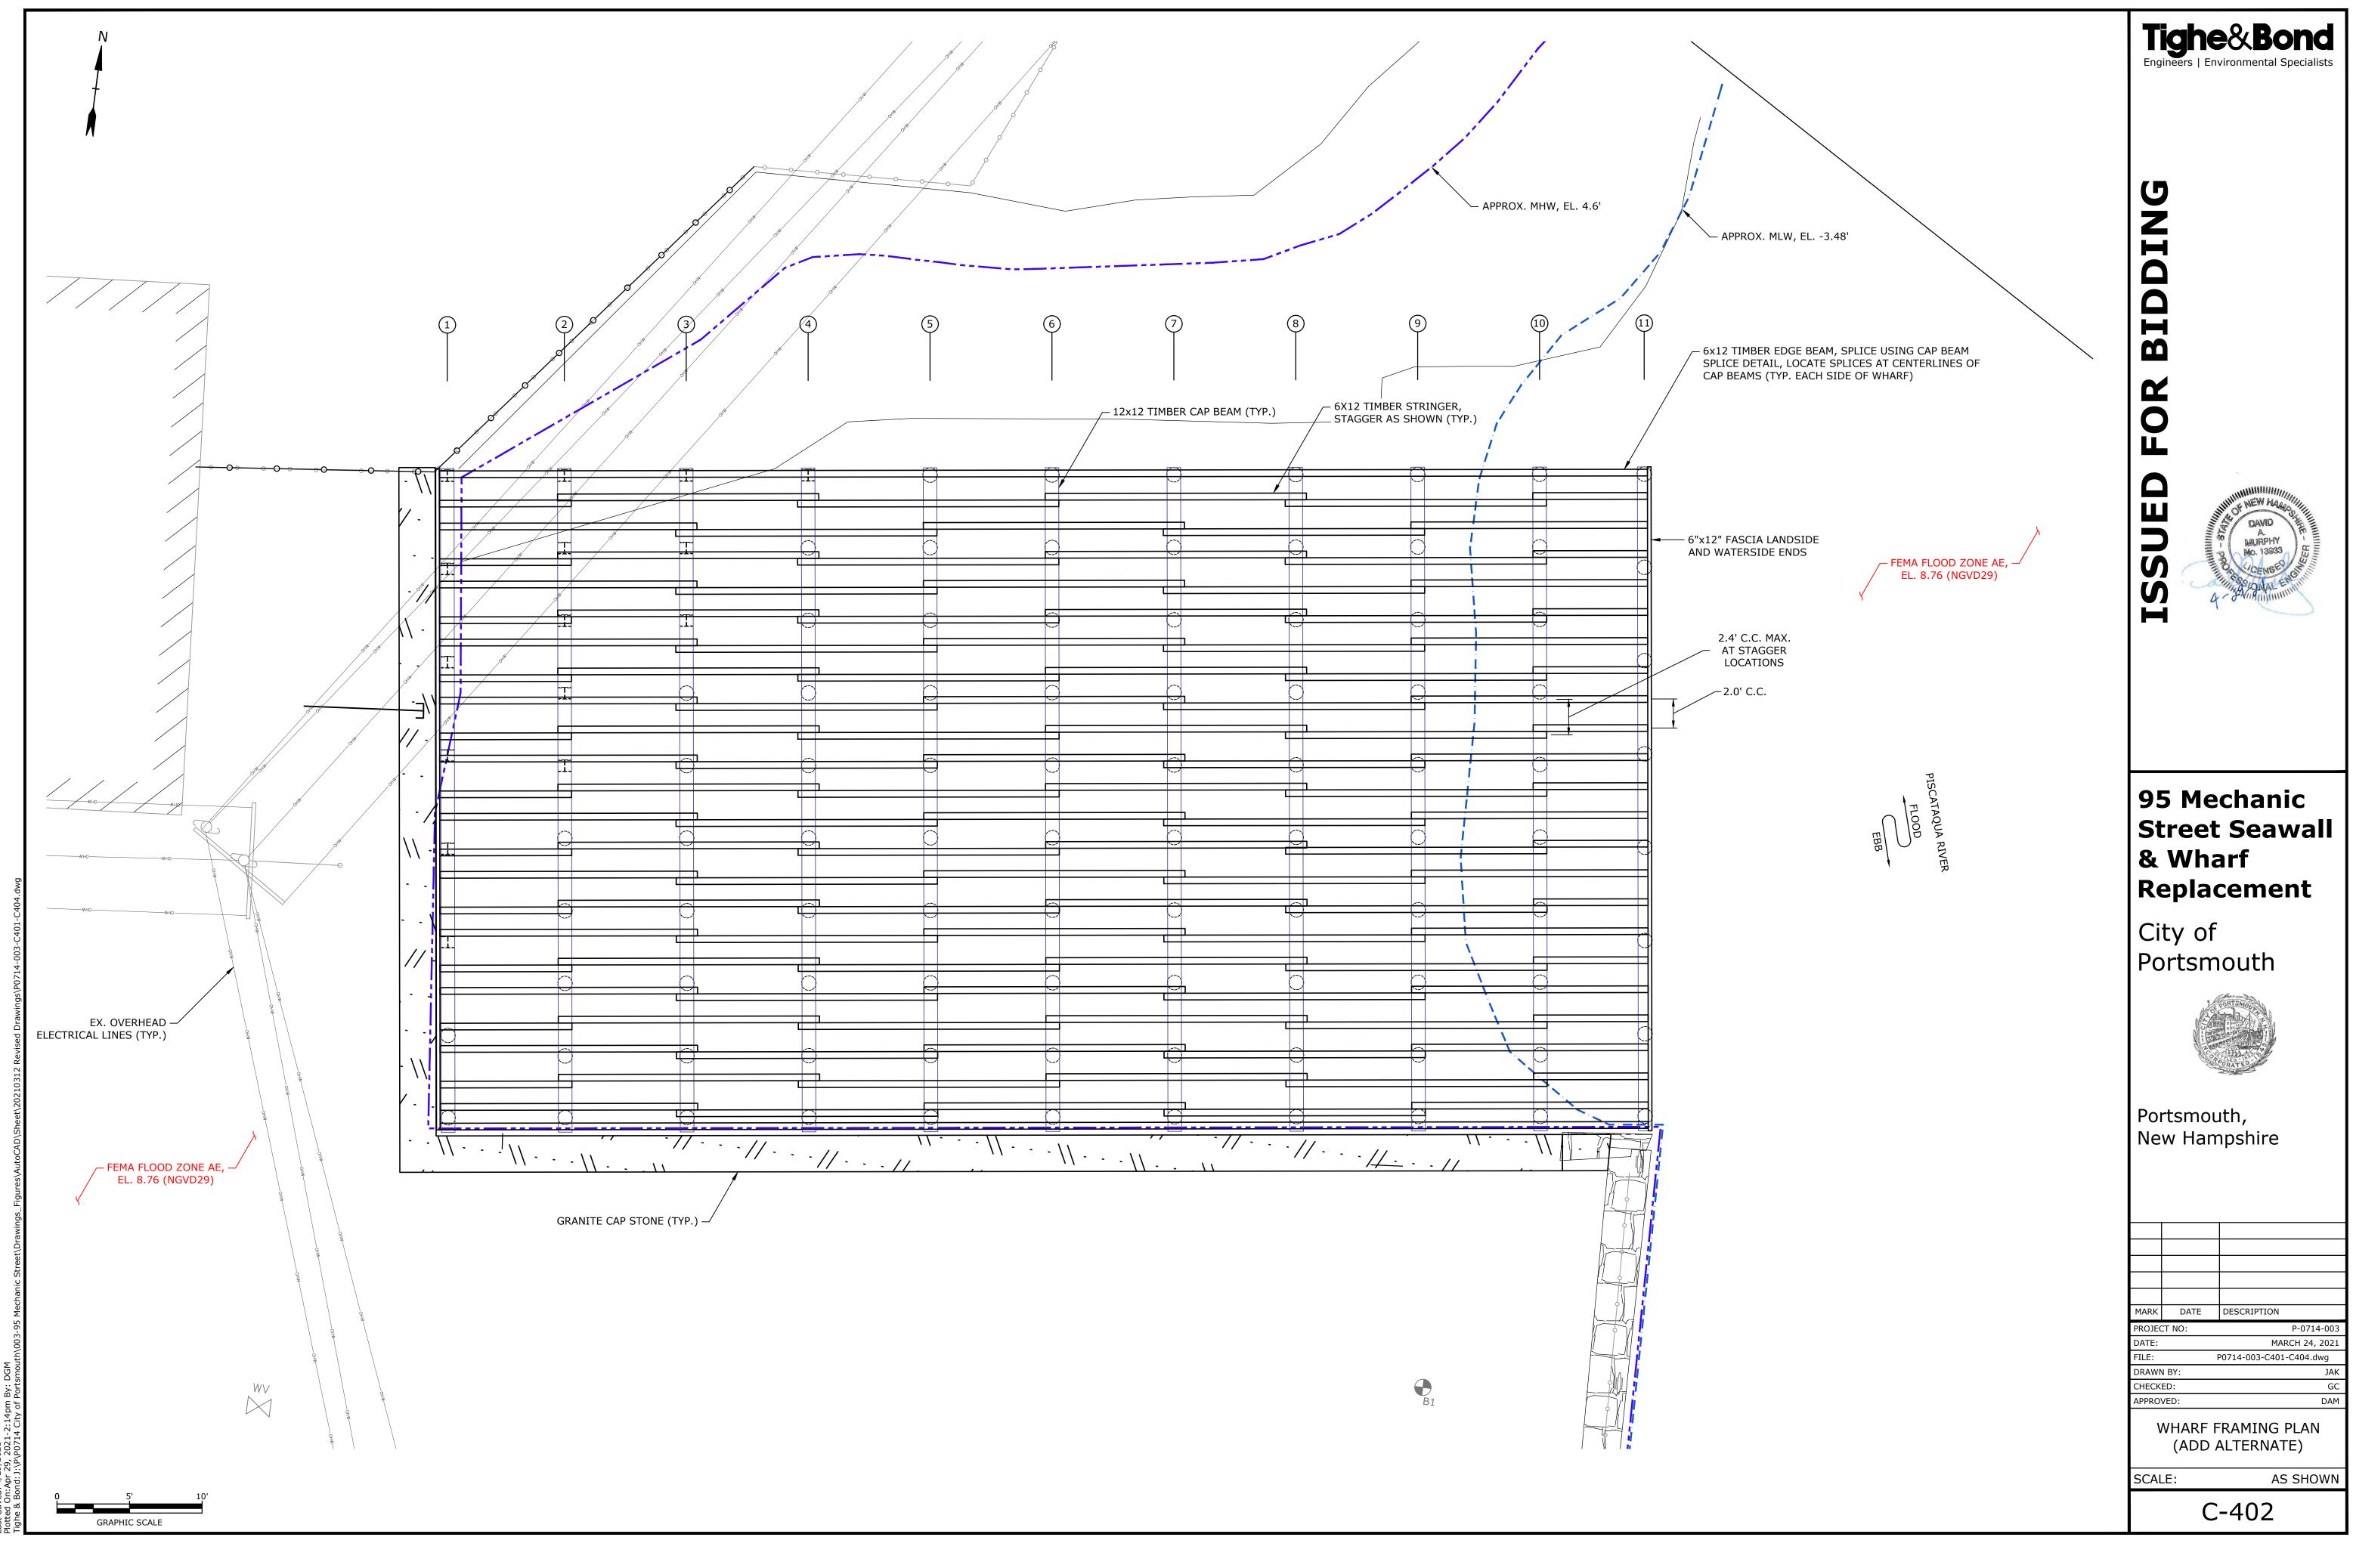




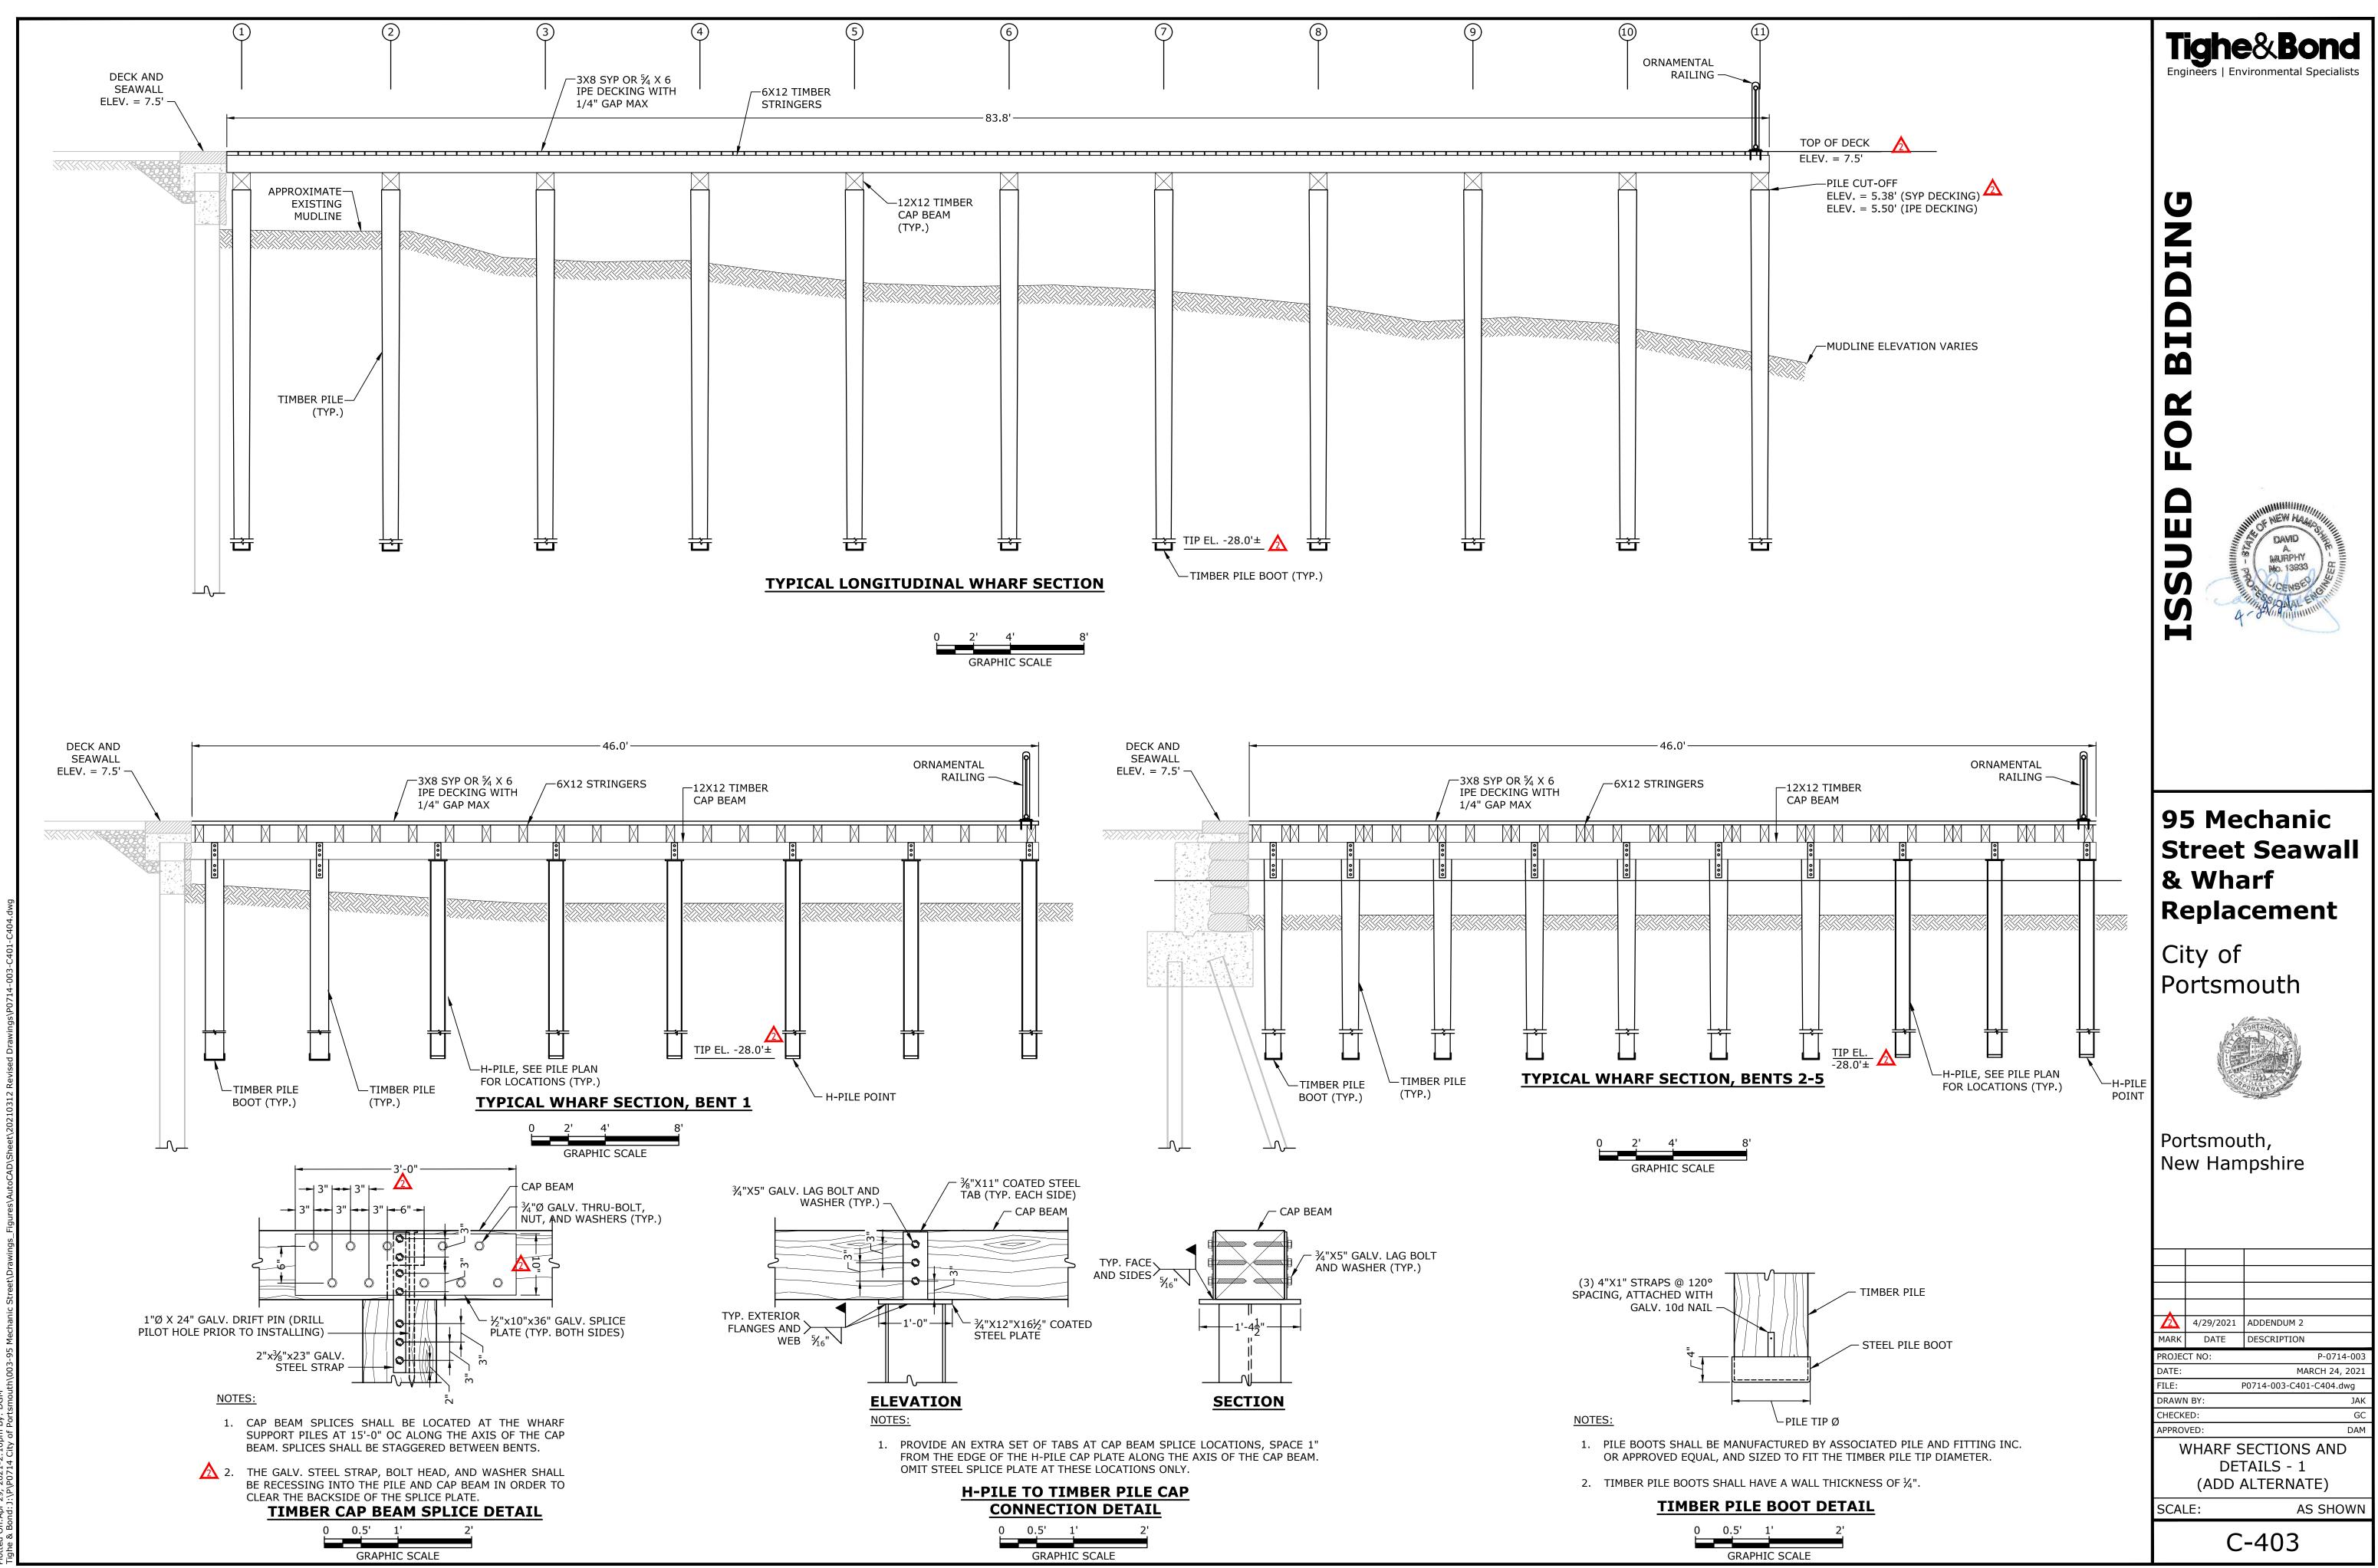

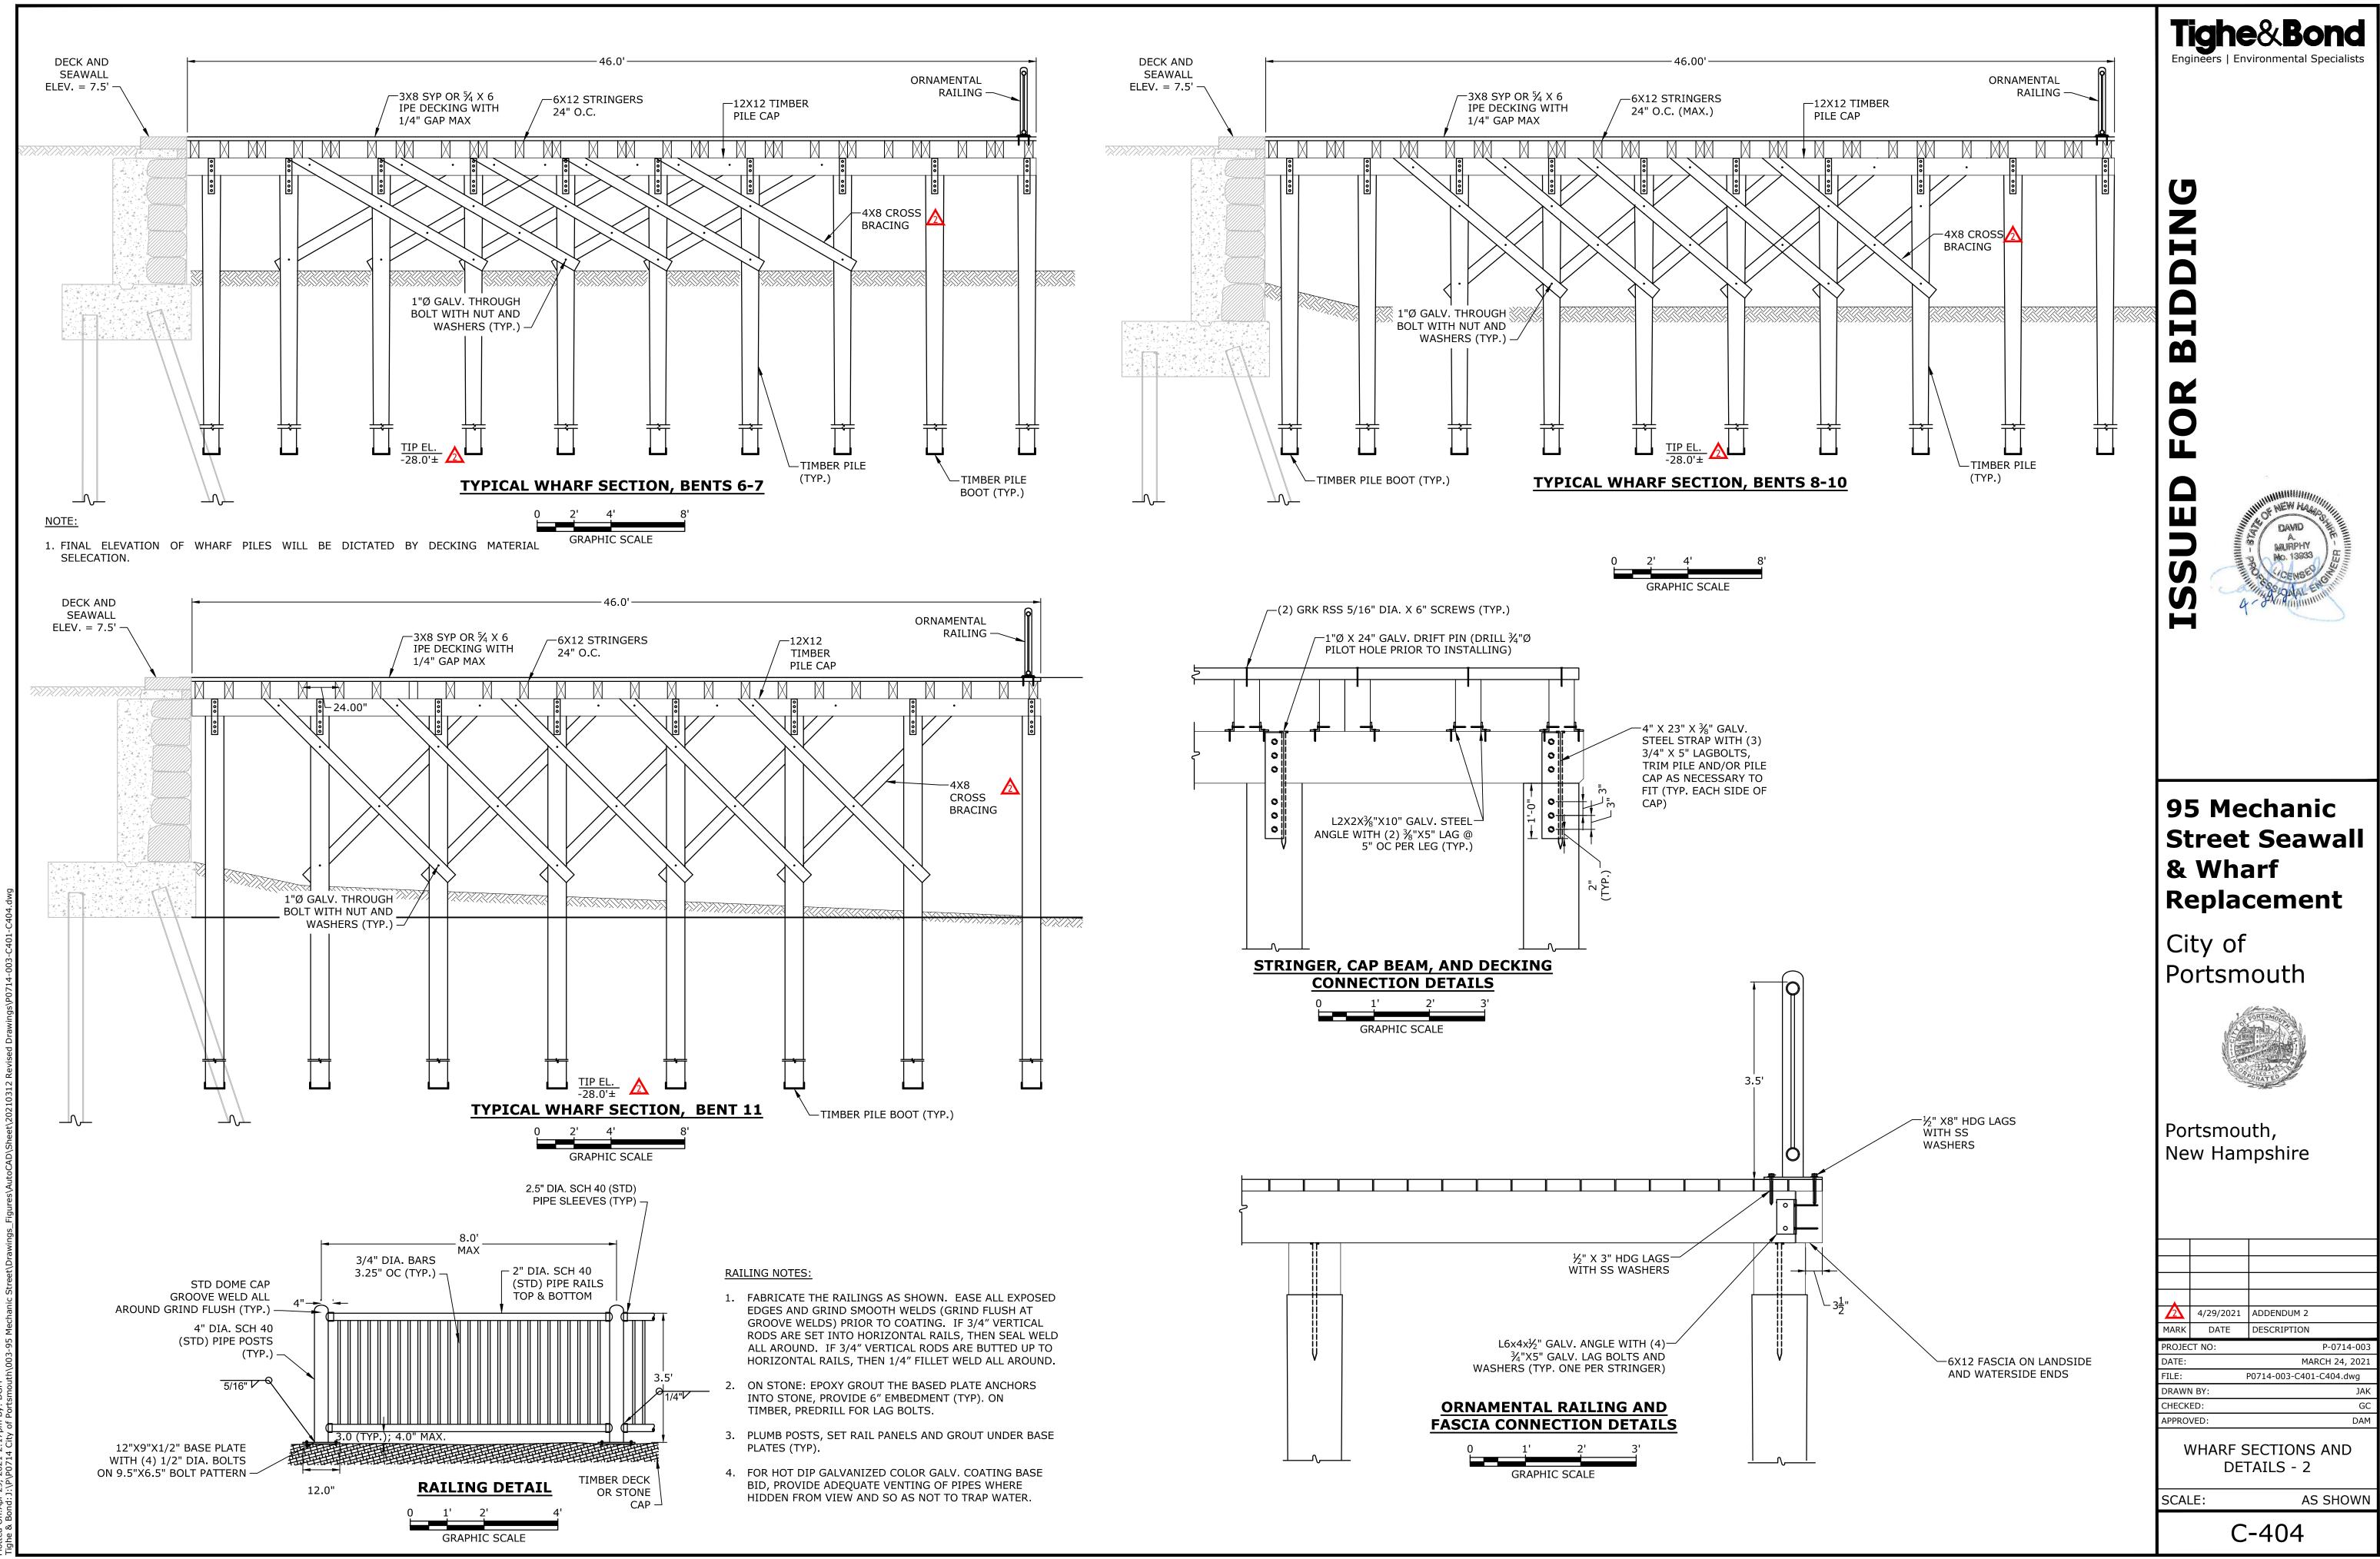


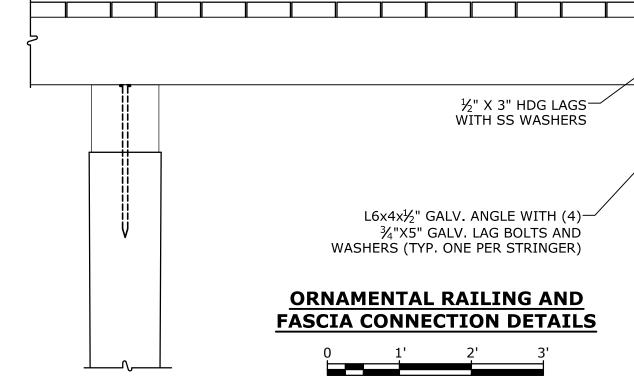


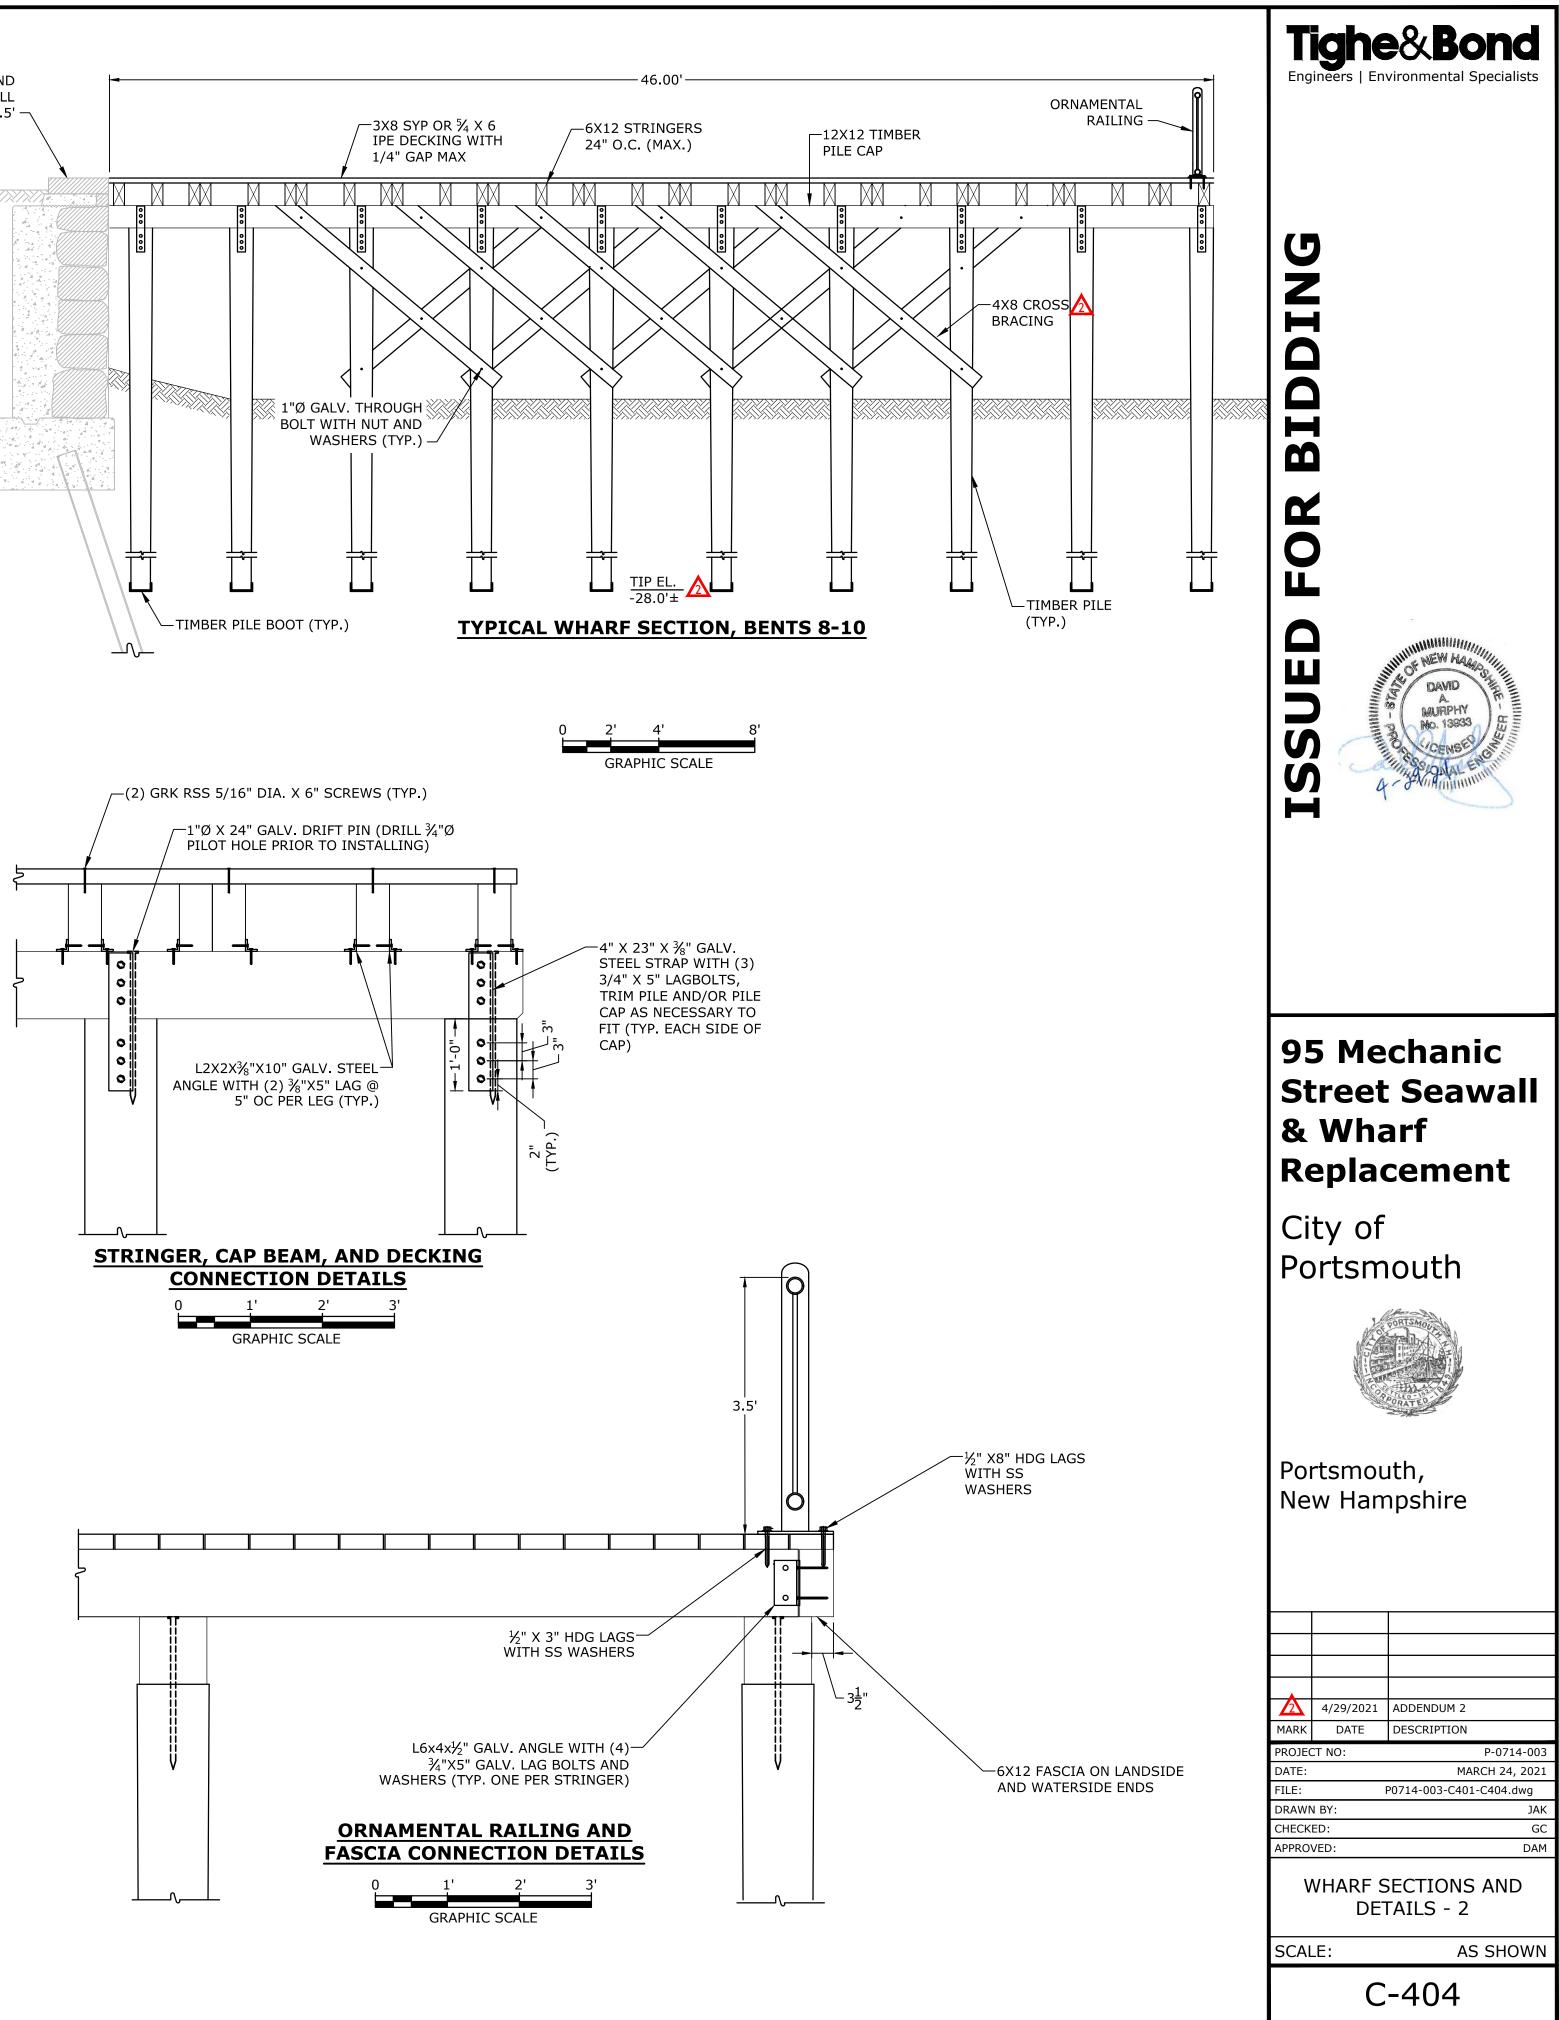

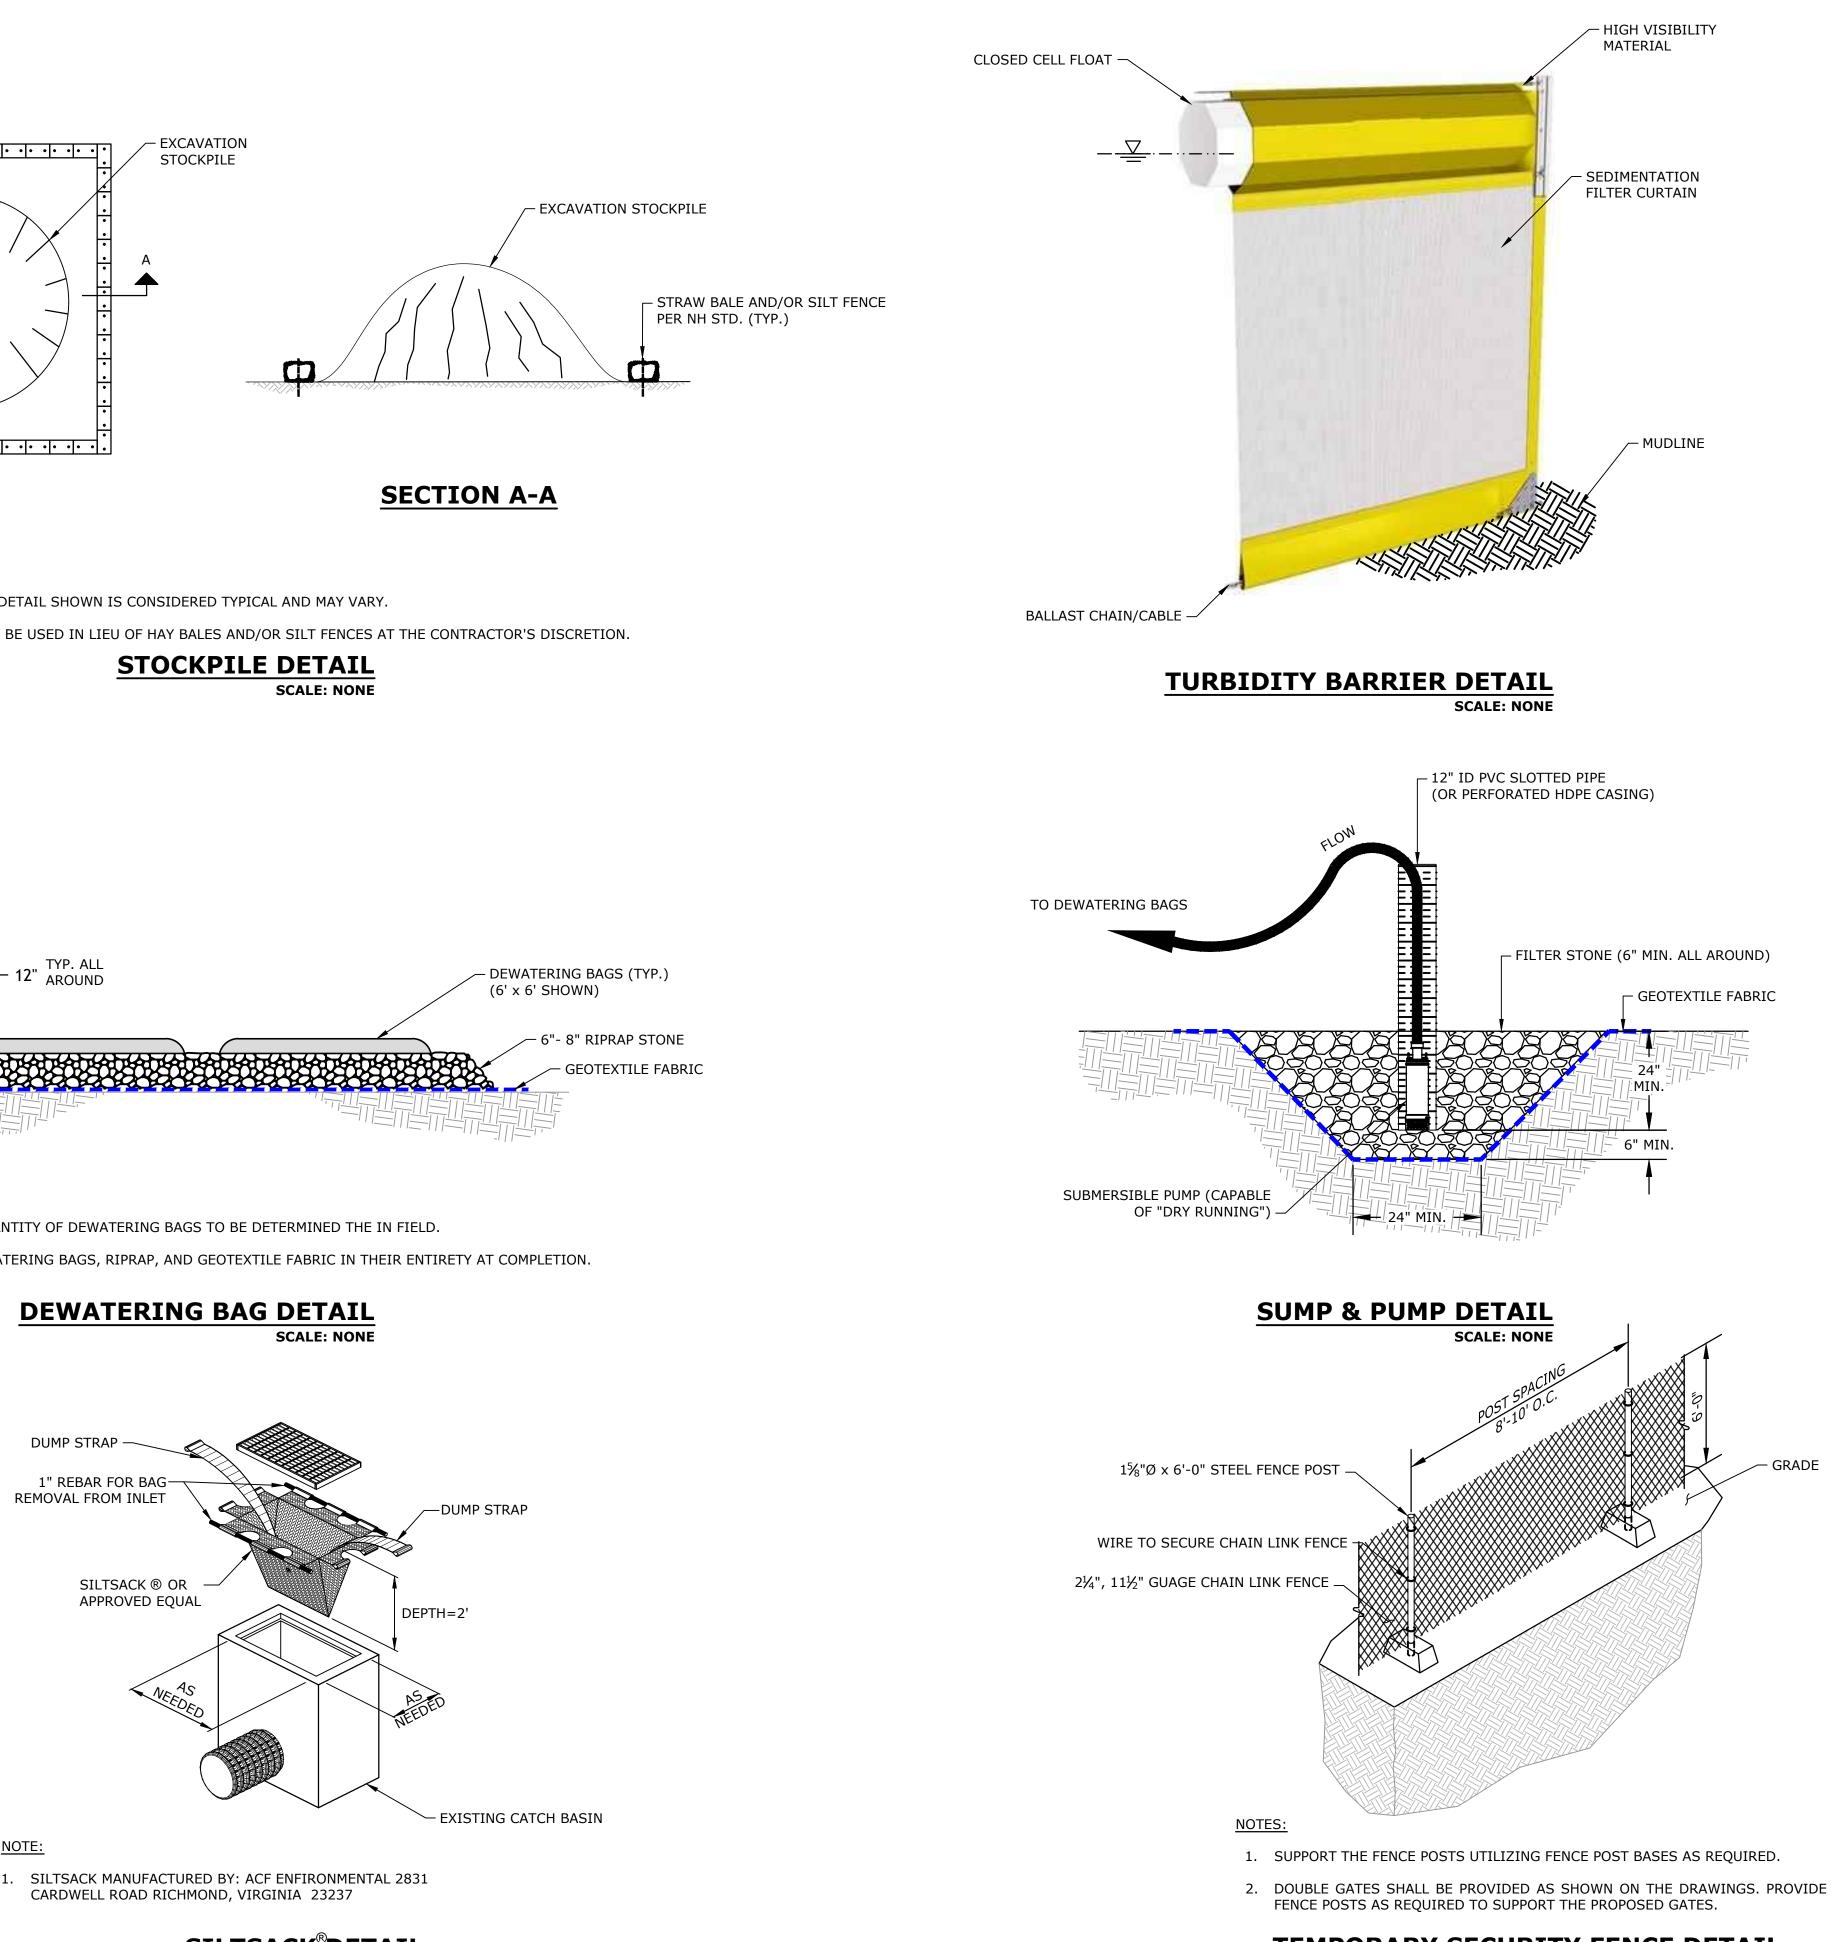




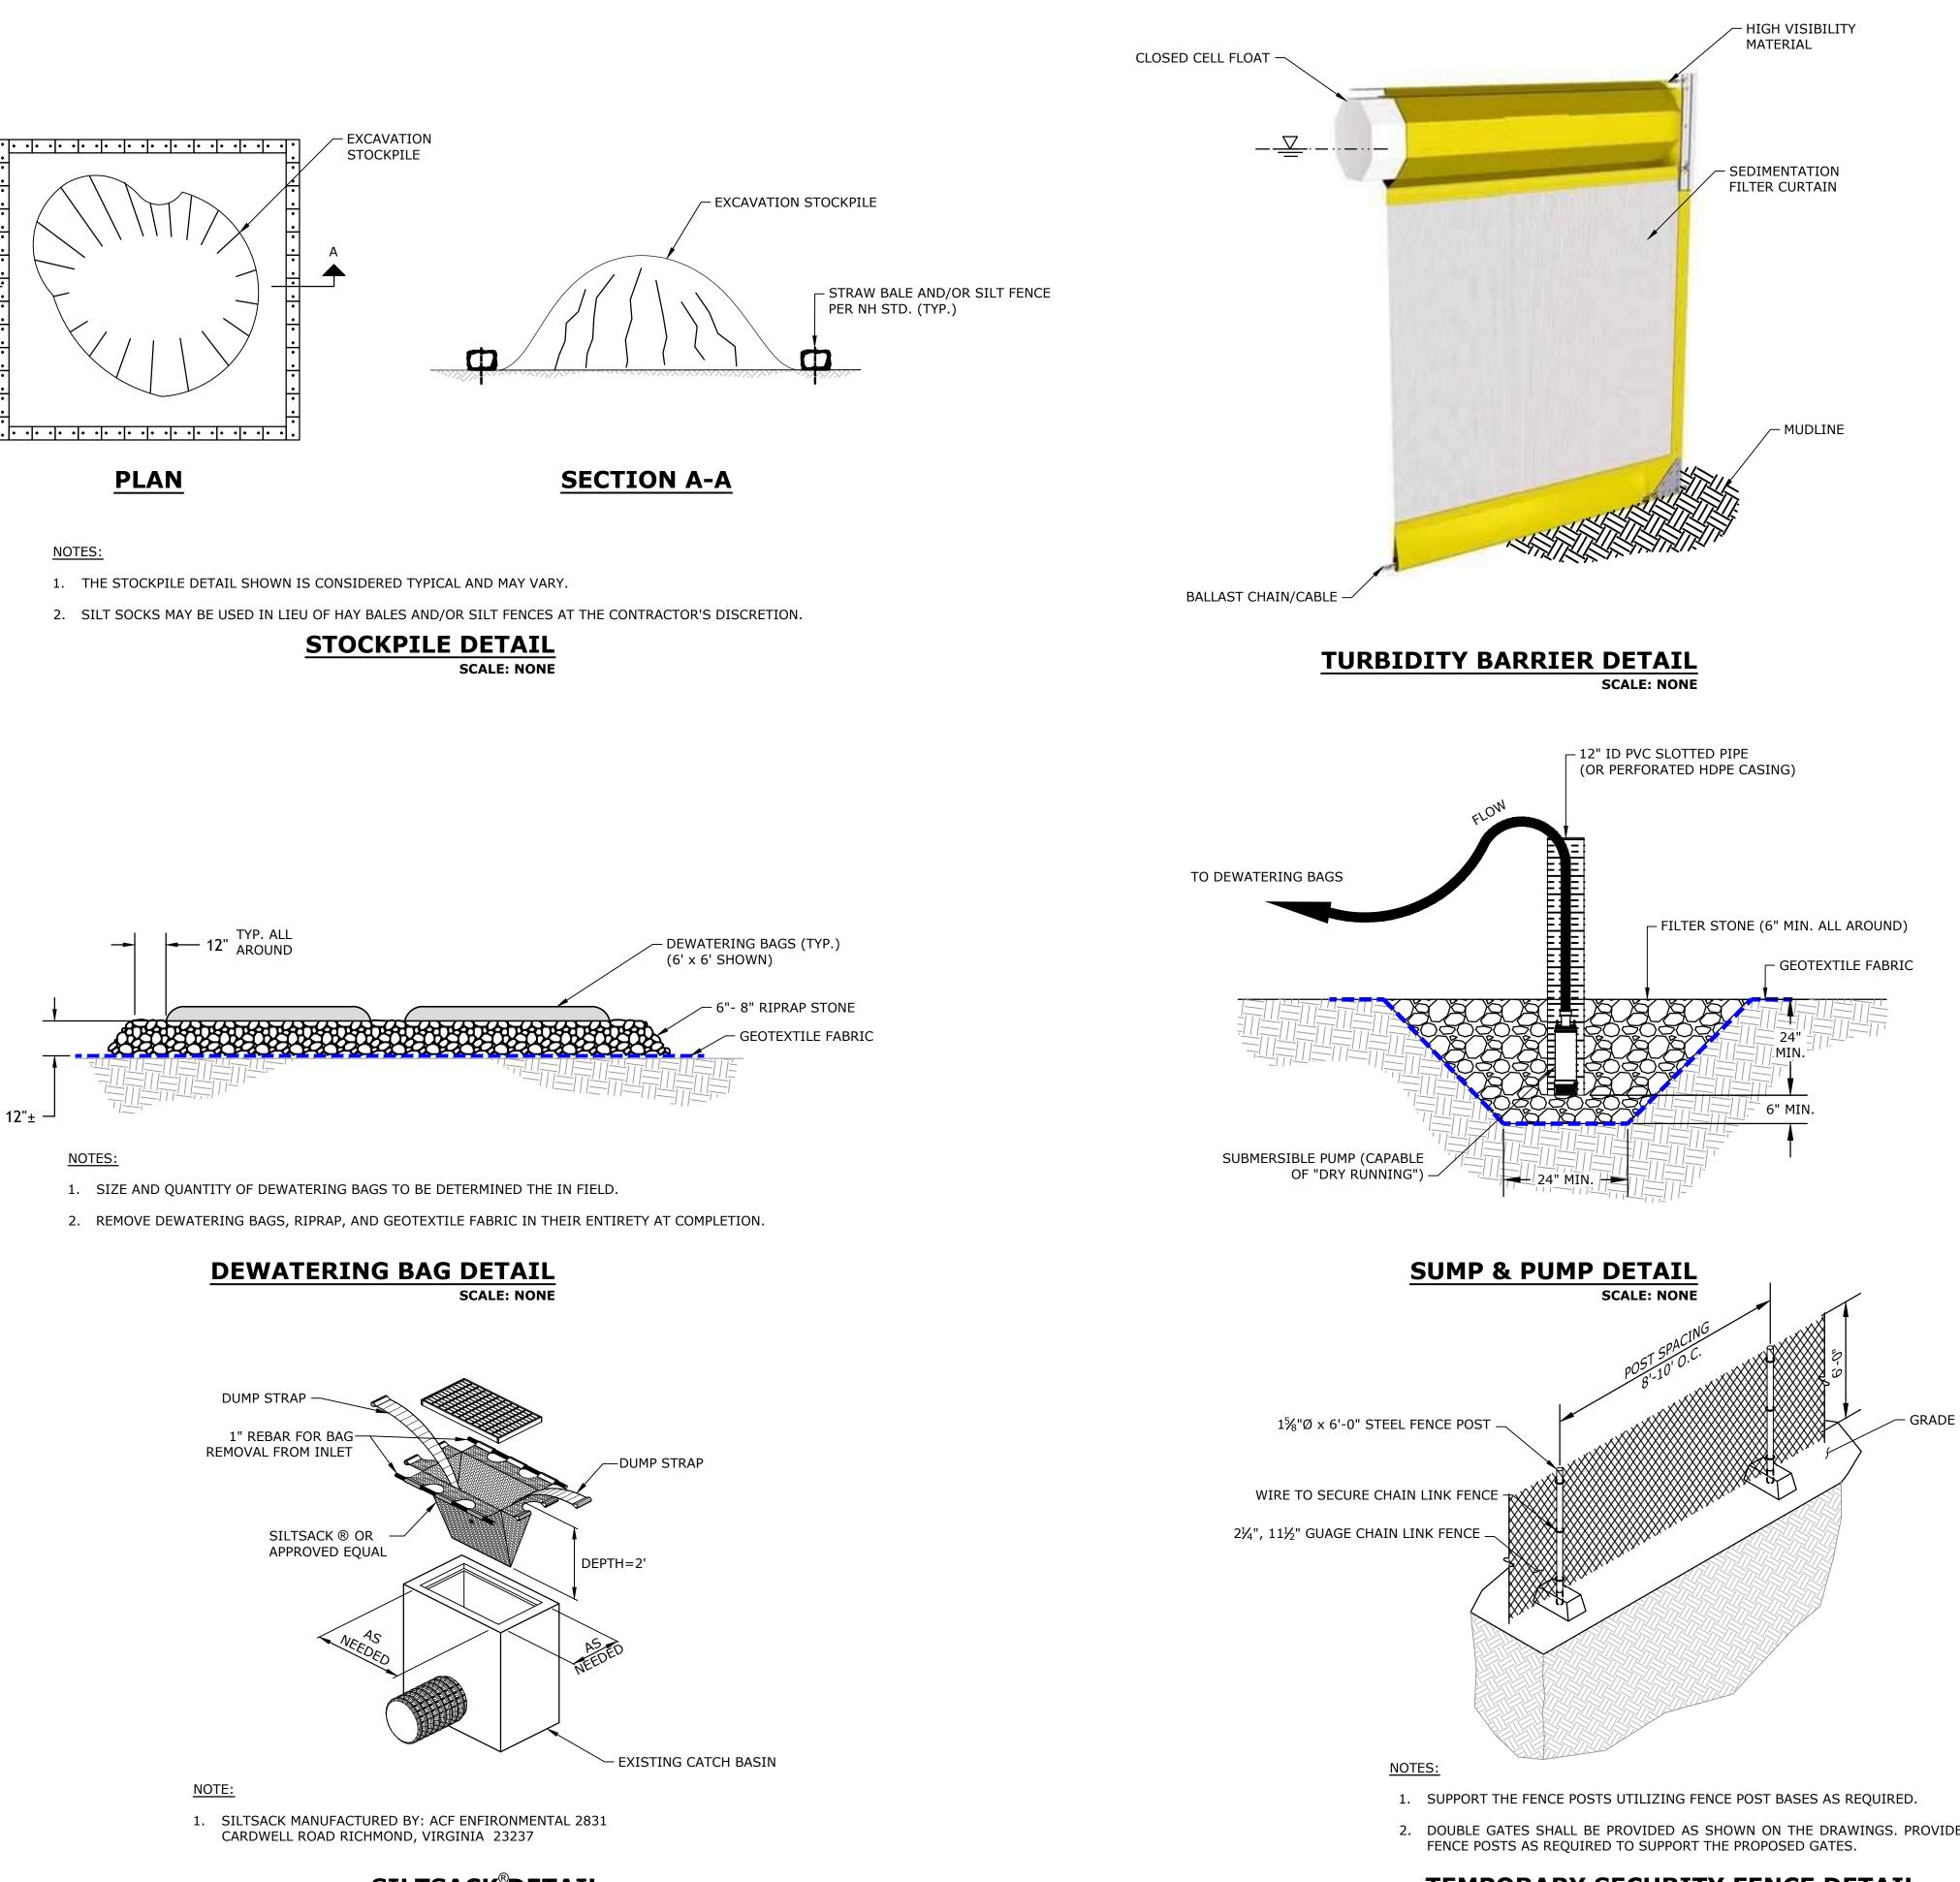

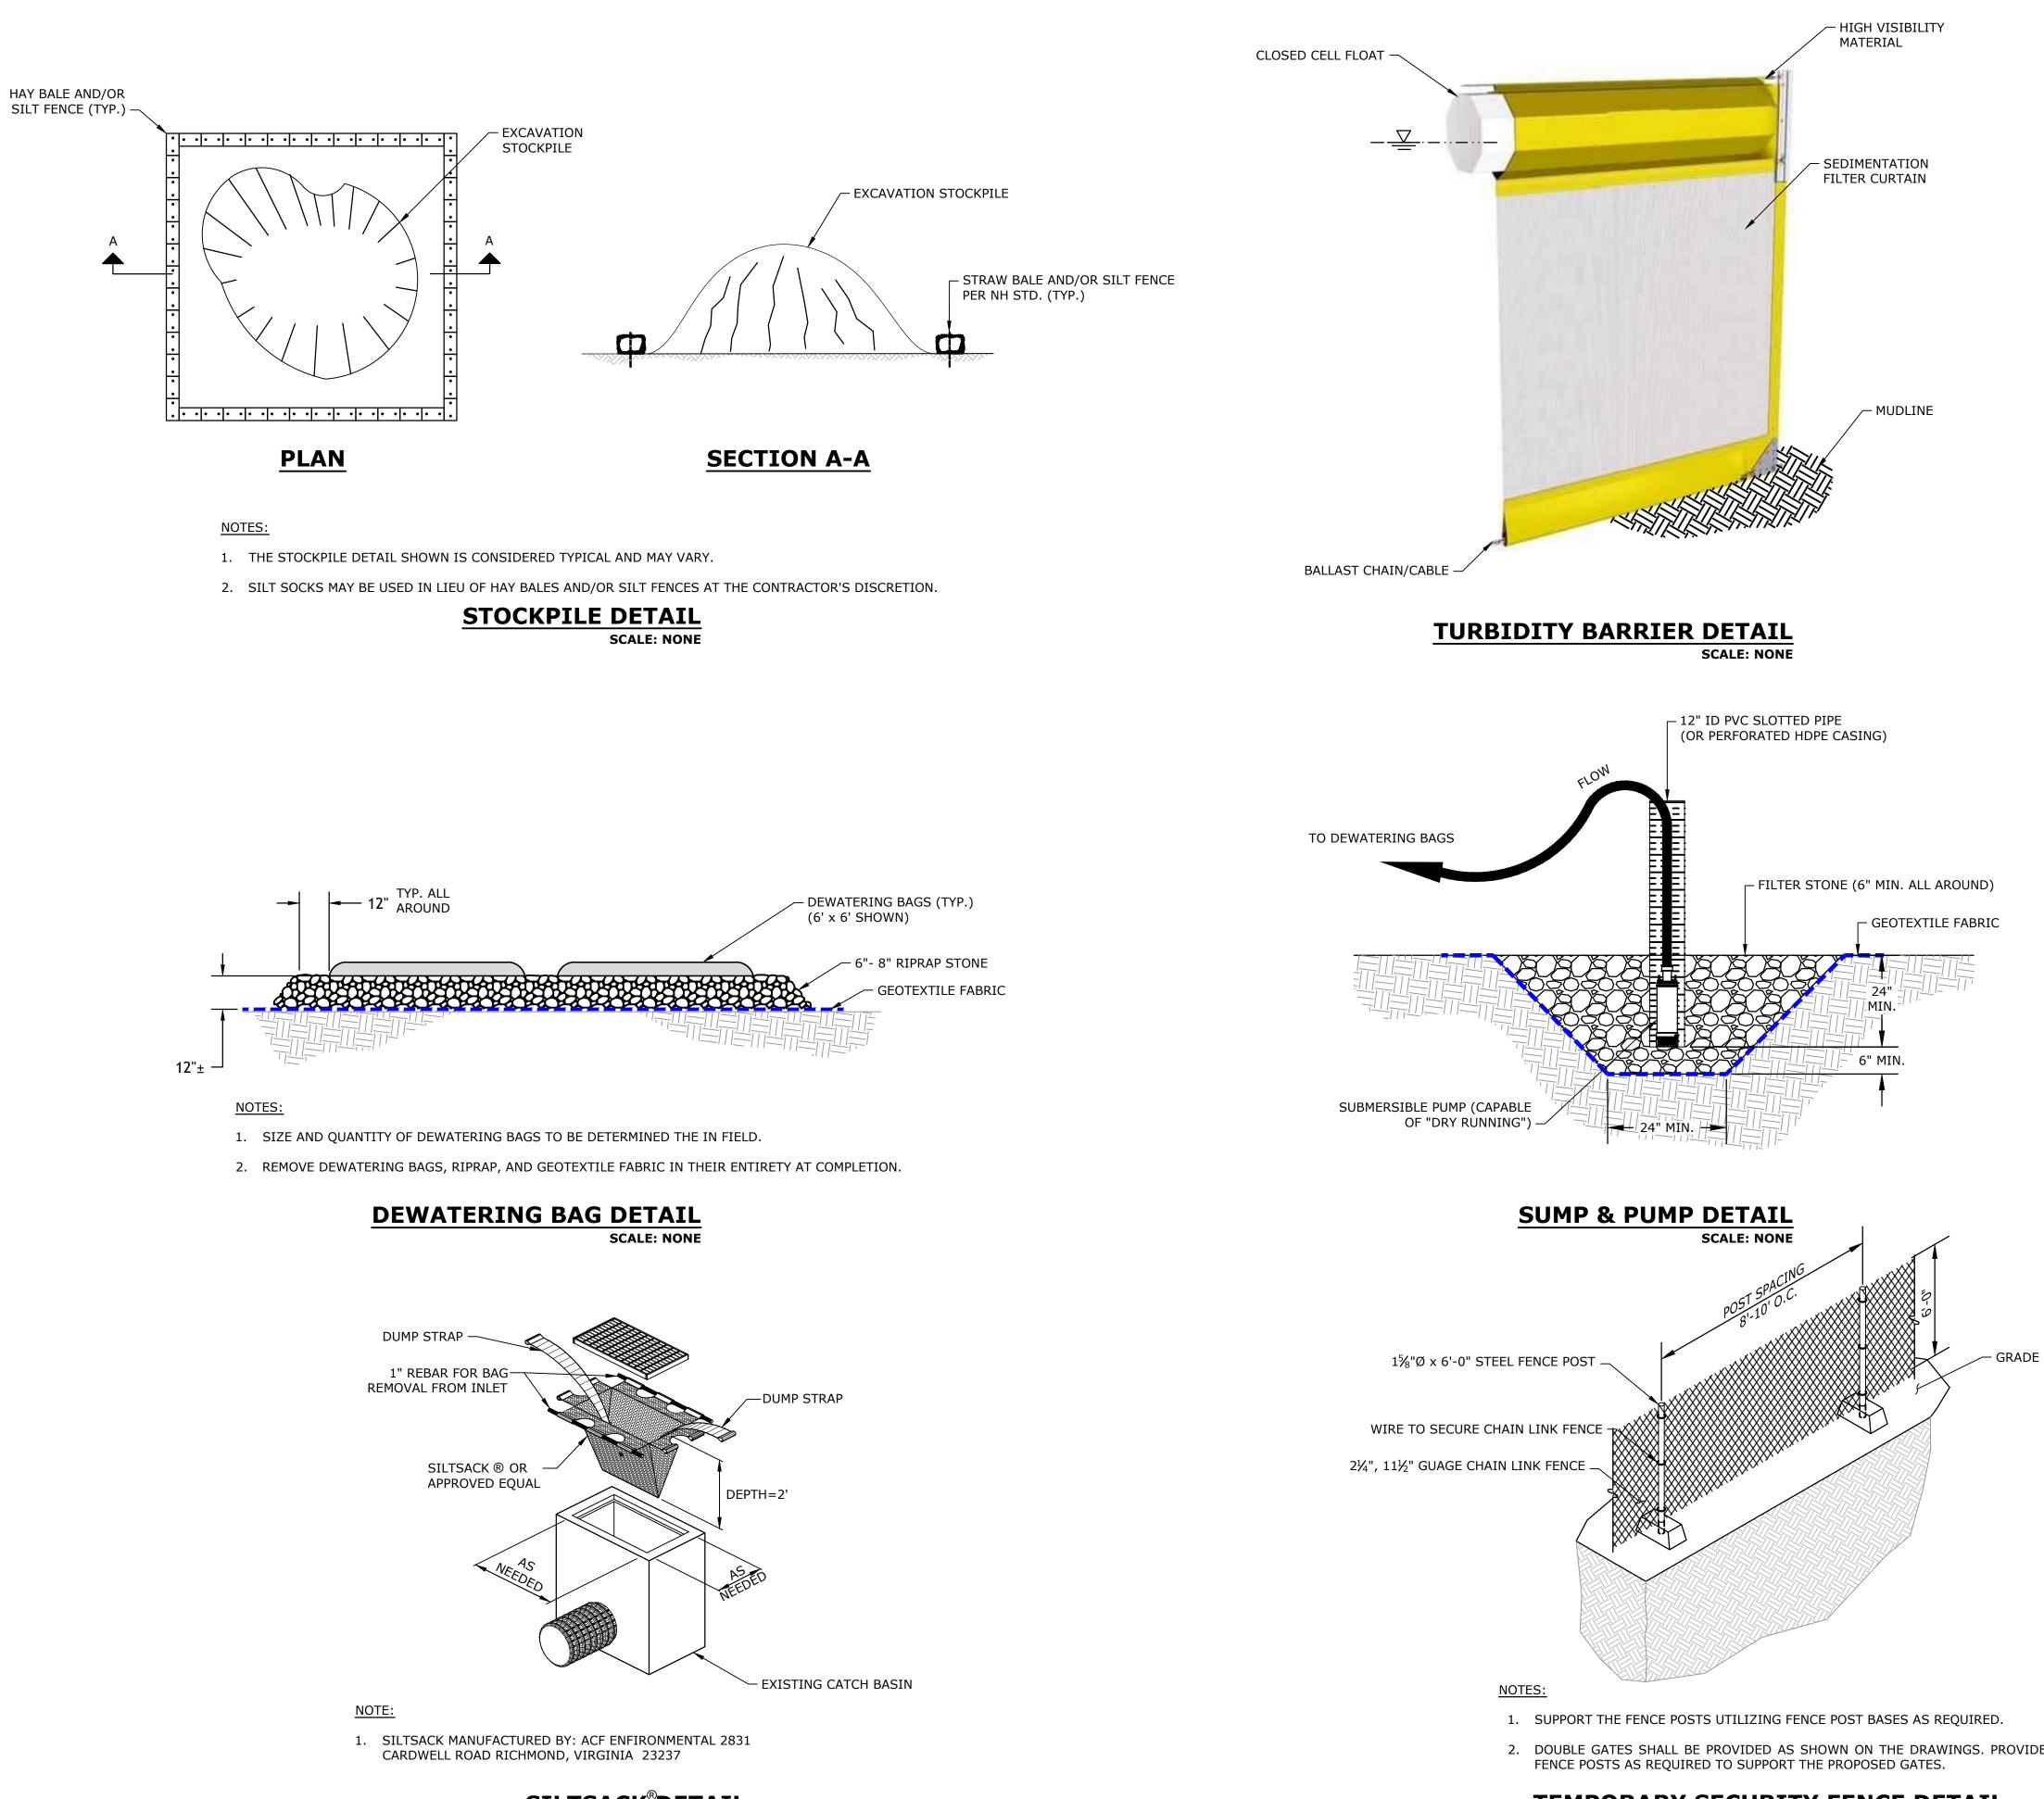

TEMPORARY SECURITY FENCE DETAIL



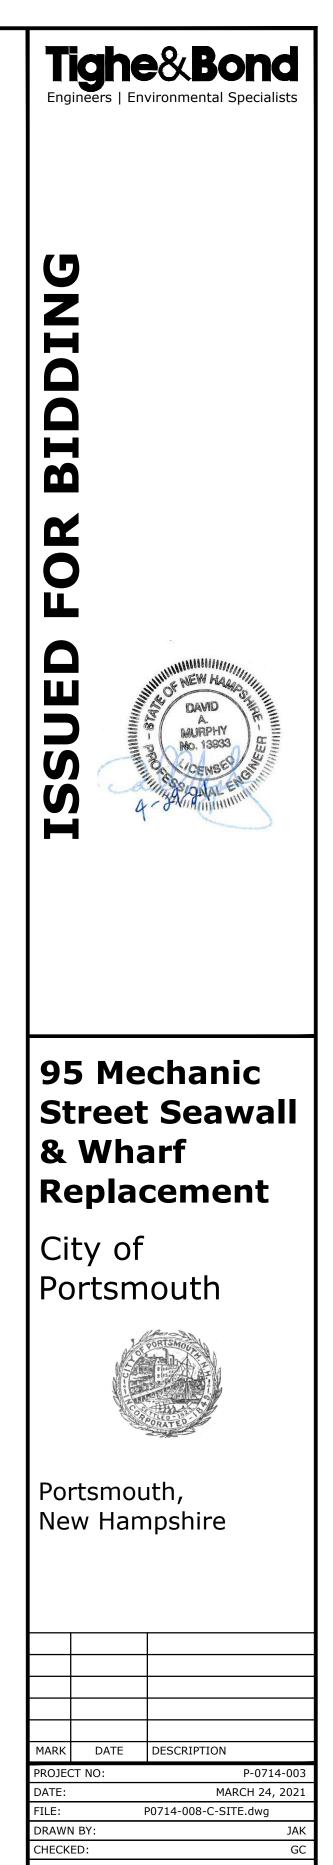


APPROVED: DAM EROSION AND SEDIMENT CONTROL DETAILS

C-501

AS SHOWN

SCALE:

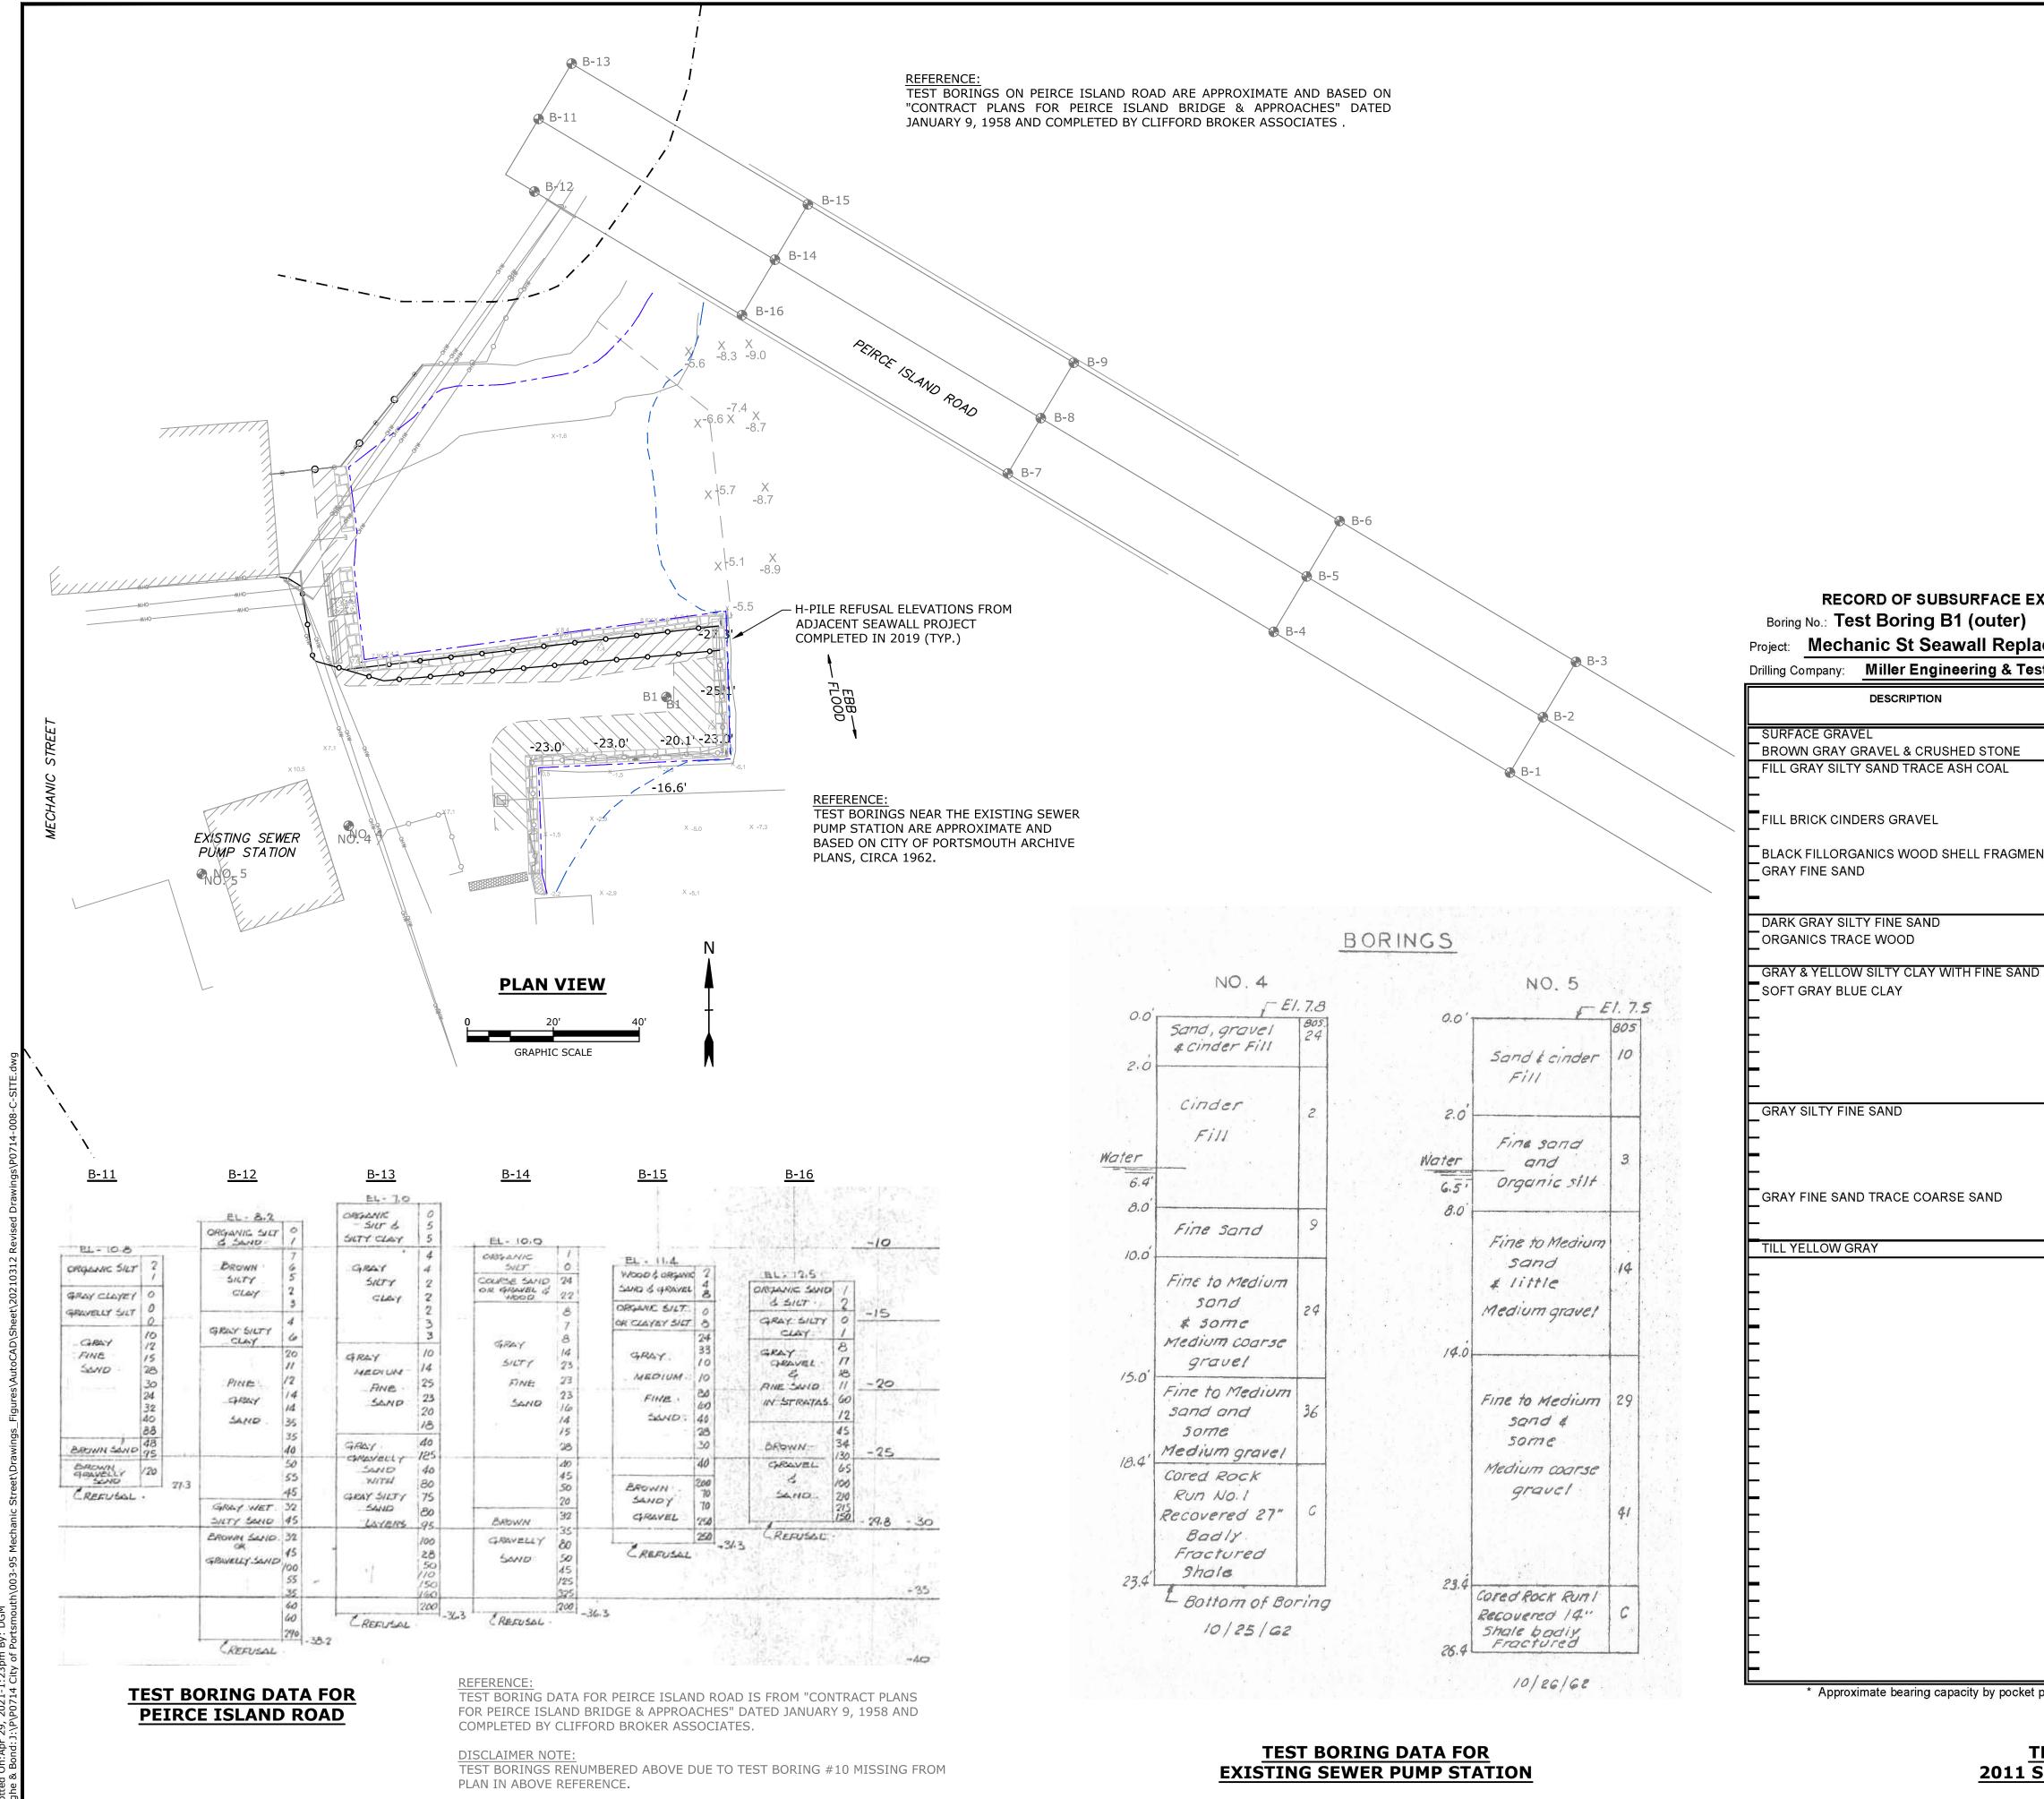

						Tighe&Bond Engineers Environmental Specialists
XPLORATION Prepa Accement, P Sting, Inc.	red by: ortsmc DEPTH 5' —	Water	front Date o	ETRATION Enginee of Boring: neer: BEARING CAPACITY*		<section-header></section-header>
LENSES	20' — 25' — 30' — 35' — 40' —	1,10 2,13 54,15 1,1 1,1 WOR 24" WOR,WOH WOH,1 WOH,3 8,8 WOR,3 7,7 10,15 18,21 9,14 27,14	3 ? 2 0 11 10 33 41	1 TSF 0.3 TSF 0.25 TSF	WOOD IN TIP PUSHING STONE?	95 Mechanic Street Seawall & Wharf ReplacementCity of PortsmouthVortsmouth New Hampshire
penetrometer on EST BORI SEAWALL	NG DA			, tons/sf		MARK DATE DESCRIPTION PROJECT NO: P-0714-003 DATE: P0714-008-C-SITE.dwg DRAWN BY: JAK CHECKED: GC APPROVED: DAM HISTORICAL BORING AND LOGS SCALE: AS SHOWN C-900